


VEGAS HEIGHTS TRACT.

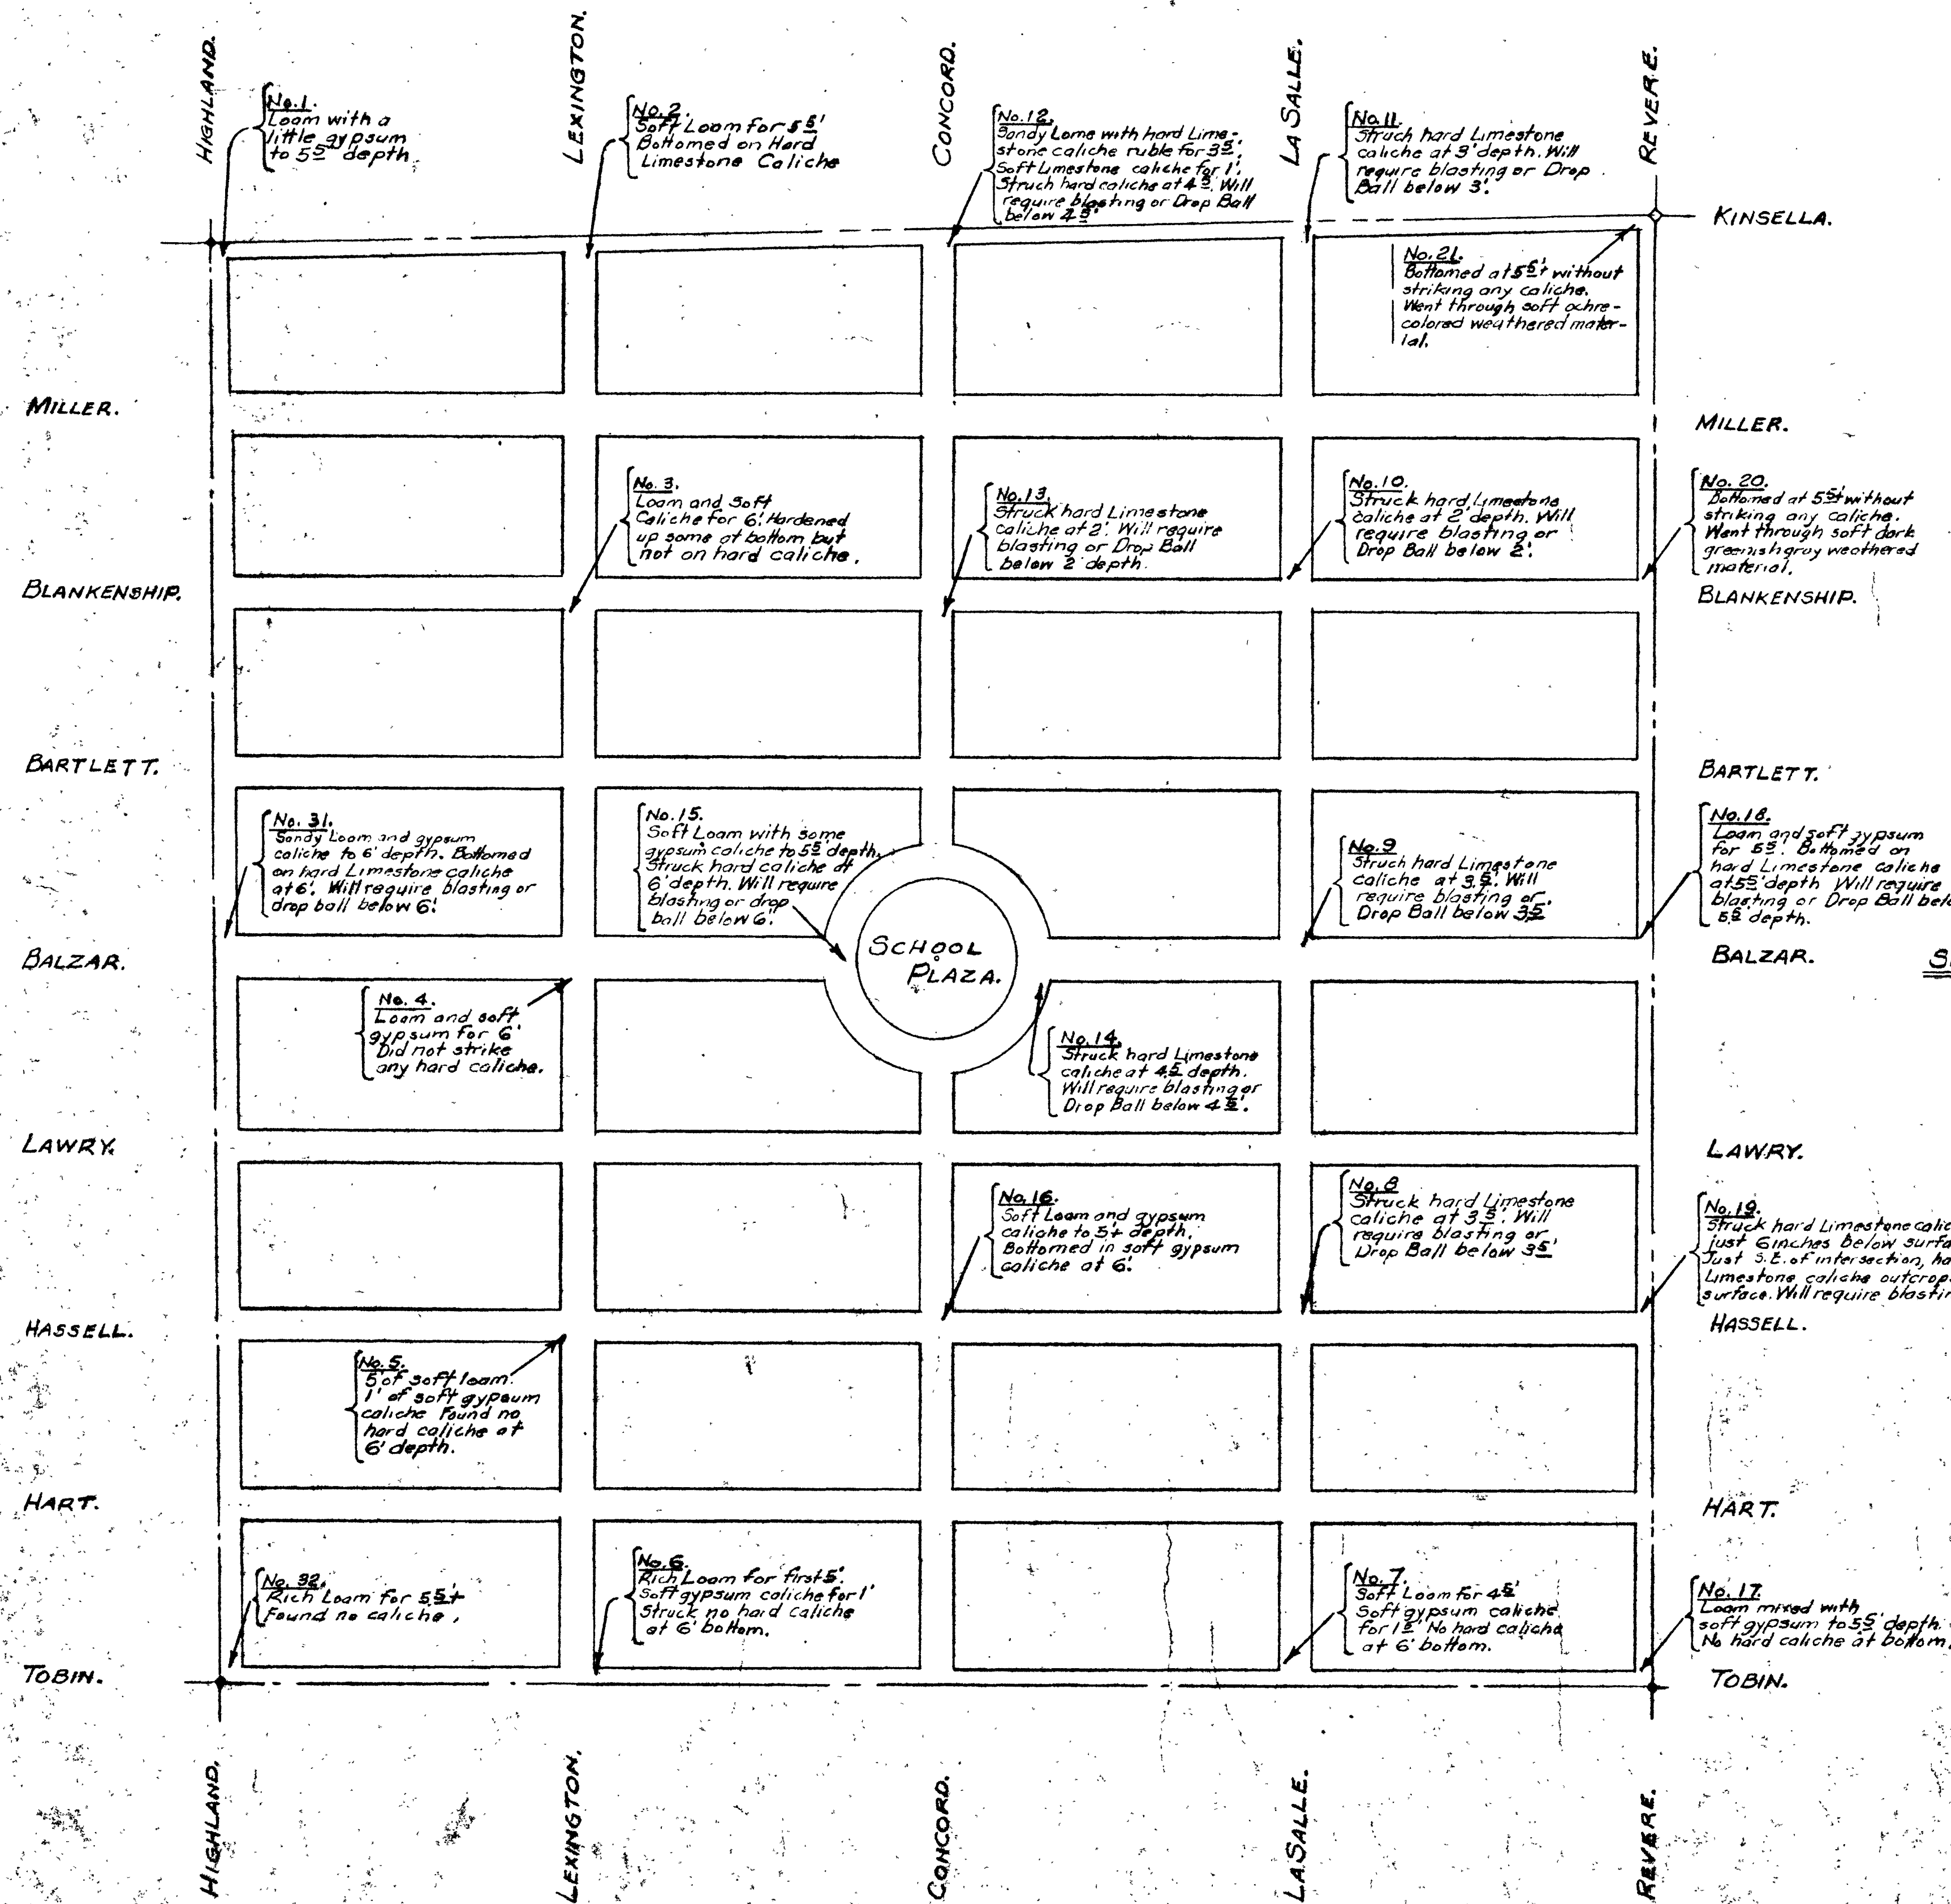

TEST HOLES ALONG SOUTH SIDE OF SMOKE RANCH ROAD AND IN 4.0-ACRE PARCEL OF LAND.

No. 22. On south side of Smoke Ranch Road (Kinsella Ave. Projected) approx. 1,000' west of Highland, 180' west of S. N. P. Pole No. 141. Top of hole about 1' below top of E. of pavement. Struck hard gypsum caliche at 3'. Will require blasting or drop ball below 3'.

No. 23. On S. side of Smoke Ranch Rd. 100' west of Pwr. Pole No. 141. Top of hole about 1' below top of E. of pavement. Hole is approx. 2,000' west of Highland Dr. - Soft Loom and gypsum for 5'. Bottomed on top of hard gypsum caliche. Will require blasting or drop ball below 5' depth.

No. 24. On S. side of Smoke Ranch Road approx. 3,000' west of Highland Dr. 28' west of Pwr. Pole No. 121. Top of hole 1.2' below top of E. of pavement. - Loom and Limestone pebbles for 3'. Struck hard Limestone caliche at 4'. Bottomed at 4'. Will require blasting or drop ball below 4'.

No. 25. On S. side of Smoke Ranch Rd. approx. 4,000' west of Highland Dr. 56' east of Pwr. Pole No. 121. Top of hole 1' below top of E. of pavement. - Loom, sand and pebbles for 5'. Bottomed on top of hard Limestone caliche. Will require blasting or drop ball below 5' depth.

No. 26. On S. side of Smoke Ranch approx. 5,000' west of Highland Dr. 117' east of Pwr. Pole No. 121. Top of hole 1.5' below top of E. of pavement. - Loom, sand and Limestone pebbles for 5'. Bottomed at 55' without striking any caliche.

No. 27. On S. side of Smoke Ranch Rd. opposite 1. Sec. 17. Cor. 24' east of Pwr. Pole No. 12467 N.P. - Loom, sand and pebbles for 4'. Bottomed on hard Limestone caliche. Will require blasting or drop ball below 4' depth.

No. 28. About 10' S.W. of E. of NW-3.E. ditch, 300' N.W. of 1/4 Cor. - 15' of Loom, 25' of tight Limestone caliche (not solid). Bottomed on hard Limestone caliche at 4'. Will require blasting or drop ball below 4'.

No. 29. About 10' S.W. of E. of ditch, 900' N.W. of 1/4 Cor. - 1' of Loom, 25' of Loose Limestone caliche cobble stones, 1' of clay. Bottomed on clay at 5'.

No. 30. About 10' S.W. of E. of ditch, 1,200' N.W. of 1/4 Cor. - Struck hard Limestone caliche at 12'. Will require blasting or drop ball below 12'.

No. 31. About 10' S.W. of E. of ditch, 1,500' N.W. of 1/4 Cor. - Struck hard Limestone caliche 2' below surface. Will require blasting or drop ball below 2'.

SCALE: One Inch = 200 Feet.

For Reference only - Not Part of Contract

VEGAS HEIGHTS WATER & SANITATION DISTRICT.
1024 WEST BALZAR AVE. LAS VEGAS, NEVADA.

MAP SHOWING LOCATIONS AND LOGS OF TEST PITS FOR WATER SUPPLY SYSTEM.

Prepared by Ernest H. Clary, P.E.,
Reg. Prof. Civil Engineer and Land Surveyor - No. 230 - Nevada.
1210 Western St.,
Las Vegas, Nevada.

Scale: One Inch = 200 Feet.
Date: _____

Sheet of Sheets. Drawing No. _____

