PLAN & PROFILE - OFFSITE SEWER - SEE SHEET PP9

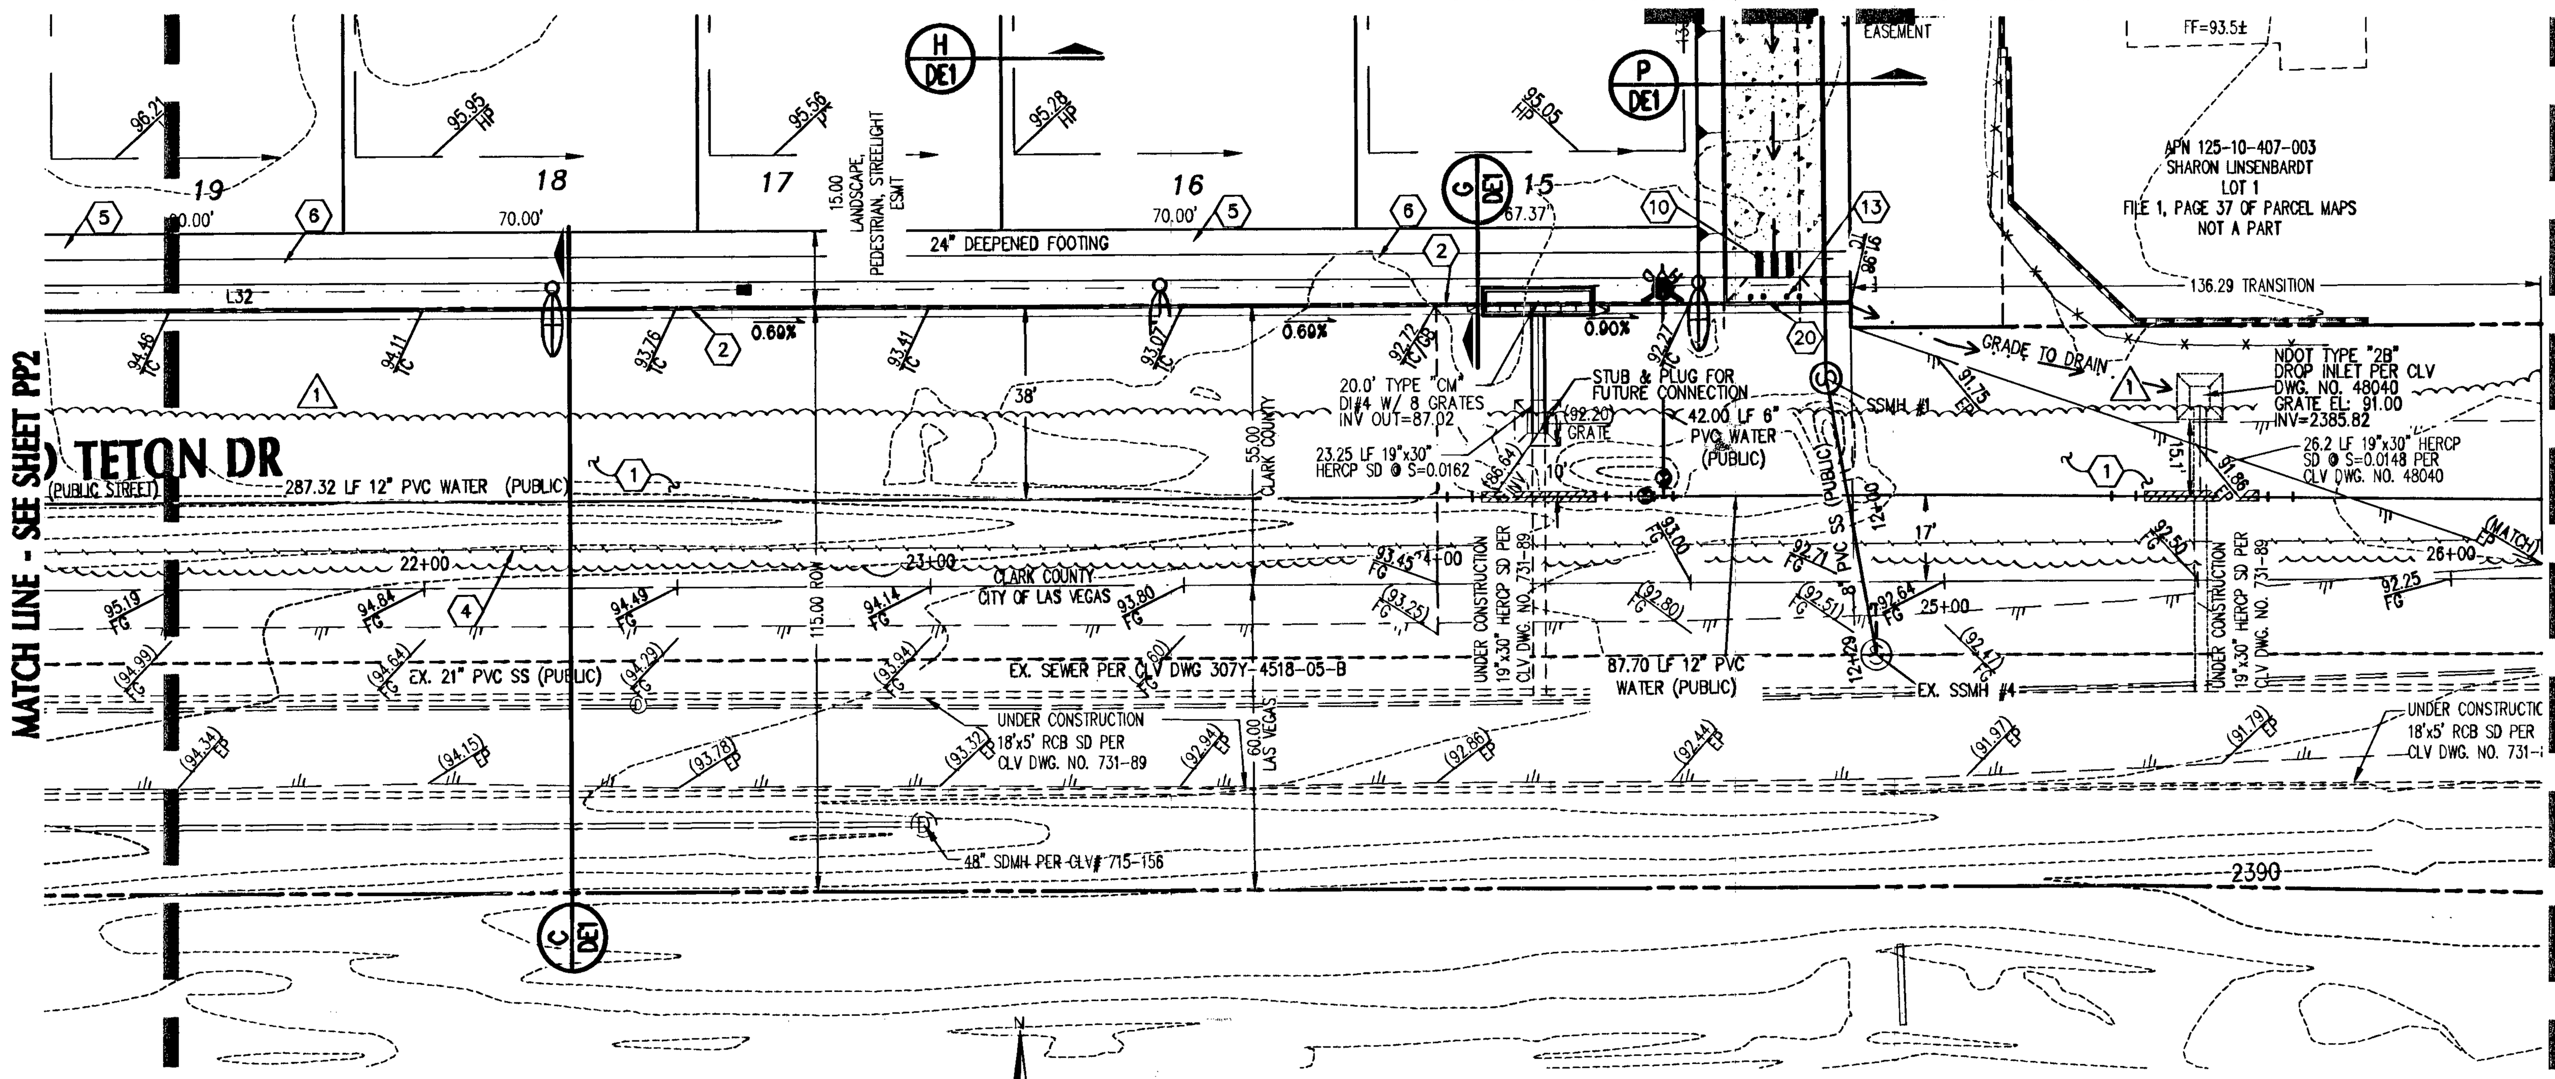

GRAND TETON DR (PUBLIC) - PLAN VIEW
SCALE: 1"=30'

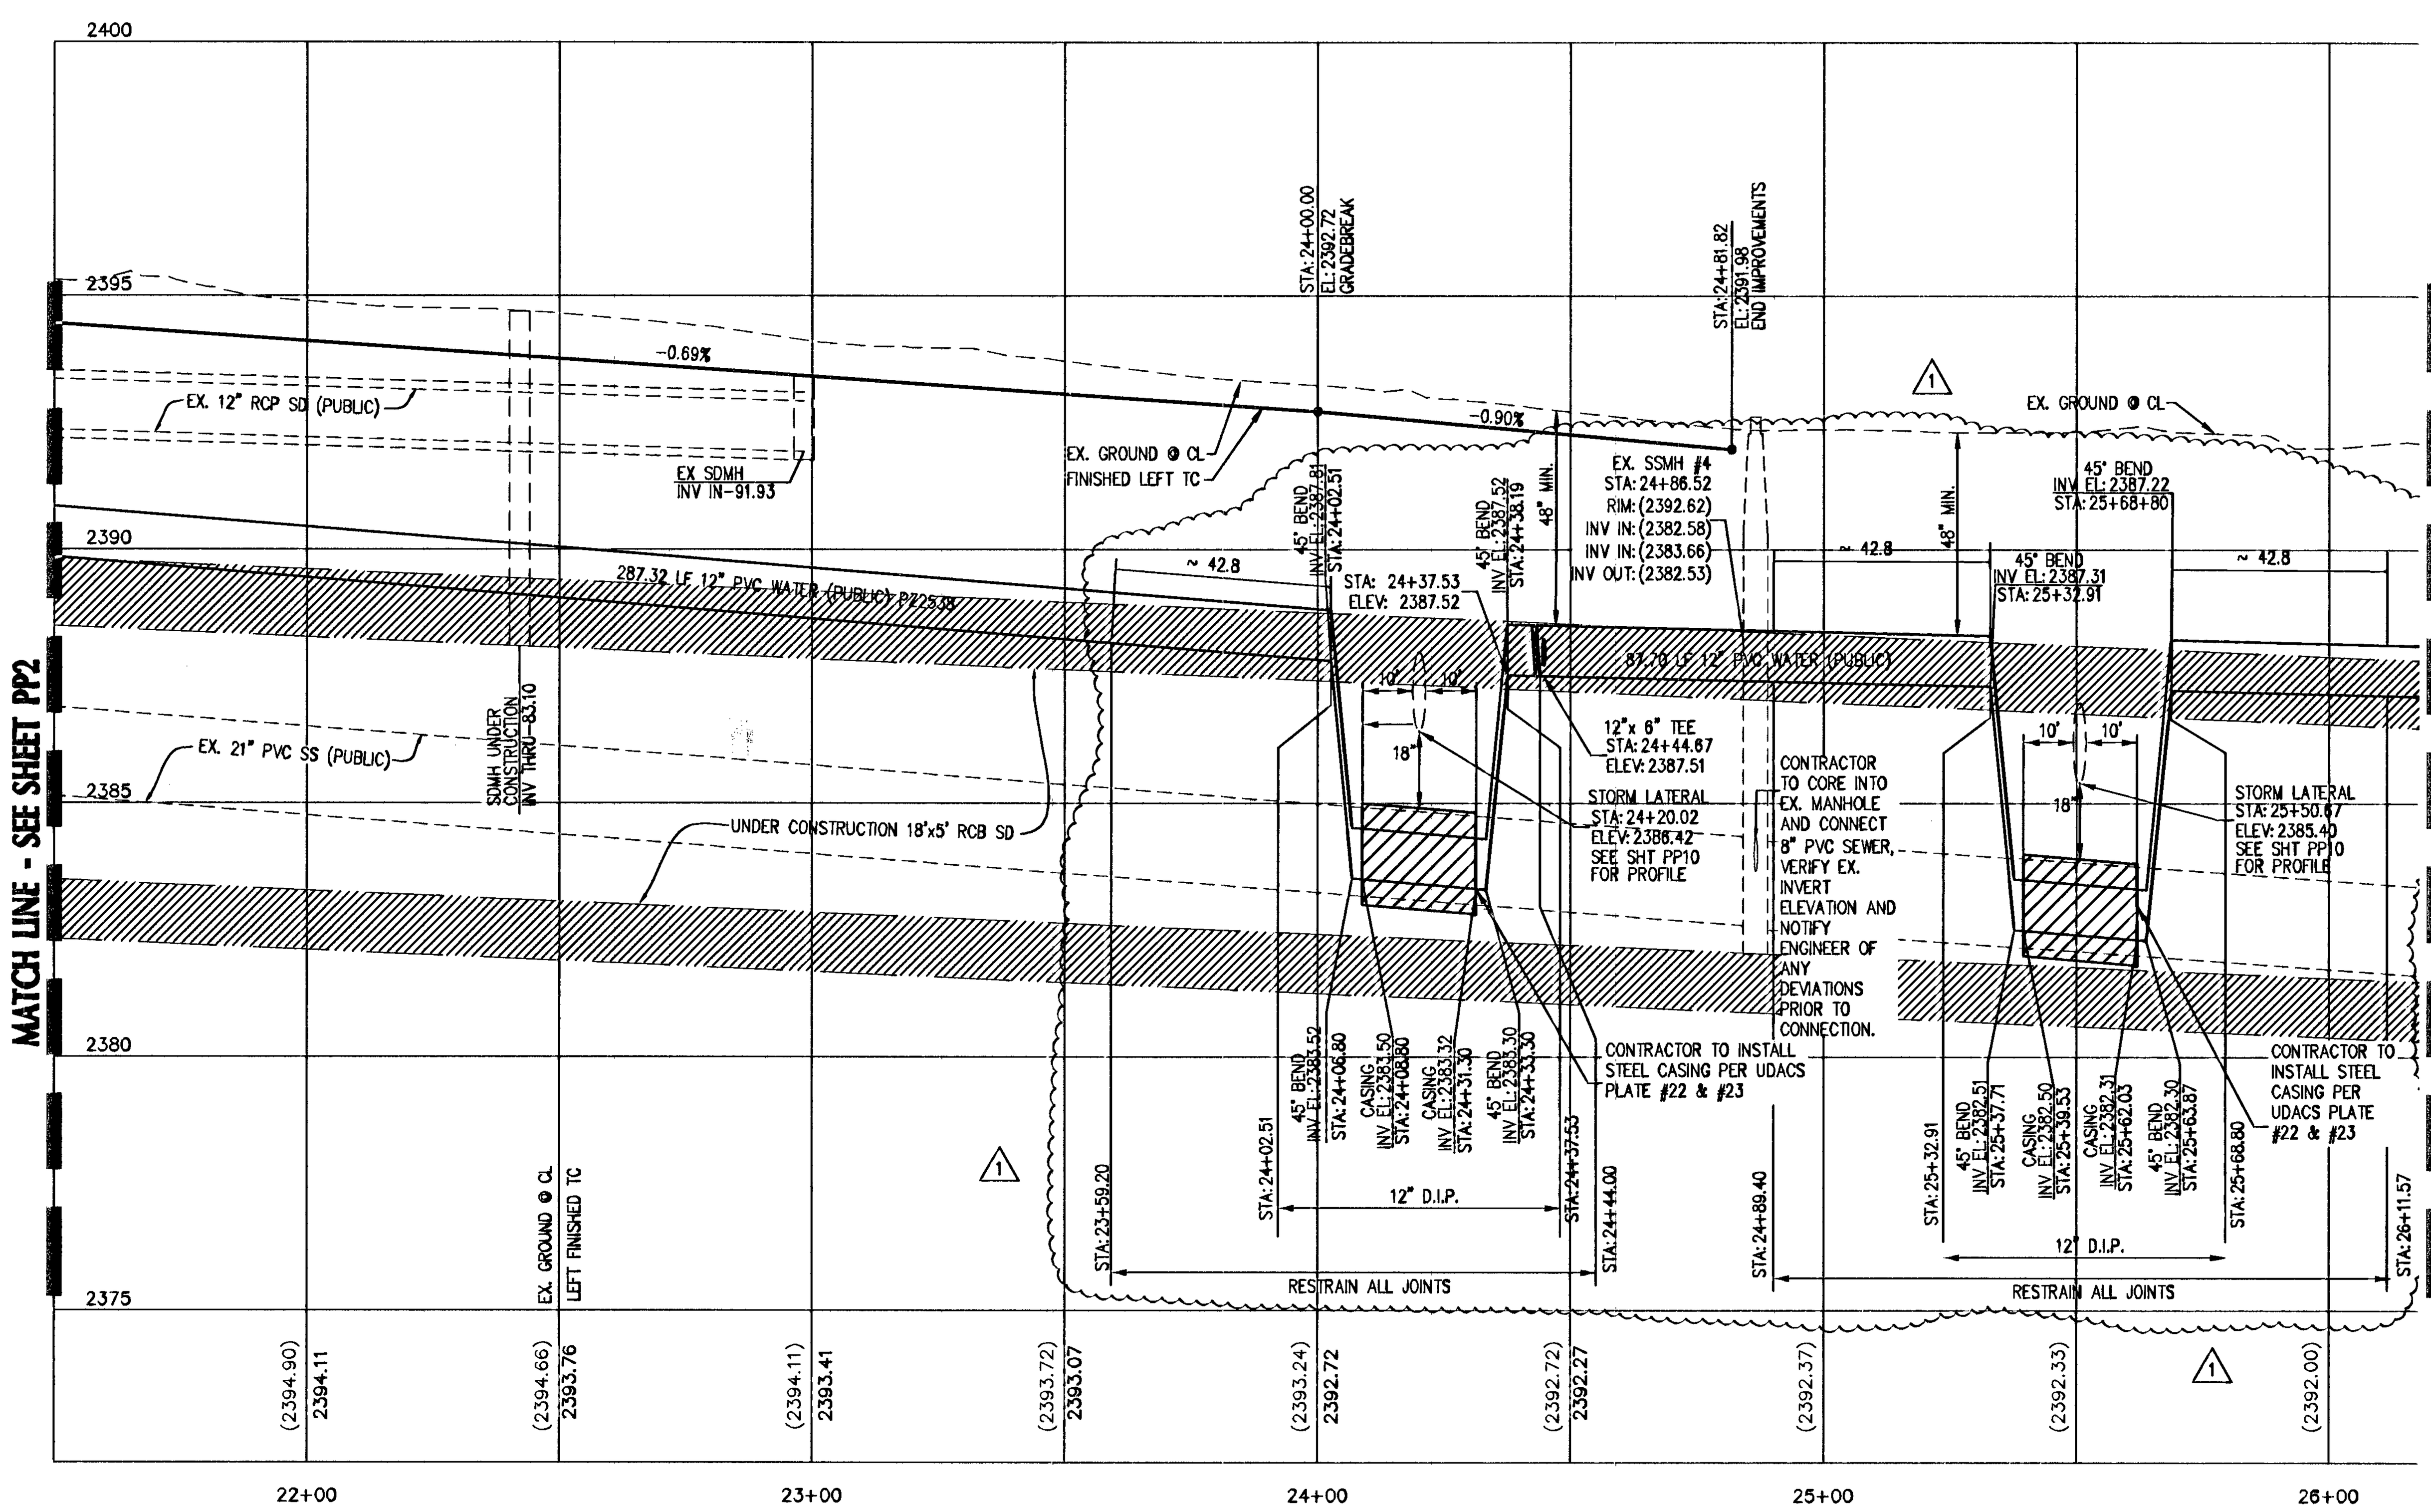

GRAND TETON DR (PUBLIC) - PROFILE VIEW
HORIZONTAL SCALE: 1"=30'
VERTICAL SCALE: 1"=3'

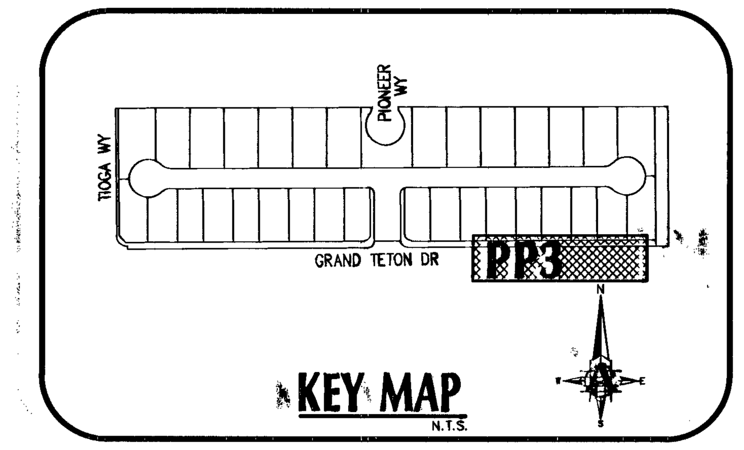

KEY MAP
N.T.S.

SCALE: 1" = 30'

CONSTRUCTION NOTES:

1. INSTALL AC PAVEMENT OVER TYPE II AGG. BASE PER DETAIL "D" SHEET DE2
2. INSTALL 2' "L" TYPE CURB & GUTTER PER CCAUSD #216
3. HATCHED AREA DENOTES SIGHT VISIBLITY ZONE PER CCAUSD #201.2
4. SAWCUT AND MATCH EXISTING ELEVATION, CONTRACTOR TO VERIFY
5. INSTALL LANDSCAPING PER LANDSCAPE PLANS
6. INSTALL 5' WIDE, 4" THICK CONCRETE SIDEWALK PER CCAUSD #234
7. CONSTRUCT SIDEWALK RAMP USING ARMOR TILE TRUNCATED DOMES OR EQUIVALENT PER CCAUSD NO. 235, CASE 1 A=8.0', B=8.0' UNLESS OTHERWISE NOTED
8. CONSTRUCT SIDEWALK RAMP USING ARMOR TILE TRUNCATED DOMES OR EQUIVALENT PER CCAUSD NO. 235, CASE 2 A=8.0', B=8.0' UNLESS OTHERWISE NOTED
9. INSTALL 8' CONCRETE VALLEY GUTTER PER CCAUSD #228
10. INSTALL SIDEWALK UNDERDRAIN PER CCAUSD #236
11. PLACE DUAL DECORATIVE CMU DRAIN BLOCK AT GRADE
12. CONSTRUCT FLUME PER DETAIL "1" SHEET DE1
13. INSTALL REMOVABLE BOLLARDS PER DETAIL "2" SHEET DE1
14. CONSTRUCT "A" TYPE CURB PER CCAUSD #219
15. CONSTRUCT 2' SIDEWALK DRAIN PER CCAUSD #236
16. INSTALL 20' TYPE "CM" DROP INLET WITH 8 GRATES PER CCAUSD #421 & DETAIL SHEET DE2
17. CONSTRUCT 4' BLOCK WALL OPENING PER DETAIL "3" SHEET DE1
18. REMOVE EXISTING MEDIAN CURB, PROPOSED CURB TO MATCH EXISTING ELEVATION
19. INSTALL WROUGHT IRON GATE PER CITY OF LAS VEGAS STANDARD DRAWING 421B, SHEET DE2
20. INSTALL CURB OPENING PER DETAIL "G" SHEET DE2
21. SAWCUT, REMOVE, AND REPLACE PAVEMENT PER CCAUSD #503, 500.3, AND 500.5

LEGEND

- PROPOSED PAVEMENT
- PROPERTY LINE
- SCARP
- RETAINING WALL
- EXISTING CHAIN LINK FENCE
- RATE: FLOW RATE/DIRECTION
- 2090 NAT. GRND CONTOUR
- EXISTING CURB
- EXISTING STREETLIGHT
- EXISTING MANHOLE
- EXISTING UTILITY BOXES
- EXISTING POWER POLE
- PROPOSED GRADE TAG
- EXISTING GRADE TAG
- PROPOSED CONSTRUCTION NOTE

NOTE:
SEE SHEETS DE1 FOR TOTAL PROJECT QUANTITIES AND GENERAL NOTES.

AVOID HITTING OVERHEAD POWER LINES. IT'S COSTLY.
CALL BEFORE YOU DO OVERHEAD
1-702-227-2929

FAST
Call before you UnderGround
1-702-432-5300
FREEWAY AND ARTERIAL SYSTEM OF TRANSPORTATION

Call before you Dig
AVOID CUTTING UNDERGROUND UTILITY LINES. IT'S COSTLY.
Call 811
OR
1-800-227-2600

BASIS OF BEARINGS
NORTH 84°40'02" EAST BEING THE BEARING OF THE SOUTH LINE OF THE SOUTHWEST QUARTER (SW 1/4) OF THE SOUTHWEST QUARTER (SW 1/4) OF SECTION 10, TOWNSHIP 19 SOUTH, RANGE 60 EAST, M.D.M., CLARK COUNTY, NEVADA, AS SHOWN ON THAT CERTAIN MAP ON FILE IN THE CLARK

BENCHMARK
BENCHMARK STATION: 8LV90 10SSW6

CITY OF LAS VEGAS RIVET AND PLATE IN CONCRETE CYLINDER, AT THE NORTHWEST CORNER OF GRAND TETON DRIVE AND PIONEER WAY.

ELEVATION=730.741 METERS (NAVD'88)
ELEVATION=2397.44 U.S. SURVEY FEET (NAVD-88)

GENERAL NOTES
1. SEE PARCEL MAP FOR EXACT BEARINGS AND DISTANCES.
2. CONTRACTORS SHALL VERIFY ALL CONDITIONS AND DIMENSIONS AND SHALL REPORT ALL DISCREPANCIES TO THE ENGINEER PRIOR TO THE COMMENCEMENT OF WORK.
3. ALL GRADING WORK TO CONFORM TO SOILS REPORT AS PREPARED FOR THIS PROJECT.
4. CONTRACTOR SHALL REMOVE EXCESS DEBRIS AND VERIFY WALL FOOTING ELEVATION PRIOR TO CONSTRUCTION, REPORT DISCREPANCIES TO ENGINEER IMMEDIATELY.

WATER MAIN JOINT DEFLECTION (PVC 4"-24")
PVC PIPE SHALL BE DEFLECTED AT THE JOINT ONLY. THE MAXIMUM ALLOWABLE DEFLECTION SHALL BE ONE (1) DEGREE PER JOINT WITH A MINIMUM RADIUS OF CURVATURE OF 1,150 FEET PER UDACS 2.07.01 AND 2.07.02.

FOR CHANGES IN DIRECTION EXCEEDING THE MAXIMUM ALLOWABLE JOINT DEFLECTION, FITTINGS SHALL BE USED.

UTILITY NOTES:
1. ADVANTAGE CIVIL DESIGN GROUP ASSUMES NO RESPONSIBILITY FOR EXISTING UTILITIES SHOWN OR NOT SHOWN. THE UTILITIES SHOWN ON THIS DRAWING HAVE BEEN PLOTTED FROM RECORD INFORMATION AND ARE FOR THE CONVENIENCE OF THE CONTRACTOR ONLY. IT IS THE CONTRACTOR'S RESPONSIBILITY TO FIELD VERIFY BOTH THE HORIZONTAL AND VERTICAL LOCATION OF ALL RELEVANT UTILITIES PRIOR TO COMMENCEMENT OF CONSTRUCTION. IF A CONFLICT OR DISCREPANCY IS DISCOVERED, THE CONTRACTOR SHALL NOTIFY THE ENGINEER IN WRITING IMMEDIATELY.
2. ALL WATER FACILITIES CONSTRUCTION SHALL BE IN ACCORDANCE WITH THE UNIFORM DESIGN AND CONSTRUCTION STANDARDS FOR WATER DISTRIBUTION SYSTEMS (UDACS), LATEST EDITION.
3. WATER AND SEWER SERVICE LATERALS SHALL BE INSTALLED A MINIMUM OF FOURTY-EIGHT (48) INCHES APART IN SEPERATE TRENCHES. WATER LATERALS SHALL BE A MINIMUM OF TWELVE (12) INCHES ABOVE THE SEWER LATERAL (REF. UDACS 2.17.01.D)
4. GATE VALVES SHALL NOT BE LOCATED IN STREET GUTTERS, VALLEY GUTTERS, OR IN DRIVEWAYS PER UDACS FOR WATER DISTRIBUTION STANDARDS SECTION 2.11.01.E.
5. ALL SEWER AND STORM DRAINS CROSSING WATER LINES MUST CONFORM TO SECTION 2.22 OF THE UNIFORM DESIGN AND CONSTRUCTION STANDARDS FOR POTABLE WATER SYSTEMS (UDACS) FOR WATER AND STORM MAIN CROSSING AND CLEARANCES.

SOILS NOTE:
FOR SOILS INFORMATION, REFERENCE SOILS STUDY
BY: ANGLE ENGINEERING
PROJECT NUMBER: 26157-1
DATED: AUGUST 19, 2013

FOR LINE & CURVE TABLE SEE SHEET PP1

APPROVED FOR CONSTRUCTION
M. Dishafi FOR DJM
LAS VEGAS VALLEY WATER DISTRICT ENGINEERING SERVICES MANAGER
PROJECT NO. 116987 DATE: 12/04/14 Replot
1ST APPROVED 9/10/14
CLV #54192 107500?

NO.	DATE	DESCRIPTION	BY
1	12.1.14	REVISION RELOCATING HYDRANT ON PIONEER WAY, ADDING PROPOSED ASPHALT TO GRAND TETON, REMOVED 45 BENDS, AND REALIGNED WATER UNDER PROPOSED PAVEMENT, ADDED SOUTHWEST GAS PLANS.	

JOB NUMBER: 63-001
DRAWN BY: MK
DESIGNED BY: BGD
CHECKED BY: JRM
DATE: 8/2014

PP3 11/20

PLAN & PROFILE - GRAND TETON 3
VERONA ESTATES
RICHMOND AMERICAN HOMES OF NV

ADVANTAGE CIVIL DESIGN GROUP, LLP
2920 N. GREEN VALLEY PKWY. BLDG.4 STE. #422 HENDERSON, NEVADA 89014
Office: 702.492.2224
Fax: 702.436.2224
Email: mail@advantagecivil-nv.com
CIVIL ENGINEERING CONSULTING PLANNING

BRANDON DOTY, CIVIL, No. 20002, EXP. 12/31/14, REGISTERED PROFESSIONAL ENGINEER, STATE OF NEVADA 12/2/14

cchaffin PLOT DATE: 12-02-14 PLOT TIME: 15:15:14