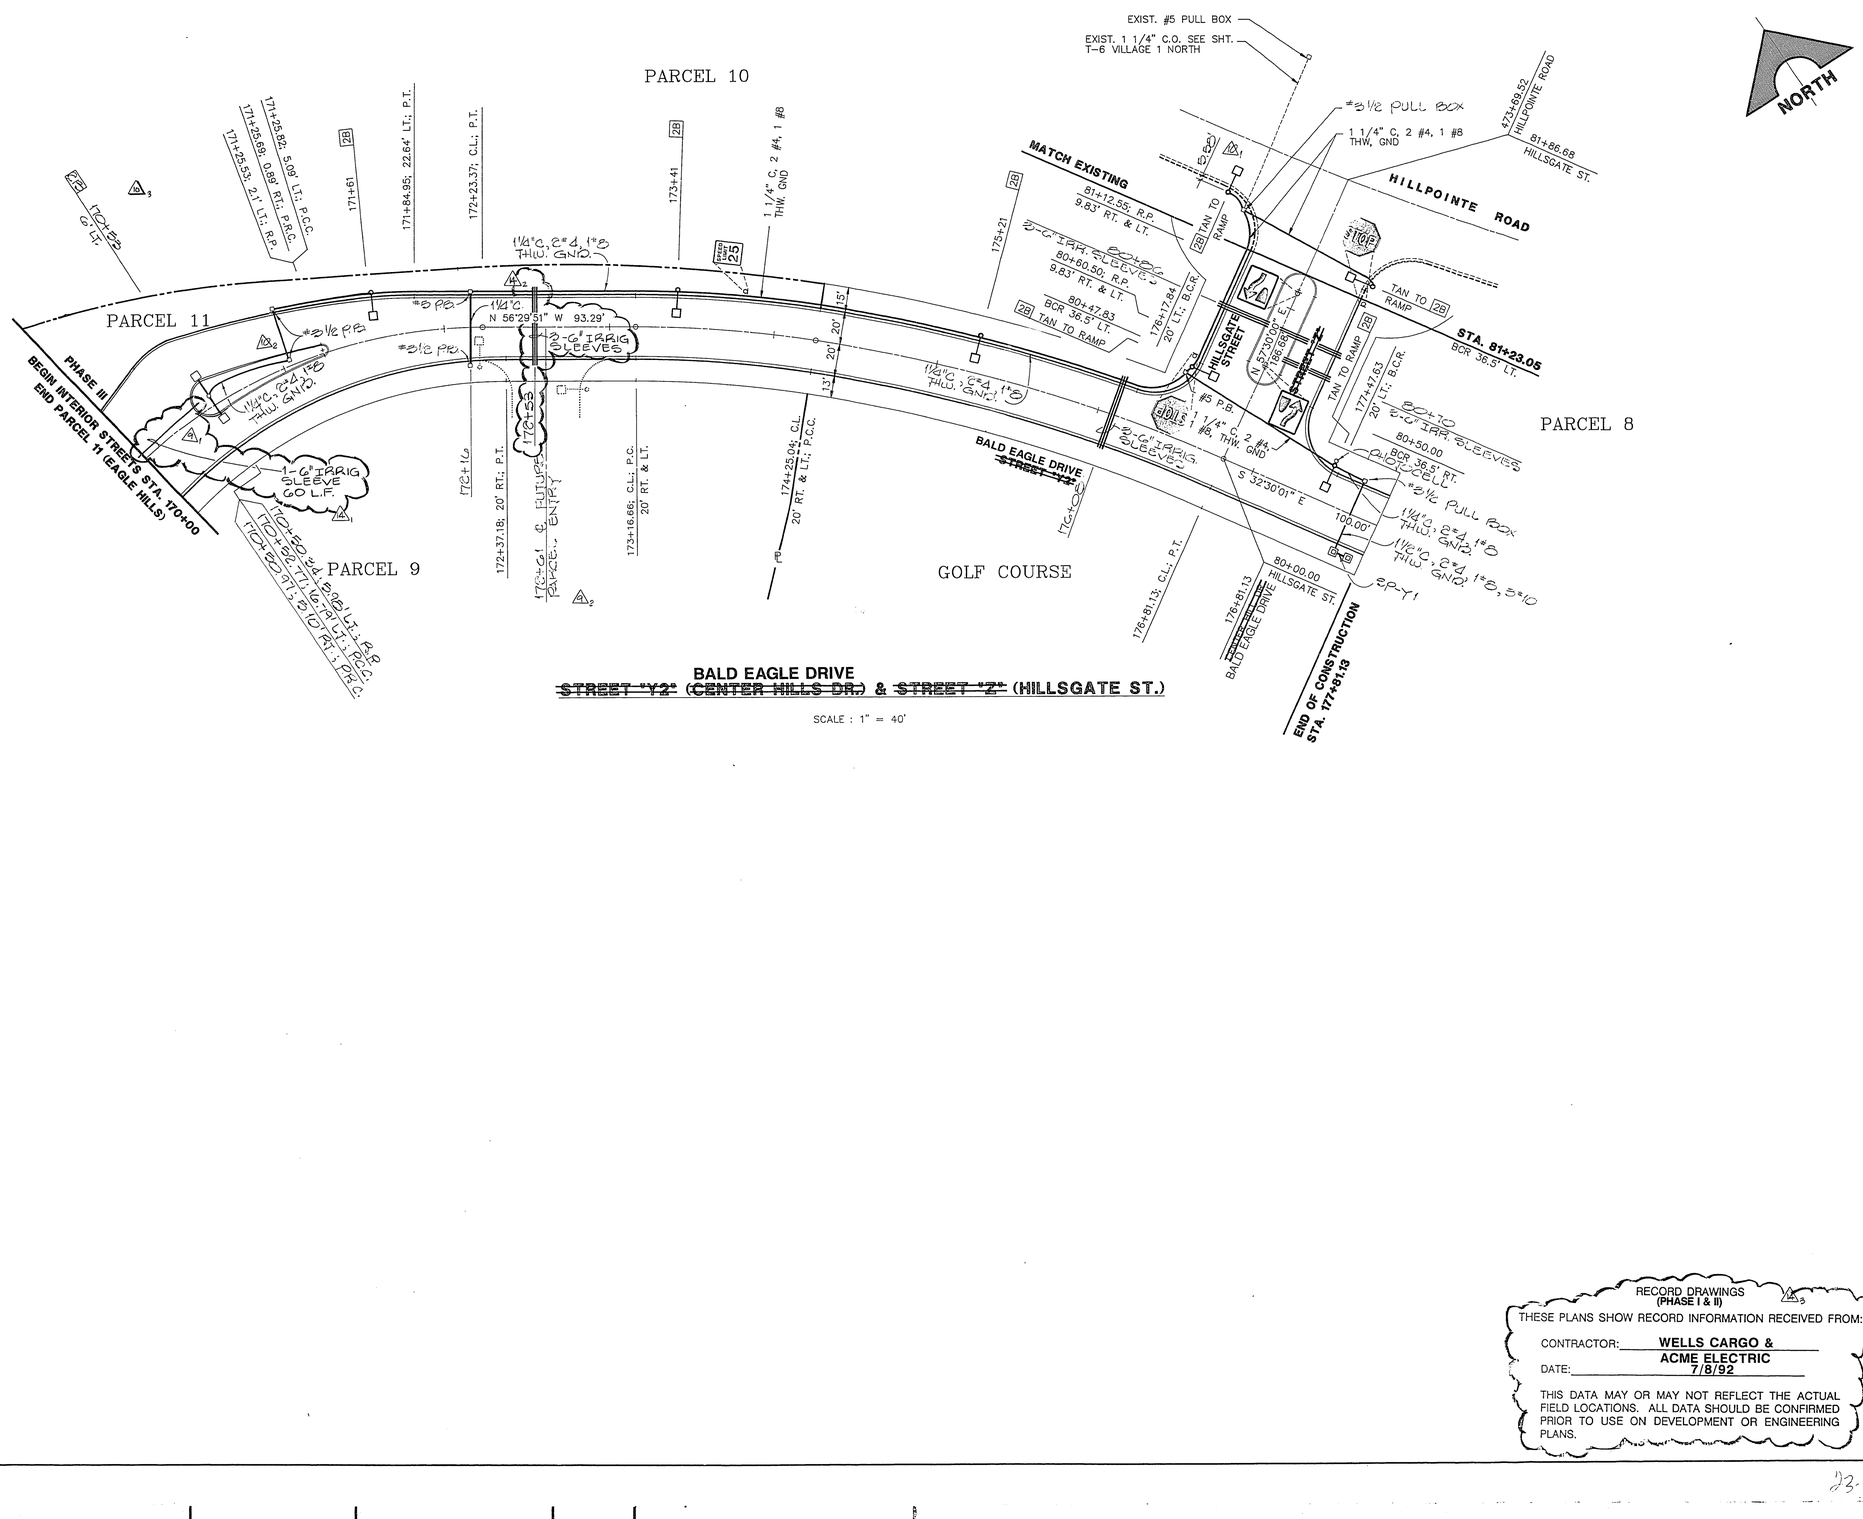

BALD EAGLE DRIVE
~~STREET "Y2"~~ (~~CENTER HILLS DR.~~) & ~~STREET "Z"~~ (HILLSGATE ST.)

SCALE : 1" = 40'

RECORD DRAWINGS (PHASE I & II)

THESE PLANS SHOW RECORD INFORMATION RECEIVED FROM:

CONTRACTOR: WELLS CARGO & ACME ELECTRIC

DATE: 7/8/92

THIS DATA MAY OR MAY NOT REFLECT THE ACTUAL FIELD LOCATIONS. ALL DATA SHOULD BE CONFIRMED PRIOR TO USE ON DEVELOPMENT OR ENGINEERING PLANS.

REV.	DATE	DESCRIPTION
3	7/8/92	RECORD DRAWINGS KJ 11/14/92
2	12/11/91	REVISION
1	6/13/91	REVISIONS
0	4/11/91	REVISION C.L.V. COMMENTS

RECOMMENDED: JOHN P. NAMES 2730 R.P.E. NO. 5/1/91 DATE

G.C. WALLACE, INC.
Engineering/Architecture 1555 SOUTH RAINBOW BLVD/LAS VEGAS, NEVADA 89102

HOWARD HUGHES PROPERTIES
SUMMERLIN - VILLAGE 1 SOUTH
~~STREET "Y2" (CENTER HILLS DRIVE)~~
~~STREET "Z"~~ (HILLSGATE STREET)
BALD EAGLE DRIVE
STREET LIGHTS, STRIPING & SIGNS

SHEET
T-5
SHT 43 OF 44

QT 10V275 03-30-91

23.362 107-V1815