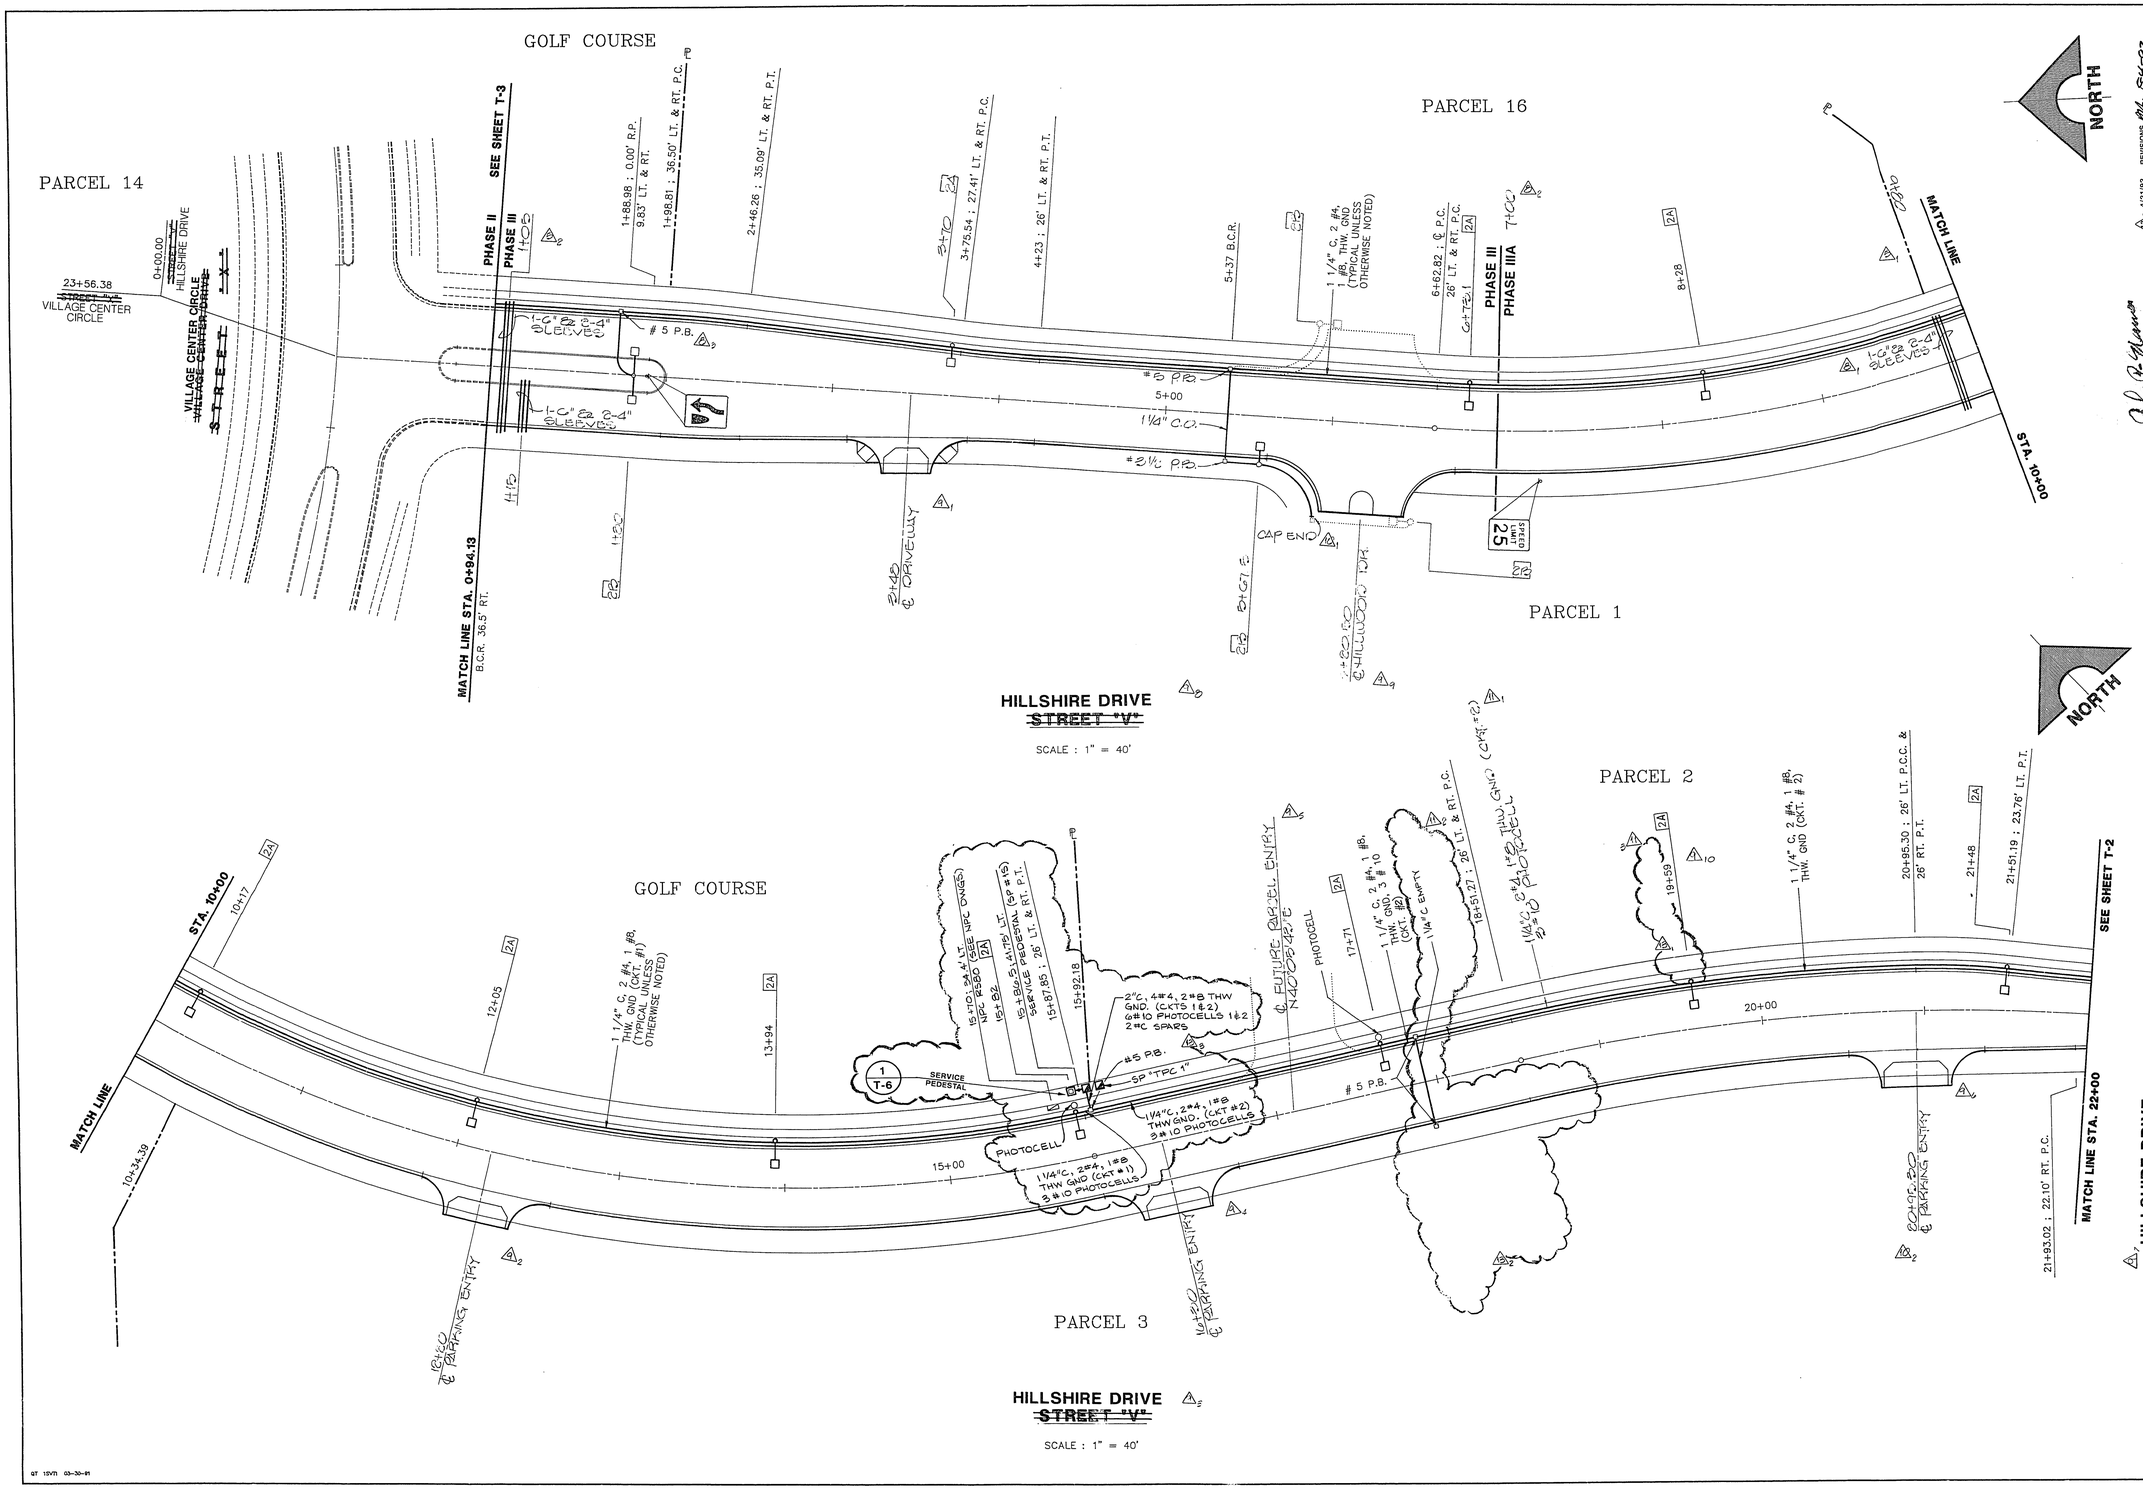

REV.	DATE	REVISION / C.L.V. COMMENTS DESCRIPTION
1	6/6/91	REVISIONS
2	8/27/91	REV. AS PER C.L.V.
3	1/20/92	REV. AS PER C.L.V.
4	4/21/92	REVISIONS

RECOMMENDED 1-1-91

JOHN P. NAMES — R.P.E. NO. 2730 — DATE

G.C. WALLACE, INC.
Engineering/Architecture
1555 SOUTH RAINBOW BLVD./LAS VEGAS, NEVADA 89102

HILLSHIRE DRIVE
HOWARD HUGHES PROPERTIES
SUMMERLIN - VILLAGE 1 SOUTH
~~STREET "V"~~
STREET LIGHTS, STRIPING & SIGNS
STA. 0+00 TO 22+00

SHEET T-1

SHT 39 OF 44

QT 15VTI 03-30-91

23-3-26 107-V 1815