



GENERAL NOTES

- ALL CONSTRUCTION, MATERIALS AND DETAILS FOR THIS PROJECT SHALL BE IN ACCORDANCE WITH THE CONTRACT DOCUMENTS, DRAWINGS, SUMMERLIN IMPROVEMENT STANDARDS, AND THE UNIFORM STANDARD SPECIFICATIONS FOR PUBLIC WORKS' CONSTRUCTION, OFFSITE IMPROVEMENTS, CLARK COUNTY AREA, NEVADA, 1986.
- 48 HOURS PRIOR TO THE START OF CONSTRUCTION, THE CONTRACTOR SHALL CONTACT:
 - LAS VEGAS VALLEY WATER DISTRICT PHONE 870-2011
 - NEVADA POWER COMPANY PHONE 1-800-227-2600
 - CENTRAL TELEPHONE COMPANY PHONE 1-800-227-2600
 - SOUTHWEST GAS CORPORATION PHONE 365-2296
- LOCATIONS OF UNDERGROUND UTILITIES SHOWN ON THE DRAWINGS WERE OBTAINED FROM INFORMATION RECEIVED FROM THE APPLICABLE UTILITY COMPANIES. NEITHER THE OWNER NOR ENGINEER ASSUMES ANY RESPONSIBILITY FOR EXISTING UTILITIES OR STRUCTURES NOT SHOWN, OR NOT IN THE LOCATIONS SHOWN ON THE DRAWINGS. CONTRACTOR TO VERIFY THE EXACT LOCATION OF UTILITIES PRIOR TO START OF CONSTRUCTION. THE CONTRACTOR'S RESPONSIBILITY REGARDING UTILITIES SHALL BE AS REQUIRED UNDER SECTION 107.17 OF THE UNIFORM STANDARD SPECIFICATIONS FOR CLARK COUNTY AREA, NEVADA AND AS PROVIDED IN THE SPECIFICATIONS, THE CONTRACTOR SHALL USE EXTREME CAUTION WHEN WORKING OVER OR NEAR THE EXISTING GAS MAINS.
- THE CONTRACTOR SHALL TAKE ALL PRECAUTIONARY MEASURES NECESSARY TO PROTECT EXISTING IMPROVEMENTS, WHICH ARE TO REMAIN IN PLACE, FROM DAMAGE AND ALL SUCH IMPROVEMENTS OR STRUCTURES DAMAGED BY THE CONTRACTOR'S OPERATIONS SHALL BE REPAIRED OR RECONSTRUCTED SATISFACTORY TO THE ENGINEER AT THE EXPENSE OF THE CONTRACTOR.
- THE CONTRACTOR SHALL NOT REMOVE TREES, SHRUBS, LAWNS, WALLS, FENCES, SIGNS, STRUCTURES, LIGHTS, OR ANY EXISTING IMPROVEMENTS OUTSIDE OF STREET RIGHT-OF-WAY, EXCEPT WHERE REQUIRED TO DO SO BY THE CONTRACT DRAWINGS OR BY THE ENGINEER.
- TREES, SHRUBS, LAWNS, WALLS, FENCES, SIGNS, STRUCTURES, LIGHTS AND OTHER EXISTING IMPROVEMENTS WITHIN STREET RIGHTS-OF-WAY SHALL BE REMOVED WHERE SHOWN ON THE CONTRACT DRAWINGS, AND AS REQUIRED BY THE ENGINEER.
- REPLACEMENT, RELOCATION OR RECONSTRUCTION OF ALL EXISTING IMPROVEMENTS INCLUDING SPRINKLER SYSTEMS, LAWNS, FENCES, WALLS, SIGNS, STEPS, SIDEWALKS, DRIVENAYS, LAWN LIGHTS, AND ALL OTHER ITEMS APPLICABLE TO THIS CONTRACT SHALL BE AS REQUIRED BY THE ENGINEER.
- THE CONTRACTOR SHALL BACKFILL AND FINE GRADE ALL CUT OR FILL SLOPES TO MATCH EXISTING CONDITIONS TO THE SATISFACTION OF THE ENGINEER. WHERE EXISTING LAWNS ARE DAMAGED BY THE CONTRACTOR'S OPERATIONS, THE CONTRACTOR SHALL RE-SEED AND/OR SOD THE AFFECTED AREA TO A CONDITION EQUAL TO OR BETTER THAN EXISTED PRIOR TO CONSTRUCTION.
- ALL BARRICADING AND TEMPORARY TRAFFIC CONTROL DEVICES OR METHODS USED DURING CONSTRUCTION SHALL BE IN ACCORDANCE WITH THE "NEVADA TRAFFIC CONTROL MANUAL," 1985, PUBLISHED BY THE STATE OF NEVADA, DEPARTMENT OF HIGHWAYS, EXCEPT AS OTHERWISE PROVIDED IN THE CONTRACT SPECIFICATIONS OR AS REQUIRED BY THE ENGINEER.
- AT THE TIME OF PRE-CONSTRUCTION CONFERENCE, THE CONTRACTOR SHALL FURNISH, FOR APPROVAL, A TRAFFIC BARRICADING PLAN AND THE METHOD OF MAINTAINING PUBLIC CONVEYANCE AND SAFETY THROUGHOUT THE CONSTRUCTION AREA. TRAFFIC BARRICADING PLANS SHALL COMPLY WITH APPLICABLE PORTIONS OF SECTIONS 624 AND 625 OF THE STANDARD SPECIFICATIONS. THE TRAFFIC CONTROL MANUAL AND APPLICABLE CITY ORDINANCES.
- THE CONTRACTOR SHALL NOT BE RESPONSIBLE FOR THE VERTICAL ADJUSTMENT OF EXISTING SANITARY, WATER AND STORM SEWER MANHOLES TO THE FINAL FINISH GRADES EXCEPT AS NOTED ON THE CONTRACT DRAWINGS, AND IN ACCORDANCE WITH SECTION 609 OF THE "STANDARD SPECIFICATIONS," AND ANY VERTICAL ADJUSTMENTS OF WATER VALVE BOXES AND OTHER APPURTENANCES SHALL BE IN ACCORDANCE WITH THE DETAILS SHOWN ON THE CONTRACT DRAWINGS.
- REFERENCE IS MADE TO THE "SUMMERLIN IMPROVEMENT STANDARDS" FOR CONSTRUCTION DETAILS. STANDARDS AVAILABLE FROM OWNER.
- NOTICE: GRADING AUTHORIZED ONLY AFTER PERMITTEE'S FULL COMPLIANCE WITH FEDERAL ENDANGERED SPECIES ACT.
- THE PROJECT IS TO BE CONSTRUCTED IN 3 PHASES (PHASE I AND PHASE II & III) SO THAT EACH PHASE MAY BE APPROVED WITH A LETTER OF ACCEPTANCE FOR EACH PHASE BY THE APPROPRIATE AGENCIES.
- ALL FUTURE PARCEL ENTRY ROADS ARE SHOWN FOR REFERENCE AND INTENDED DEVELOPMENT ONLY. FINAL LOCATIONS TO BE ESTABLISHED BY PARCEL DEVELOPMENT SUBMITTALS AND APPROVALS THROUGH SUMMERLIN AND CL.V.

LEGEND & ABBREVIATIONS

1	DETAIL DRAWING NUMBER	UTILITIES	
1	DRAWING NUMBER FOR DETAIL DRAWN ON SAME SHEET	14" WATERLINE	
1	DRAWING NUMBER FOR DETAIL WITH REFERENCE TO THE SHEET IT IS DRAWN ON	W	WATER LINE
WS-7	DRAWING NUMBER FOR DETAIL PER SUMMERLIN IMPROVEMENTS STANDARDS	S	SEWER LINE
D1.D2	DRAWING NUMBER FOR DETAIL PER SUMMERLIN IMPROVEMENTS STANDARDS	G	GAS LINE
S	INDICATES CONSTRUCTION NOTE	T	TELEPHONE LINE
I	INDICATES REMOVAL NOTE	E	ELECTRICAL LINE
A	INDICATES REMOVAL NOTE	SD	STORM DRAIN
EMBANKMENT		DG	DESIGNED GRADE
TOP	PROPOSED	FG	FINISHED GRADE
BOT	BY SEPARATE CONTRACT	RG	ROUGH GRADE
	EXISTING	TC	TOP OF CURB

LEGEND & ABBREVIATIONS SPECIFIED IN THE "SUMMERLIN IMPROVEMENT STANDARDS"-AUGUST 1988 WILL BE UTILIZED FOR ANY LEGEND & ABBREVIATIONS REQUIRED WHICH ARE NOT SHOWN.

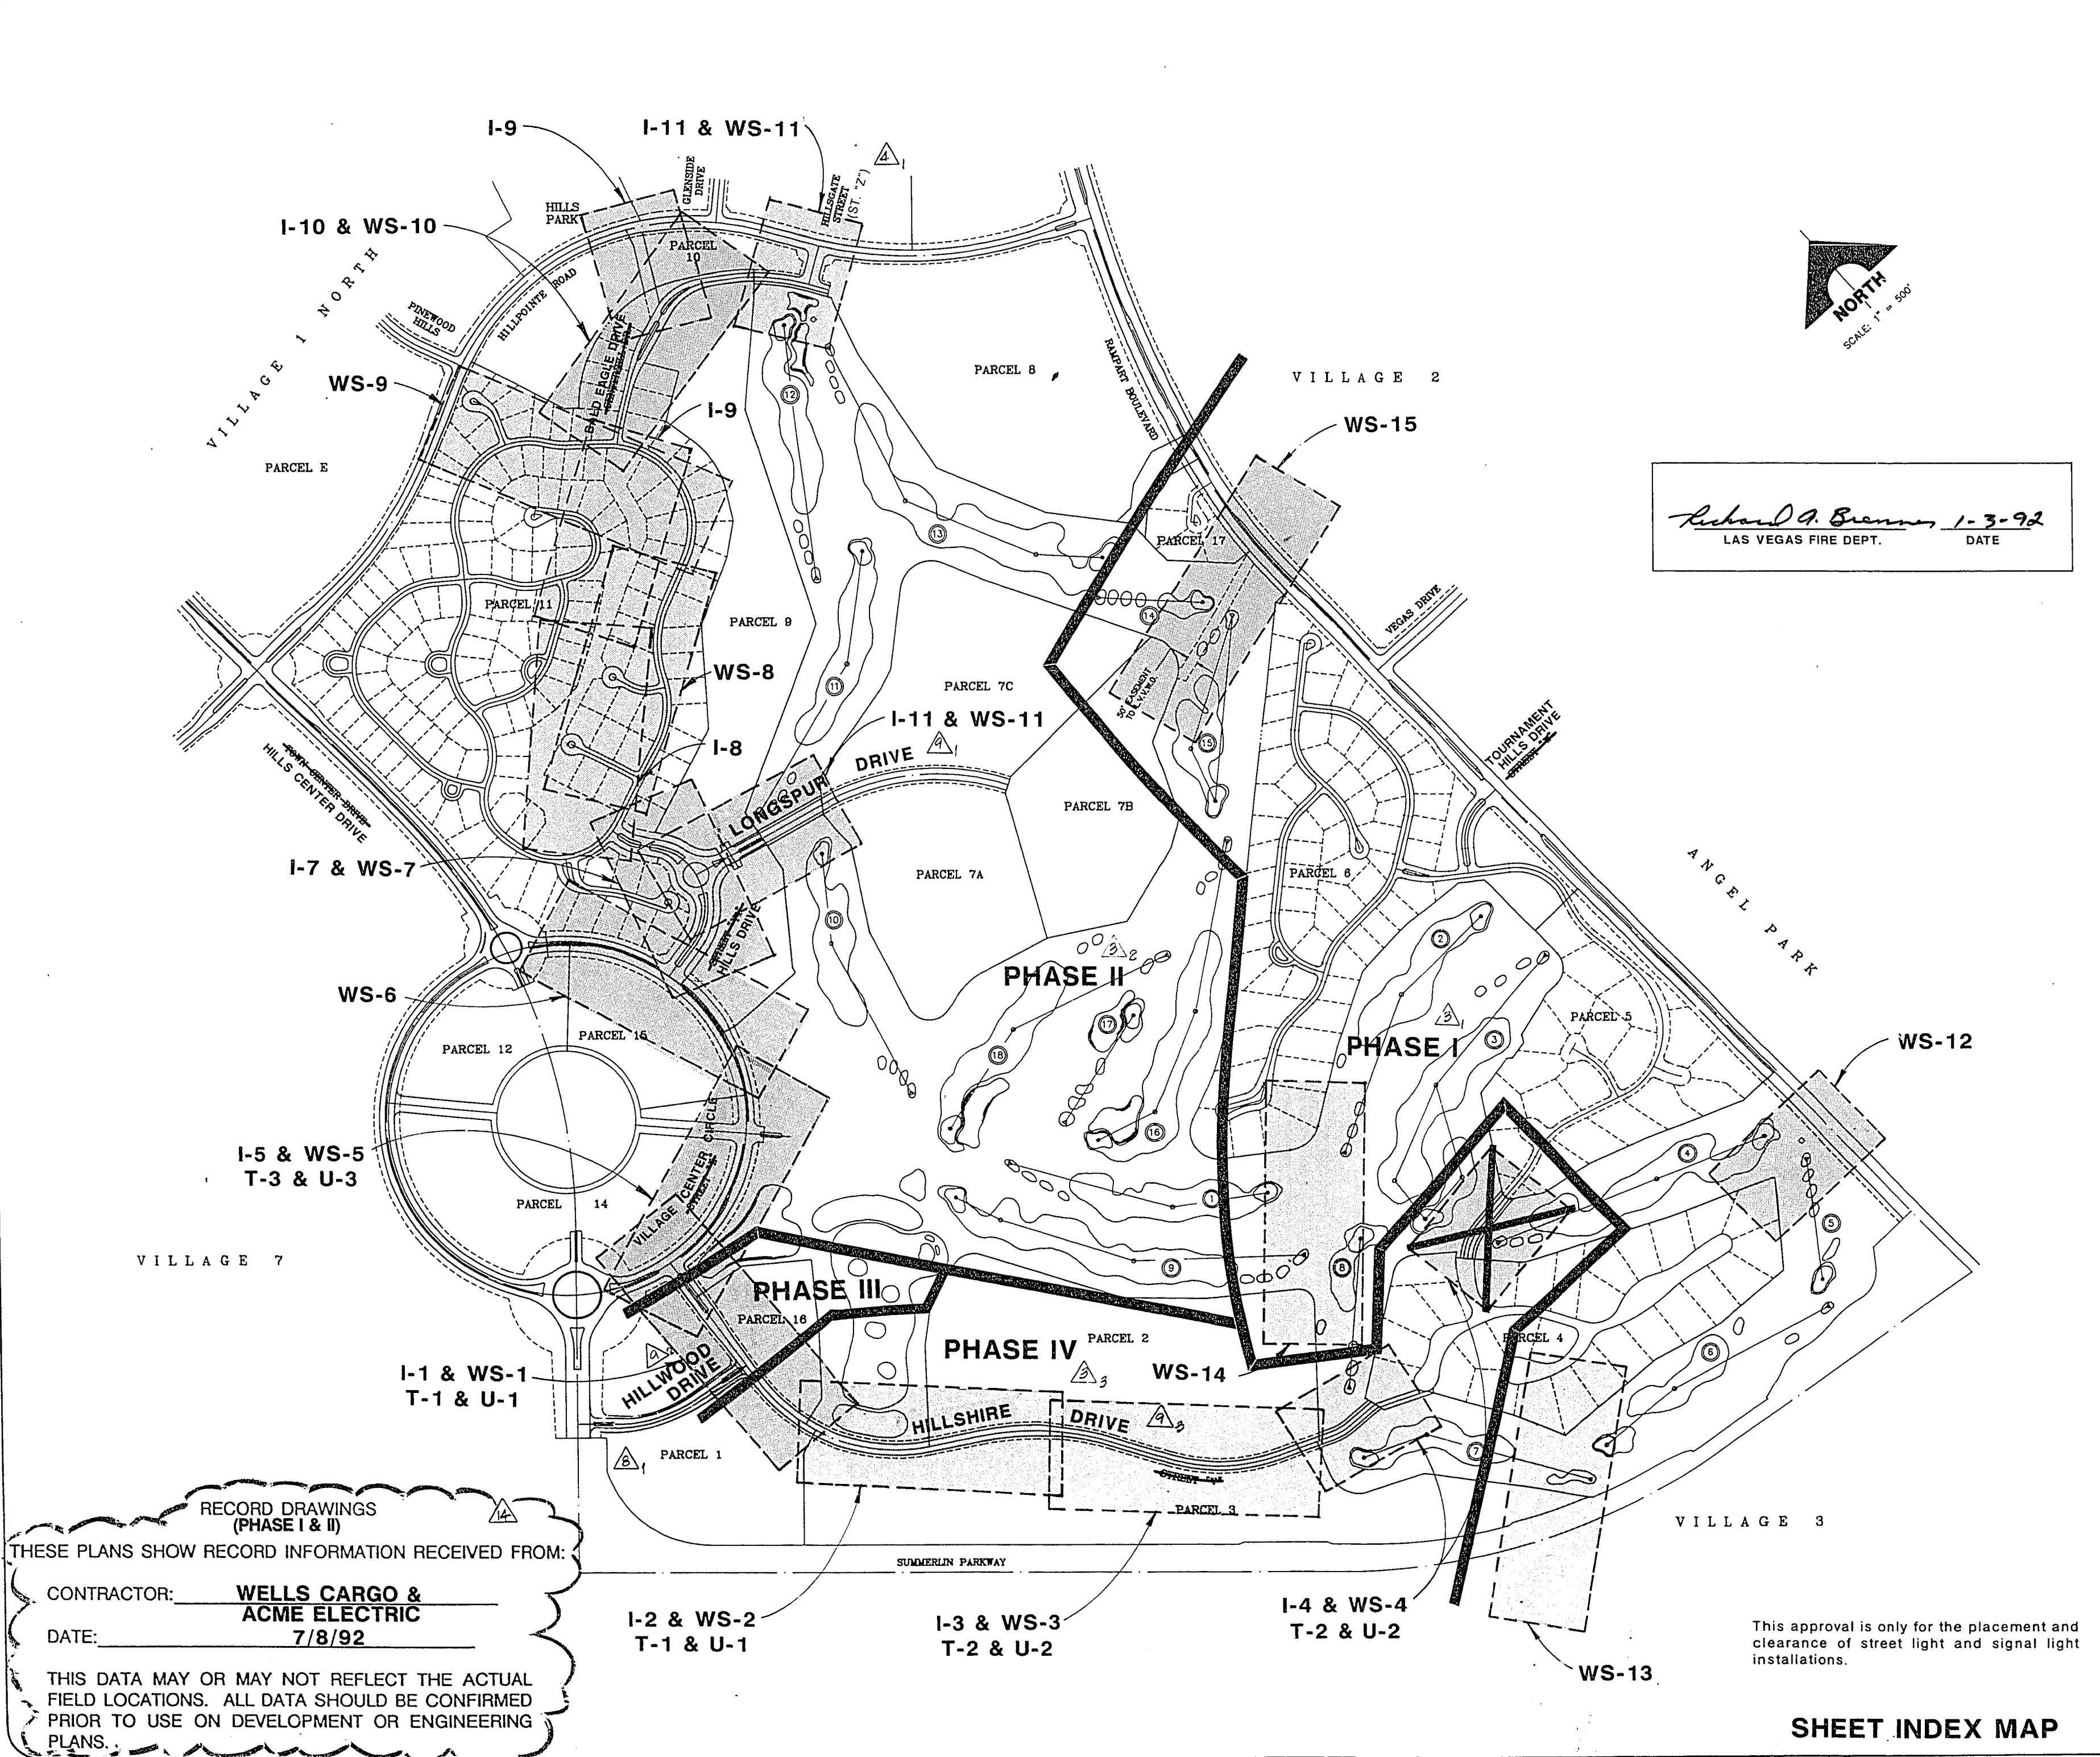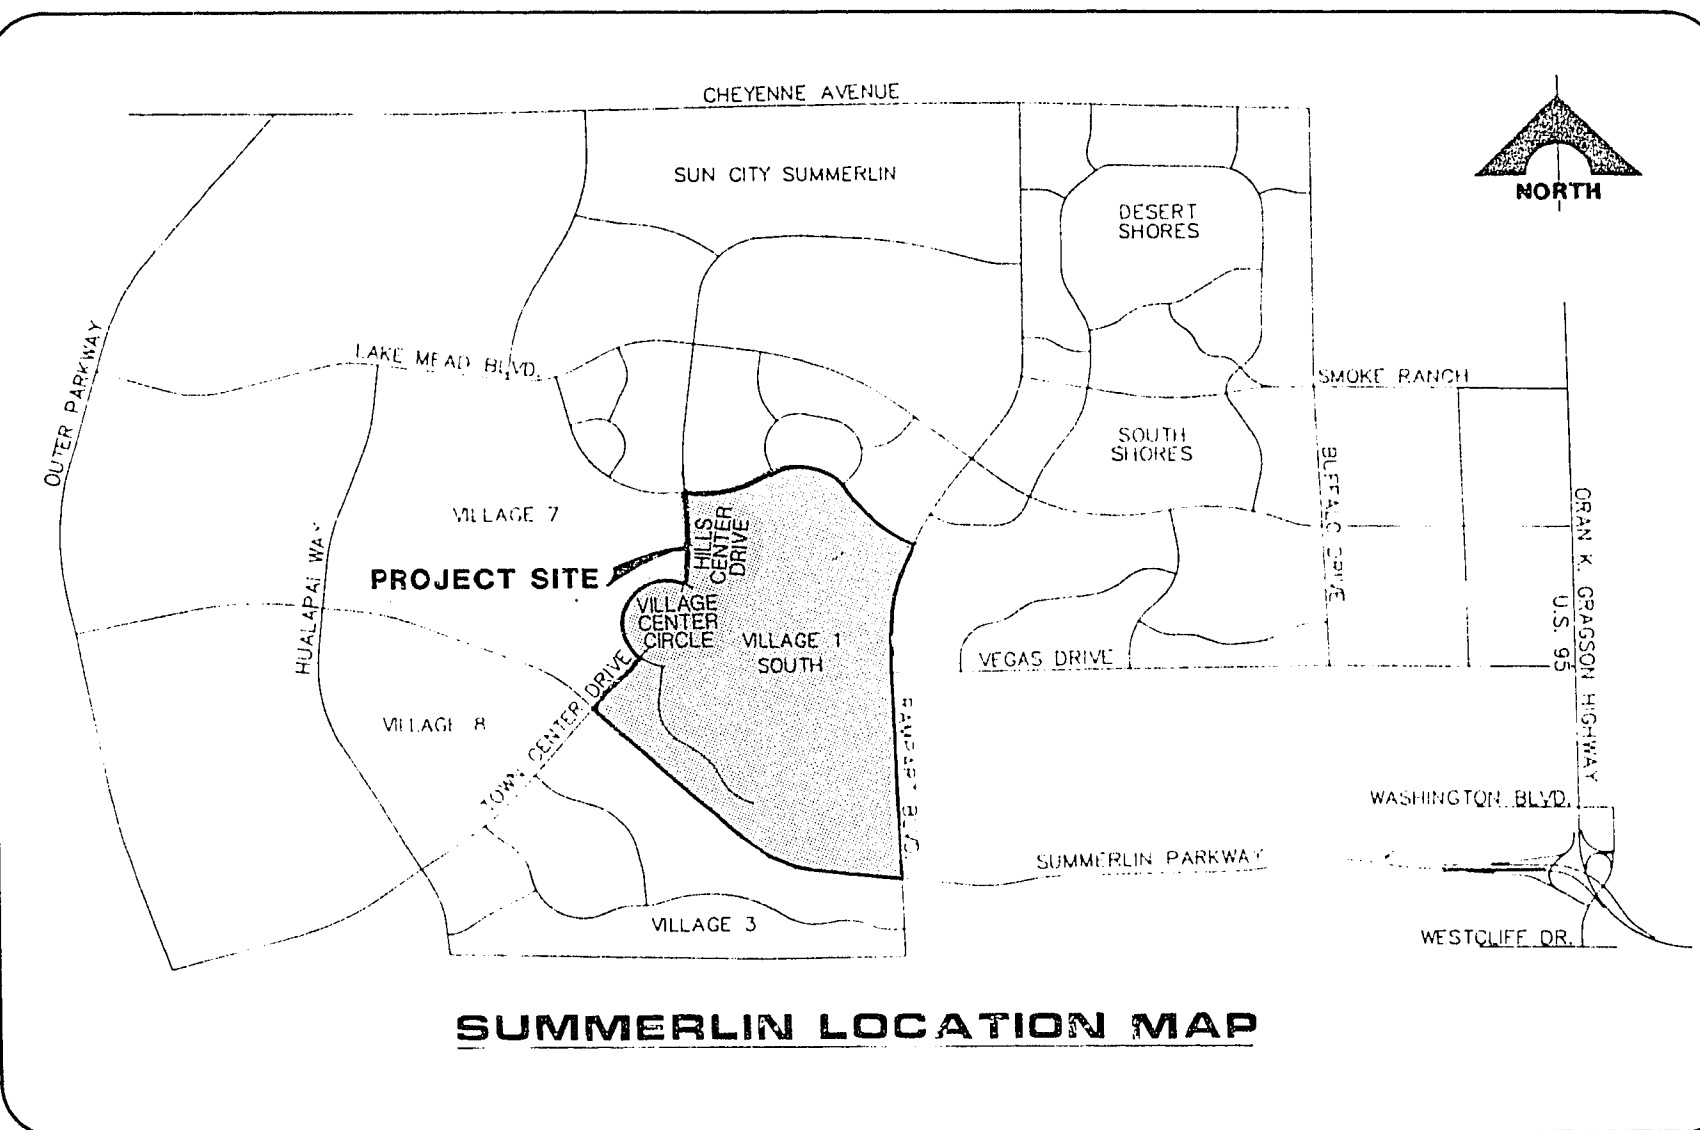

INDEX OF DRAWINGS

1	COVER SHEET
2	PROJECT DATA SHEET
IMPROVEMENTS STORM DRAIN	
I-0	STORM DRAIN MAP
I-1	STREET "A" BEG TO 10+00
I-2	STREET "A" 10+00 TO 22+00
I-3	STREET "A" 22+00 TO 34+00
I-4	STREET "A" 34+00 TO END
I-5	STREET "A" 28+00 TO 14+00
I-6	STREET "A" 14+00 TO BEG
I-7	STREET "A" BEG TO 305+00
I-8	STREET "A" 305+00 TO 317+00
I-9	STREET "A" 317+00 TO 329+00
I-10	STREET "A" 329+00 TO END
I-11	STREET "Z" STREET "W"
I-12	STREET SECTIONS
I-13	STORM DRAIN SECTIONS
I-14	STORM DRAIN SECTIONS
I-15	STORM DRAIN SECTIONS
WATER AND SEWER	
W-0	WATER MAP
W-1	SEWER MAP
WS-1	STREET "A" BEG TO 10+00
WS-2	STREET "A" 10+00 TO 22+00
WS-3	STREET "A" 22+00 TO 34+00
WS-4	STREET "A" 34+00 TO END
WS-5	STREET "A" 25+00 TO 14+00
WS-6	STREET "A" 14+00 TO BEG
WS-7	STREET "A" BEG TO 305+00
WS-8	STREET "A" 305+00 TO 317+00
WS-9	STREET "A" 317+00 TO 329+00
WS-10	STREET "A" 329+00 TO END
WS-11	STREET "Z" STREET "W" & PARCEL 10
WS-12	RAMPART TO PARCEL 4
WS-13	PARCEL 4 TO PARCEL 3
WS-14	PARCEL 6 TO PARCEL 2
WS-15	RAMPART TO PARCEL 7
WS-16	DETAILS
WS-17	METER DETAILS
STREET LIGHTS STRIPING AND SIGNS	
T-0	STREET LIGHTS MAP
T-1	STREET "A" BEG TO 22+00
T-2	STREET "A" 22+00 TO END
T-3	STREET "A"
T-4	STREET "A" BEG TO 317+00
T-5	STREET "A" 317+00 TO END & STREET "Z"
T-6	PANEL SCHEDULE, DETAILS & NOTES

APPROVALS CITY OF LAS VEGAS RESUBMITTAL APPROVAL

CITY ENGINEER: *[Signature]* DATE: 6-16-91

GARY A. PRESSWOOD CITY ENGINEER DATE: 7-10-90

APPROVAL FOR "I" AND "WS" DRAWINGS ONLY.

AGENCY	REVIEWED BY	DATE
NEVADA POWER CO.	<i>[Signature]</i>	7-2-90
SOUTHWEST GAS CORP.	<i>[Signature]</i>	7-6-90
CENTRAL TELEPHONE CO.	<i>[Signature]</i>	7-7-90
L.V. VALLEY WATER DIST.	<i>[Signature]</i>	6-29-90

BASIS OF BEARING

N 01°12'43" E. IS BASED ON THE NEVADA STATE GRID SYSTEM (EAST ZONE) AS DETERMINED FROM THE TRIANGULATION POINTS "RED ROCK" TO "LONE MOUNTAIN."

BENCHMARK

CHISELED IN TOP OF CURB AT END OF CURB ON WEST SIDE OF DURANGO, 250' SOUTH OF WESTCLIFF. ELEV. PER CITY OF LAS VEGAS DATUM = 2610.16

Call before you Dig.

1-800-227-2600

RECOMMENDED




























































































































































































































































































































































































