



PARCEL 2

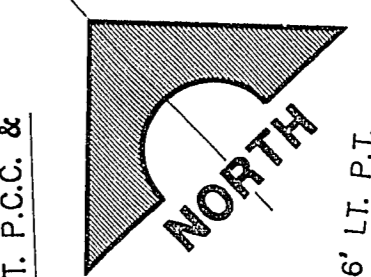

GOLF COURSE

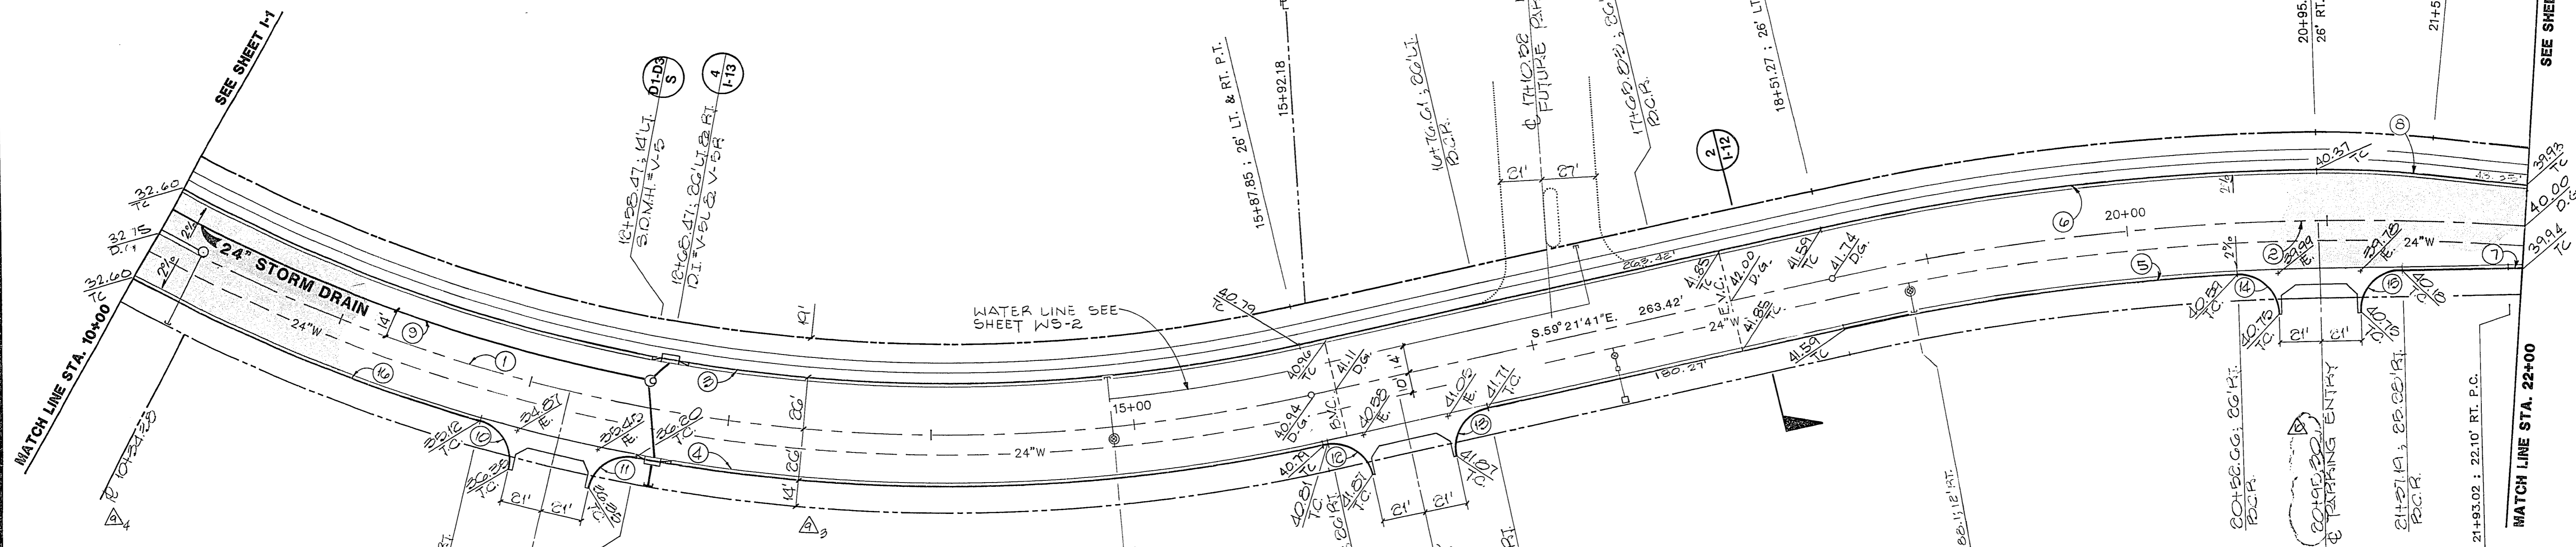


CURVE DATA

NO.	DELTA	RADIUS	LENGTH	TANGENT	DESCRIPTION
1	42°06'05"	800.00	587.85	307.90	CENTERLINE
2	16°39'03"	1200.00	348.73	175.60	CENTERLINE
3	42°06'05"	774.00	568.74	297.90	BACK OF CURB
4	23°34'03"	886.00	329.76	172.88	BACK OF CURB
5	09°26'57"	1,174.00	117.03	40.70	BACK OF CURB
6	11°39'07"	1226.00	249.32	125.09	BACK OF CURB
7	00°57'24"	411.47	6.87	3.44	BACK OF CURB
8	07°09'43"	457.00	57.13	28.60	BACK OF CURB
9	13°20'42"	786.00	202.90	120.09	STORM DRAIN
10	07°13'20"	200.00	20.45	10.08	BACK OF CURB
11	07°13'20"	200.00	20.45	10.08	BACK OF CURB
PARCEL 3
HILLSHIRE DRIVE
STREET "W"

SCALE: HORIZ. 1"=40'
VERT. 1"=10'

CONSTRUCTION NOTE:
ROUGH GRADING HAS BEEN
COMPLETED UNDER SEPARATE
CONTRACT.

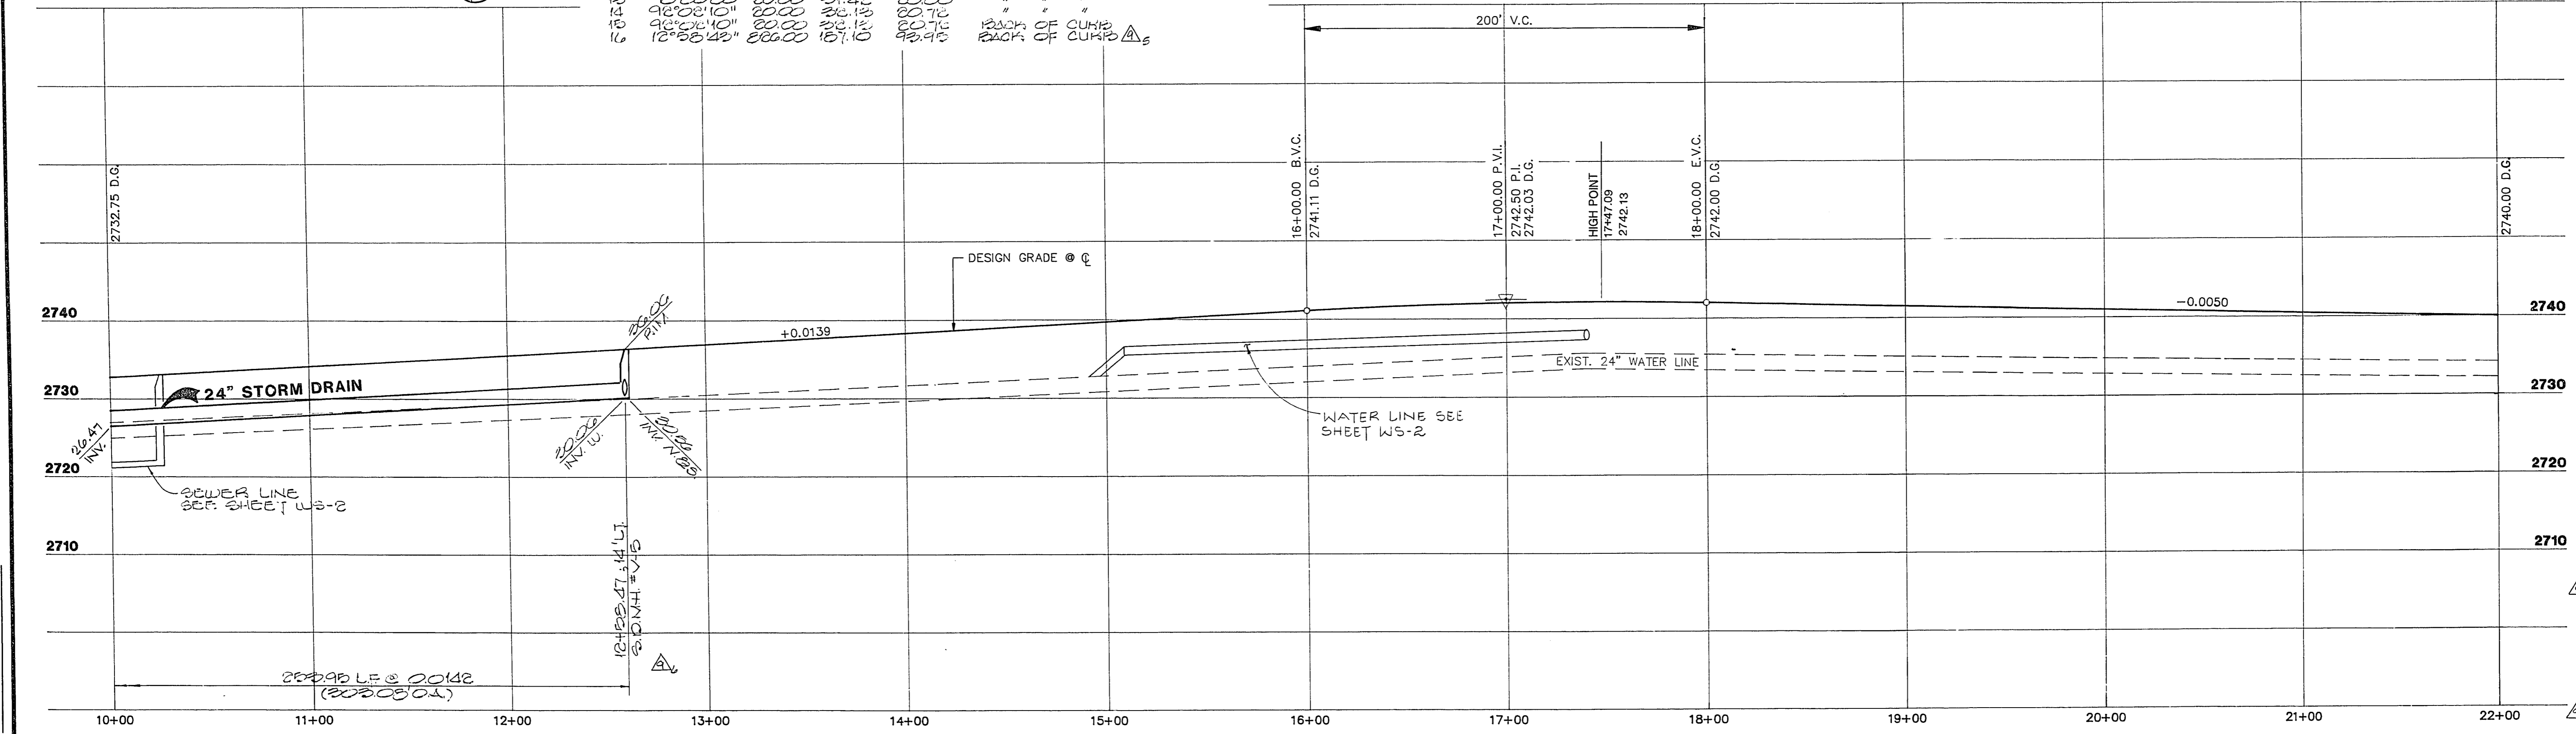

JOB NO. 620.3145

REV	DATE	DESCRIPTION
A	12/11/11	REVISION
B	01/08/12	REVISION
C	01/08/12	REVISION
D	01/08/12	REVISION / C.A.V. COMMENTS

6071
R.F.E. NO.
DATE

RECOMMENDED
G.C. WALLACE, INC.
Engineering/Architecture

1555 SOUTH RAINBOW BLVD LAS VEGAS, NEVADA 89102

HILLSHIRE DRIVE
HOWARD HUGHES PROPERTIES
SUMMERLIN VILLAGE I SOUTH
IMPROVEMENT PLANS
STA. 10+00 TO STA. 22+00

SHEET
I-2
SHT. 5 OF 44

107-V1815