


CURVE DATA

NO.	DELTA	RADIUS	LENGTH	TANGENT	DESCRIPTION
1	117°22'	1200.00	250.41	125.66	CENTERLINE
2	37°50'00"	800.00	528.65	274.94	CENTERLINE
3	06°12'19"	411.47	44.56	22.30	BACK OF CURB
4	09°20'35"	1200.00	195.68	98.05	BACK OF CURB
5	09°47'38"	1250.00	238.53	104.52	BACK OF CURB
6	37°50'00"	790.00	516.41	266.07	BACK OF CURB
7	28°10'22"	650.00	493.35	255.63	BACK OF CURB
8	21°16'18"	796.00	251.80	147.80	STORM DRAIN
9	15°56'18"	796.00	218.65	110.03	STORM DRAIN
10	04°09'28"	820.00	59.50	29.76	BACK OF CURB
11	07°12'06"	20.00	30.44	13.05	BACK OF CURB
12	07°12'06"	20.00	30.44	19.05	BACK OF CURB
13	30°38'12"	30.00	47.44	30.32	BACK OF CURB
14	30°38'12"	30.00	47.44	30.32	BACK OF CURB
15	90°00'00"	30.00	47.12	30.00	BACK OF CURB

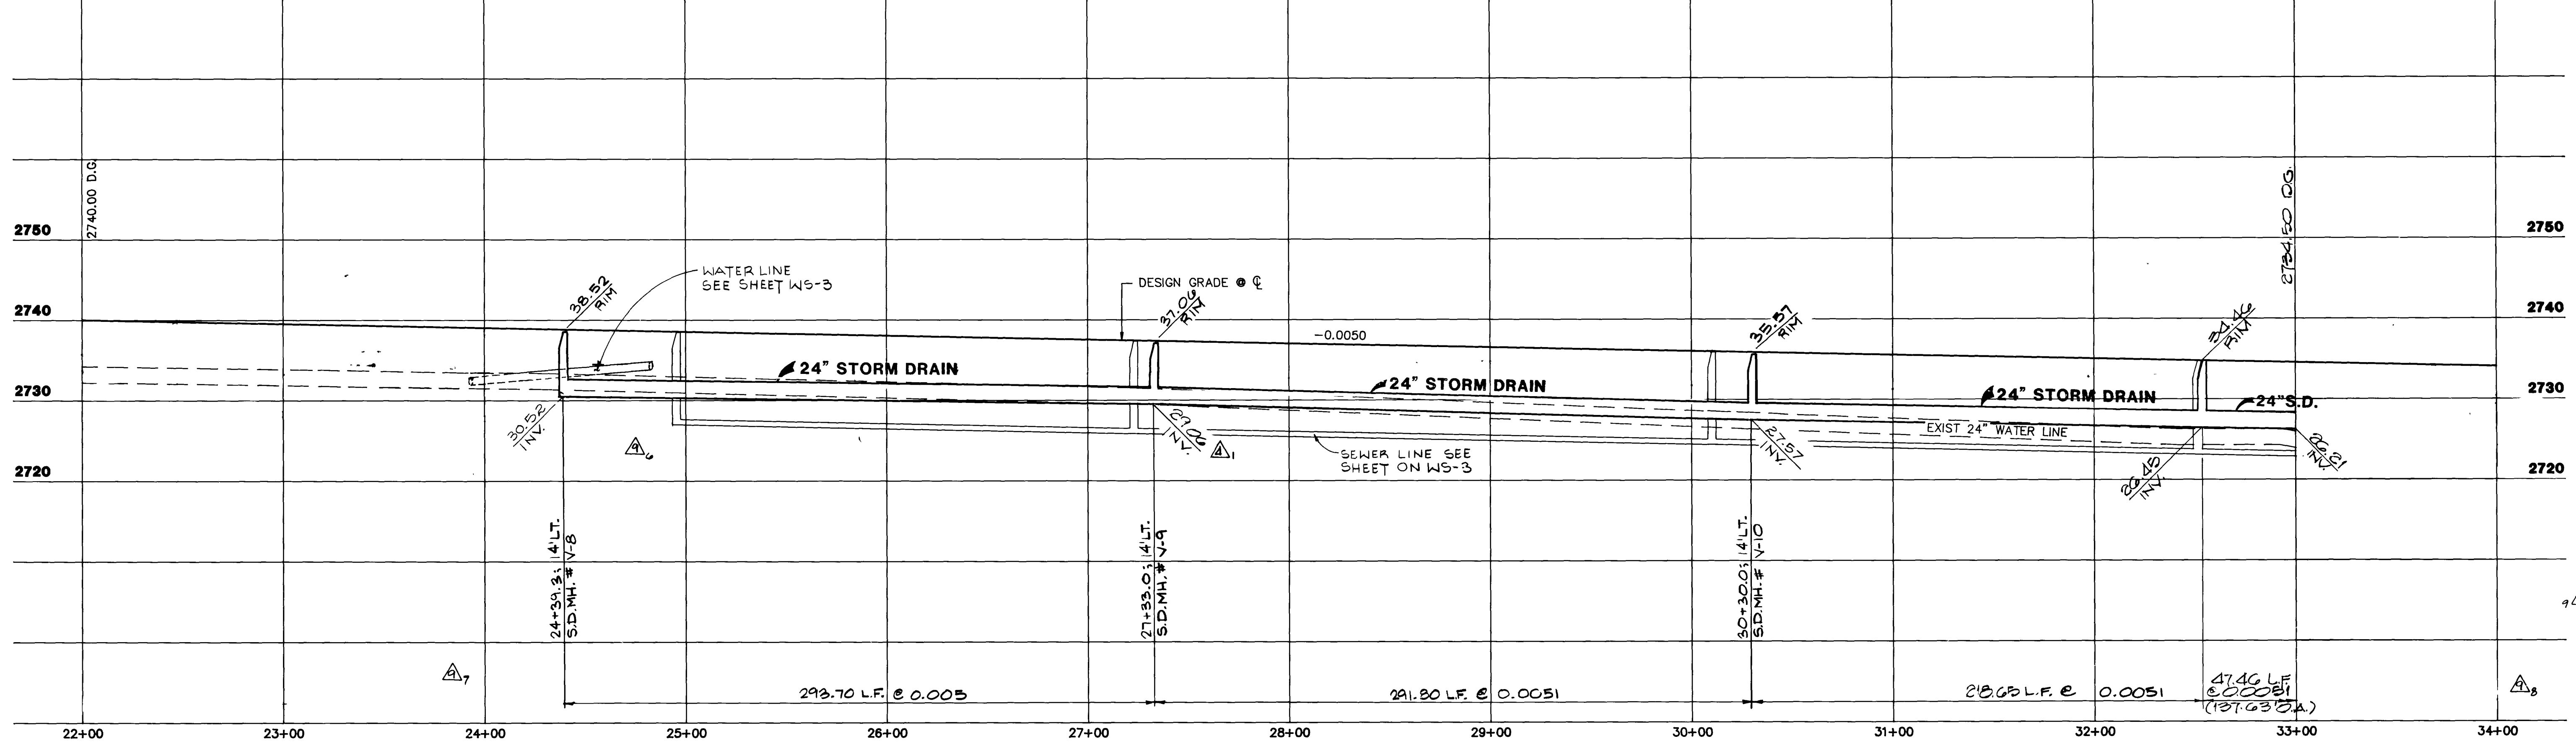

REVISION / CLY. COMMENTS


REV	DATE	DESCRIPTION
AA	1/12/23	REMOVE TEMP. P.A. @ STA. 24+00. P.A. # 1
AA	4/12/23	REVISIONS SEE WS-3
AA	7/19/23	REVISIONS SEE WS-3
AA	10/26/23	REVISIONS SEE WS-3
AA	11/16/23	REVISIONS SEE WS-3
AA	1/16/24	REVISIONS SEE WS-3
AA	1/16/24	REVISIONS SEE WS-3

1555 SOUTH RAINBOW BLVD LAS VEGAS, NEVADA 89102

G.C. WALLACE, INC.
Engineering/Architecture

1952

107-11815

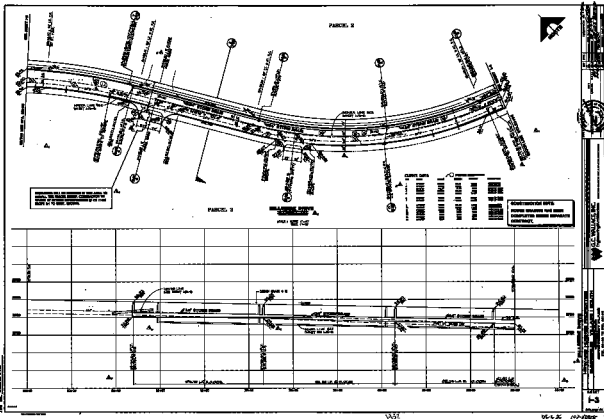




1-3