
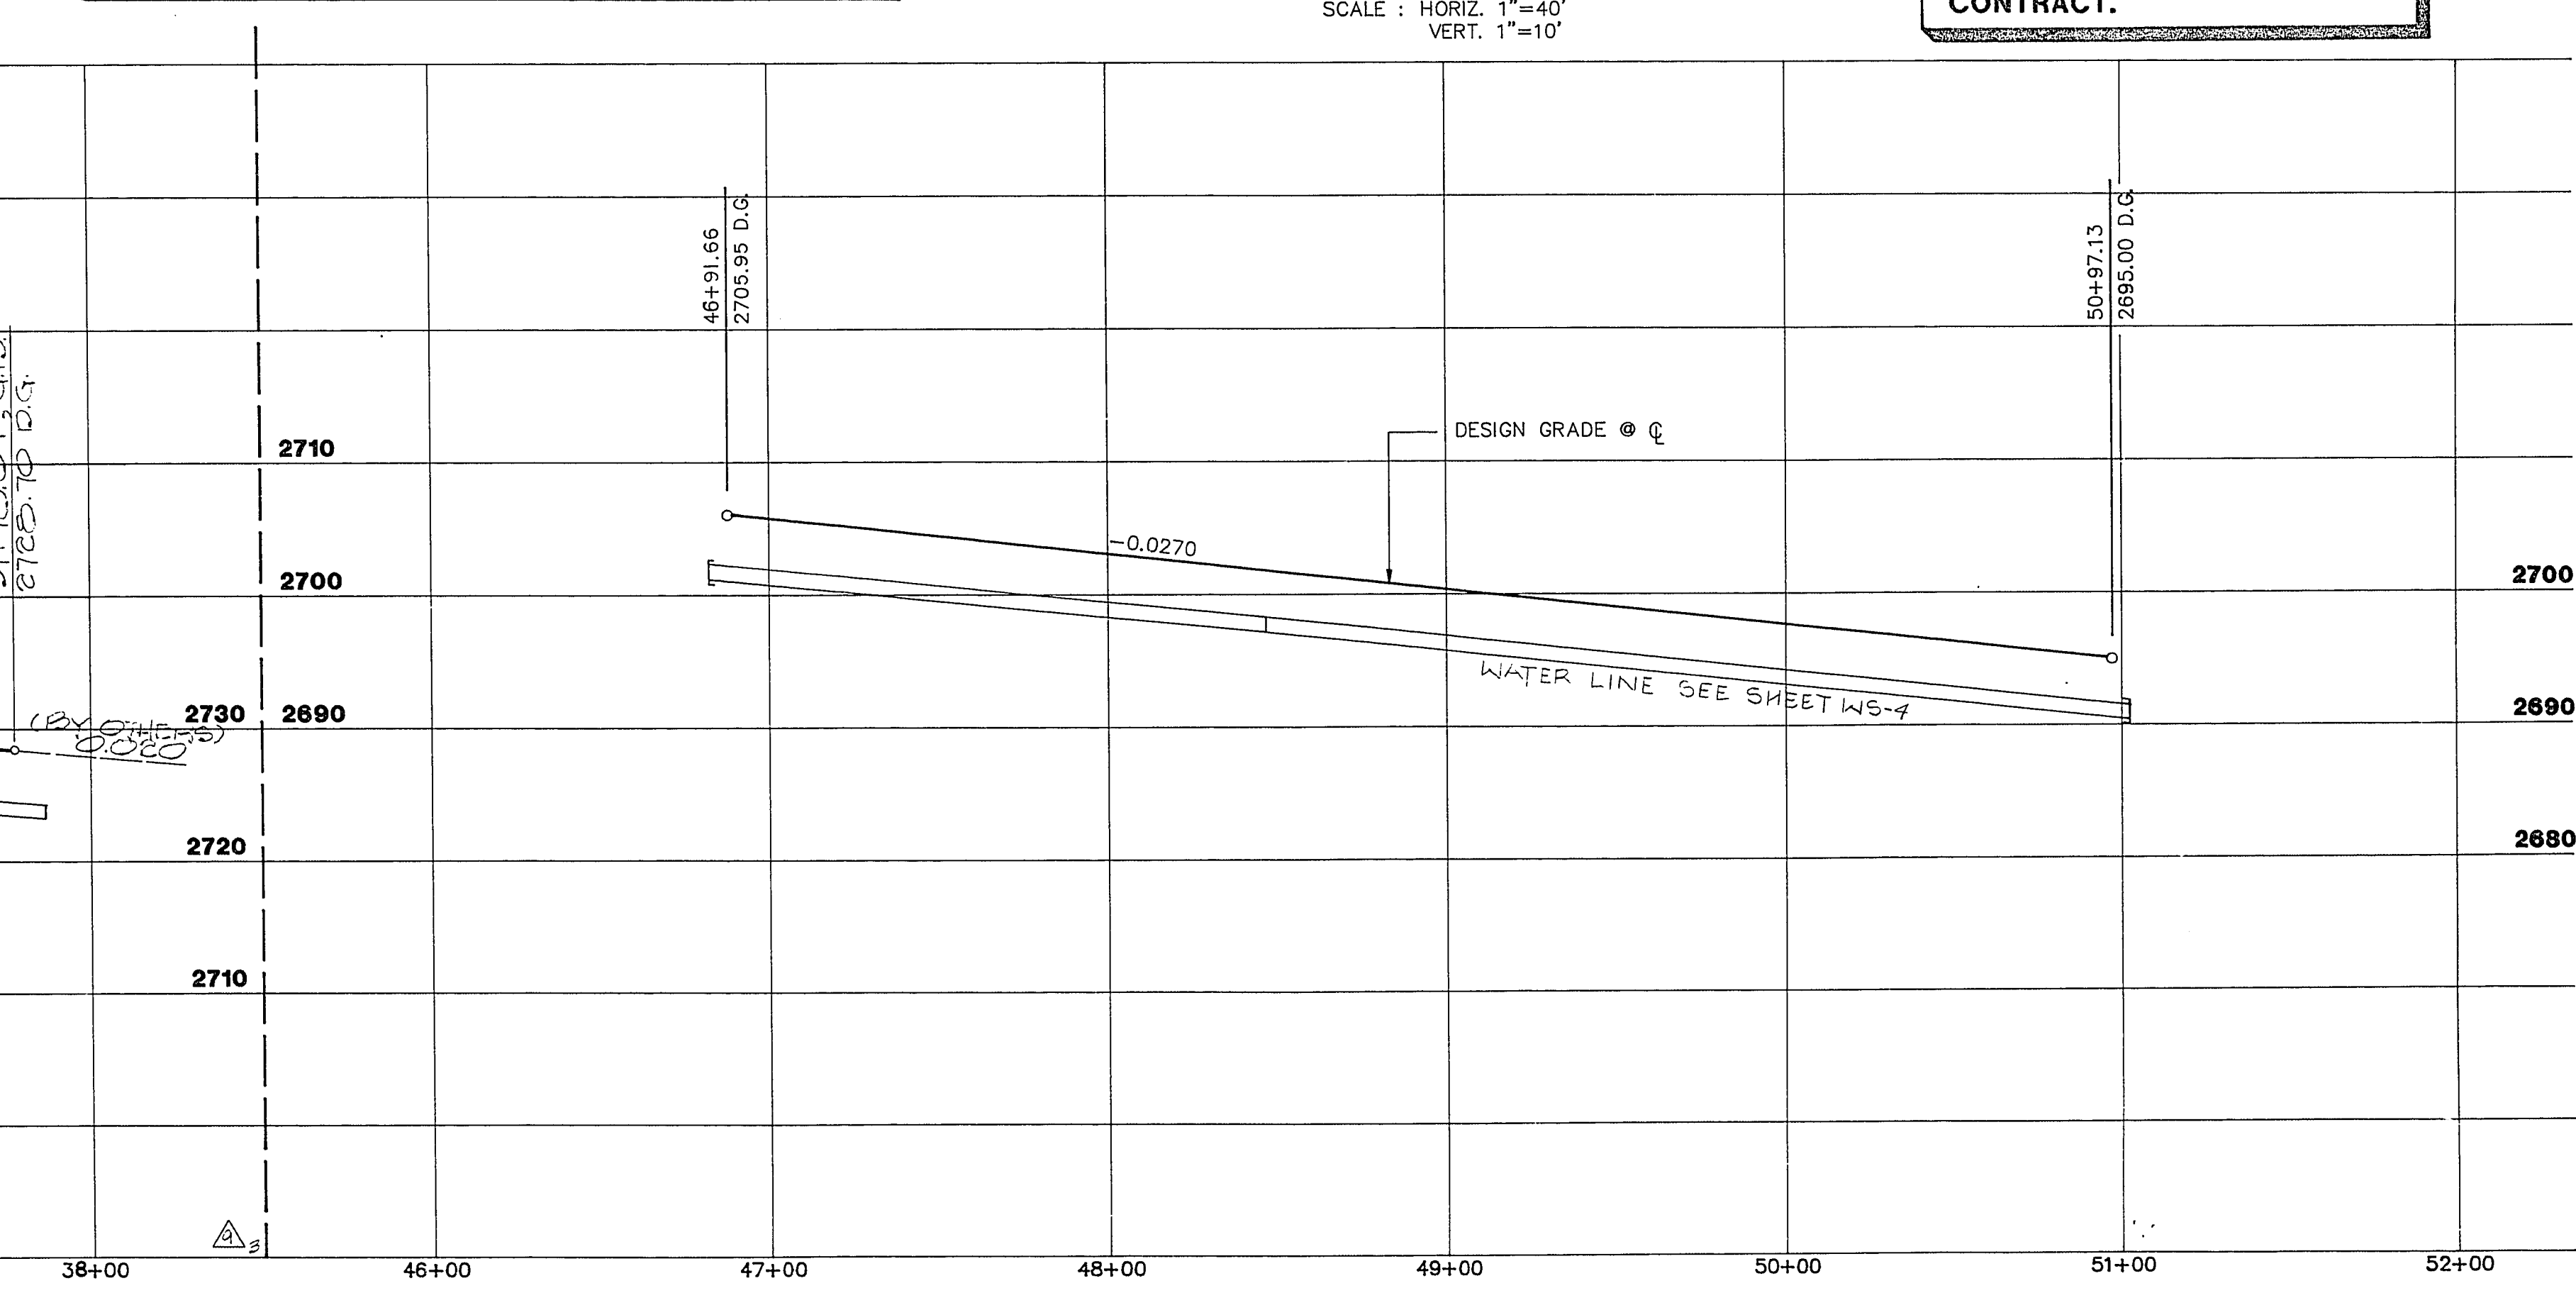
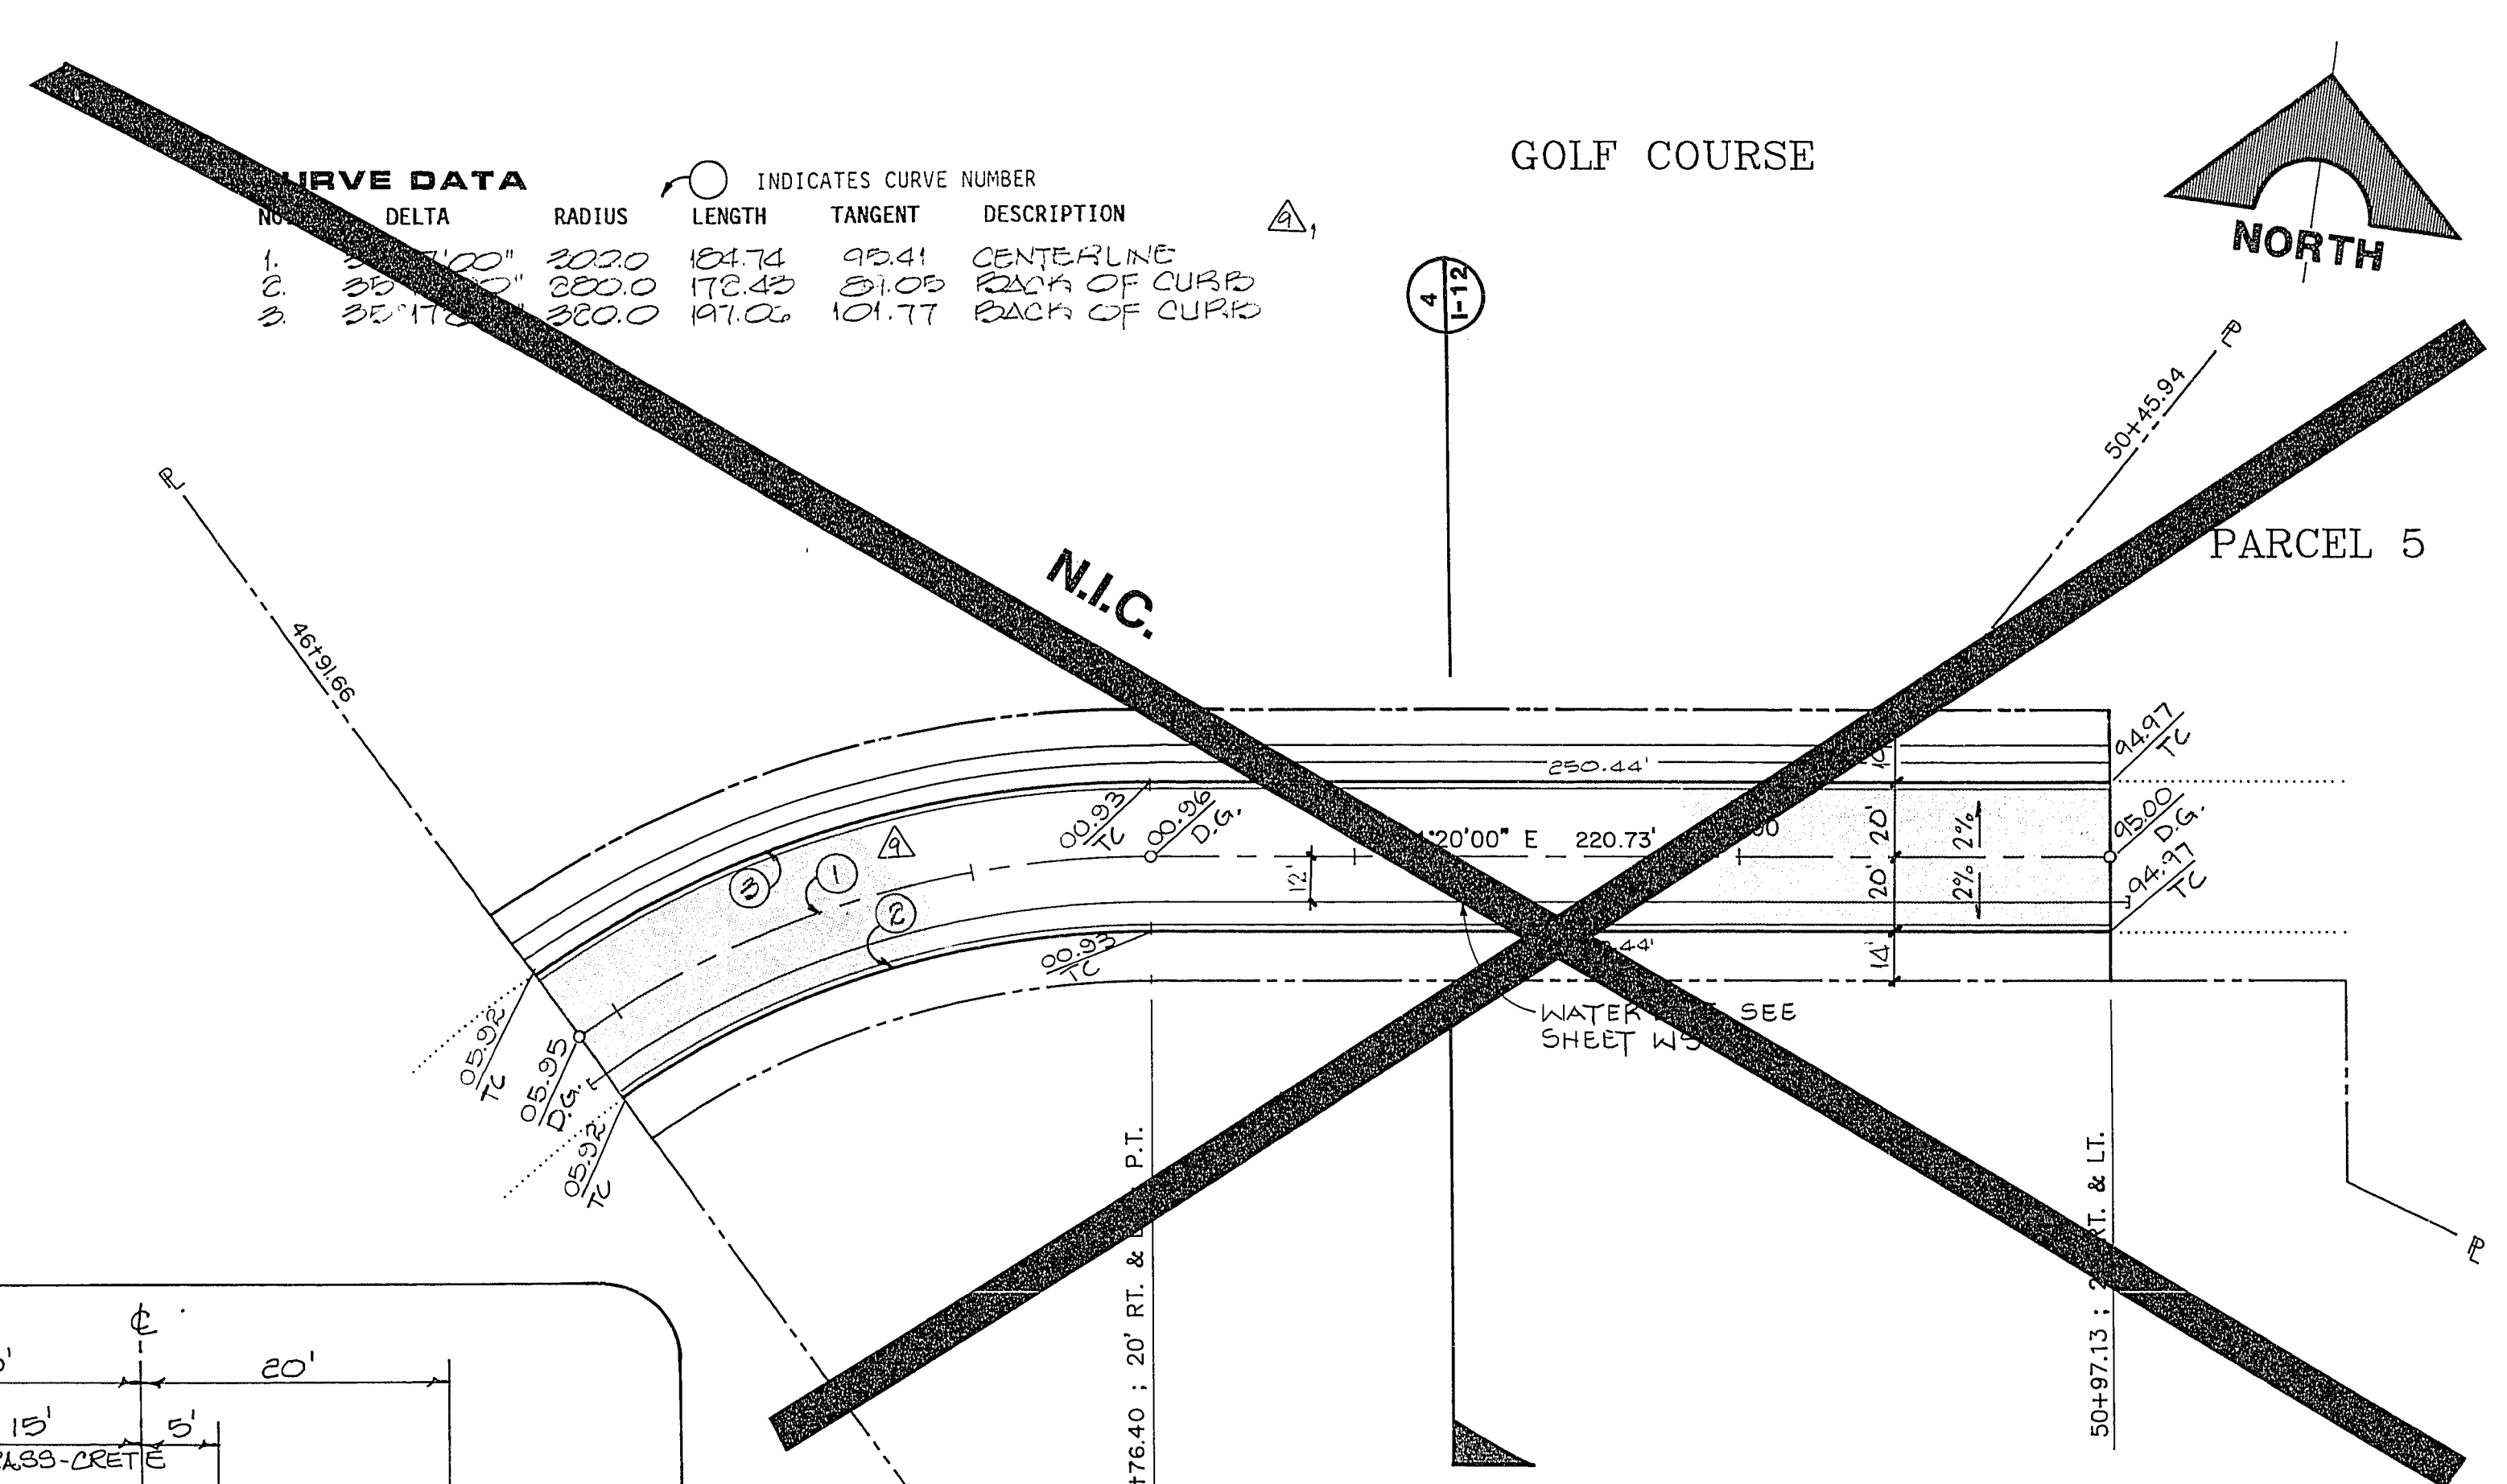






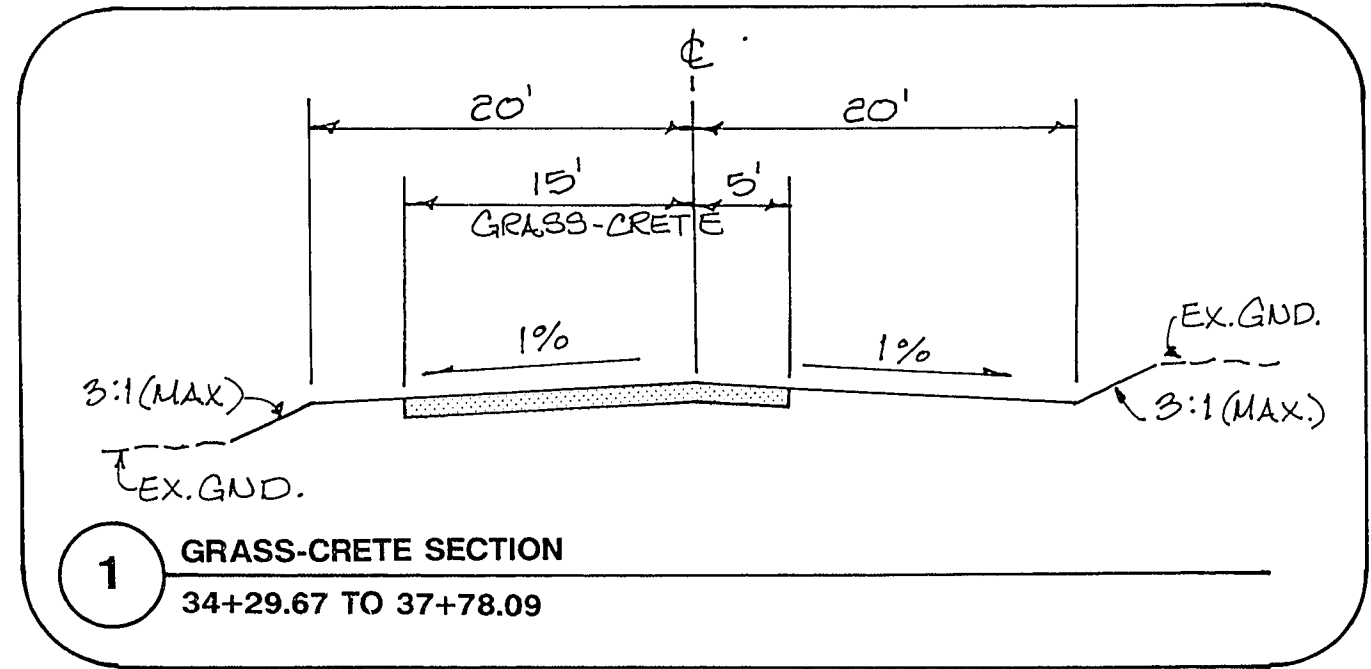

CURVE DATA

NO.	DELTA	RADIUS	LENGTH	TANGENT	DESCRIPTION

JOB NO. 620.3145

G.C. WALLACE, INC.
Engineering/Architecture

155 SOUTH RAINBOW BLVD LAS VEGAS, NEVADA 89102

HOWARD HUGHES PROPERTIES
SUMMERLIN - VILLAGE I SOUTH
STREET 'V'
IMPROVEMENT PLANS
STA. 34+00 TO STA. END

REVISIONS: 5-4-92
REVISION: 10/2/91
REVISION: 11/16/91

DATE: 10/2/91
DATE: 11/16/91

REVISION 1 C.L.V. COMMENTS

SHEET **1-4**
SHT. 7 OF 44

23-2-92 107-V1815