


PARCEL 2

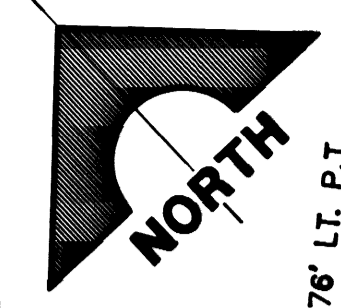

CURVE DATA


NO.	DELTA	RADIUS	LENGTH	TANGENT	DESCRIPTION
1	42°06'05"	800.00	587.95	307.90	CENTERLINE
2	16°39'03"	1200.00	348.73	115.68	CENTERLINE
3	42°06'05"	774.00	568.74	297.90	BACK OF CURB
4	22°24'00"	880.00	289.76	172.22	BACK OF CURB
5	21°20'27"	1,174.00	197.03	92.70	BACK OF CURB
6	11°39'07"	1226.00	249.32	125.09	BACK OF CURB
7	00°57'24"	411.47	6.87	3.44	BACK OF CURB
8	07°09'43"	457.00	57.13	28.60	BACK OF CURB
INDICATES CURVE NUMBER

PARCEL 3
HILLSHIRE DRIVE
STREET

SCALE: HORIZ. 1"=40'
VERT. 1"=10'

CONSTRUCTION NOTE:
ROUGH GRADING HAS BEEN COMPLETED UNDER SEPARATE CONTRACT.

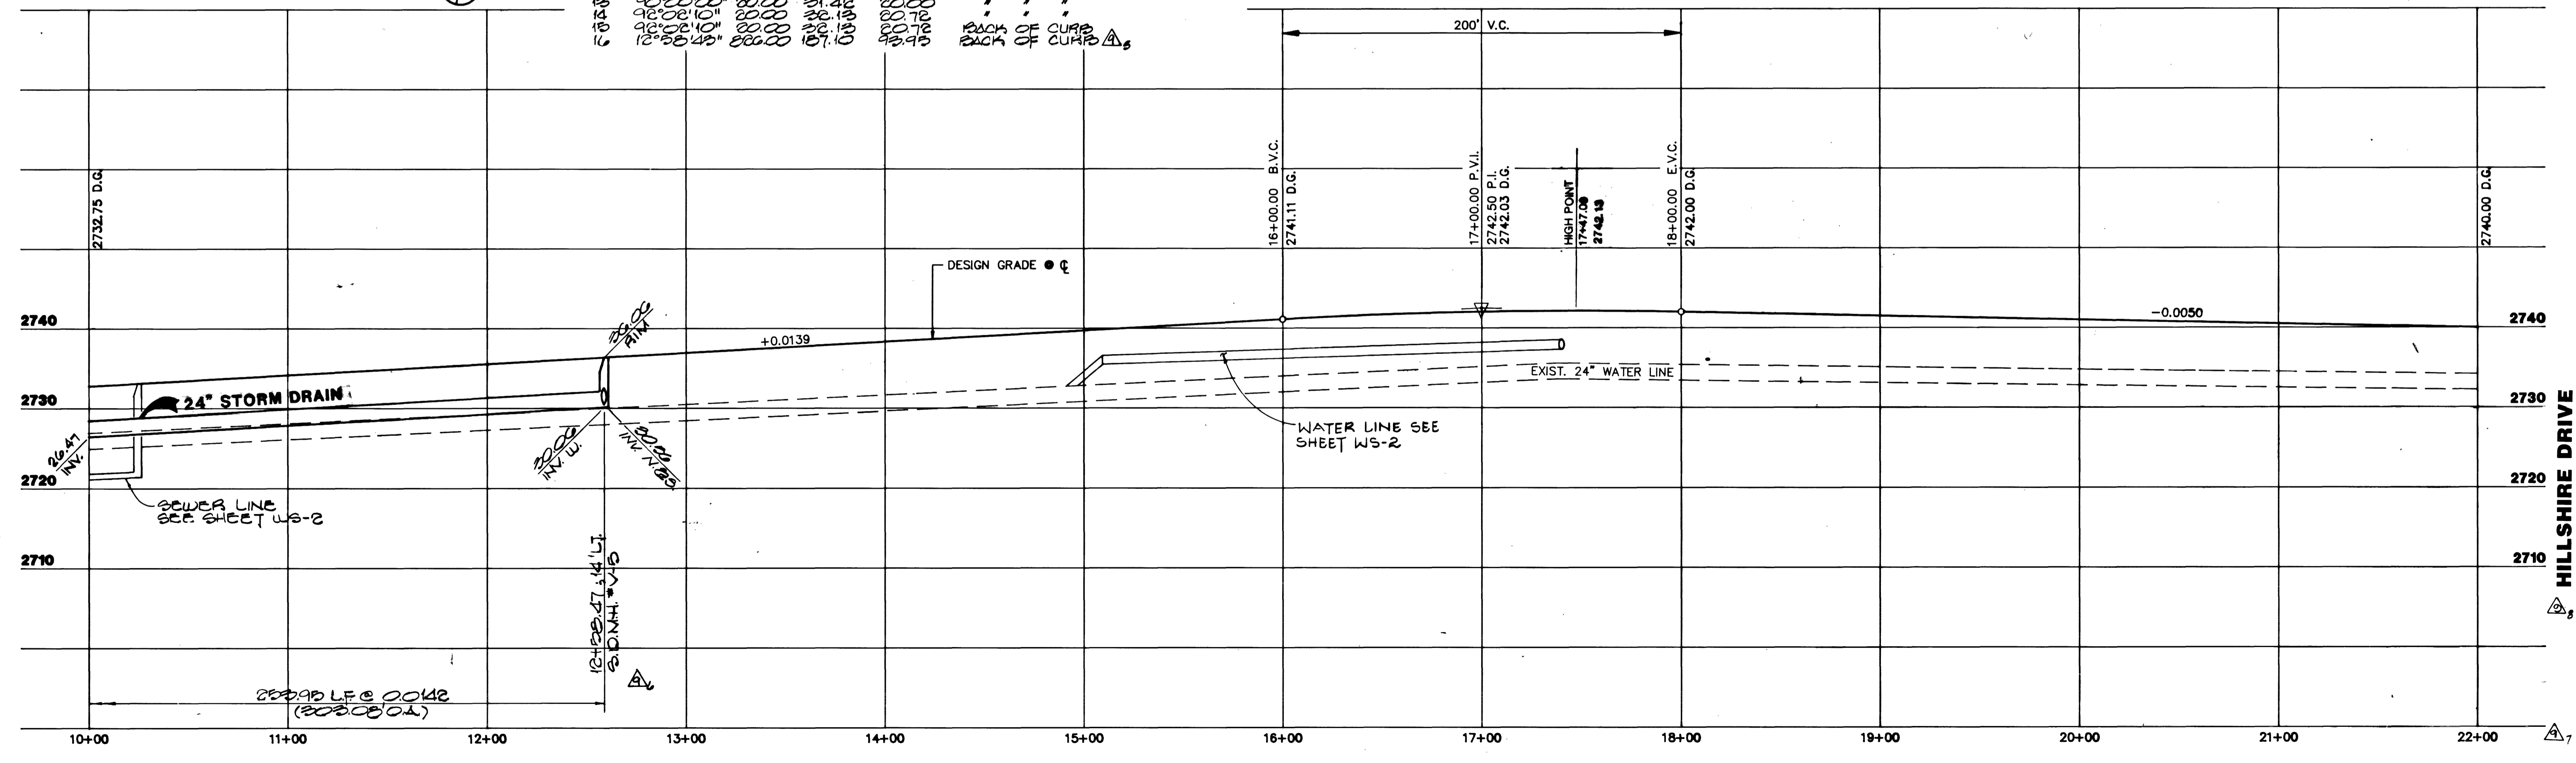

JOB NO. 620.3148

29722
8/4 DIETRICH-POST 63328

REV	DATE	DESCRIPTION
1	12/10/11	APPROX. COMMERCIAL DUTY AND
2	12/10/11	REVISION
3	10/08/11	REVISION
4	08/01/11	REVISION / C.S.V. COMMENTS

DATE: 12/10/11
SCALE: 1/8"=1'-0"

G.C. WALLACE, INC.
Engineering/Architecture
1555 SOUTH RAINBOW BLVD. LAS VEGAS, NEVADA 89102

HOWARD HUGHES PROPERTIES
SUMMERLIN VILLAGE I SOUTH
STREET
IMPROVEMENT PLANS
STA. 10+00 TO STA. 22+00

SHEET
I-2
SHT. 5 OF 44

23-24 107-VI815

