


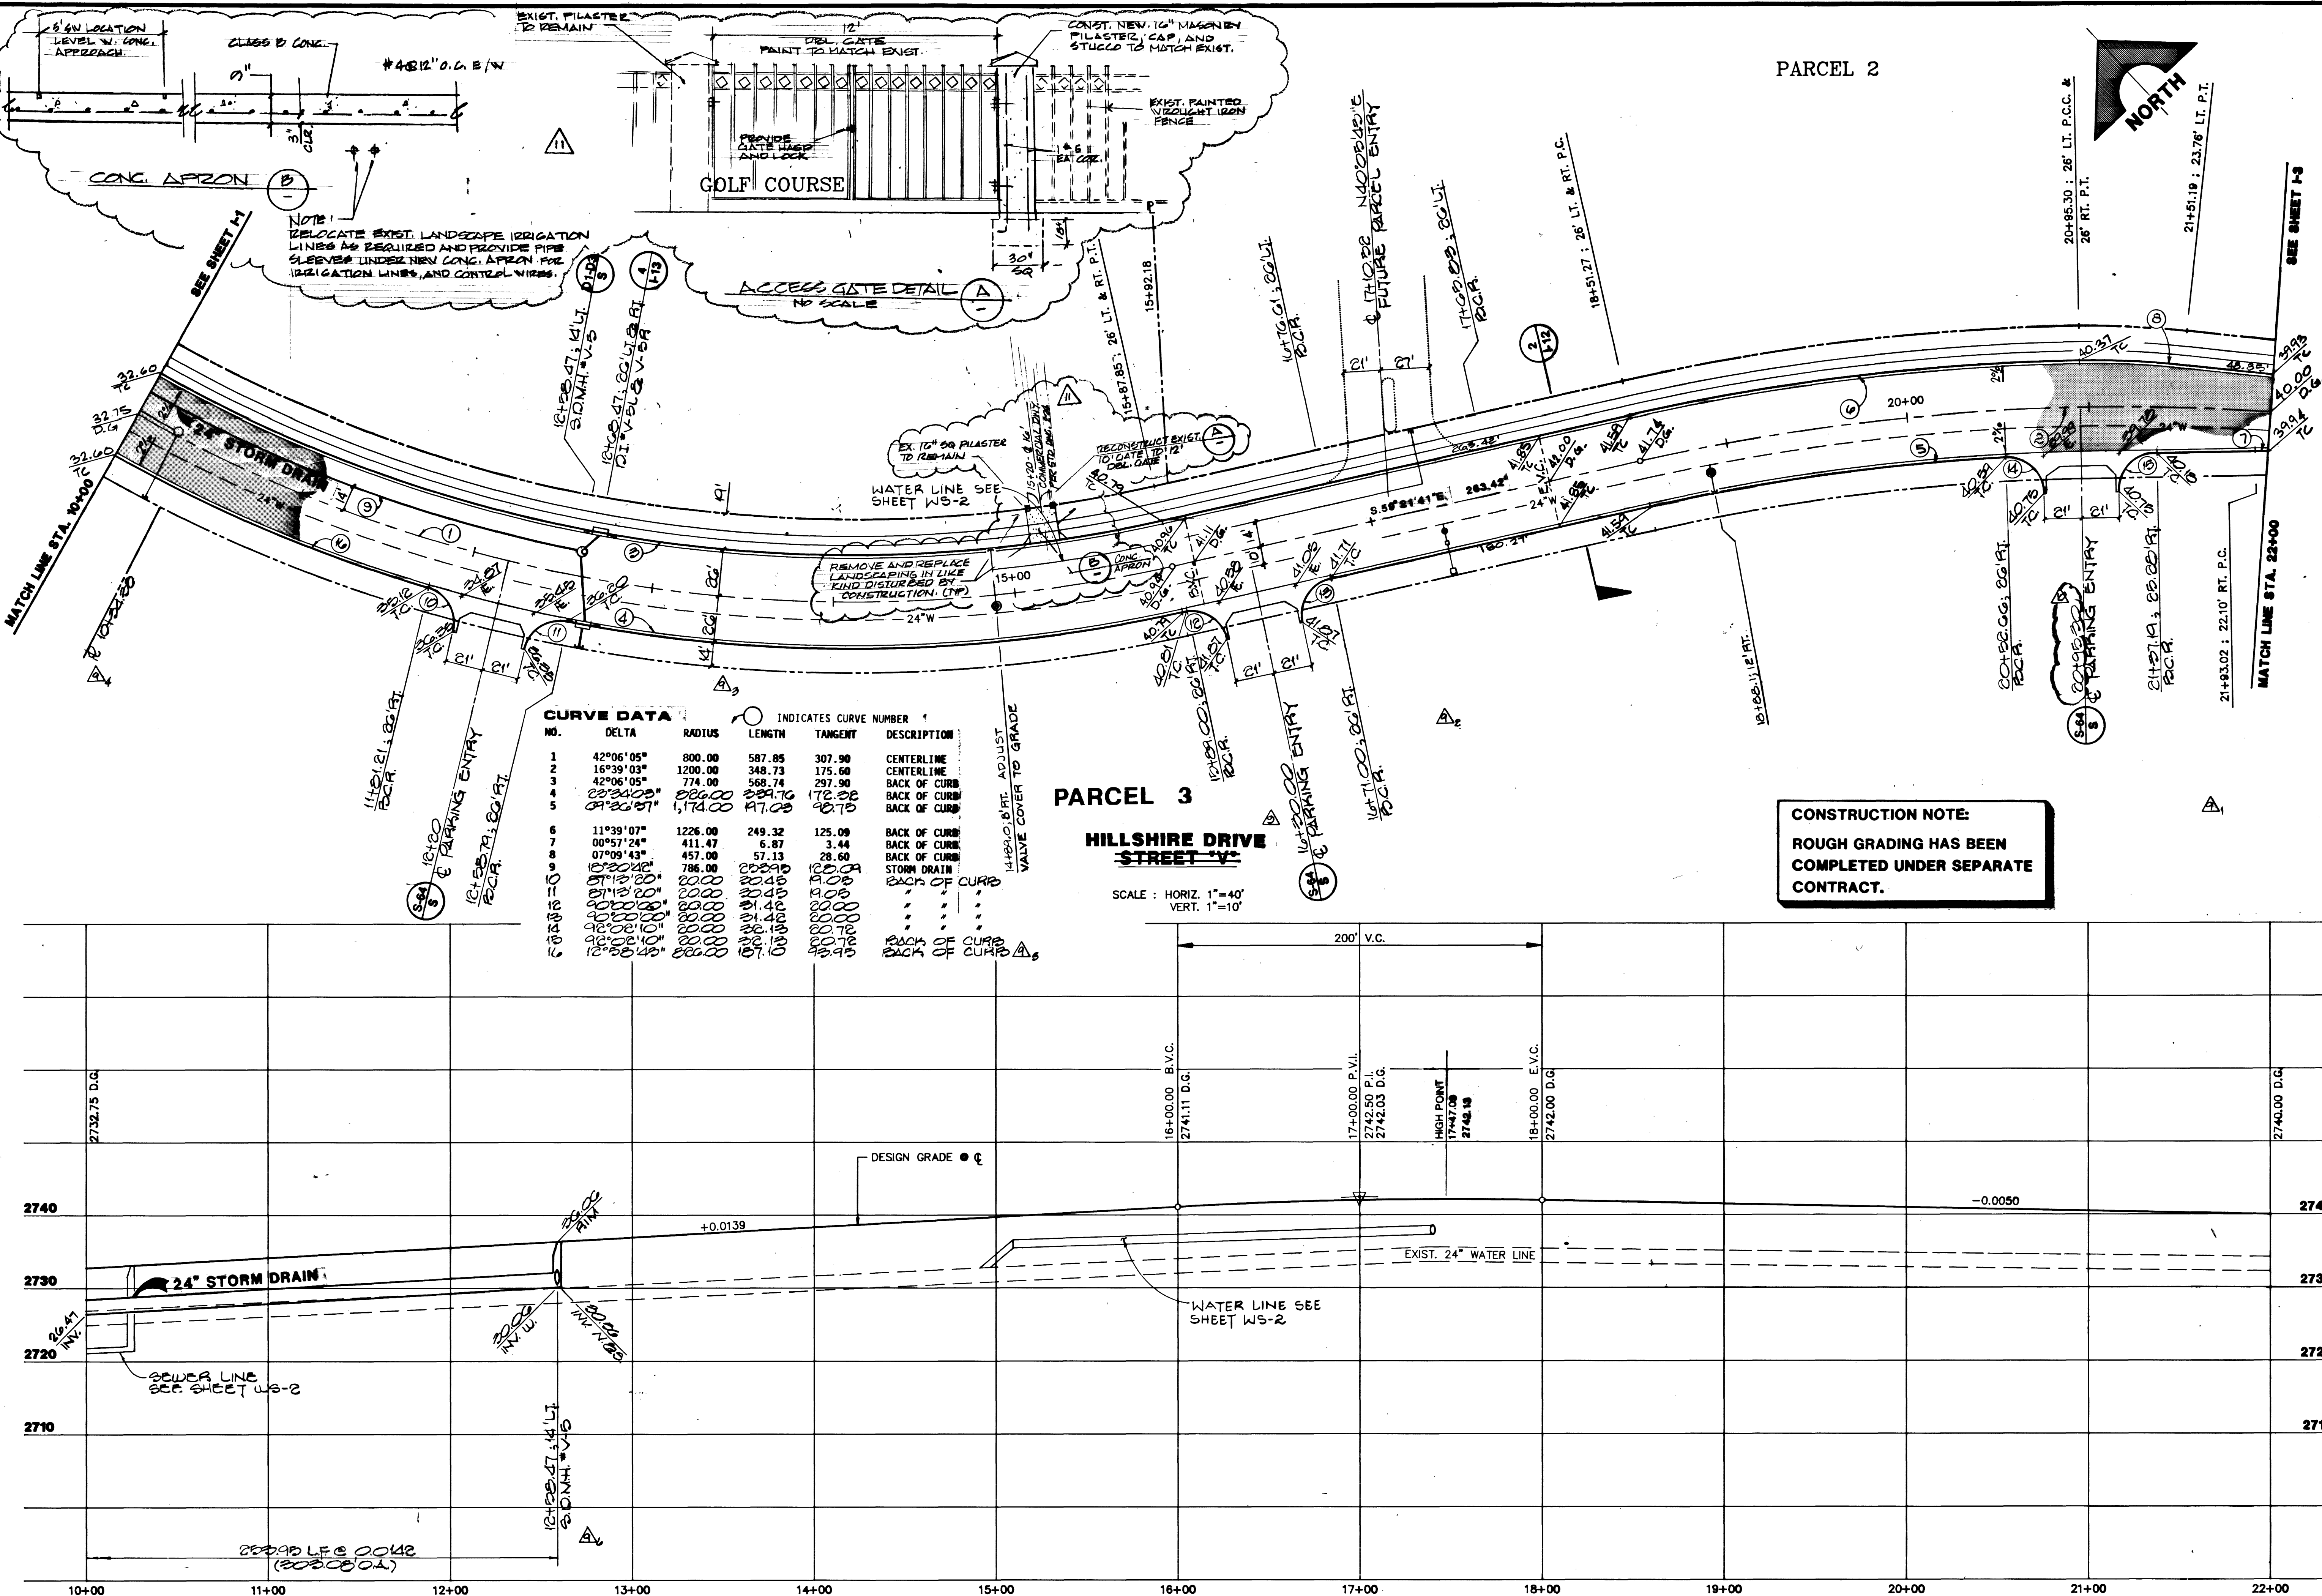


CURVE DATA

NO.	DELTA	RADIUS	LENGTH	TANGENT	DESCRIPTION
1	42°06'05"	800.00	587.95	307.90	CENTERLINE
2	16°39'03"	1200.00	349.73	175.60	CENTERLINE
3	42°06'05"	774.00	568.74	297.90	BACK OF CURB
4	22°34'03"	886.00	289.76	172.28	BACK OF CURB
5	29°26'27"	1,174.00	197.03	90.70	BACK OF CURB
6	11°39'07"	1226.00	249.32	125.09	BACK OF CURB
7	00°57'24"	411.47	6.87	3.44	BACK OF CURB
8	07°09'43"	457.00	57.13	28.60	BACK OF CURB
9	18°00'24"	786.00	222.90	120.09	STORM DRAIN
10	07°19'20"	200.00	22.45	11.08	BACK OF CURB
PARCEL 3
HILLSHIRE DRIVE
STREET V

SCALE: HORIZ. 1"=40'
VERT. 1"=10'

CONSTRUCTION NOTE:
ROUGH GRADING HAS BEEN
COMPLETED UNDER SEPARATE
CONTRACT.

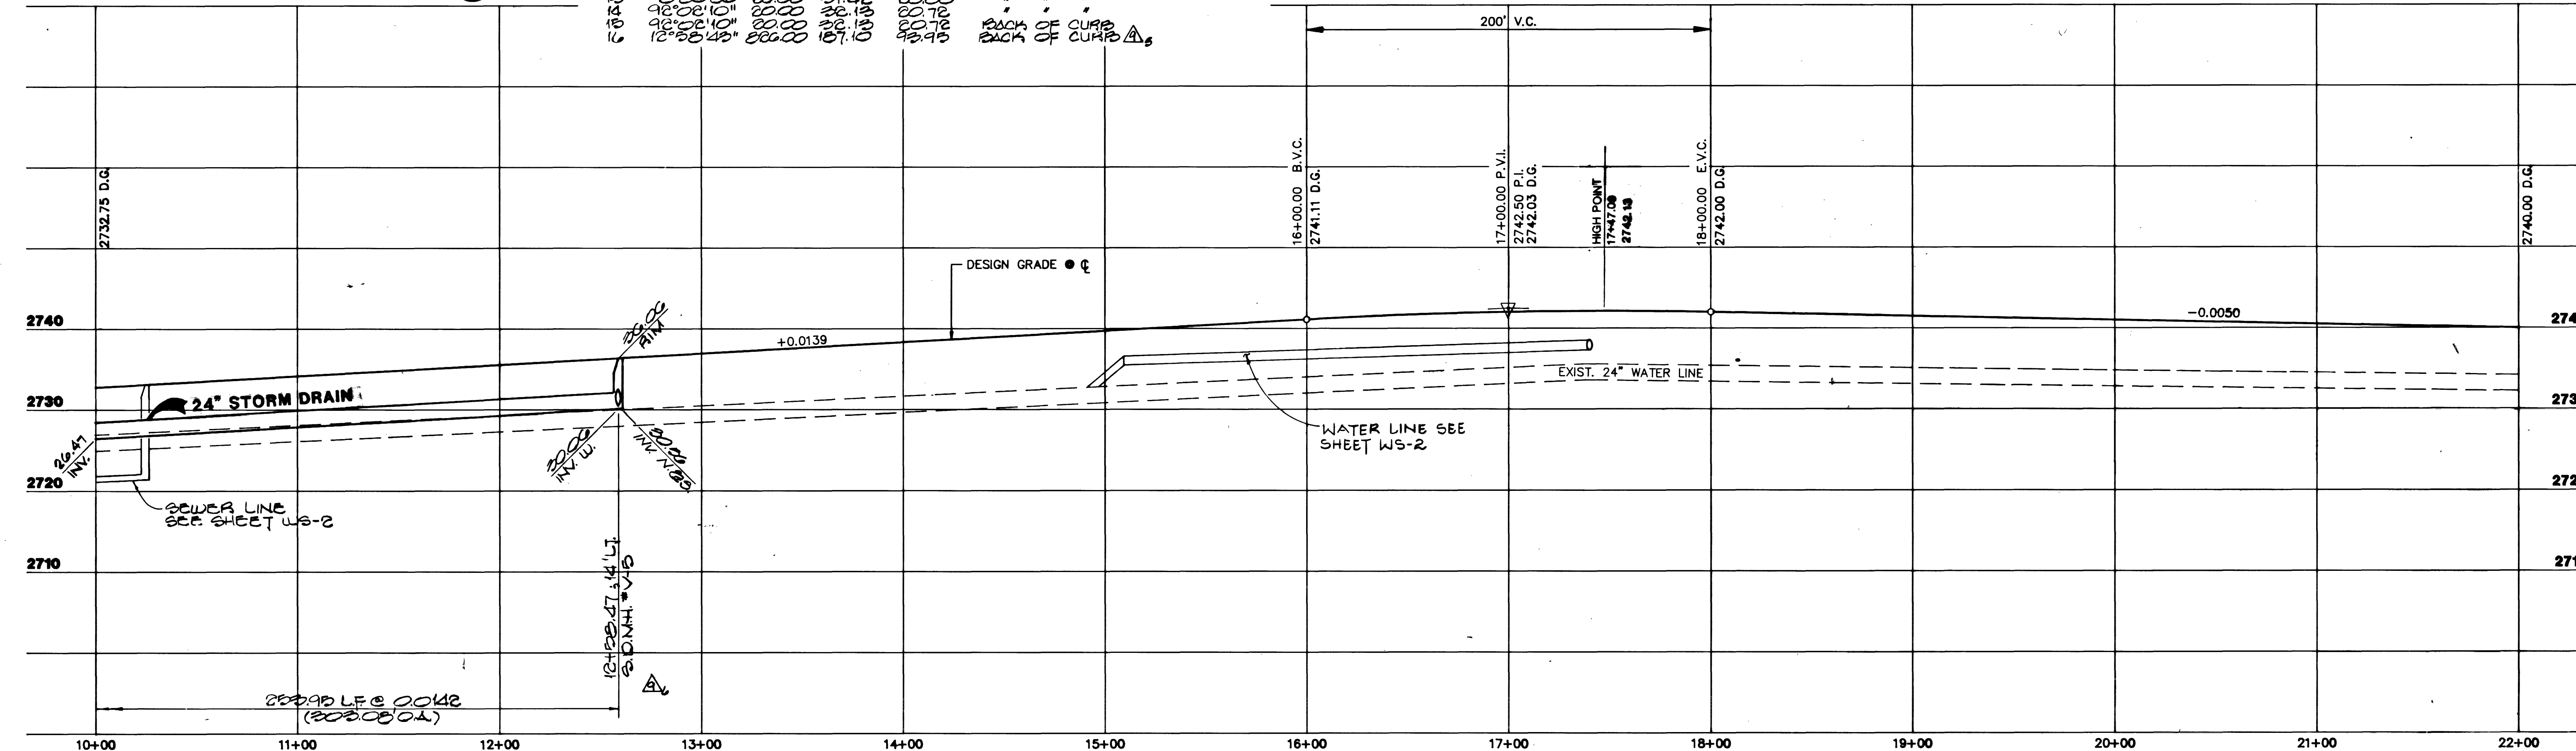


G.C.C. WALLACE, INC. Engineering/Architecture		HOWARD HUGHES PROPERTIES SUMMERLIN VILLAGE I SOUTH STREET V IMPROVEMENT PLANS STA. 10+00 TO STA. 22+00																		
SHEET I-2 SHT. 5 OF 44		23-3-24 107-VI-15																		

