


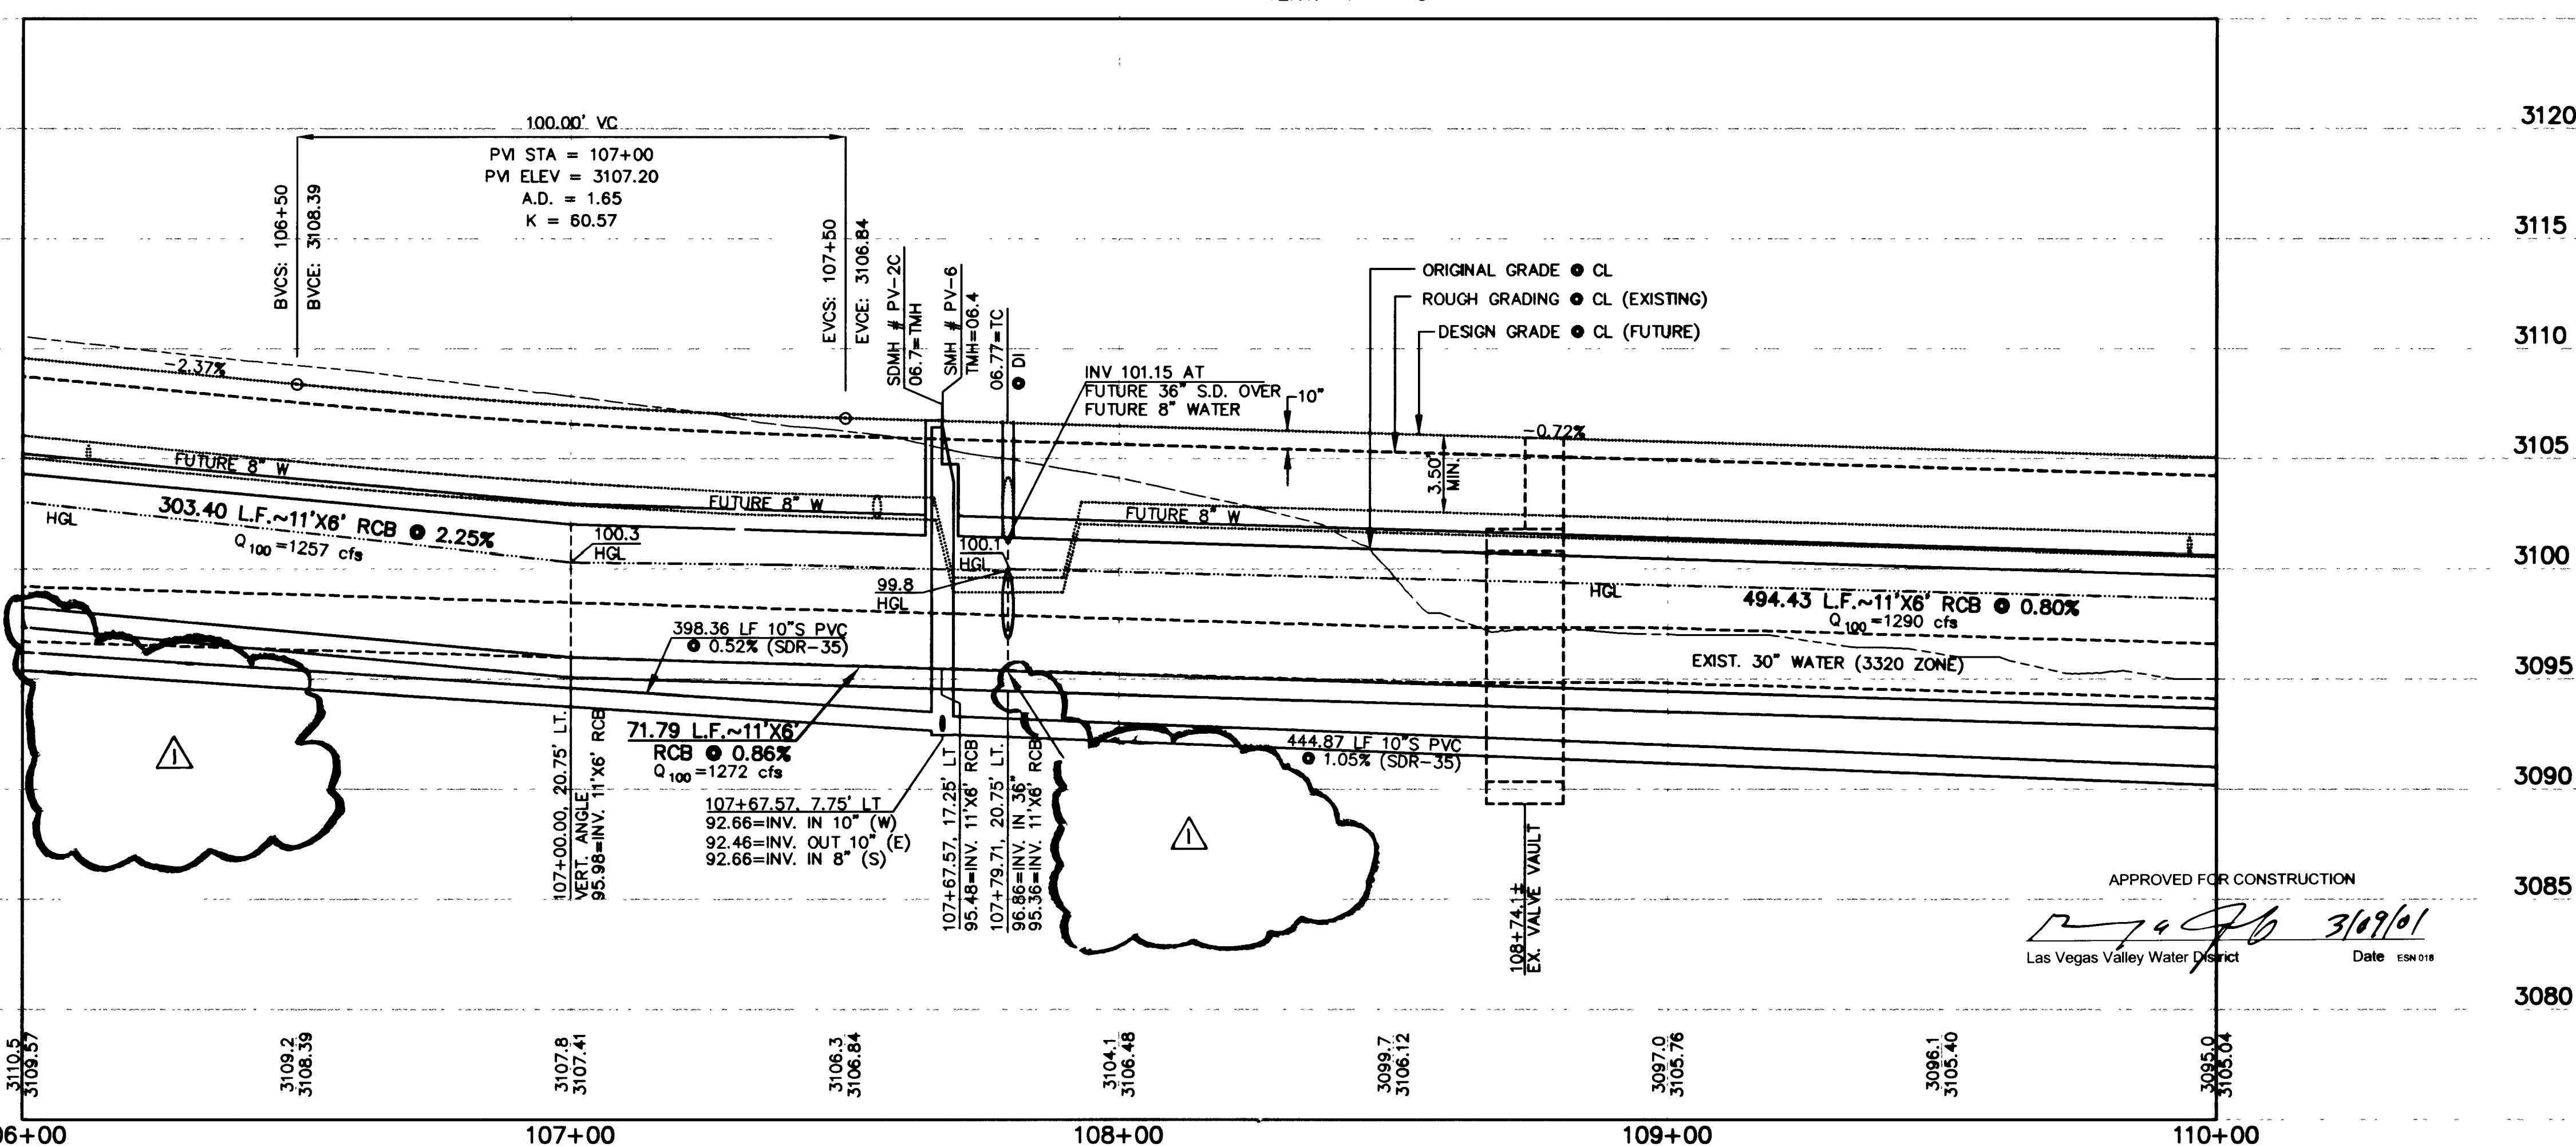

SHEET
C-8
8 OF 18 SHTS