



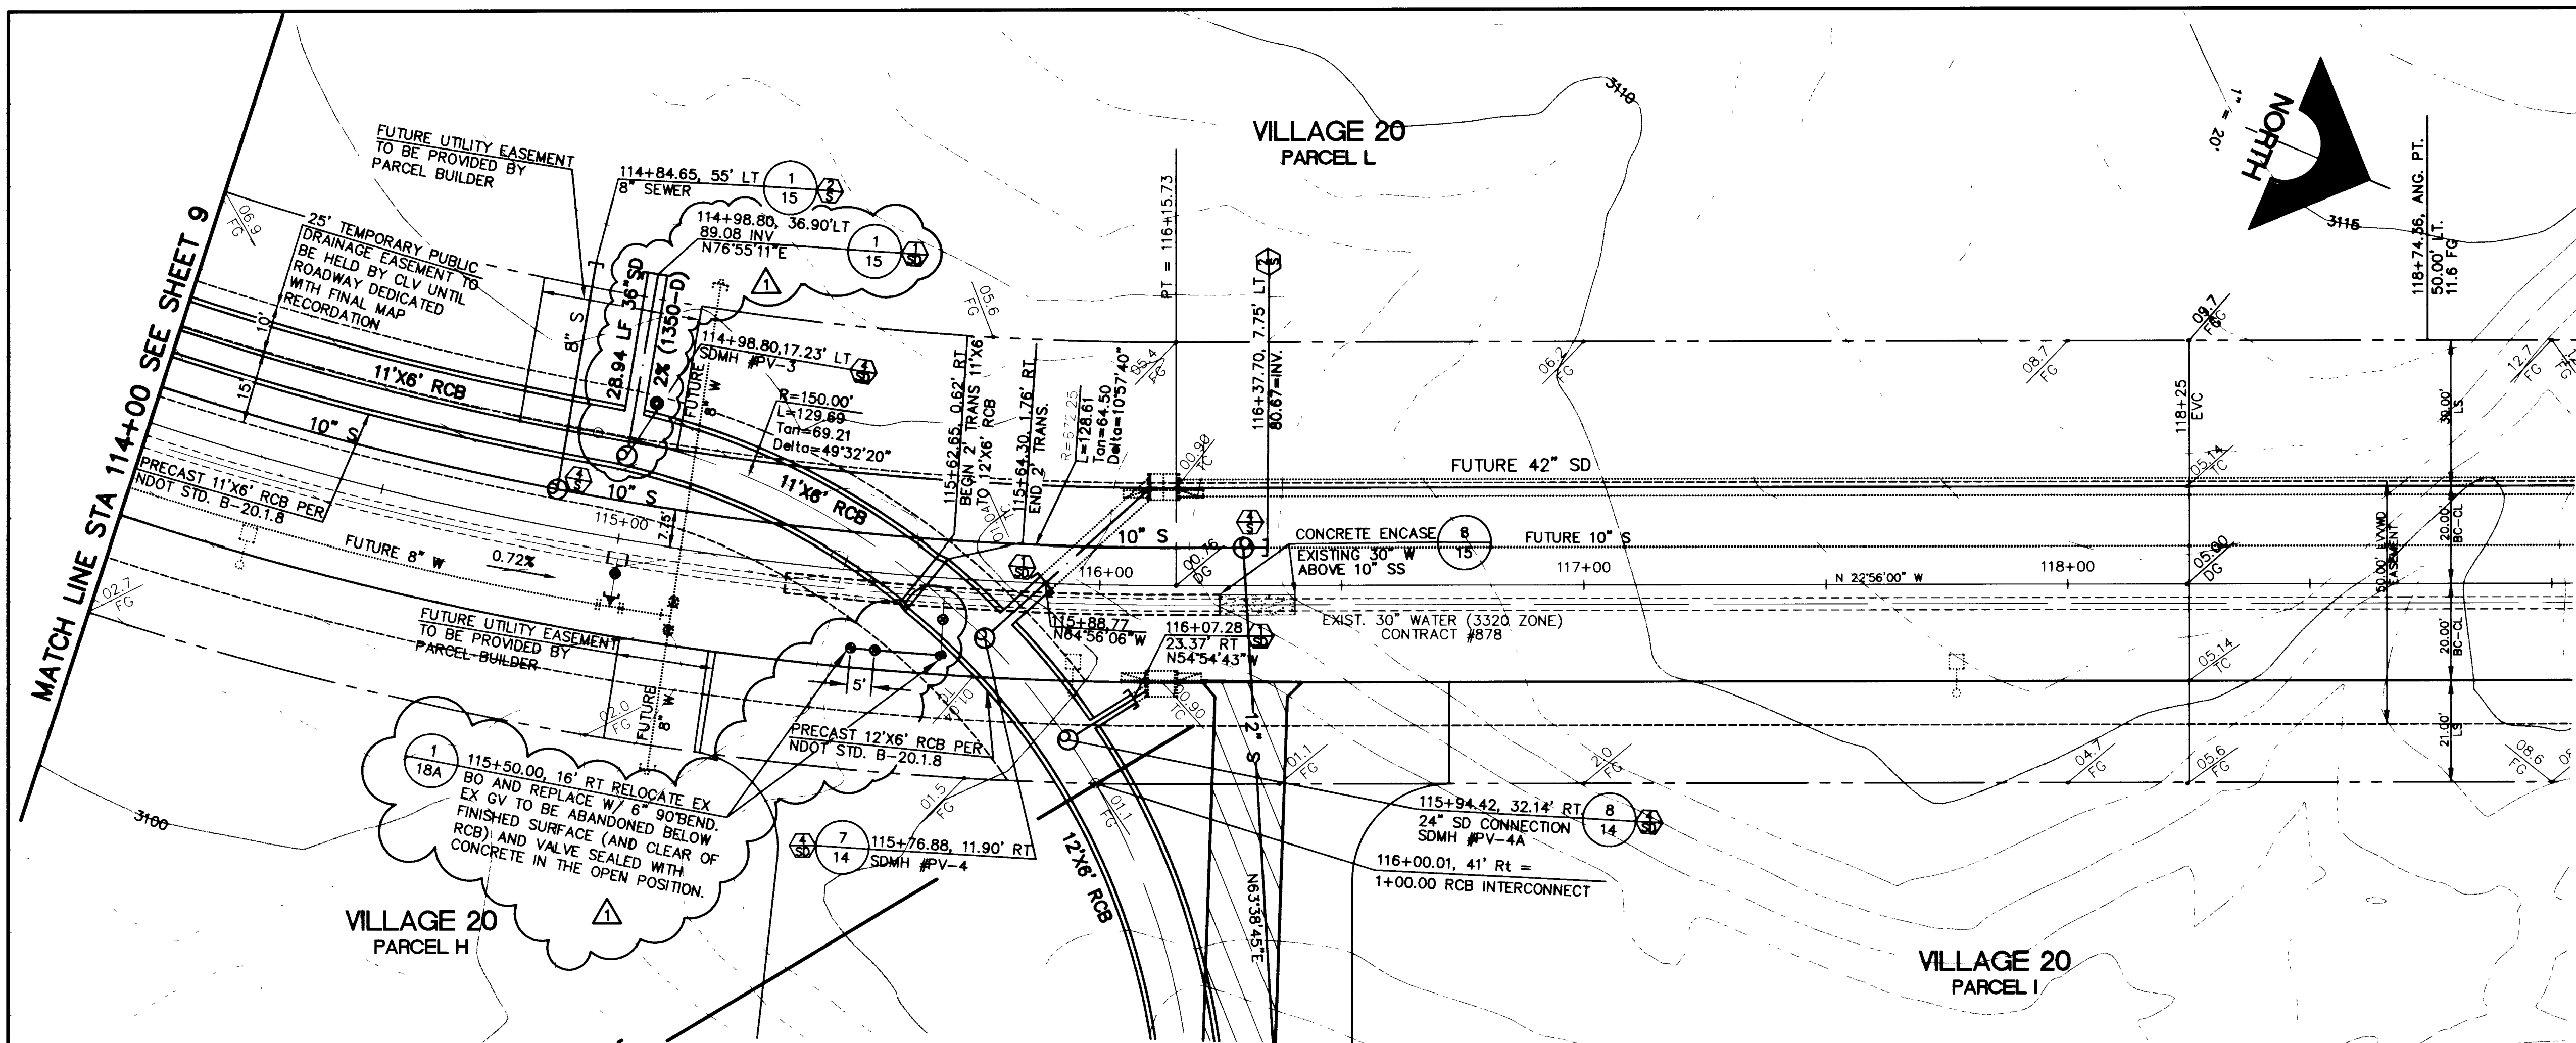

PARK VISTA DRIVE (PUBLIC)

SCALE: HORIZ. 1" = 20'
VERT. 1" = 5'

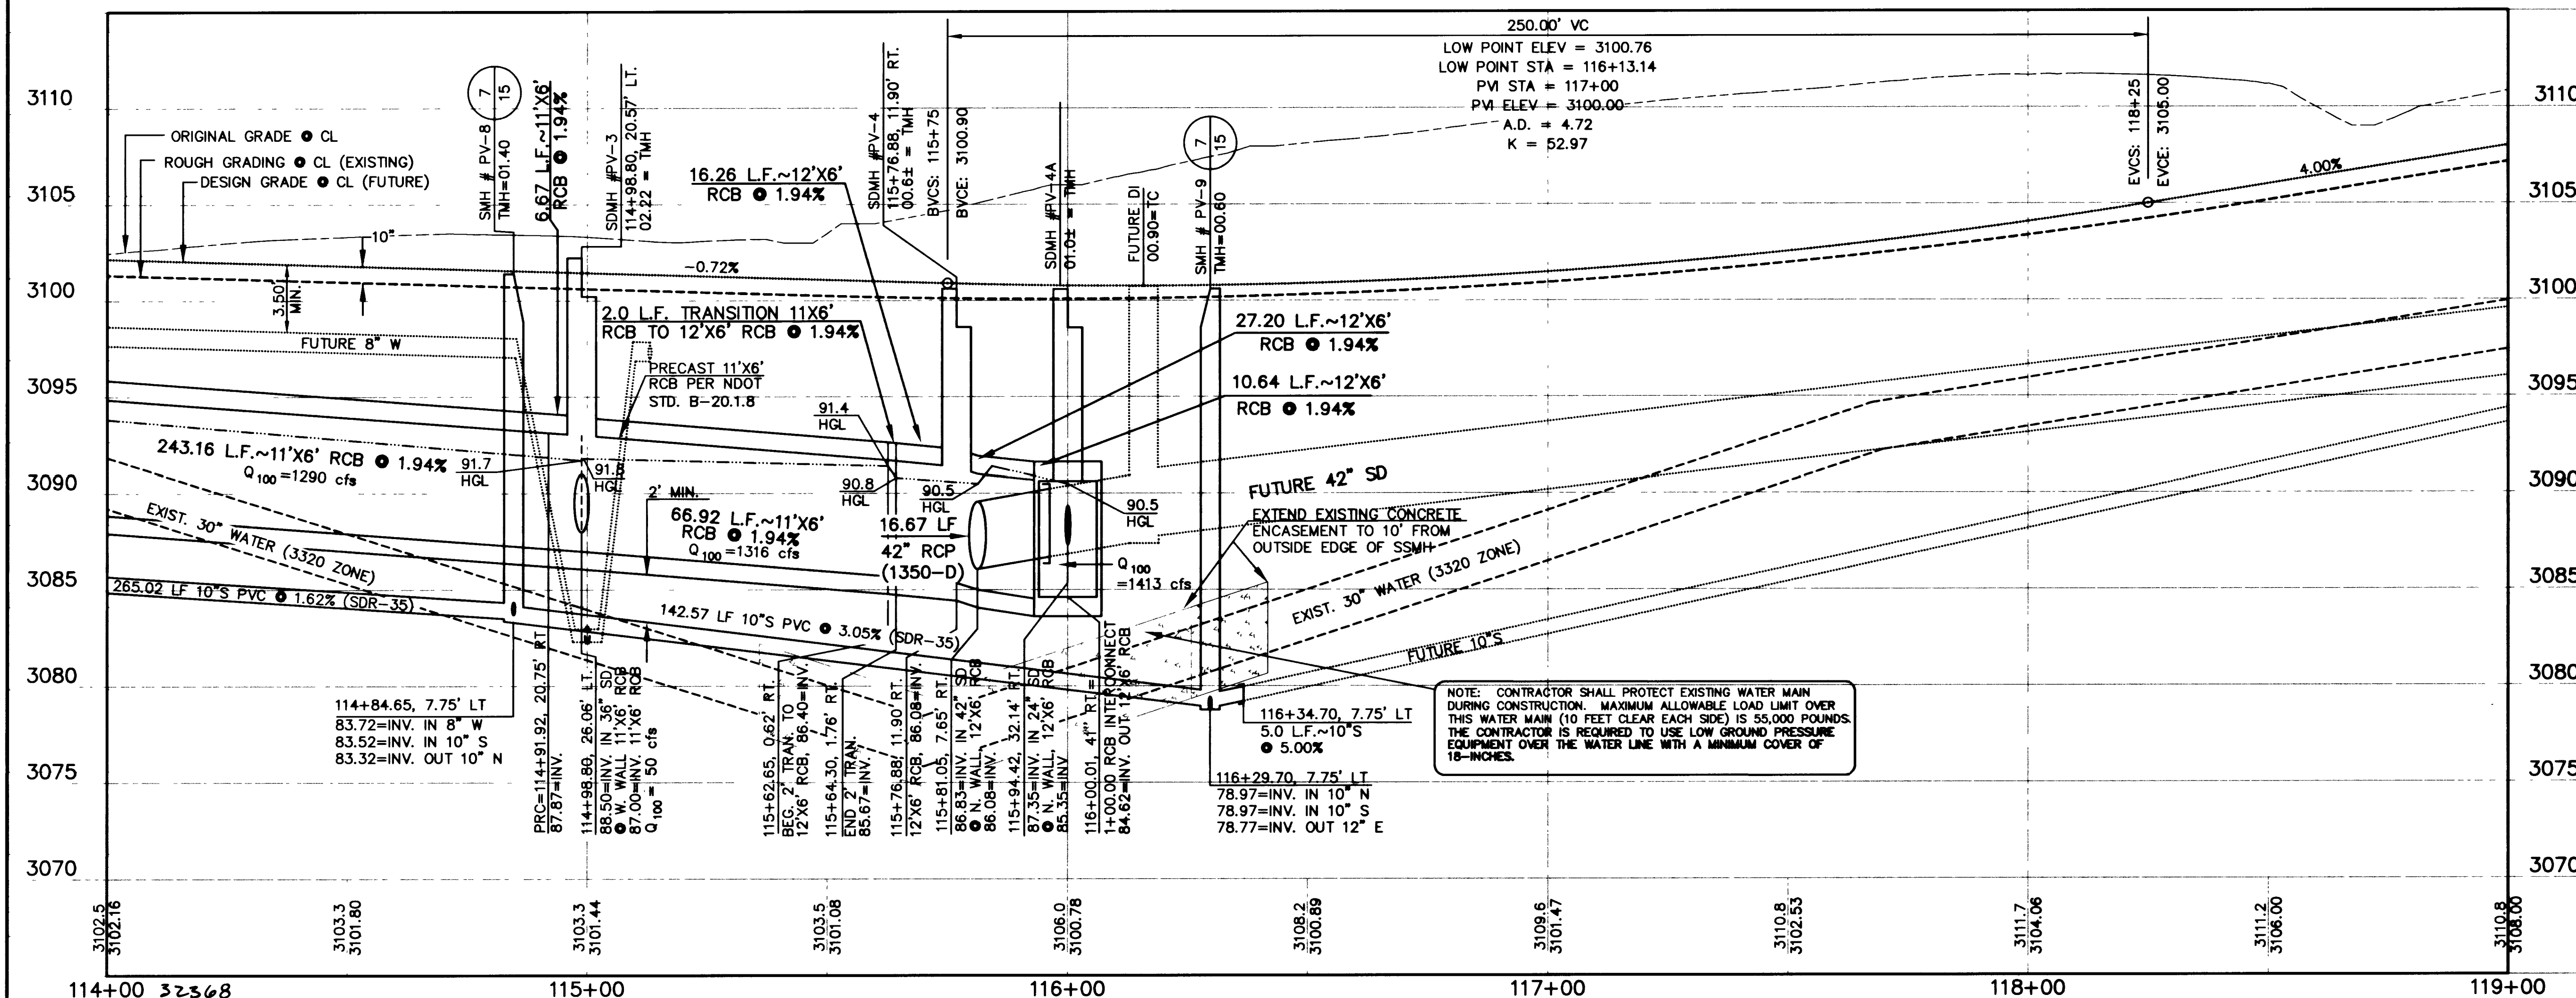

NOTE TO CONTRACTOR:

- ALL EXISTING UTILITY CROSSINGS MUST BE VERIFIED PRIOR TO CONSTRUCTION OF ANY MAIN LINES OR LATERALS THAT MAY BE ADVERSELY EFFECTED. ANY DISCREPANCIES IN LOCATION AND/OR ELEVATION MUST BE PROVIDED TO THE ENGINEER FOR ACCEPTANCE PRIOR TO CONSTRUCTION.
- TOPOGRAPHY SHOWN HEREIN REFLECTS ORIGINAL EXISTING TOPOGRAPHY. ACTUAL FIELD CONDITIONS INCLUDE SITE ROUGH GRADING.

CONSTRUCTION NOTES

STORM DRAIN

- INSTALL TEMPORARY PLUG
- INSTALL TYPE "A" DROP INLET
- INSTALL MODIFIED TYPE "C" DROP INLET
- INSTALL TYPE I ACCESS STORM DRAIN MANHOLE

SEWER

- INSTALL 48" DIA. SEWER MANHOLE
- INSTALL TEMPORARY PLUG WITH 3/4" "CDX" PLY. AND 30# FELT COVER
- INSTALL CONCRETE COLLAR
- INSTALL 60" DIA. DEEP SEWER MANHOLE
- INSTALL LOCKING COVER

WATER

- PROTECT EXISTING WATER FACILITY IN PLACE

BASIS OF BEARING

NORTH 89°43'05" EAST BEING THE SOUTH LINE OF THE SOUTHWEST QUARTER (SW 1/4) OF SECTION 35, TOWNSHIP 20, RANGE 59 EAST, M.D.M., AS SHOWN BY MAP ON FILE IN FILE #1, PAGE 28 OF PARCEL MAPS IN THE CLARK COUNTY RECORDER'S OFFICE, CLARK COUNTY, NEVADA.

BENCHMARK

NDOT BRASS REFERENCE CAP, 50.00 FEET NORTH OF STATION 787+19.42 OF CHARLESTON BLVD. (NO. 0LV09-34SSE8)
*3207.81 NAVD 1988 DATUM (978.351 M)
3207.61 SUMMERLIN DATUM
* THIS PROJECT BASED ON NAVD 1988 DATUM


NOTE

THIS SET OF DRAWINGS IS BASED UPON NAVD 88 DATUM. PREVIOUS DRAWINGS MAY BE BASED ON OTHER DATUM. CARE SHOULD BE OBSERVED WHEN UTILIZING THIS SET OF DRAWINGS.


Avoid cutting underground utility lines. It's costly.
Call before you Dig.
1-800-227-2600
NEVADA STATE ALERT 800

Avoid hitting overhead power lines. It's costly.
CALL BEFORE YOU DO OVERHEAD
CALL 1-702-593-6111

NOTES

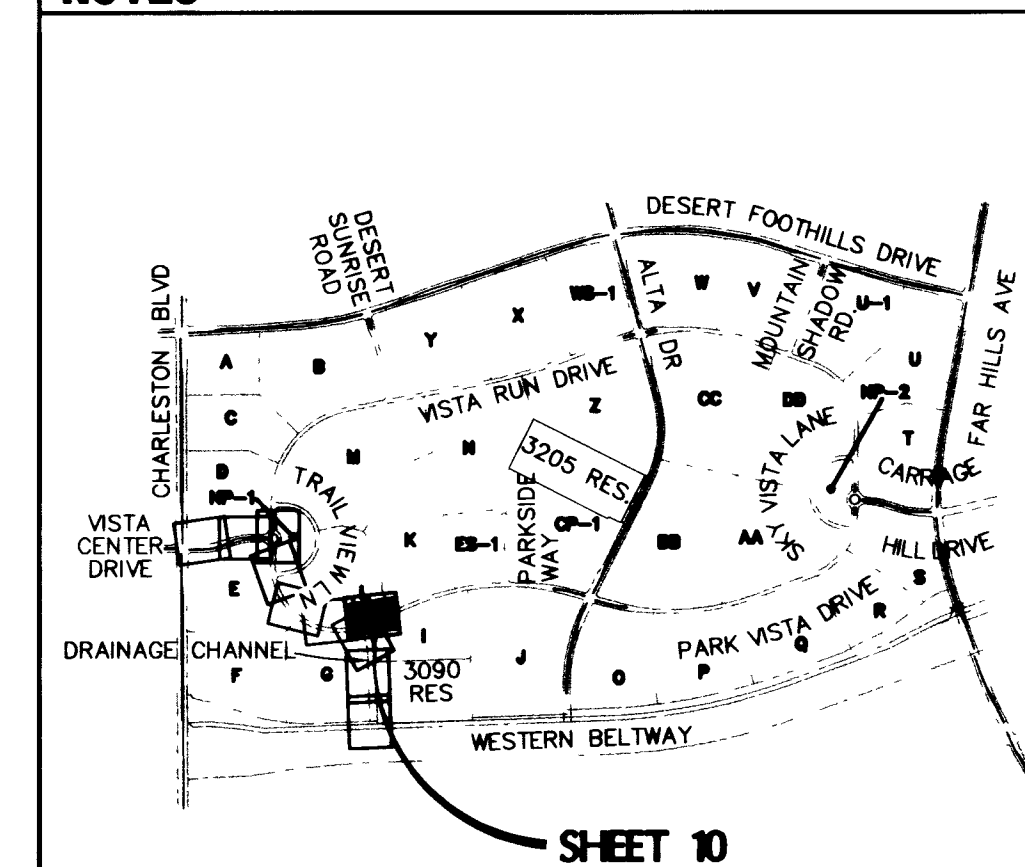

125 APP 3/19/01
LAS VEGAS VALLEY WATER DISTRICT
DATE 5/17/01

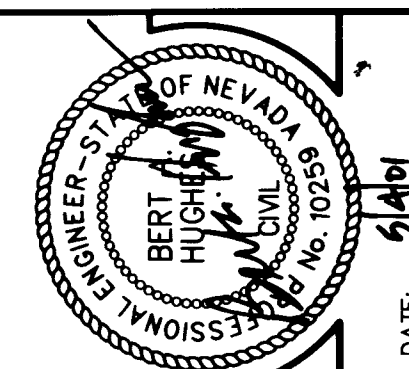

G.C. WALLACE, INC.
Engineering/Architecture
1555 SOUTH RAINBOW BLVD./LAS VEGAS, NEVADA 89146
TELEPHONE: (702) 804-2000 • FAX: (702) 804-2289
F: V20 UNIT 1 - R03 5/17/01 11:00 AM 11/20/01 5:17 PM

SUMMERLIN
VILLAGE 20 UNIT 1 REGIONAL DRAINAGE IMPROVEMENTS
PARK VISTA DRIVE
PLAN & PROFILE
STA 114+00 TO 119+00

SHEET
C-10
10 OF 18 SHEETS

RELOT 131-73