
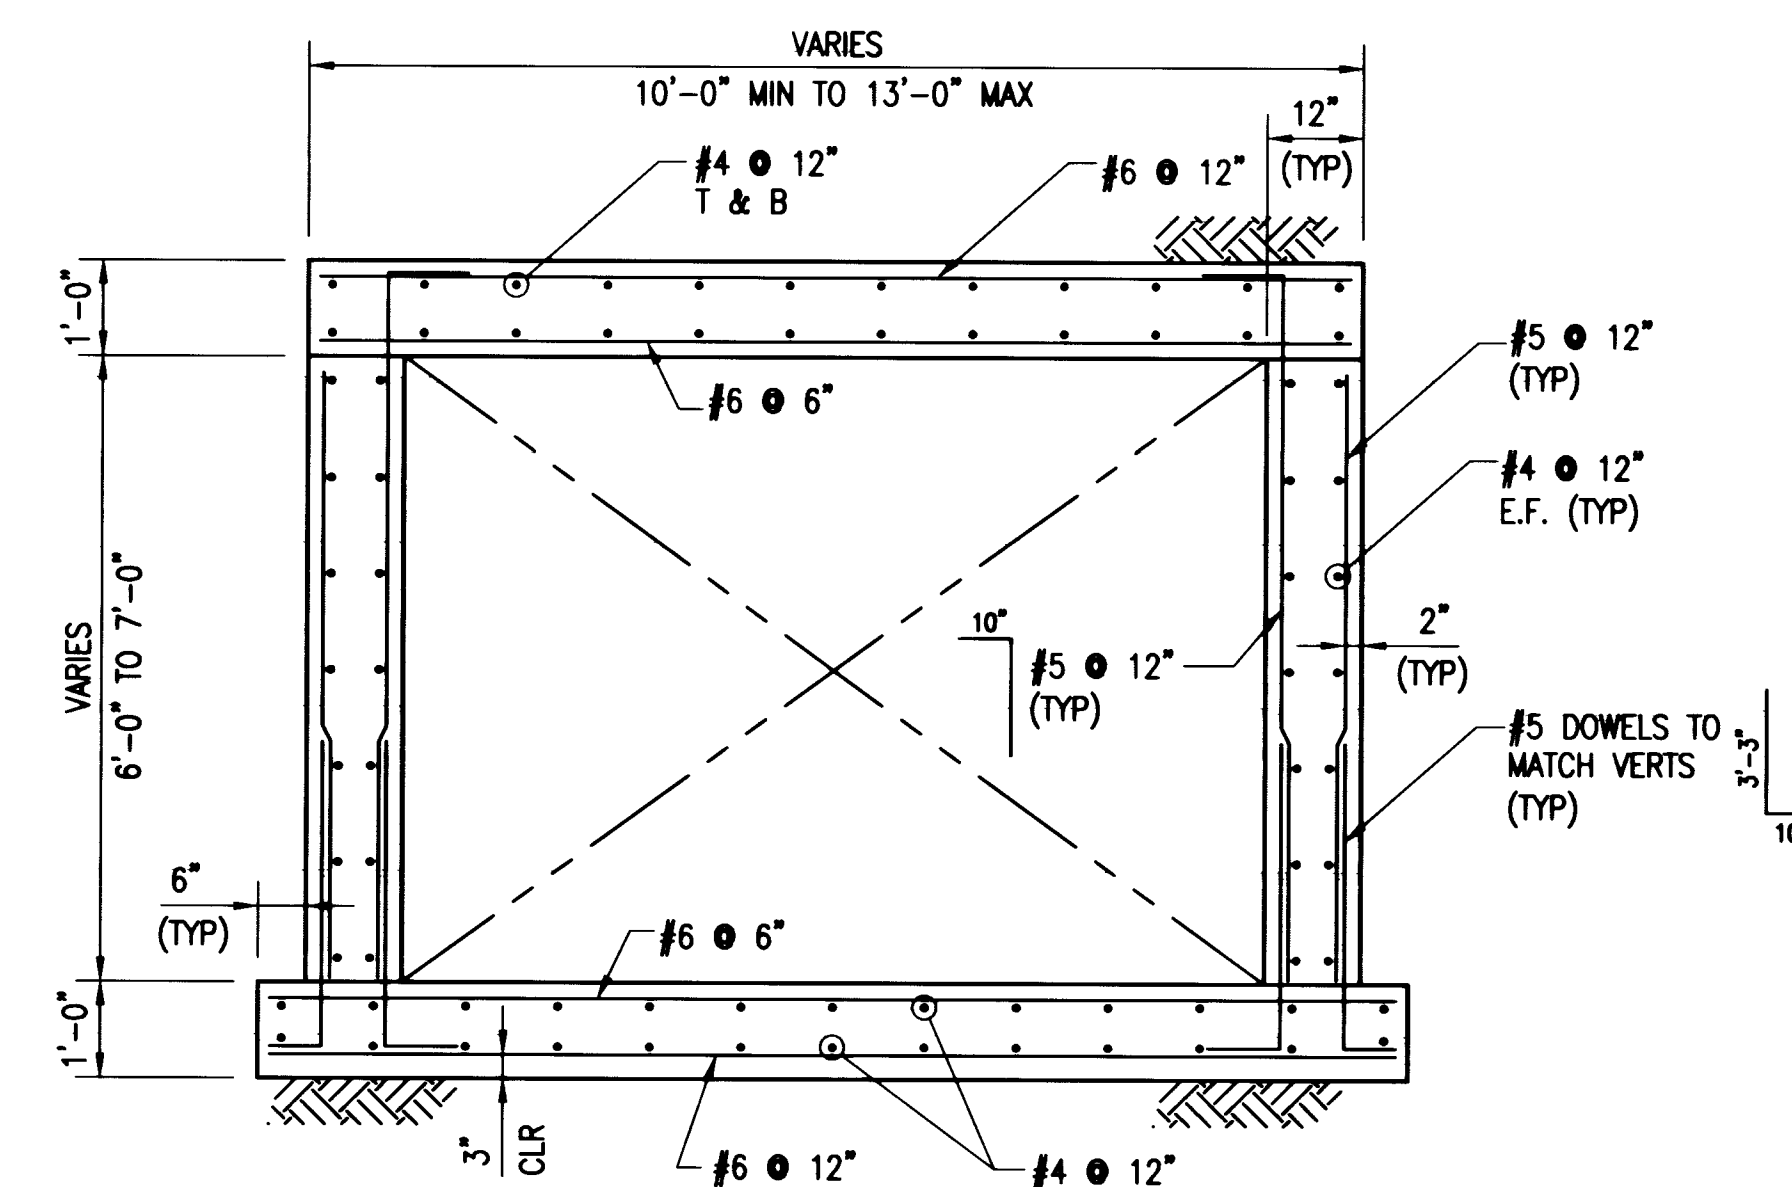
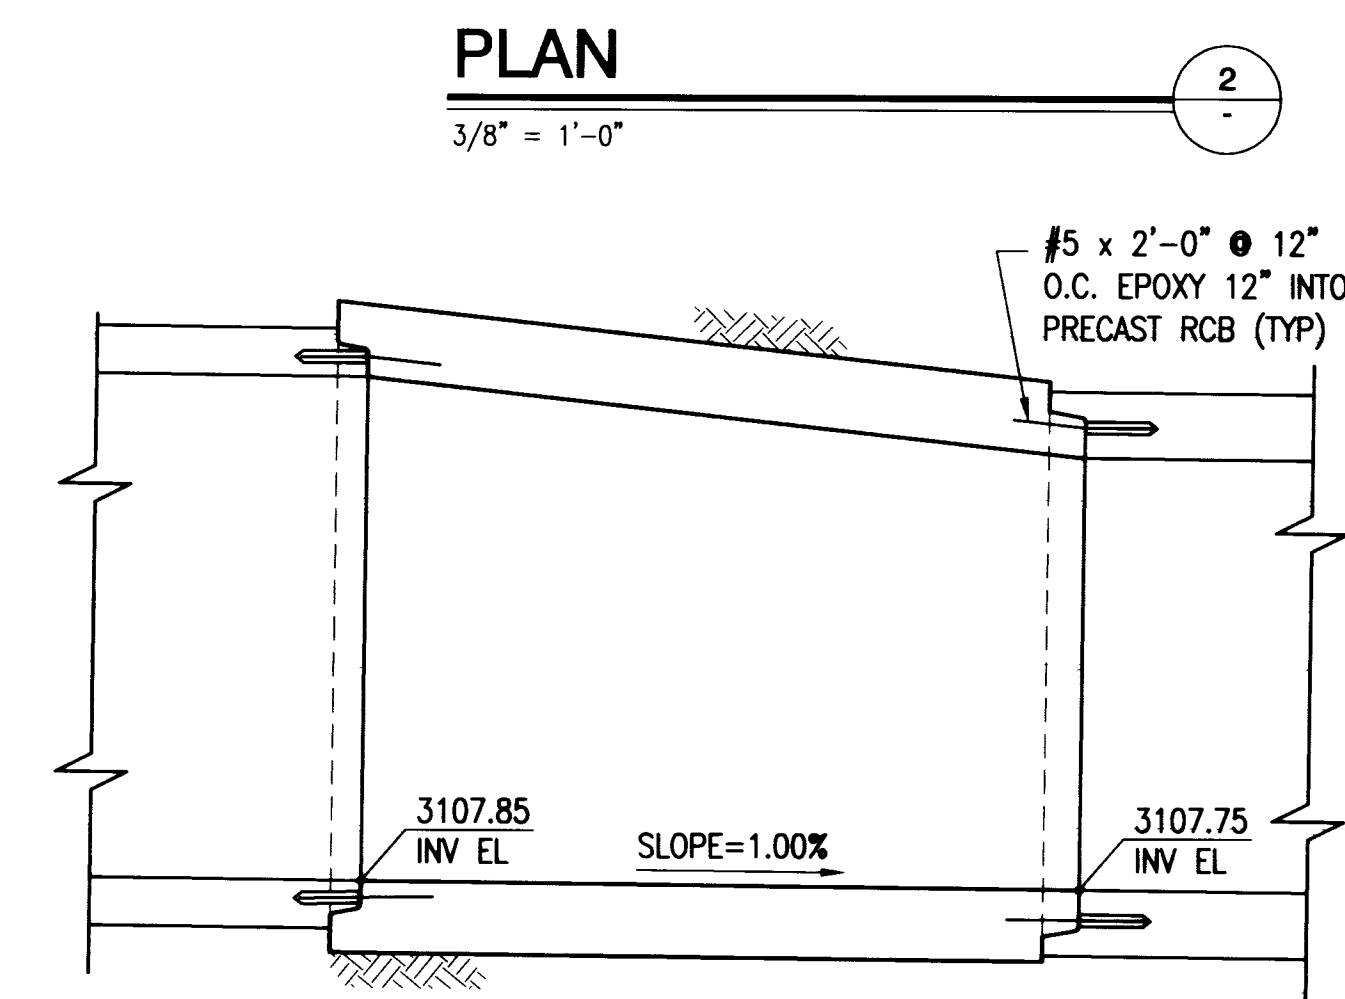
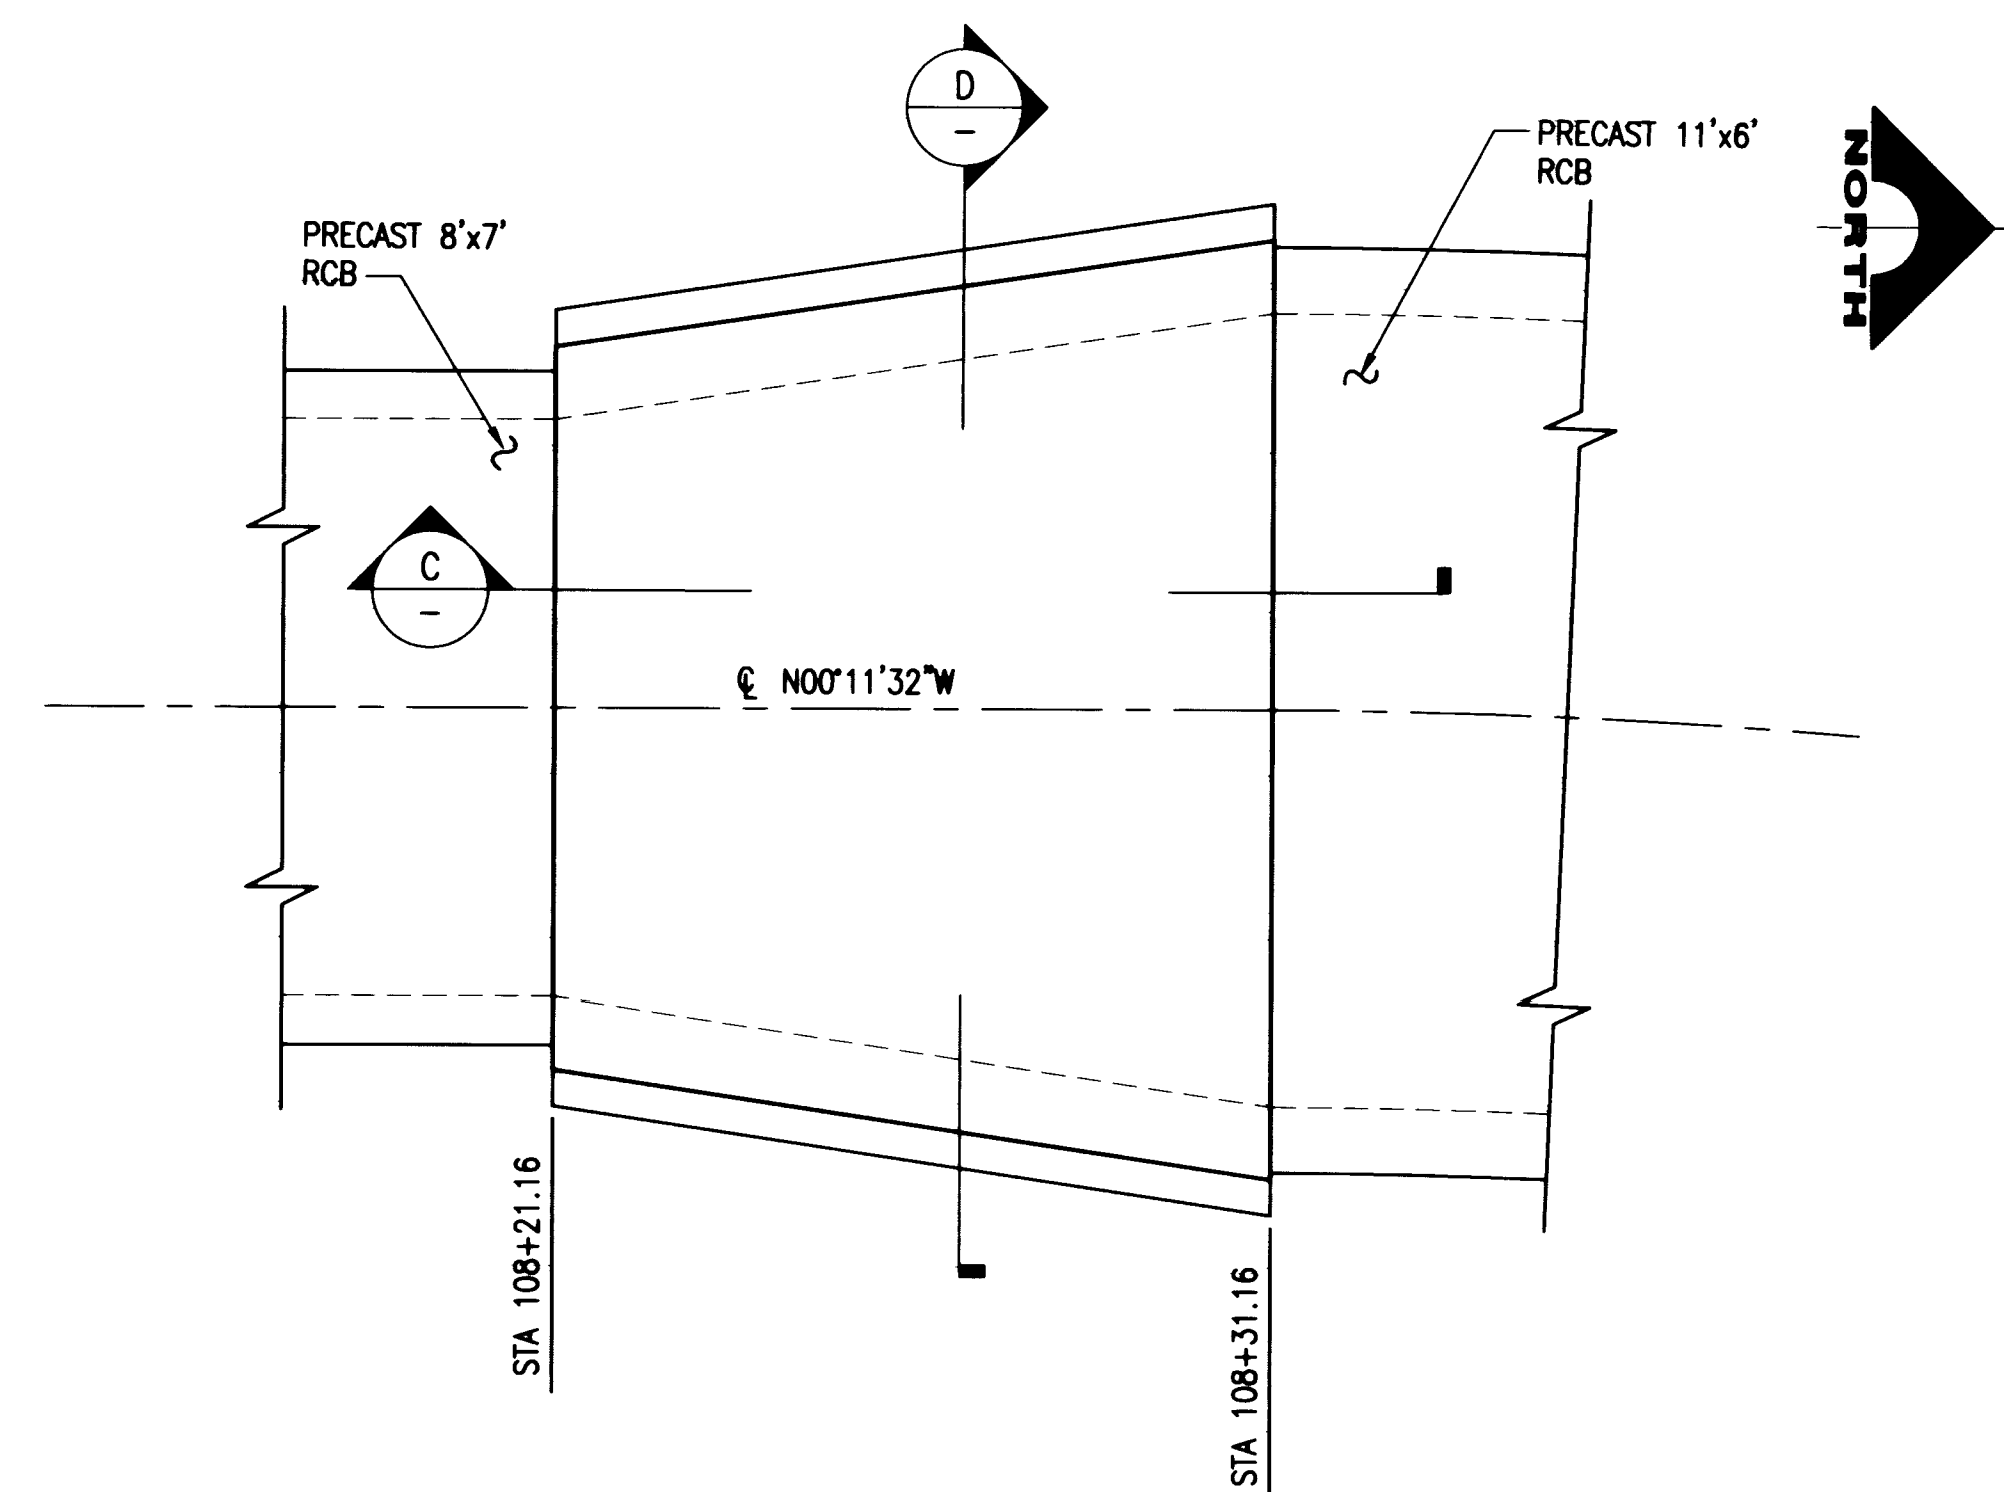
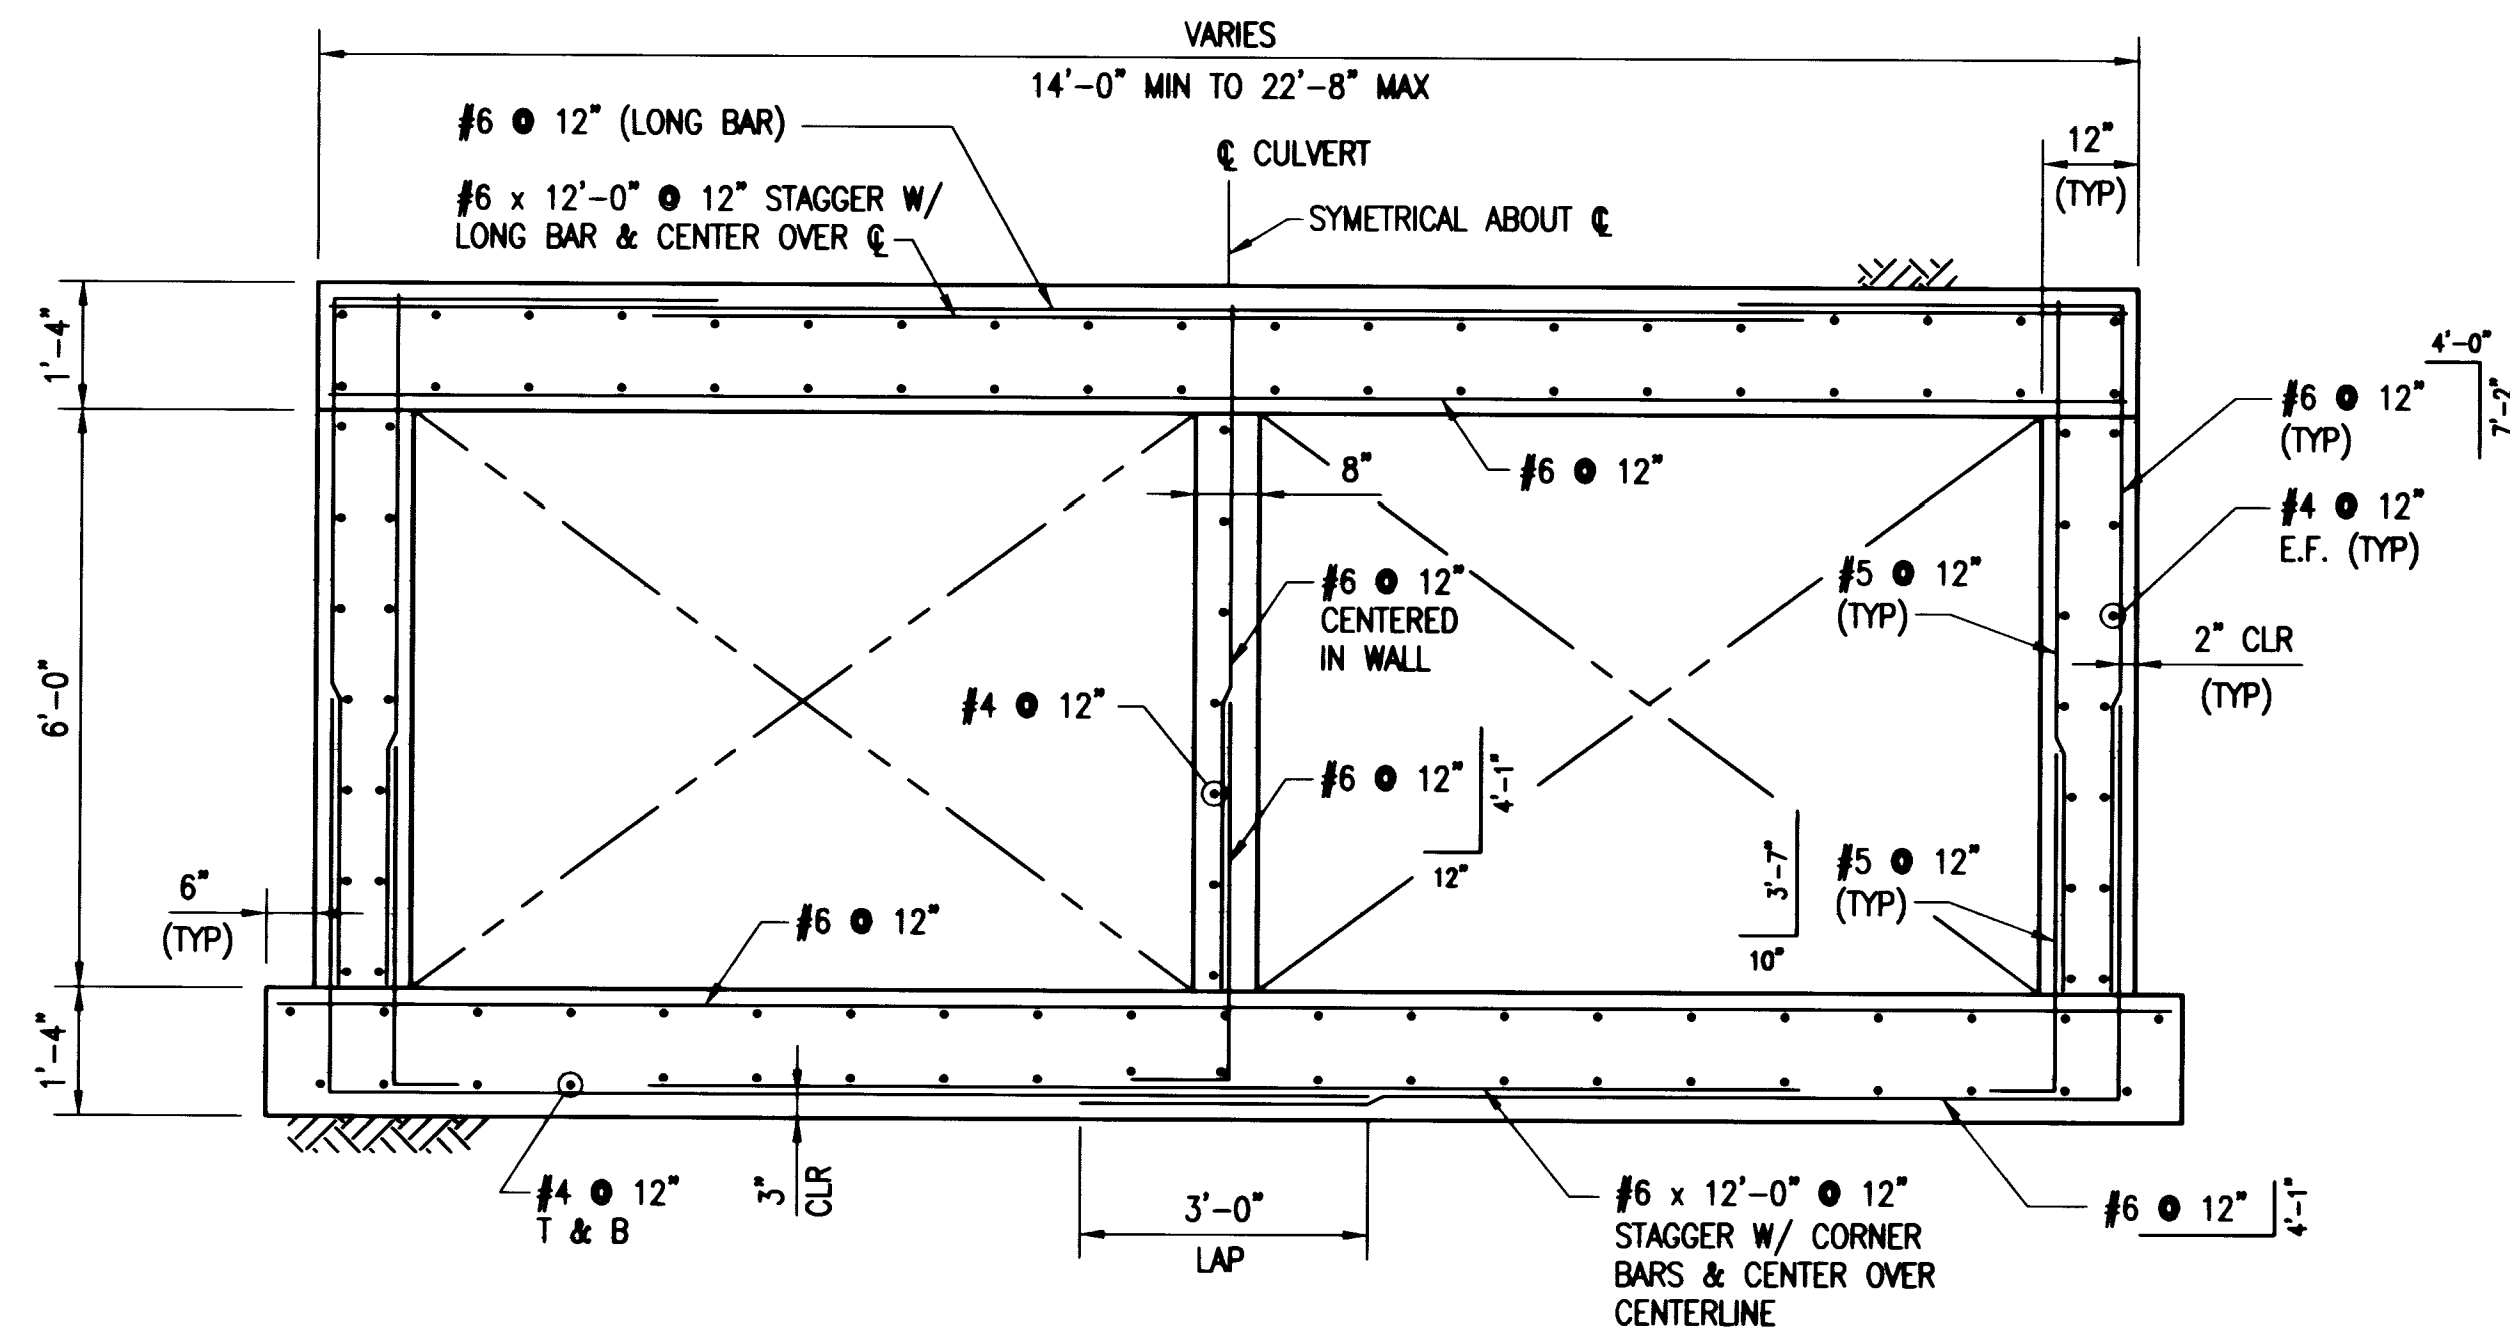
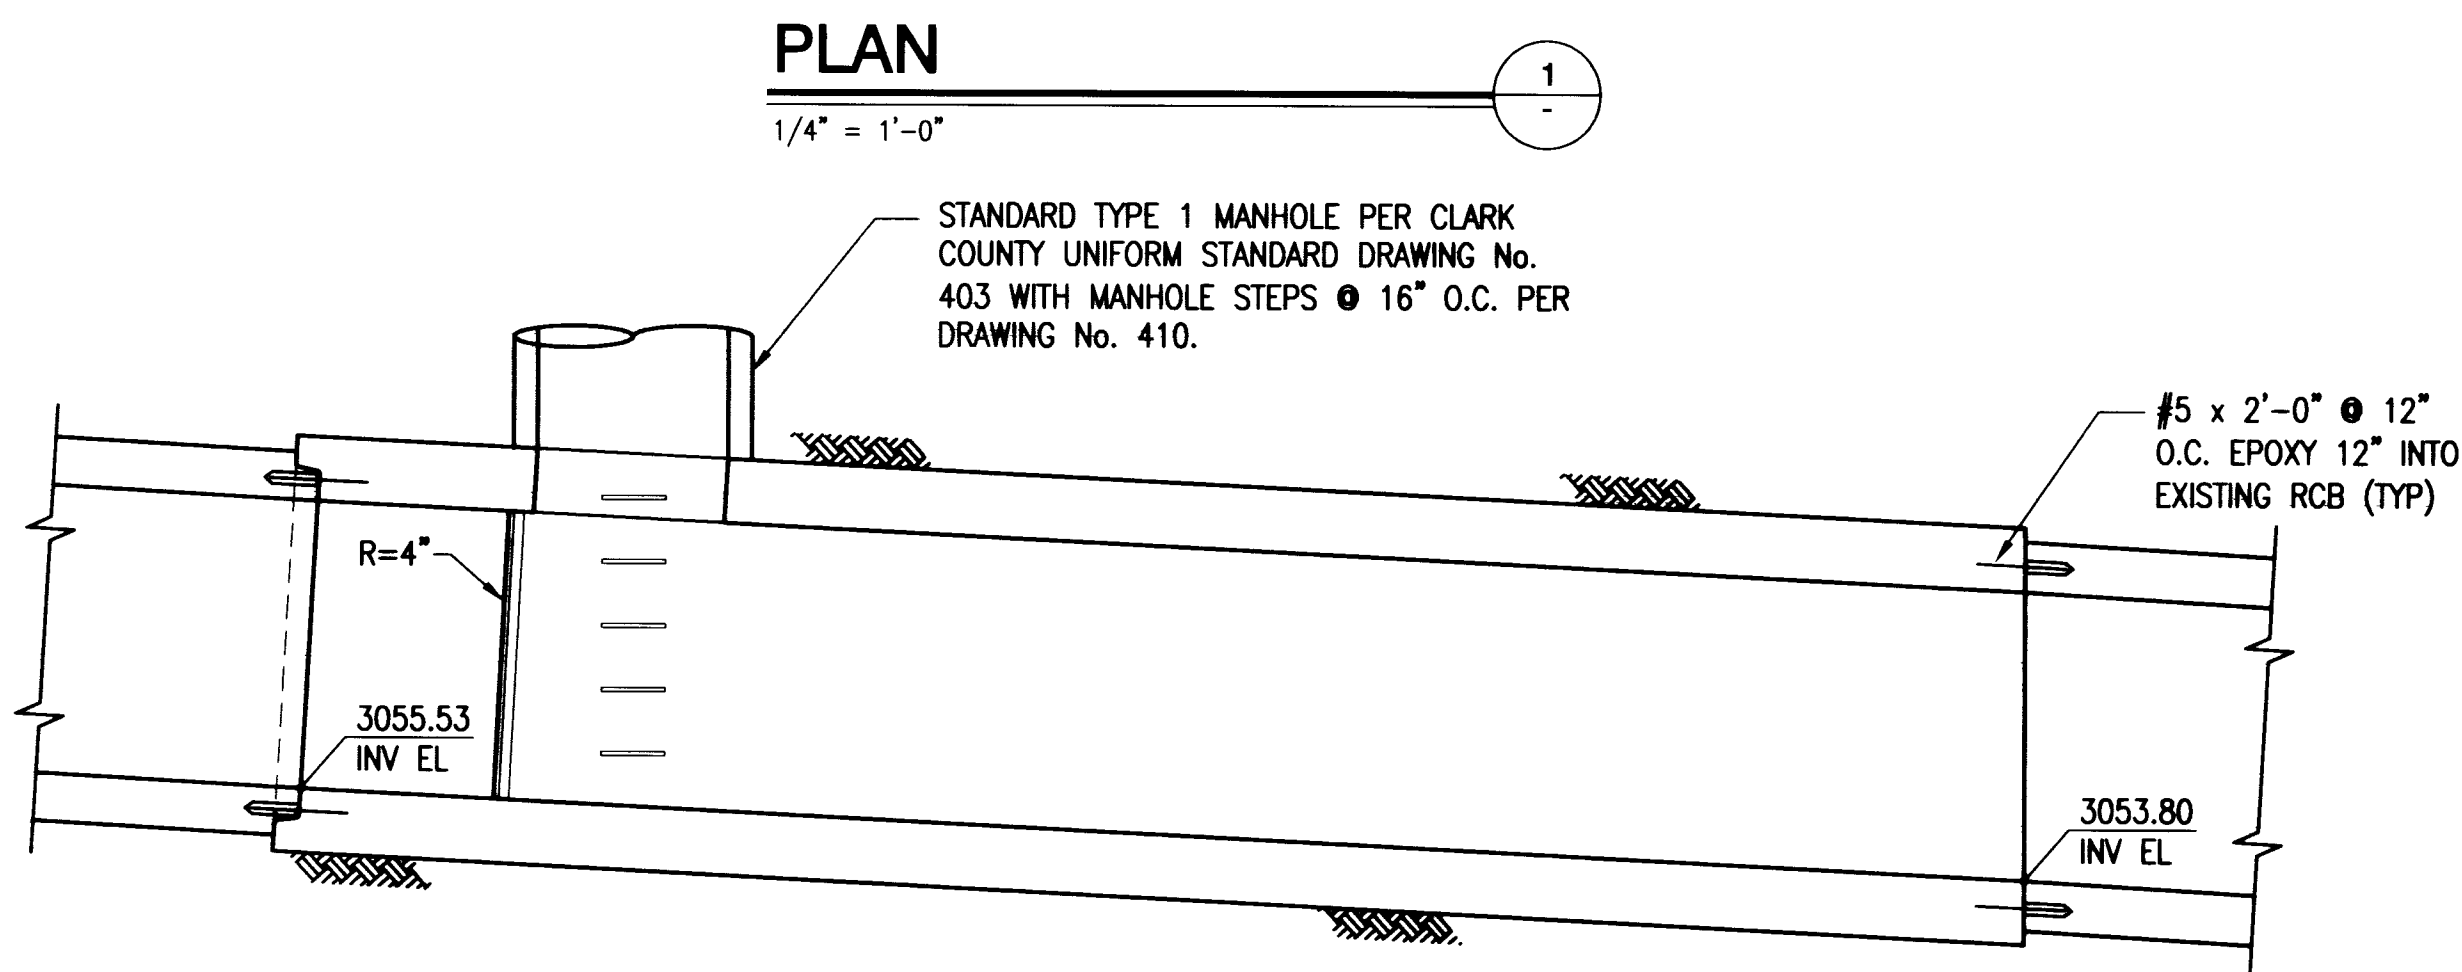


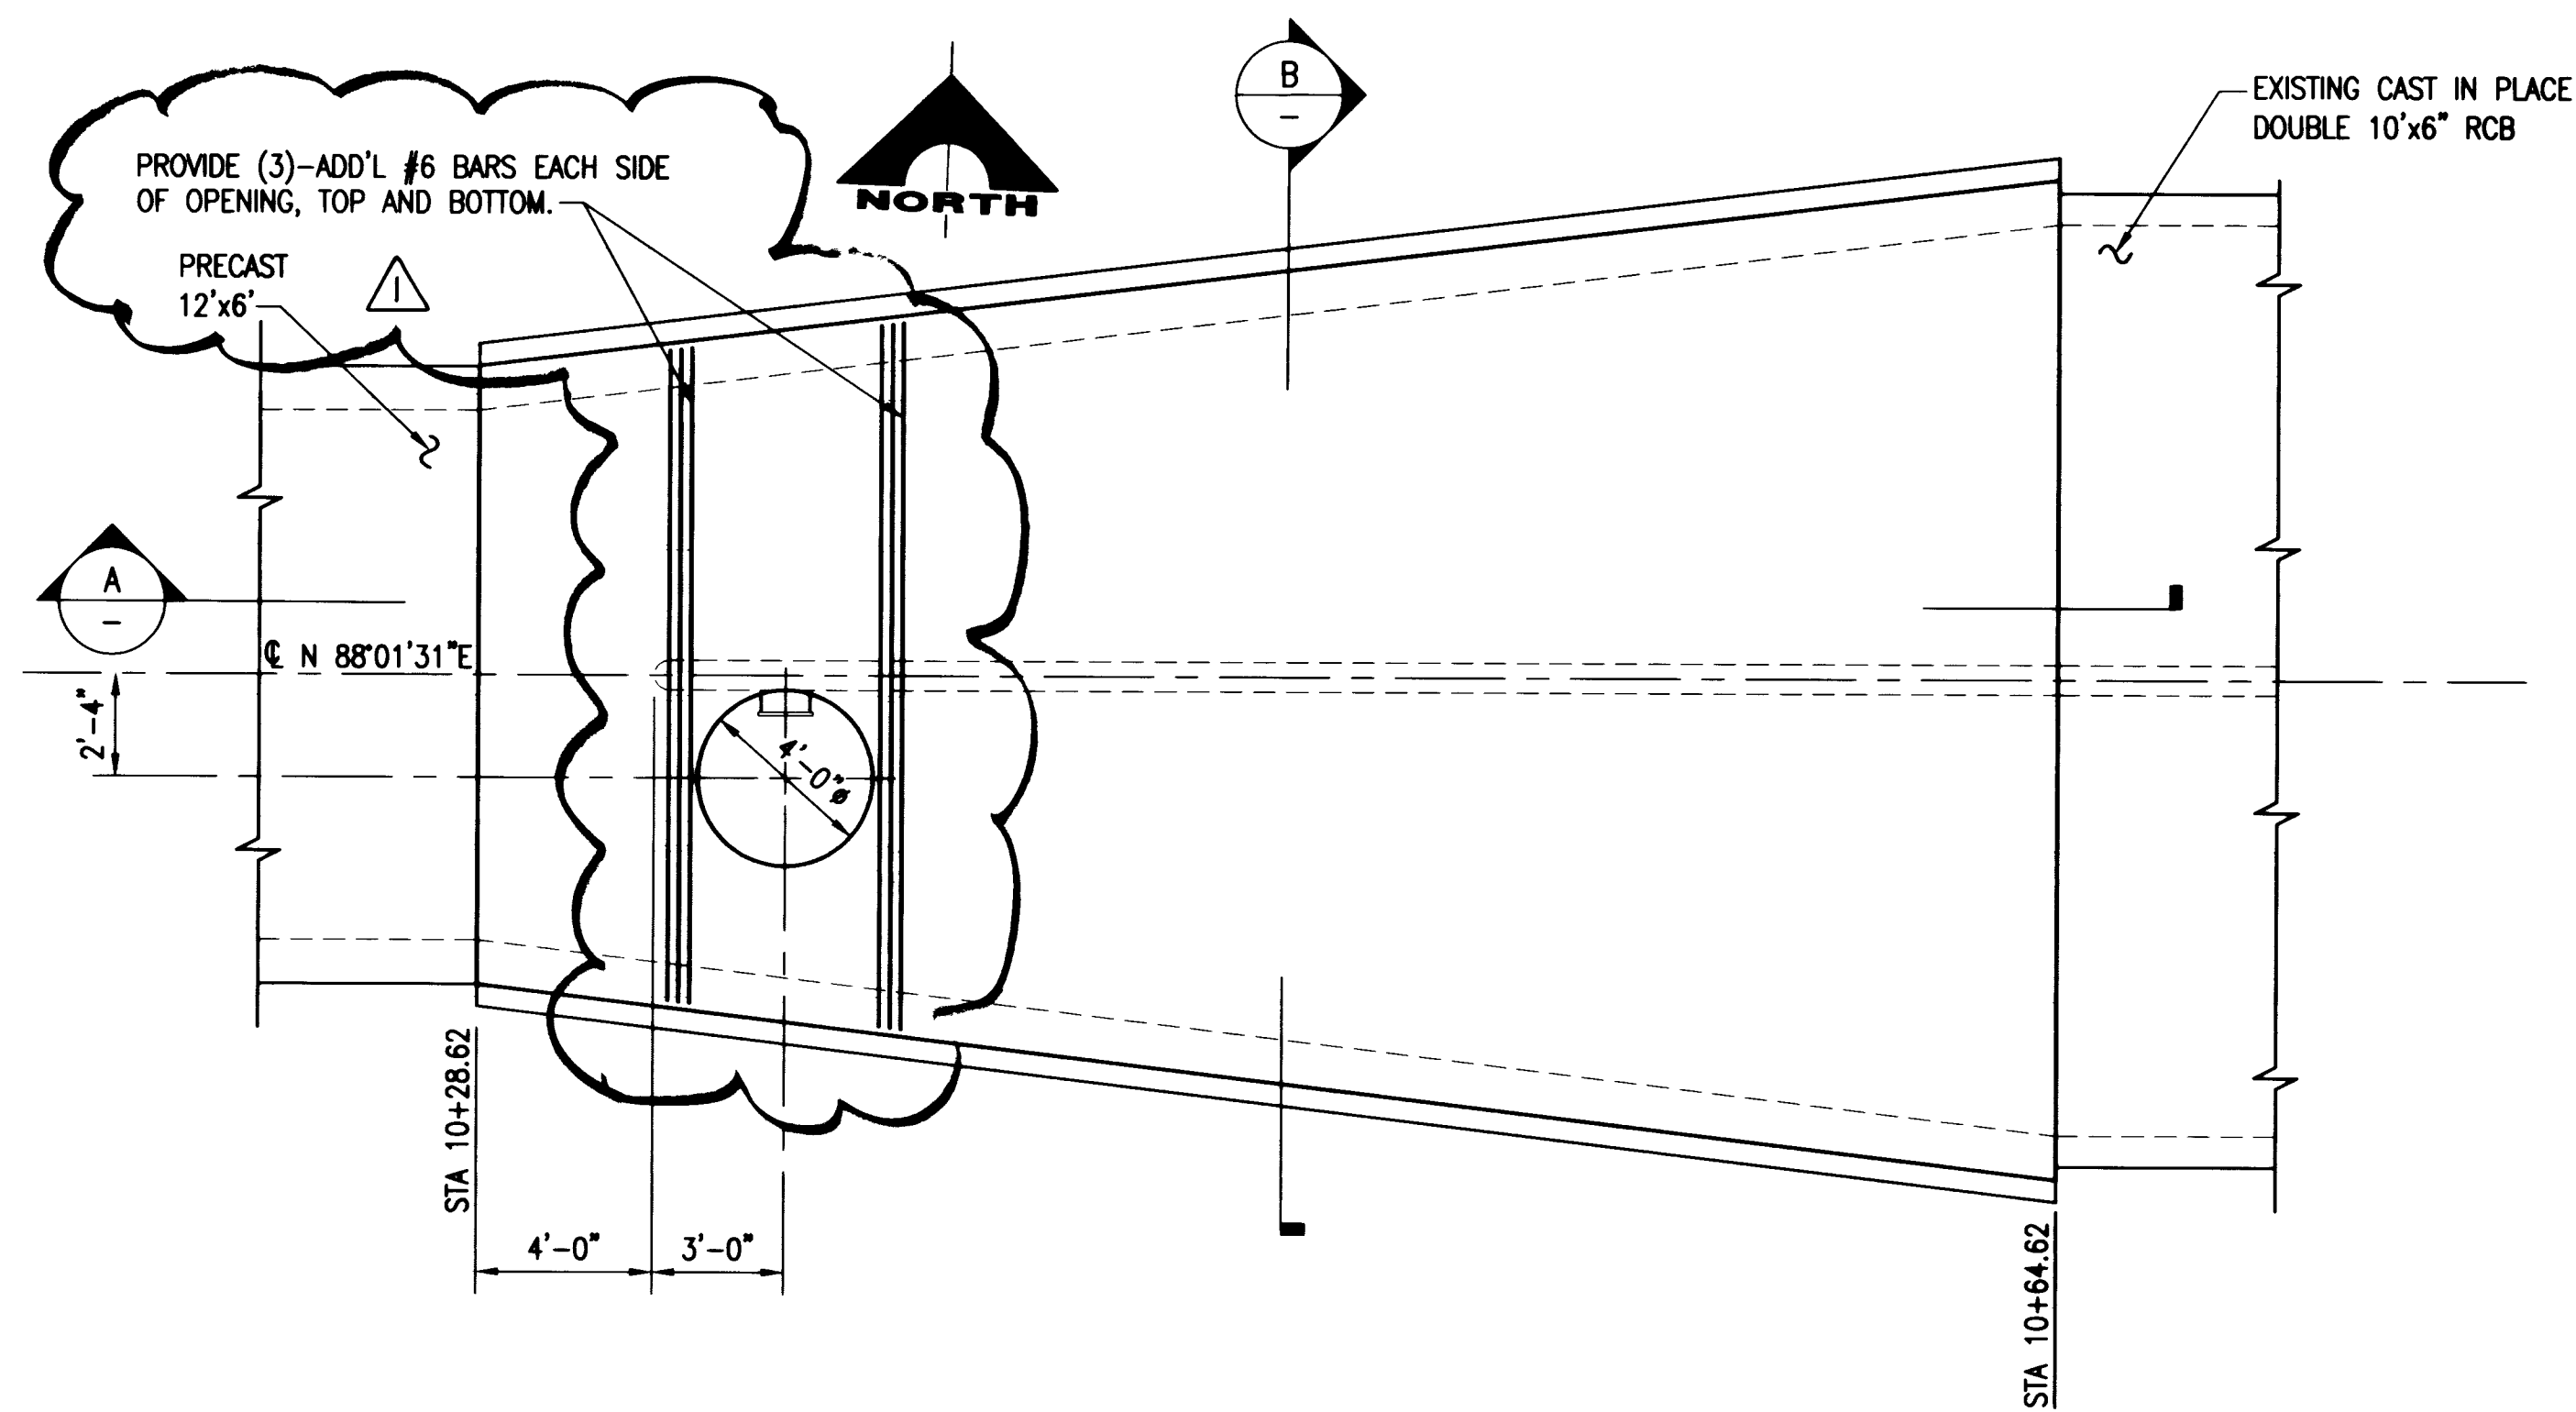


GENERAL NOTES:

CONCRETE: ALL CONCRETE SHALL BE CLASS D WITH A MINIMUM ULTIMATE COMPRESSIVE STRENGTH $f'_c=4500$ psi AT 28 DAYS. ALL CONCRETE SHALL BE MADE USING TYPE V CEMENT. ALL EXPOSED CORNERS SHALL BE BEVELED $3/4"$ UNLESS OTHERWISE NOTED.

REINFORCING STEEL: ALL REINFORCING STEEL SHALL BE ASTM A615, GRADE 60. DIMENSIONS RELATING TO BAR SPACING ARE CENTER TO CENTER. BENDING DIMENSIONS ARE FROM OUT TO OUT OF BARS. MINIMUM CLEARANCE TO REINFORCING STEEL SHALL BE 2" UNLESS OTHERWISE NOTED. HOOKS MAY BE ROTATED OR TILTED, AS NECESSARY, TO PROVIDE PROPER CLEARANCES

BEDDING MATERIAL: BEDDING MATERIAL SHALL BE 6" OF CLARK COUNTY TYPE II AGGREGATE. THE BEDDING LAYER SHALL BE COMPACTED TO AT LEAST 90 PERCENT OF THE MAXIMUM DRY DENSITY AS ESTABLISHED BY ASTM TEST METHOD D-1557.

EXISTING UTILITIES: THE CONTRACTOR SHALL BE RESPONSIBLE FOR LOCATING ALL EXISTING UTILITIES WITHIN THE WORK AREA, AND PROVIDING PROTECTION FOR THE VARIOUS UTILITIES AFFECTED, BEFORE PROCEEDING WITH THE WORK.

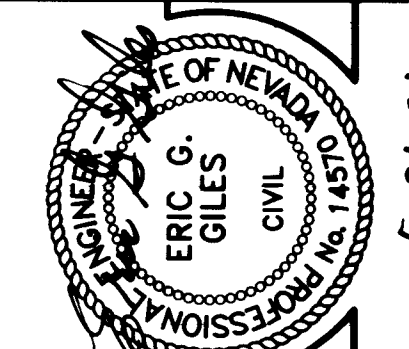

DATE: 5-24-01

DATE: 10-14-01









G. C. WALLACE, INC.
Engineering/Architecture
1545 SOUTH RAINBOW BLVD., SUITE 100, LAS VEGAS, NEVADA 89146
TELEPHONE: (702) 804-2000 • FAX: (702) 804-2299
G:\2020-2251\Draws\Improvements\Structural\RCB5001.dwg

VILLAGE 20, UNIT 1 REGIONAL DRAINAGE IMPROVEMENTS
TRANSITION STRUCTURES

SHEET
9-1
17 OF 18 SHTS

32374

REPLLOT