



DESIGN: D02/ALI	DATE: 12/02
DRAWN: SUG	SCALE: AS SHOWN
CHECK: _____	PROJECT: V23A
ISSUE DATE: _____	DESCRIPTION: REVISION STREET NAMES
ISSUE EDITOR: _____	REV. 01
PLOT DATE: 05-01-02	REV. 02
PLOT TIME: 13:37:57	REV. 03
	REV. 04
	REV. 05
	REV. 06
	REV. 07
	REV. 08
	REV. 09
	REV. 10

G.C. WALLACE, INC.
 Engineers/Planners/Surveyors
 1355 SOUTH RAINBOW BLVD., SUITE 200, LAS VEGAS, NEVADA 89146
 SUMMERLIN OFFICE 10000 CHARLESTON BLVD., STE. 130
 OFFICE: (702) 804-2160, FAX: (702) 804-2295
 E:\V23A RoughGrade-A Views\mpa\23Ags045.dwg

SUMMERLIN
 VILLAGE 23A ROUGH GRADING
 LOT 'ES-1' MASS GRADING

SHEET
45
 45 OF 45 SHTS

JOB NO. 620263.010

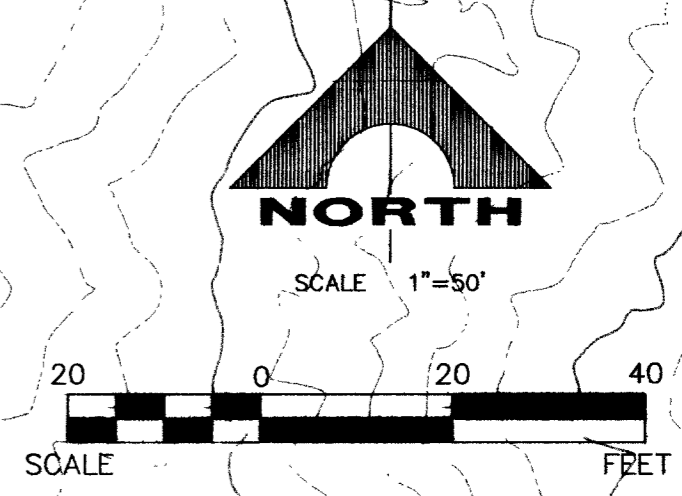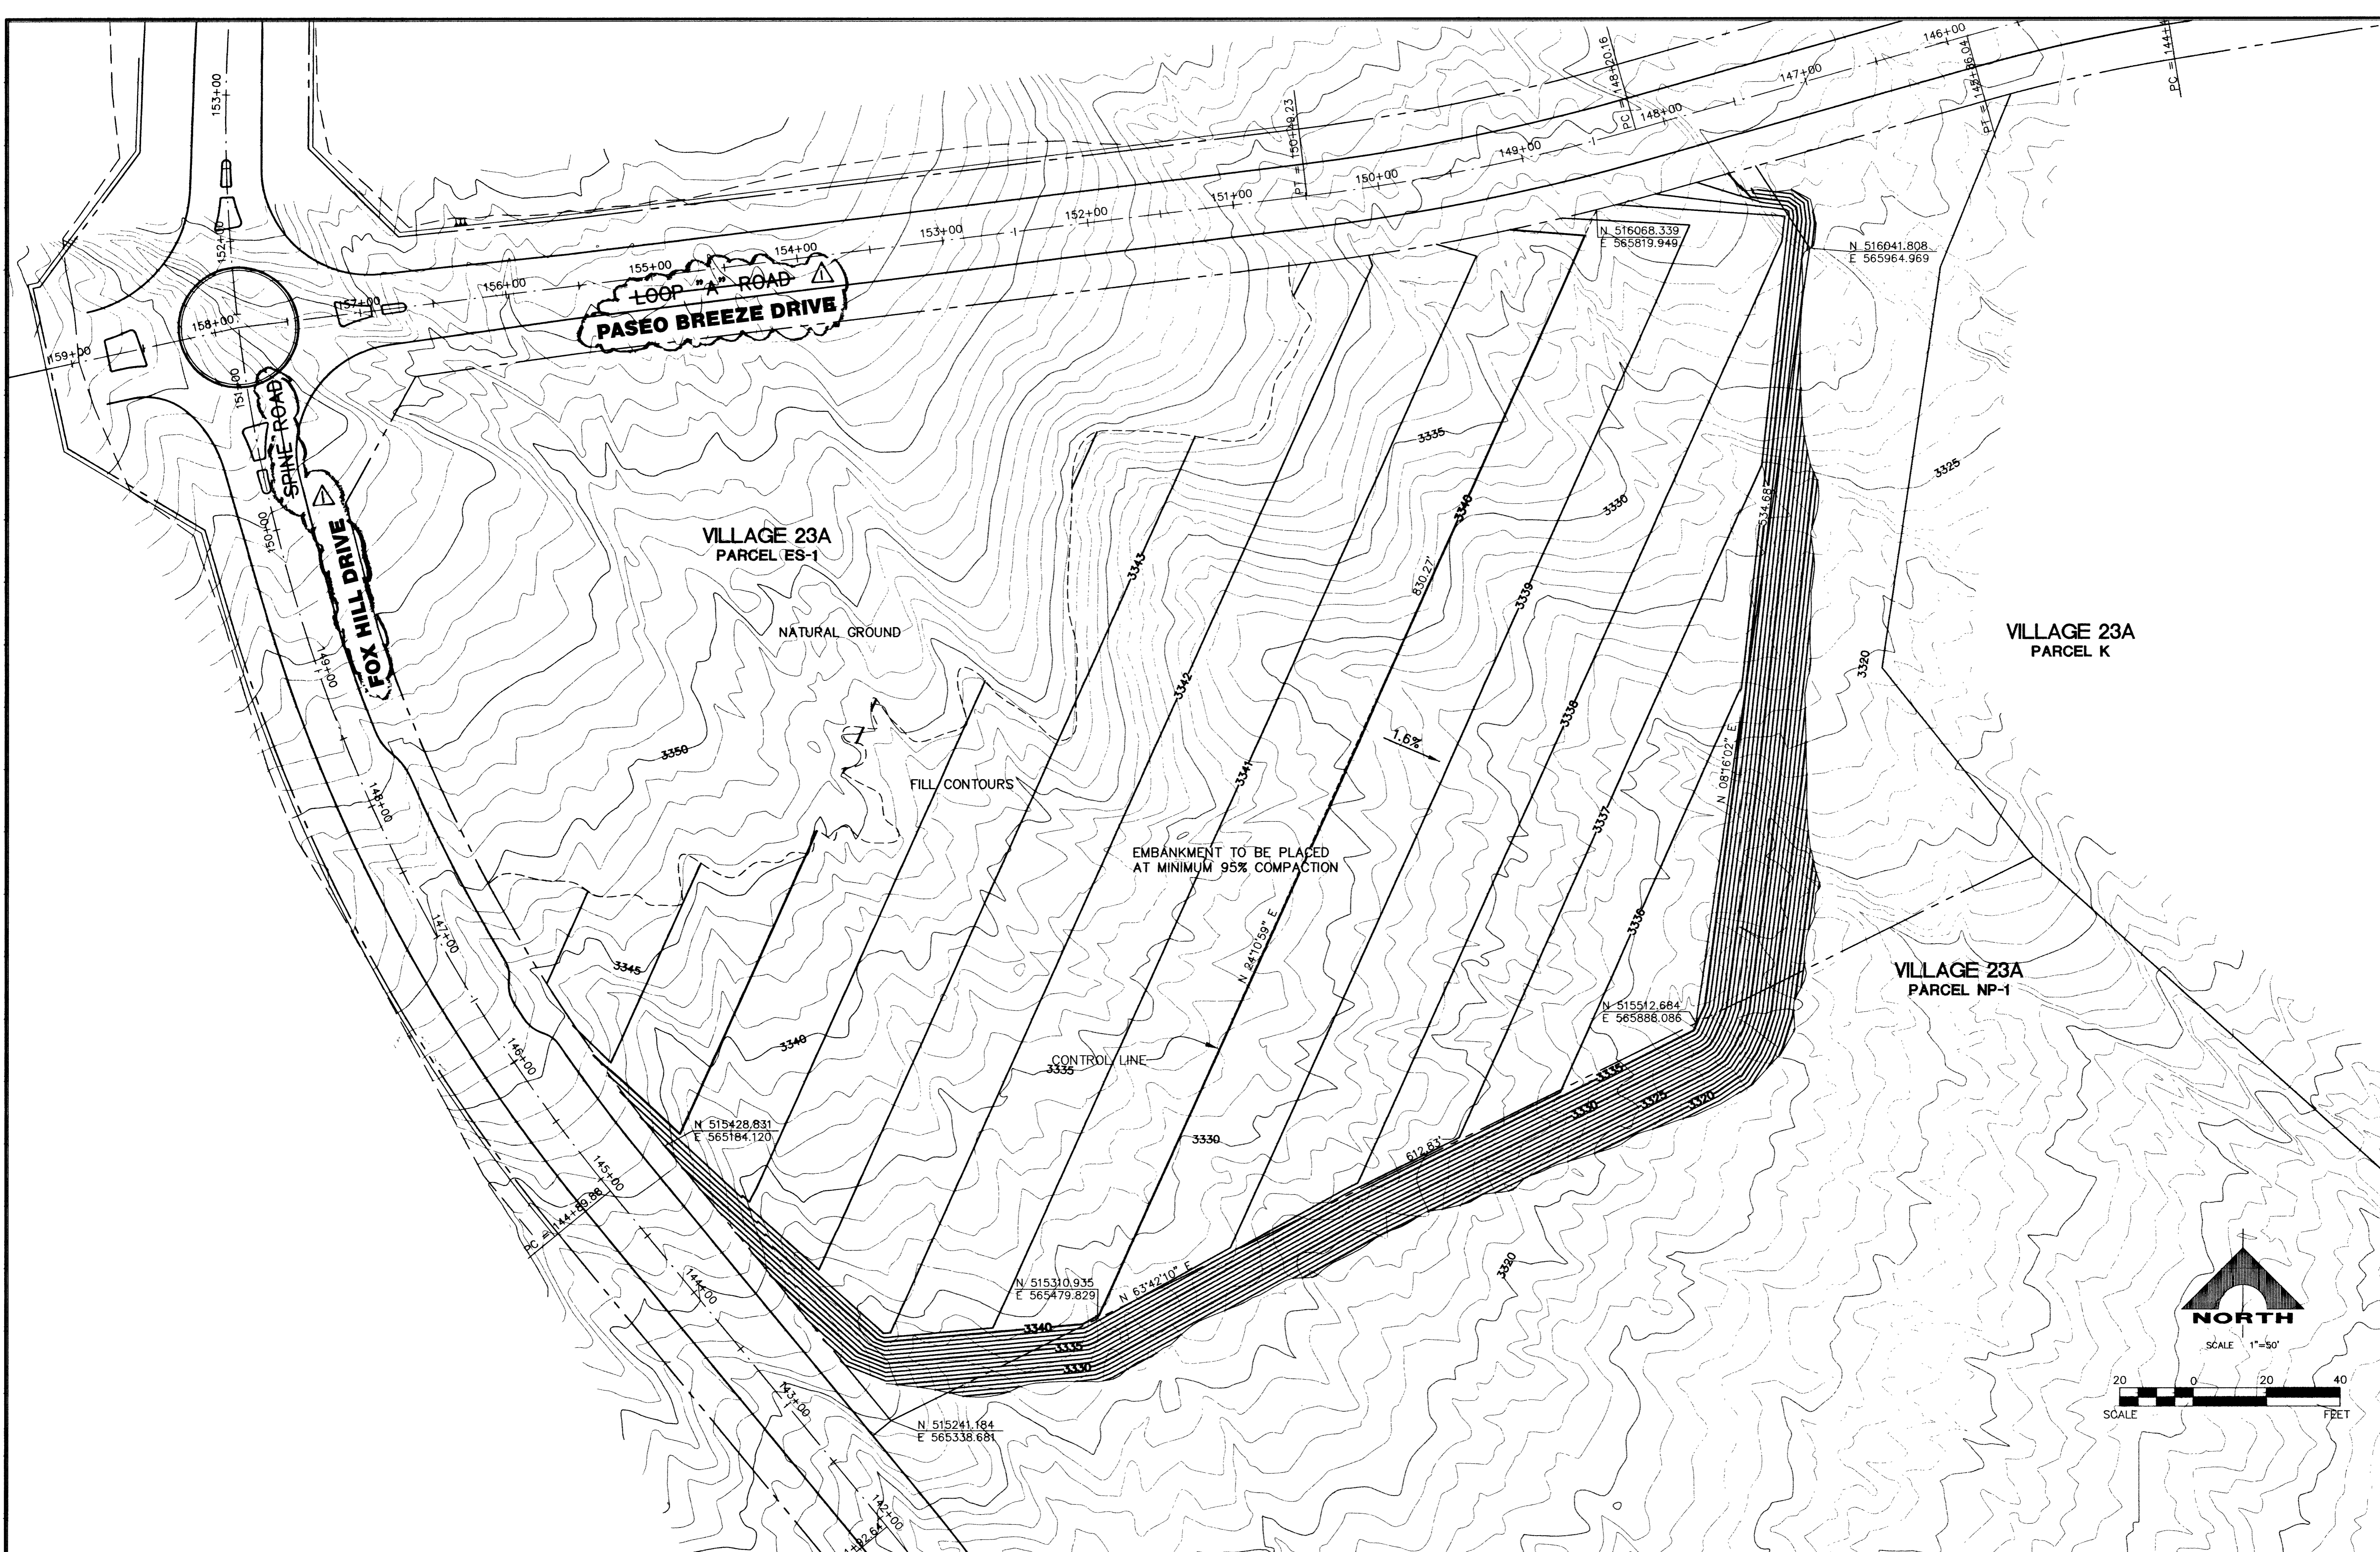

BENCHMARK			
BM #	DESC.	NAVD 88 DATUM	NAVD 88 DATUM
QLV09-345SER	NDOT BRASS CAP, 50 FEET NORTH OF STATION 787+19.42 OF CHARLESTON BOULEVARD.	3209.81 (FEET)	978.351 (METERS)

BASIS OF BEARINGS
 NORTH 89°45'05" EAST BEING THE SOUTH LINE OF THE SOUTHWEST QUARTER (SW 1/4) OF SECTION 35, TOWNSHIP 20 SOUTH, RANGE 59 EAST, M.D.M., AS SHOWN BY MAP ON FILE IN FILE 91, PAGE 28 OF PARCEL MAPS IN THE CLARK COUNTY RECORDER'S OFFICE, CLARK COUNTY, NEVADA

PARCEL 'ES-1' MASS GRADING
 SCALE: HORIZ. 1" = 50'

NOTE
 THIS SET OF DRAWINGS IS BASED UPON NAVD 88 DATUM. PREVIOUS DRAWINGS MAY BE BASED ON OTHER DATUM. CARE SHOULD BE OBSERVED WHEN UTILIZING THIS SET OF DRAWINGS.

Avoid cutting underground utility lines. It's costly.
Call before you Dig.
 1-800-227-2600
UNDERGROUND SERVICE ALERT (USA)

Avoid hitting overhead power lines. It's costly.
CALL BEFORE YOU DO OVERHEAD
 CALL 1-702-593-6111