

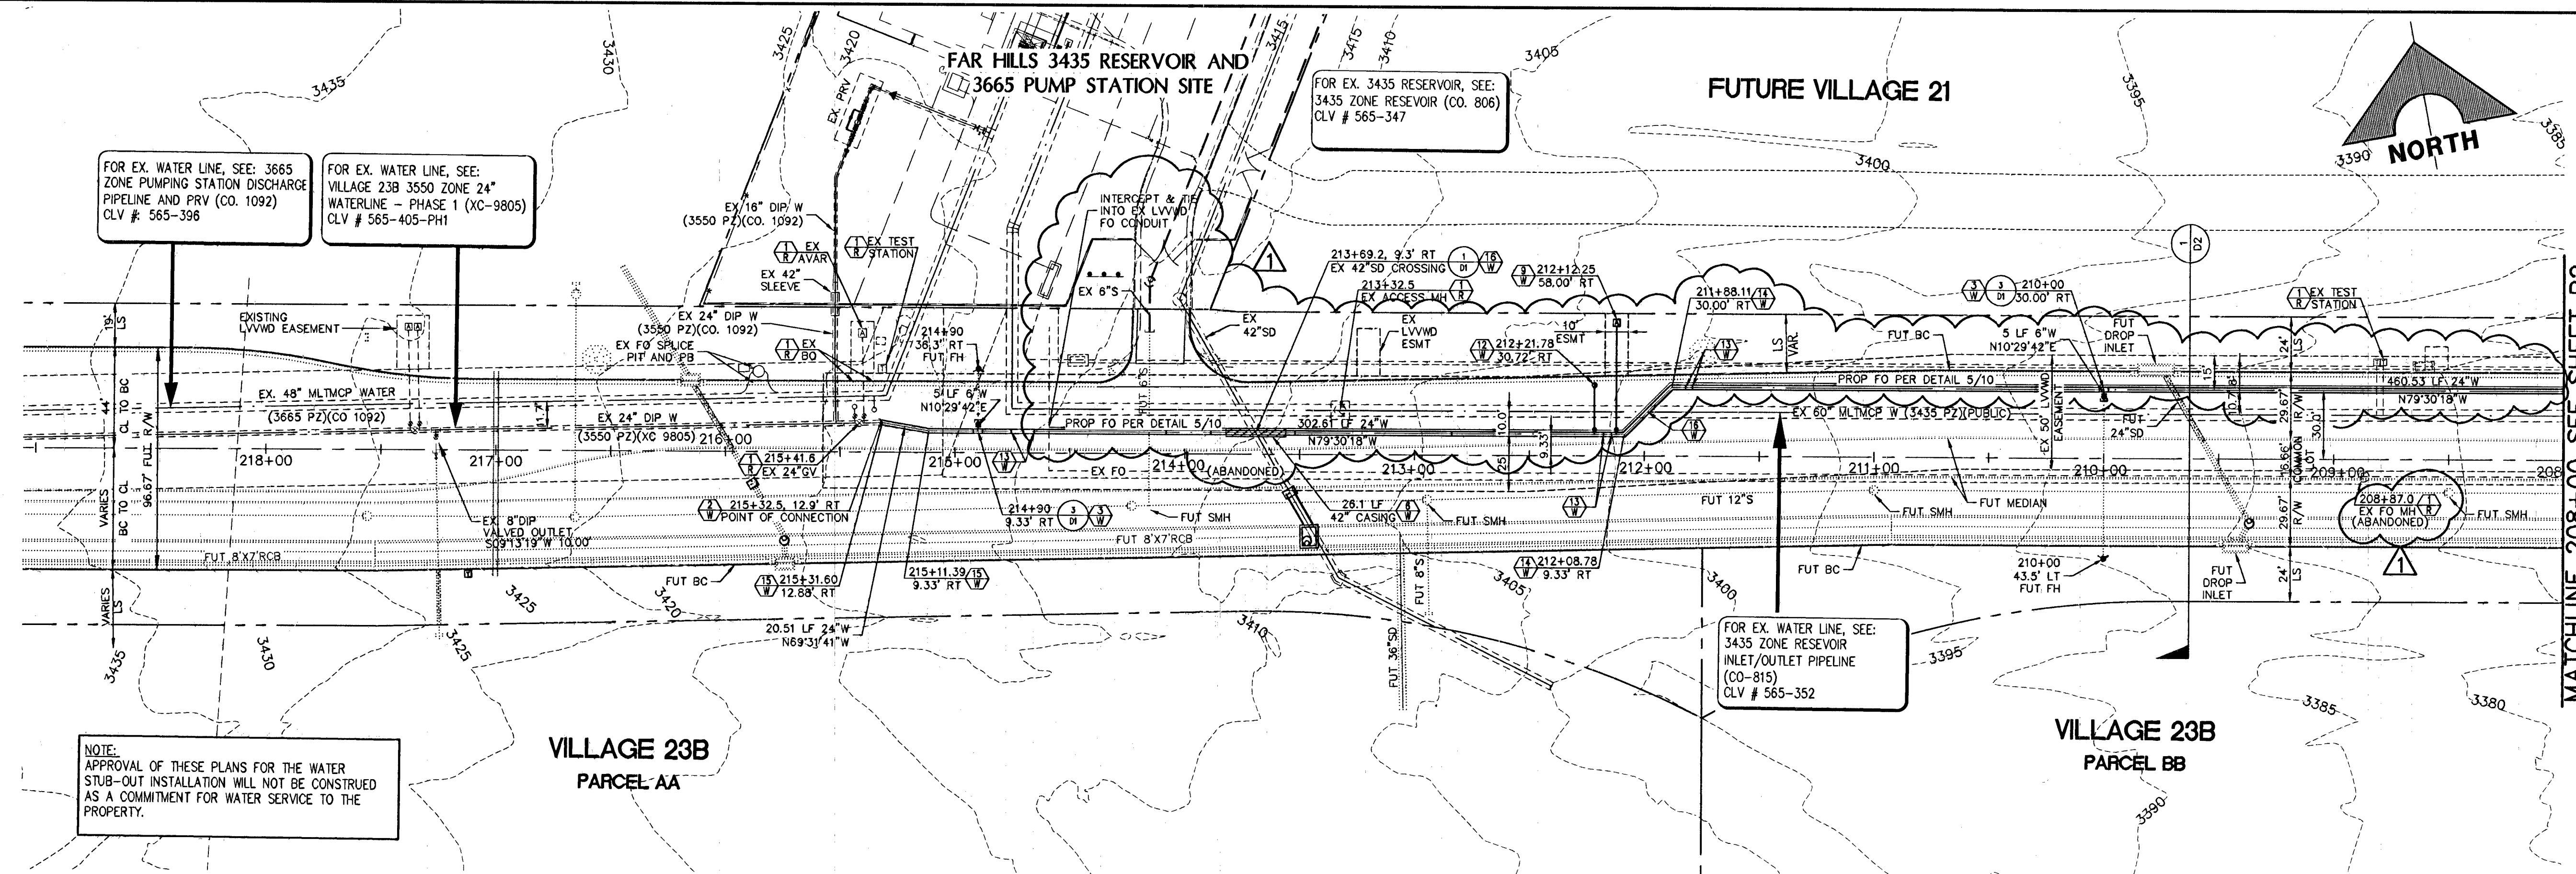


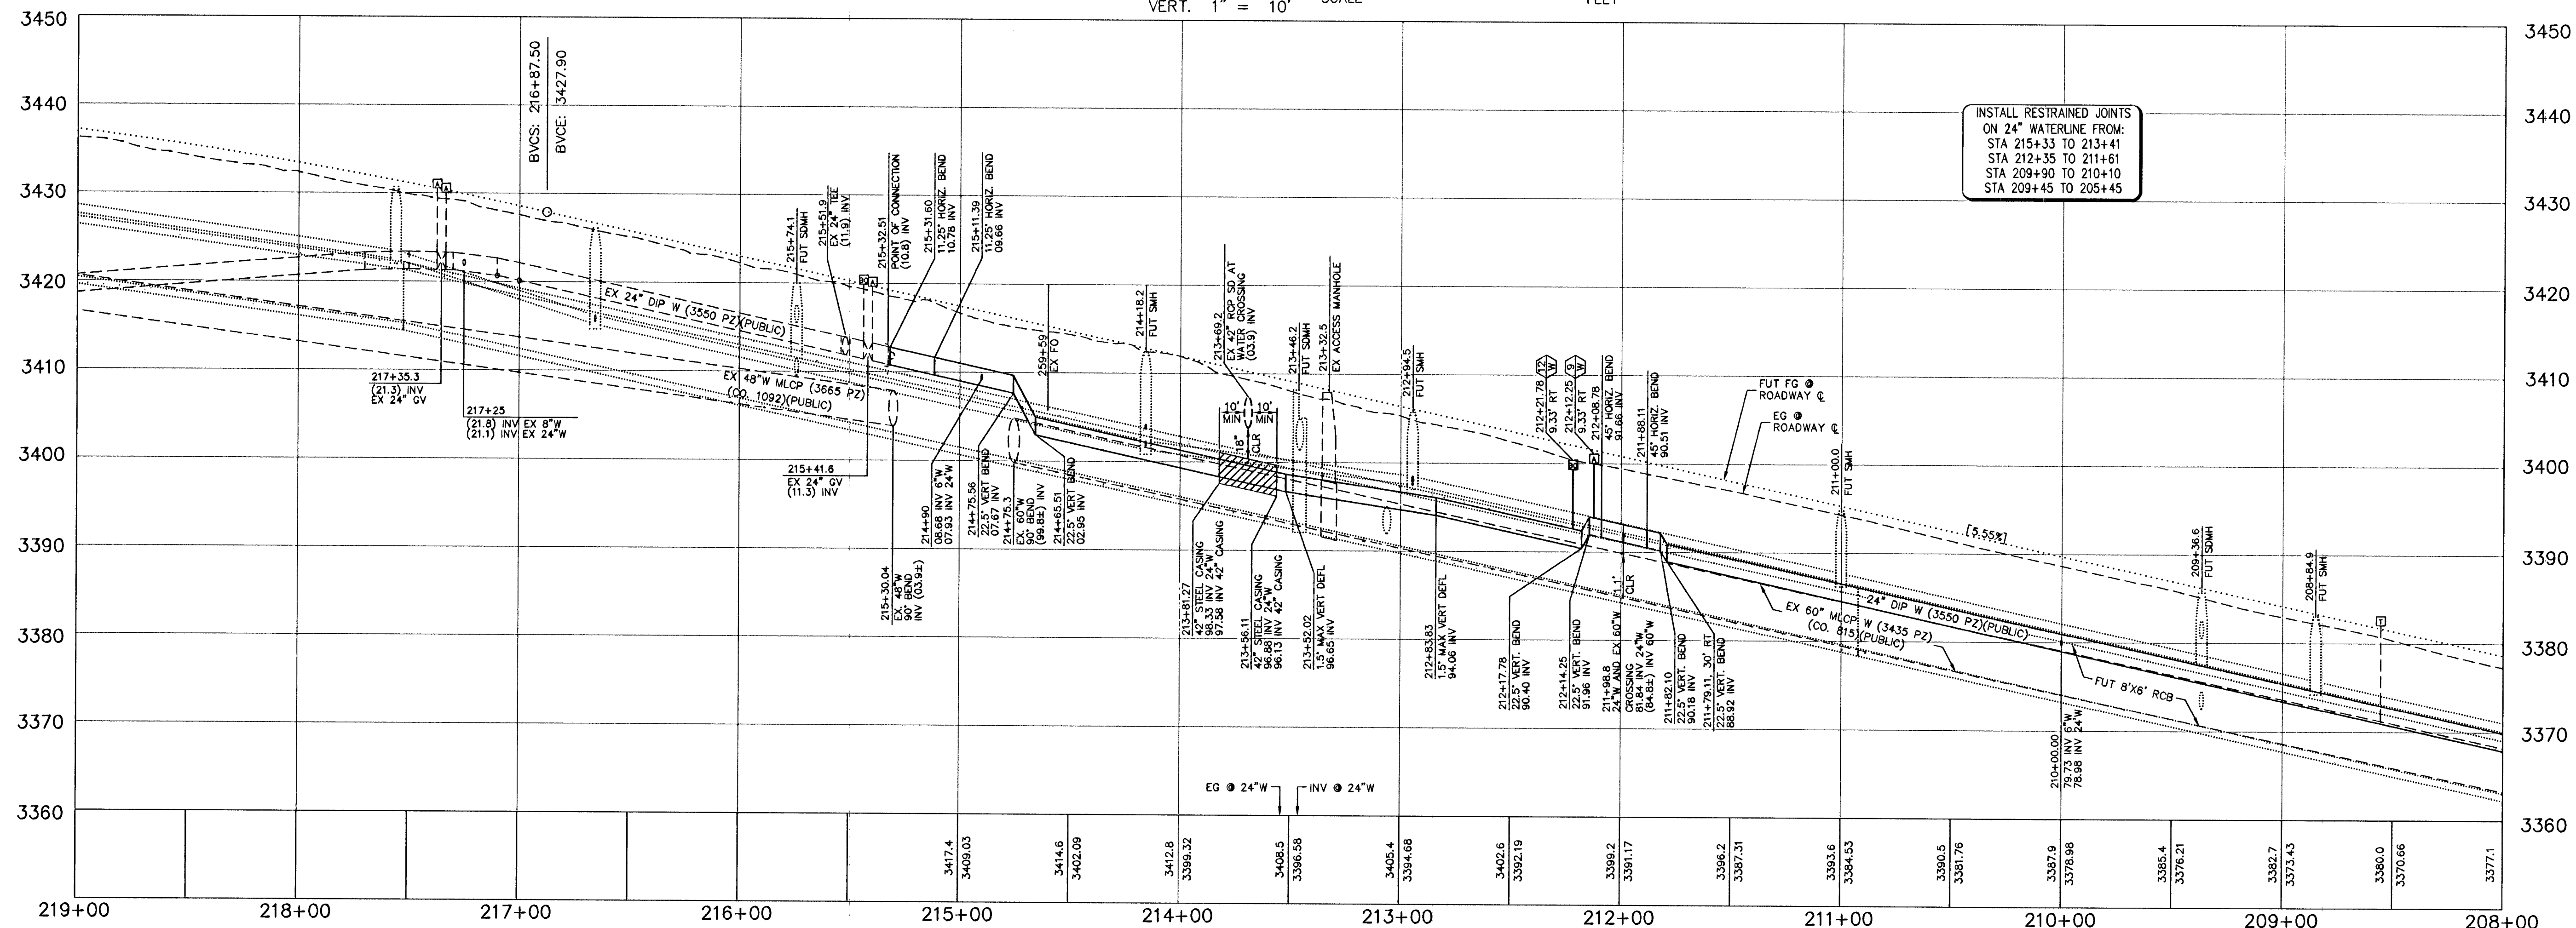

FAR HILLS AVENUE (FUTURE)

SCALE: HORIZ. 1" = 40'
VERT. 1" = 10'

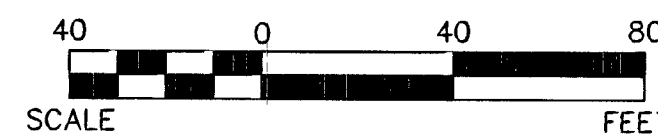

APPROVED FOR CONSTRUCTION

R. M. M.
CITY OF LAS VEGAS FIRE DEPARTMENT

11/29/14
DATE

NOTE

THIS SET OF DRAWINGS IS BASED UPON NAVD 88 DATUM. PREVIOUS DRAWINGS MAY BE BASED ON OTHER DATUM. CARE SHOULD BE OBSERVED WHEN UTILIZING THIS SET OF DRAWINGS.

BASIS OF BEARINGS

NORTH 89°45'05" EAST BEING THE SOUTH LINE OF THE SOUTHWEST QUARTER (SW 1/4) OF SECTION 35, TOWNSHIP 20 SOUTH, RANGE 59 EAST, M.D.M., AS SHOWN BY MAP ON FILE IN FILE 91, PAGE 28 OF PARCEL MAPS IN THE CLARK COUNTY RECORDER'S OFFICE, CLARK COUNTY, NEVADA.

BENCHMARK


DESCRIPTION	NAVD 88 DATUM (FEET)	NAVD 88 DATUM (METERS)
RIVET AND PLATE IN TOP OF CURB @ SOUTHEAST CORNER OF FAR HILLS AVENUE AND DESERT FOOTHILLS DRIVE	3335.35	1016.620
CLV BM No. 7LV09 27E4	3335.35	1016.620

APPROVED FOR CONSTRUCTION

1ST APP'D 9/26/13

R. M. M.
LAS VEGAS VALLEY WATER DISTRICT ENGINEERING SERVICES MANAGER
PROJECT NO. 121623 DATE: 11/26/14

H #48809
CLV DRAWING NO. 565-484

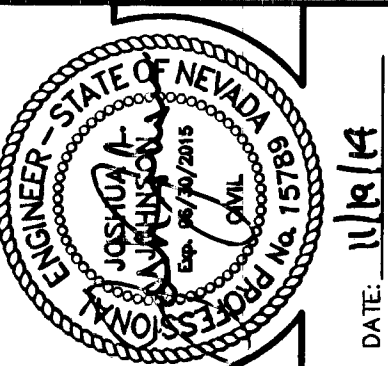

G.C. WALLACE COMPANIES
ENGINEERS | PLANNERS | SURVEYORS
1555 S. RAINBOW BOULEVARD - LAS VEGAS, NV 89146
T: 702.894.2000 - F: 702.894.2299 - GCWALLACE.COM

THE HOWARD HUGHES COMPANY, LLC
VILLAGE 23B 24" 3550 ZONE WATERLINE IMPROVEMENTS
FAR HILLS AVENUE PLAN AND PROFILE
FROM STA. 208+00 TO STA. 209+00

DRAWING

P1

6 OF 10 SHEETS

