

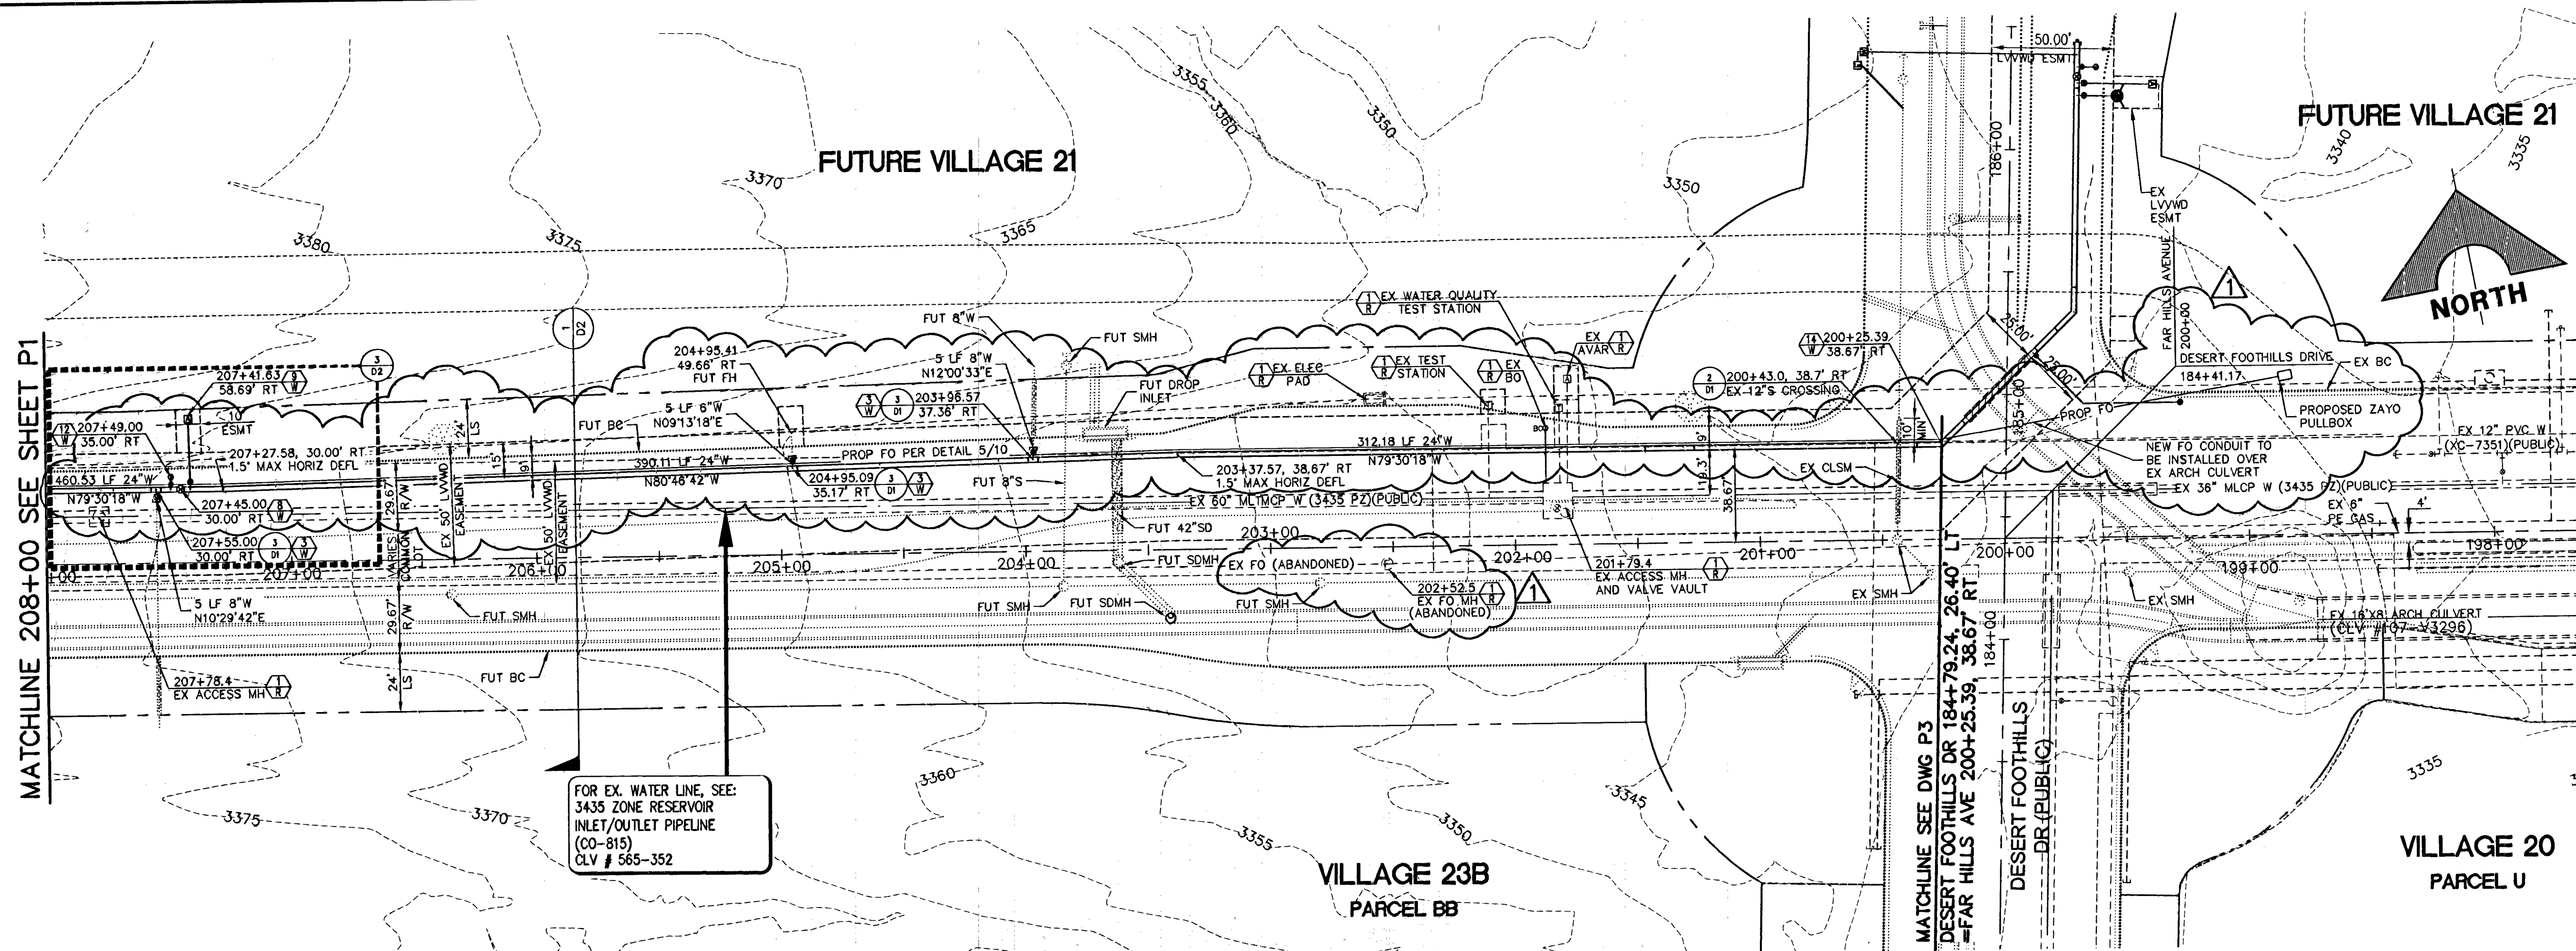


MATCHLINE 208+00 SEE SHEET P1

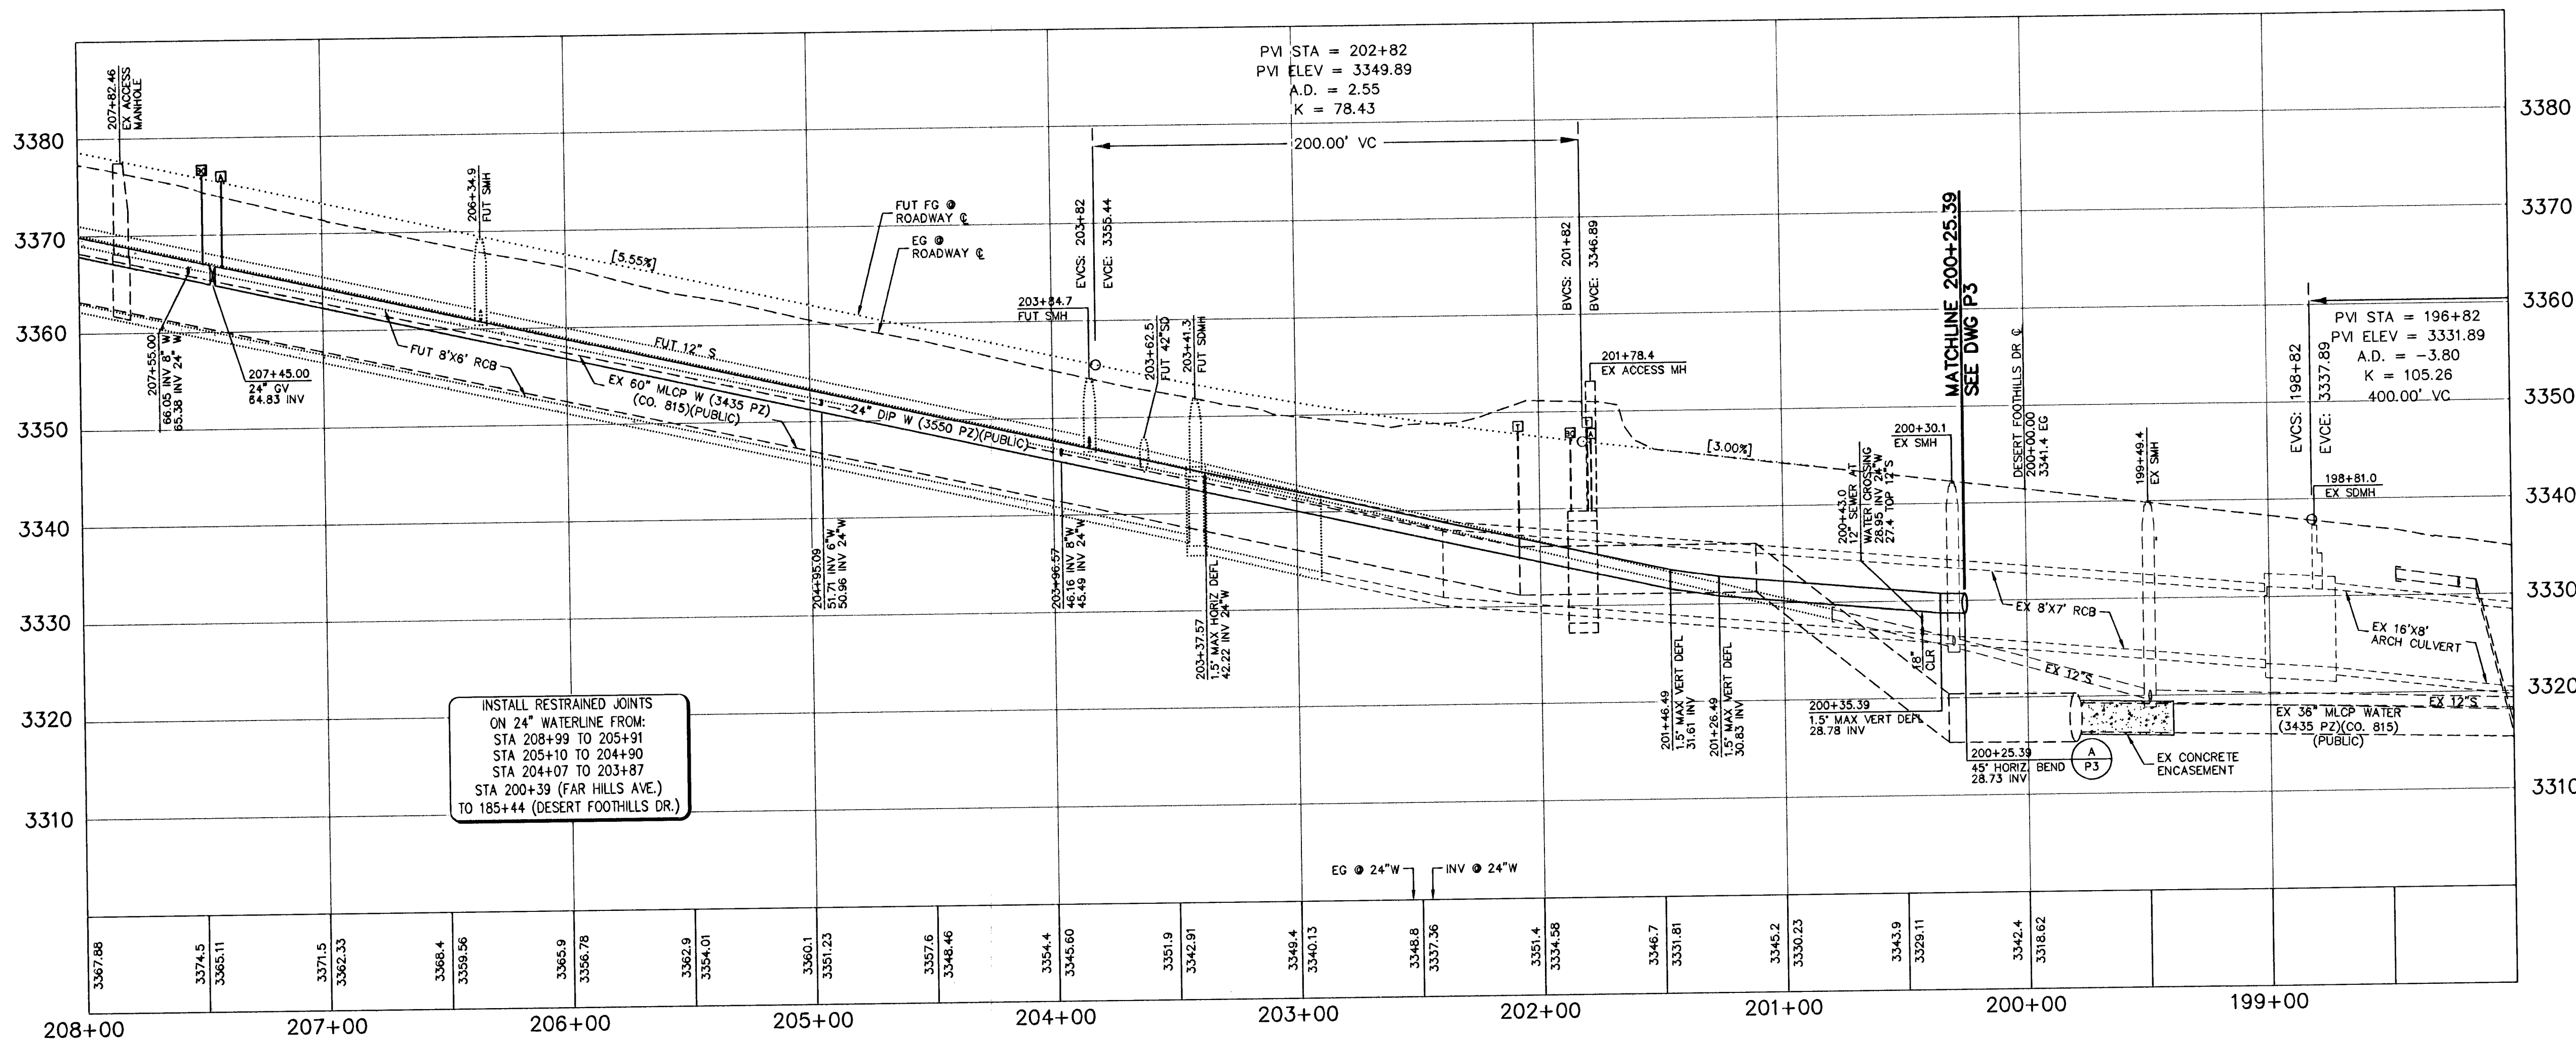

FAR HILLS AVENUE (PUBLIC) (FUTURE)

SCALE: HORIZ. 1" = 40'
VERT. 1" = 10'

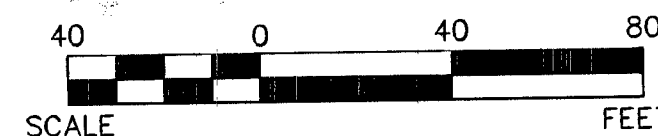

NOTE

THIS SET OF DRAWINGS IS BASED UPON NAVD 88 DATUM. PREVIOUS DRAWINGS MAY BE BASED ON OTHER DATUM. CARE SHOULD BE OBSERVED WHEN UTILIZING THIS SET OF DRAWINGS.

BASIS OF BEARINGS

NORTH 89°45'05" EAST BEING THE SOUTH LINE OF THE SOUTHWEST QUARTER (SW 1/4) OF SECTION 35, TOWNSHIP 20 SOUTH, RANGE 59 EAST, M.D.M., AS SHOWN BY MAP ON FILE IN FILE 91, PAGE 28 OF PARCEL MAPS IN THE CLARK COUNTY RECORDER'S OFFICE, CLARK COUNTY, NEVADA.

BENCHMARK

DESCRIPTION	NAVD 88 DATUM	1016.620 (METERS)
RIVET AND PLATE IN TOP OF CURB @ SOUTHEAST CORNER OF FAR HILLS AVENUE AND DESERT FOOTHILLS DRIVE	3335.36 (FEET)	
CLV BM No. 7LV09 27E4		



APPROVED FOR CONSTRUCTION

R. Miller
CITY OF LAS VEGAS FIRE DEPARTMENT


11/29/14
DATE

APPROVED FOR CONSTRUCTION

A. De Vries
LAS VEGAS VALLEY WATER DISTRICT ENGINEERING SERVICES MANAGER

PROJECT NO. 121623 DATE: 11/29/14

H #48809
CLV DRAWING NO. 565-484

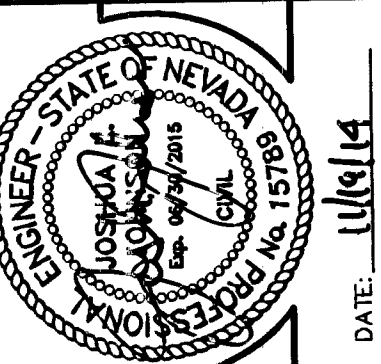

G.C. WALLACE COMPANIES
ENGINEERS | PLANNERS | SURVEYORS
1855 RAINBOW BOULEVARD, LAS VEGAS, NV 89146
T: 702.894.2000 F: 702.894.2299 GCWALLACE.COM

THE HOWARD HUGHES COMPANY, LLC
VILLAGE 23B 24' 3550 ZONE WATERLINE IMPROVEMENTS
FAR HILLS AVENUE PLAN AND PROFILE
FROM STA. 198+00 TO STA. 208+00

DRAWING

P2

7 OF 10 SHTS

JOB NO. 620238-210