


 $1'' = 30'$

2/12/89

OF 37 SHEETS

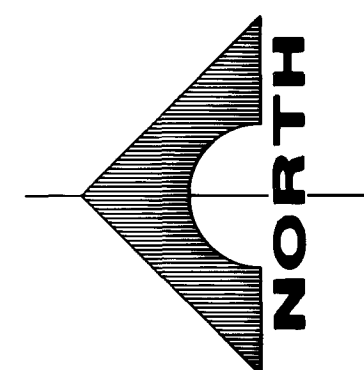

G.C. WALLACE, INC.
Engineering/Architecture

REV	DATE	DESCRIPTION
A	2/2/80	ISSUED FOR BID
A-2	5/11/81	ISSUED FOR CONSTRUCTION
A-4	2/17/90	ISSUED PER GCW LETTER
A	5/19/90	RECORD DRAWINGS

CRAG-A-THOMAS
6638 3/12/82
R.P.E. NO. DATE
BPP 2/13/90

555 SOUTH RAINBOW BLVD / LAS VEGAS, NEVADA 89102

