



RAINBOW VISTA NO. 10

UNDEVELOPED

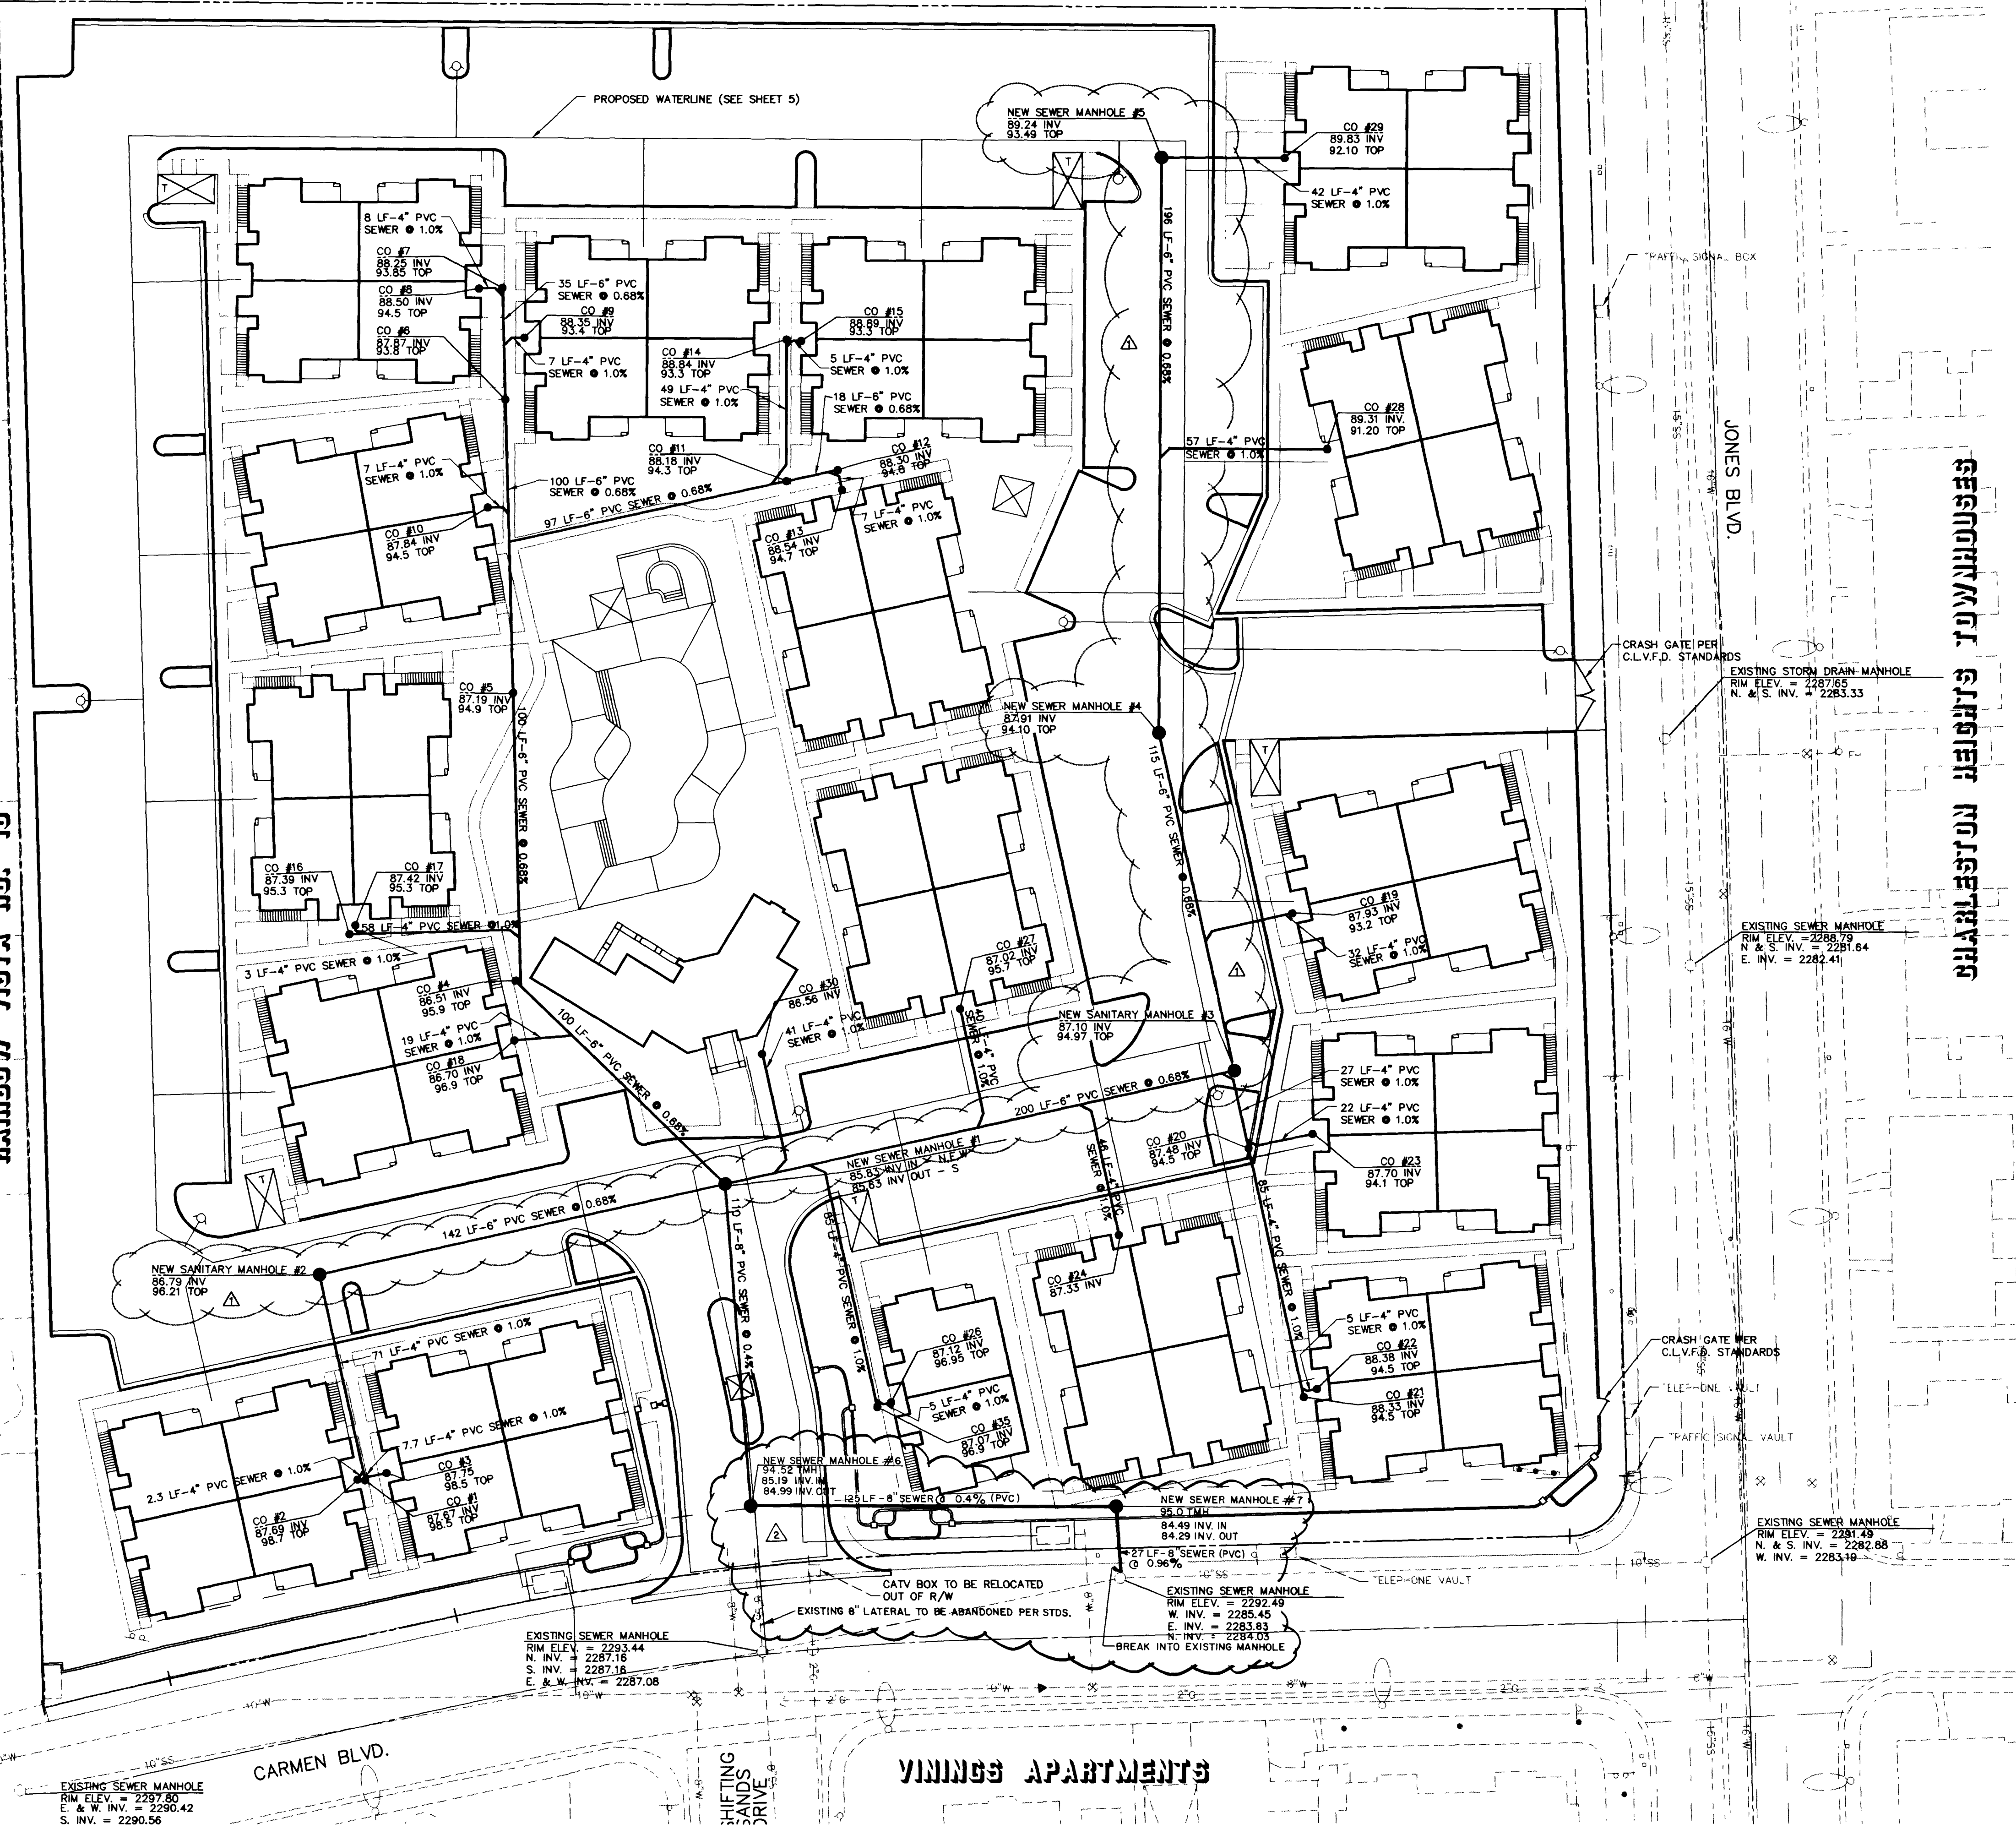

NOTE:
LOCATION OF EXISTING 8\"/>

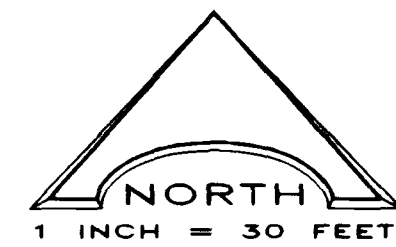

SEWER CONTRIBUTION DATA

132 UNITS x 0.7 = 92.4 ERU
92.4 ERU x 250 = 23,100 GPD = AVERAGE DAILY FLOW
23,100 GPD x 3.45 = 79,695 GPD = PEAK DAILY FLOW

NOTE:
ALL ON-SITE SEWERS ARE PRIVATELY OWNED AND MAINTAINED.

C.L.V. SEWER NOTES

- ALL CONSTRUCTION AND MATERIALS SHALL BE IN ACCORDANCE WITH THE LATEST EDITION OF THE DESIGN & CONSTRUCTION STANDARDS FOR WASTEWATER COLLECTION SYSTEMS AND THE UNIFORM STANDARD SPECIFICATIONS FOR PUBLIC WORKS CONSTRUCTION OFF-SITE IMPROVEMENTS, CLARK COUNTY AREA, NEVADA, AS AMENDED. IN ALL CASES, THESE STANDARDS SHALL SUPERSEDE THE UNIFORM STANDARD SPECIFICATIONS. IT WILL BE THE RESPONSIBILITY OF THE CONTRACTOR TO BE AWARE OF THE CONTENTS OF THE ABOVE SPECIFICATION BOOKS.
- IT SHALL BE THE CONTRACTOR'S RESPONSIBILITY TO PERFORM CONSTRUCTION AS PER PLANS. ANY ADDITIONS, DELETIONS, OR CHANGES SHALL FIRST MEET WITH THE APPROVAL OF THE CONTROLLING AGENCY.
- CHISEL "S" OR "G" IN CURBS WHERE SEWER OR GAS LATERALS PASS UNDER THE CURB.
- POLYVINYL CHLORIDE (PVC) SEWER PIPES SHALL MEET ASTM D-3034 SDR 35 SPECIFICATIONS, AND INSTALLED WITH SAND BEDDING AND BACKFILL OF TYPE II GRAVEL.
- ALL MANHOLES IN PAVED STREETS 80' R/W AND LARGER, SHALL HAVE CONCRETE COLLARS.
- TEE SADDLES SHALL BE USED TO CONNECT SEWER LATERALS TO EXISTING MAIN LINES UP TO 12\"/>

BENCHMARK

11000-2500WMB
RIVET AND PLATE IN TOP OF CURB, SE RETURN JONES BOULEVARD
AND BROMLEY AVENUE.
ELEVATION = 2289.269

ESTIMATE OF QUANTITIES SEWER (ON-SITE)

NOTE TO CONTRACTOR: CONTRACTOR TO VERIFY QUANTITIES FOR BIDDING PURPOSES.

STD. 4\"/>

APPROVALS

Robert V. Jones 1-24-94
NEVADA POWER COMPANY
THIS APPROVAL IS ONLY FOR STREETLIGHT PLACEMENT AND
CLEARANCE AND SIGNAL LIGHT INSTALLATION.

UTILITY NOTE

UTILITY LOCATIONS SHOWN HEREON ARE APPROXIMATE ONLY. IT SHALL BE THE CONTRACTOR'S RESPONSIBILITY TO DETERMINE THE EXACT HORIZONTAL AND VERTICAL LOCATION OF ALL EXISTING UNDERGROUND UTILITIES PRIOR TO COMMENCING CONSTRUCTION. NO REPRESENTATION IS MADE THAT ALL EXISTING UTILITIES ARE SHOWN HEREON.

Avoid cutting underground utility lines. If's costly.
before Call you Dig
1-800-227-2600
UNDERGROUND SERVICES (USA)




DESIGNED BY:	PK	DRAWN BY:	RD	CHECK BY:	
JOB NUMBER:	218-036-932	DATE:	11-2-93	DATE:	11-2-93
NO.	REVISION				
1	DELETED CLEANOUTS IN PAVED AREAS AND ADDED				
2	REPAVED SEWER LINE AT CARMEN ENTRANCE AND ADD 2 MANHOLES AND INZ-FIT 4' PVC SEWER LINE				

L. R. NELSON CONSULTING ENGINEERS, INC.
3035 East Patrick Lane
Las Vegas, Nevada 89120
(702) 798-7978
(702) 451-2296 FAX

SEWER PLAN
VININGS II
ROBERT V. JONES CORPORATION
CITY OF LAS VEGAS, NEVADA

SHEET NUMBER
4
OF 6 SHEETS

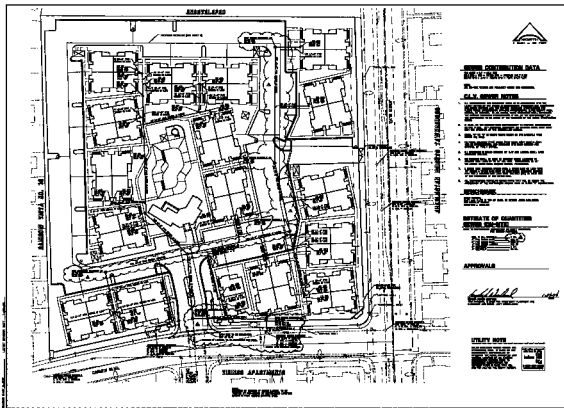
















