
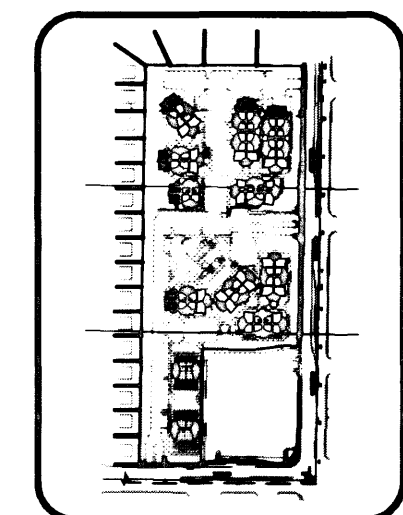
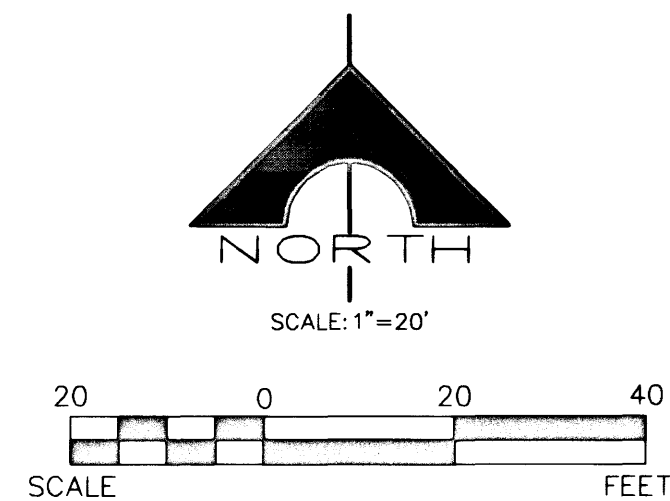


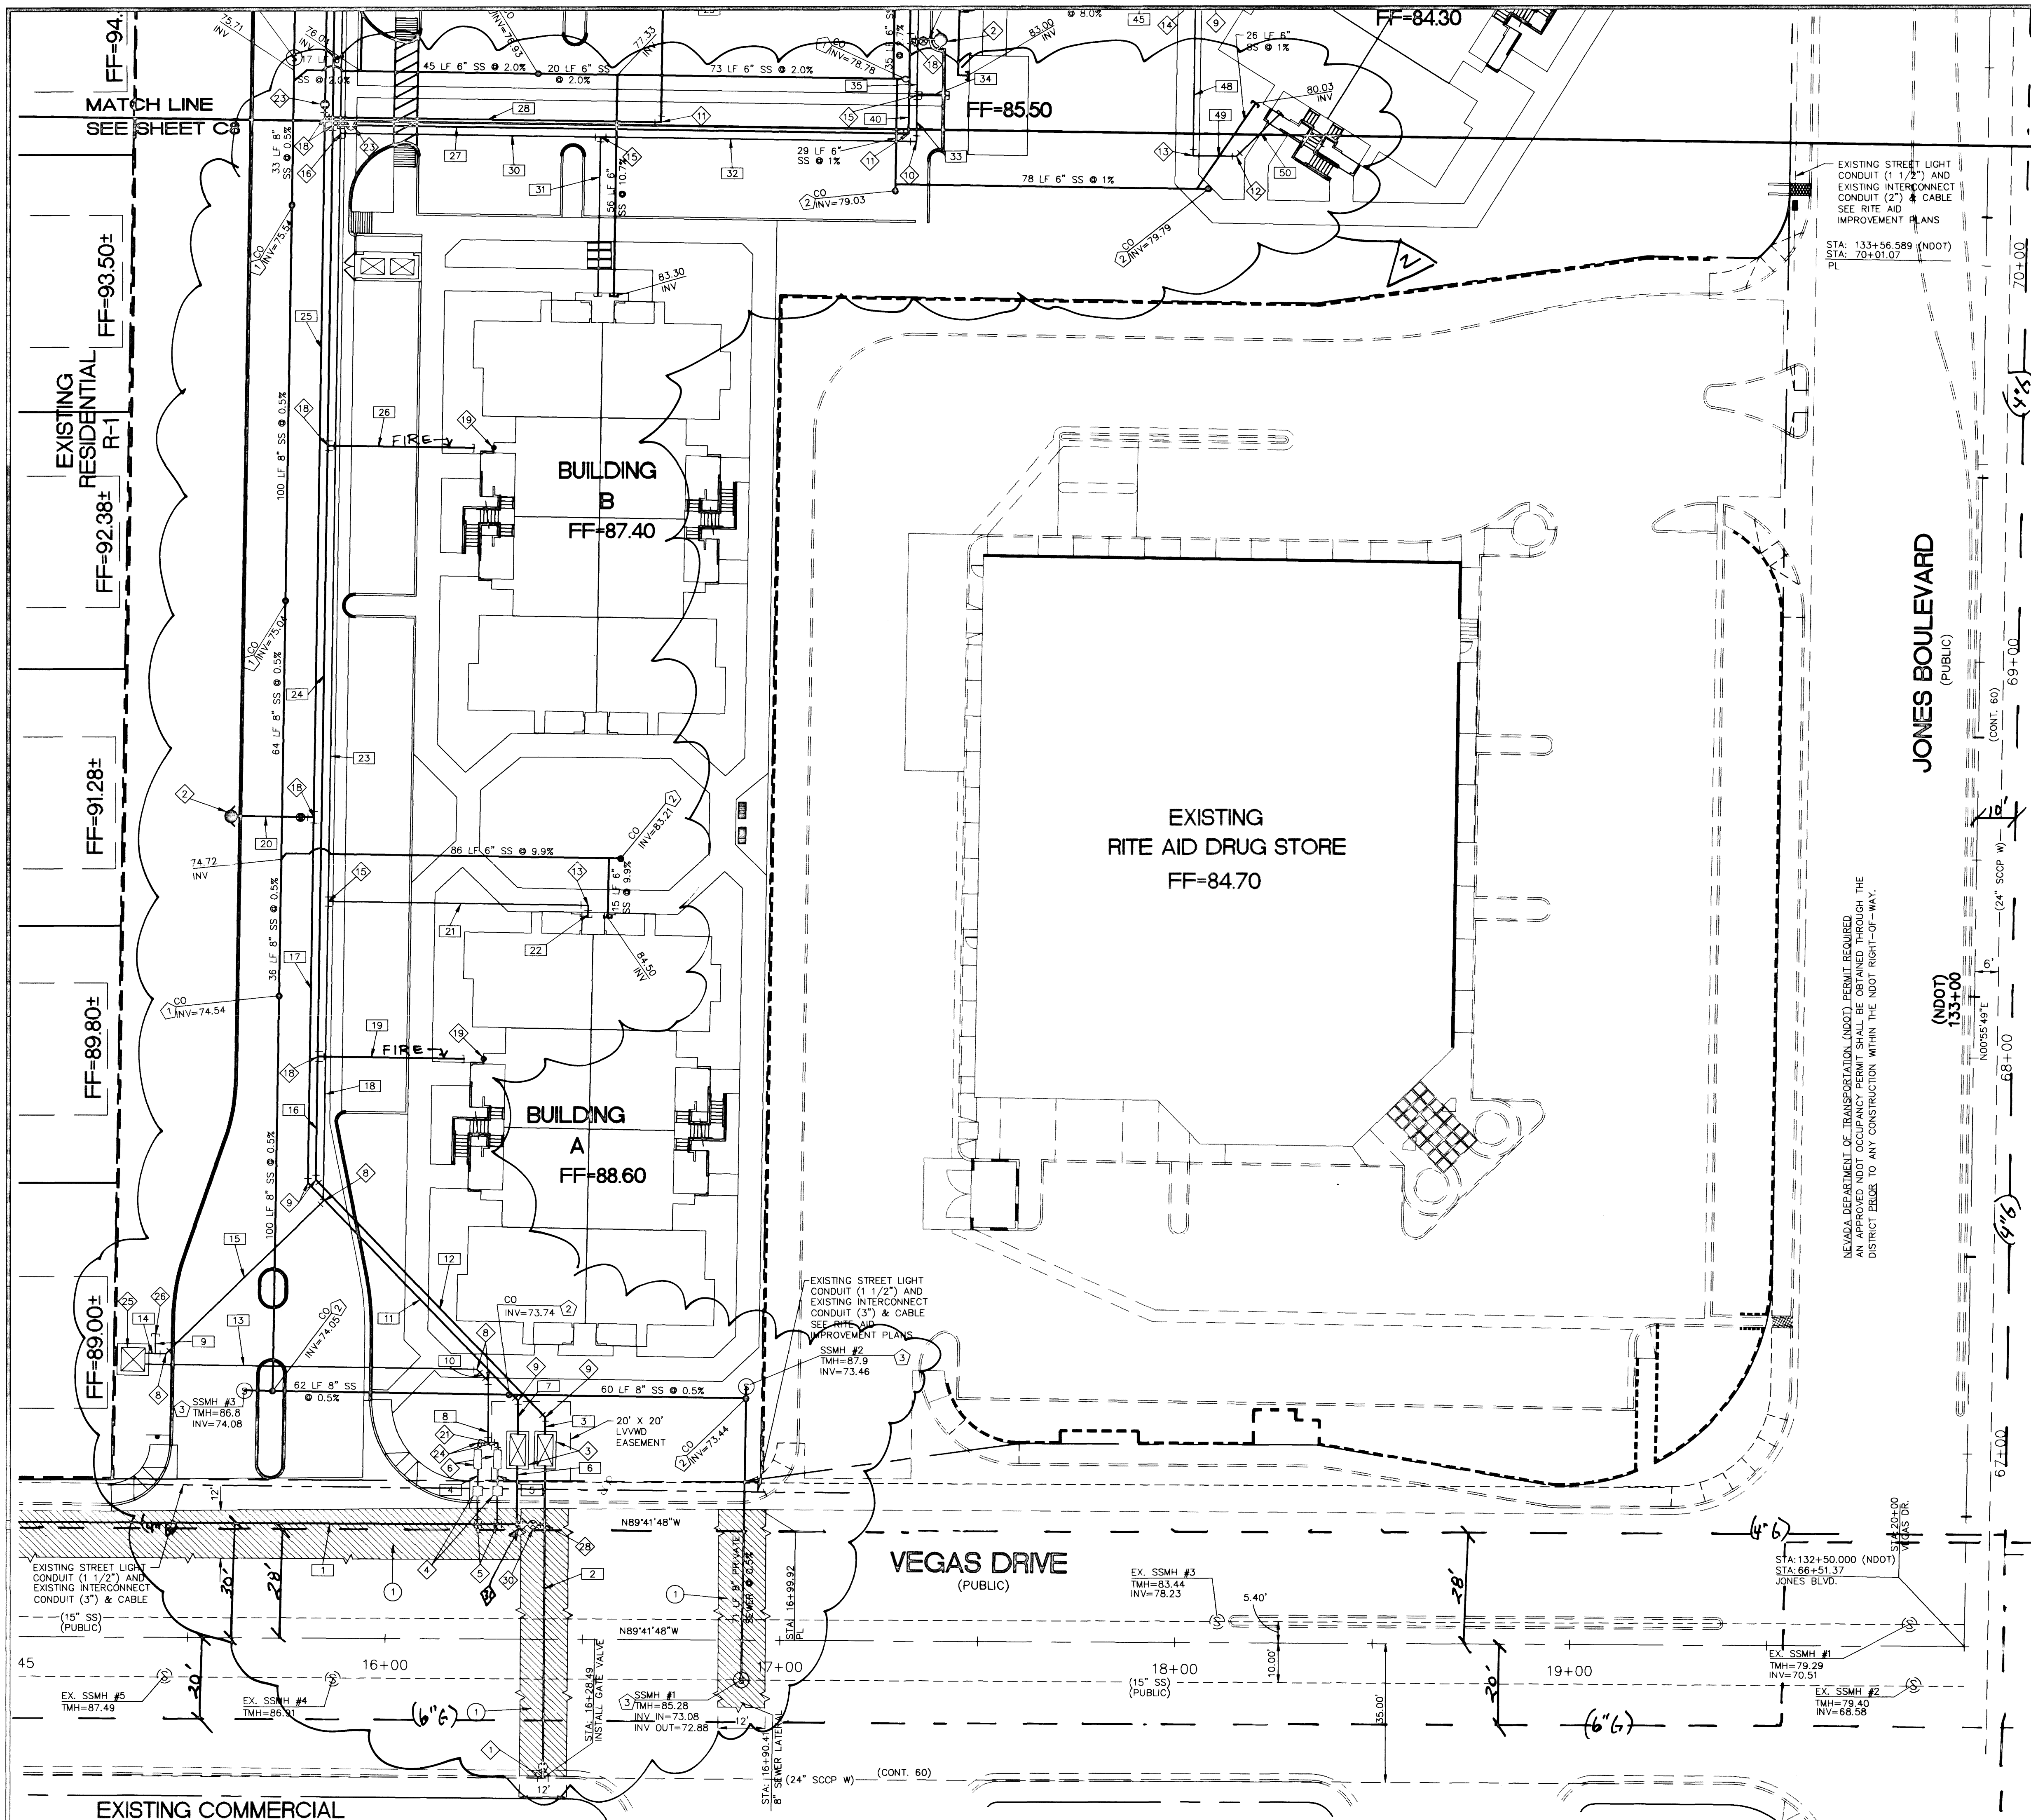


LEGEND

FIRE LANE
PAINT FIRE LANE RED WITH STENCIL

24" SSCP MAIN

STEEL CYL. 0.10462 GA
3/4" COATING
3/4" LINING
ROD REINFORCING SPIRAL WRAP
ON 1-1/2" CENTERS

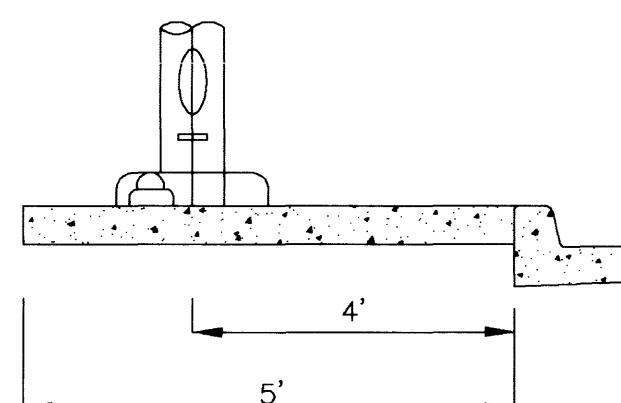

STREET LIGHT NOTE:
ALL HAND HOLE COVERS MUST BE INSTALLED. POLE
CAPS POURED, & PULL BOX LIDS BOLTED DOWN
PRIOR TO ENERGIZING CIRCUIT. ALL WIRE MUST
HAVE THW INSULATION.

STREET LIGHT LOCATION

LVWD 5/18/00
DATE
5/18/00

NOTE: FOR ALL WATER & SEWER CONSTRUCTION
NOTES & APPROVALS SEE SHEET C10

Call before you Dig.
1-800-227-2600
UNDERGROUND SERVICE (USA)

CALL BEFORE YOU DO OVERHEAD
1-702-593-6111

VINTAGE DESERT ROSE SENIORS APARTMENTS, LP 2440 PROFESSIONAL DRIVE, SUITE 100 ROSEVILLE, CA 95661 PHONE: (916) 773-6060 FAX: (916) 773-5866		VINTAGE DESERT ROSE SENIORS APARTMENTS, LP 2440 PROFESSIONAL DRIVE, SUITE 100 ROSEVILLE, CA 95661 PHONE: (916) 773-6060 FAX: (916) 773-5866	
SCALE: 1"=20'	DRAWN BY: THC	DESIGNED BY: WLW	CHECKED BY: WLW

22600