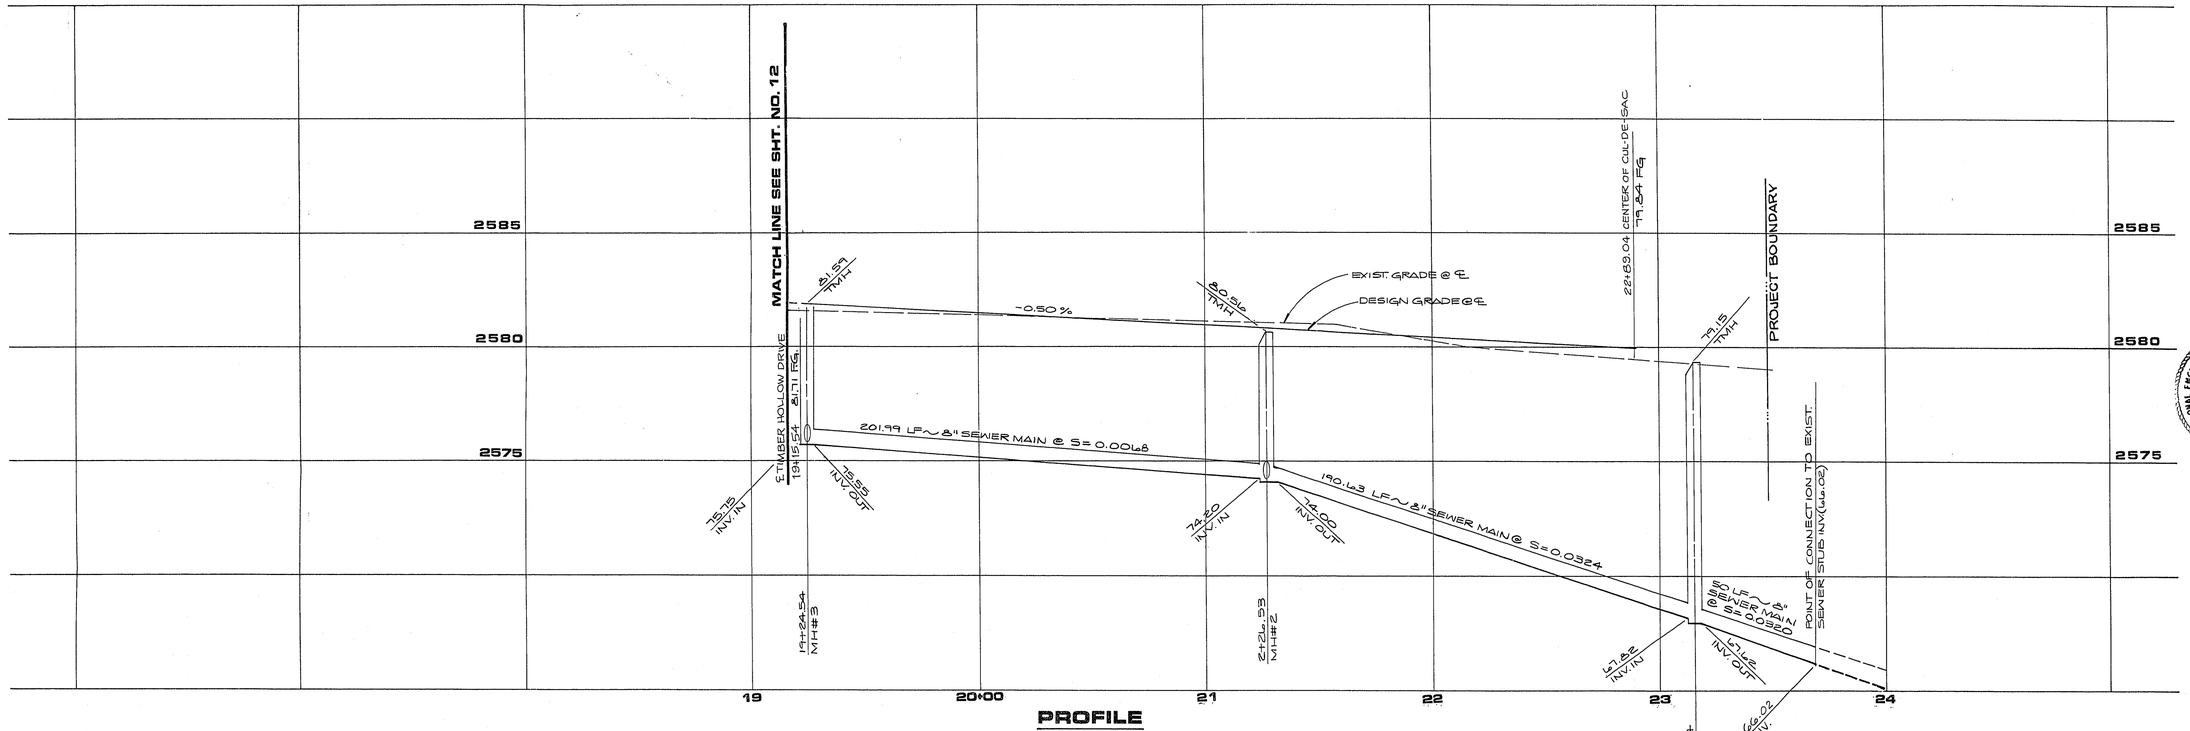

PROFILE

SCALE: HORIZ. 1" : 30'
VERT. 1" : 3'

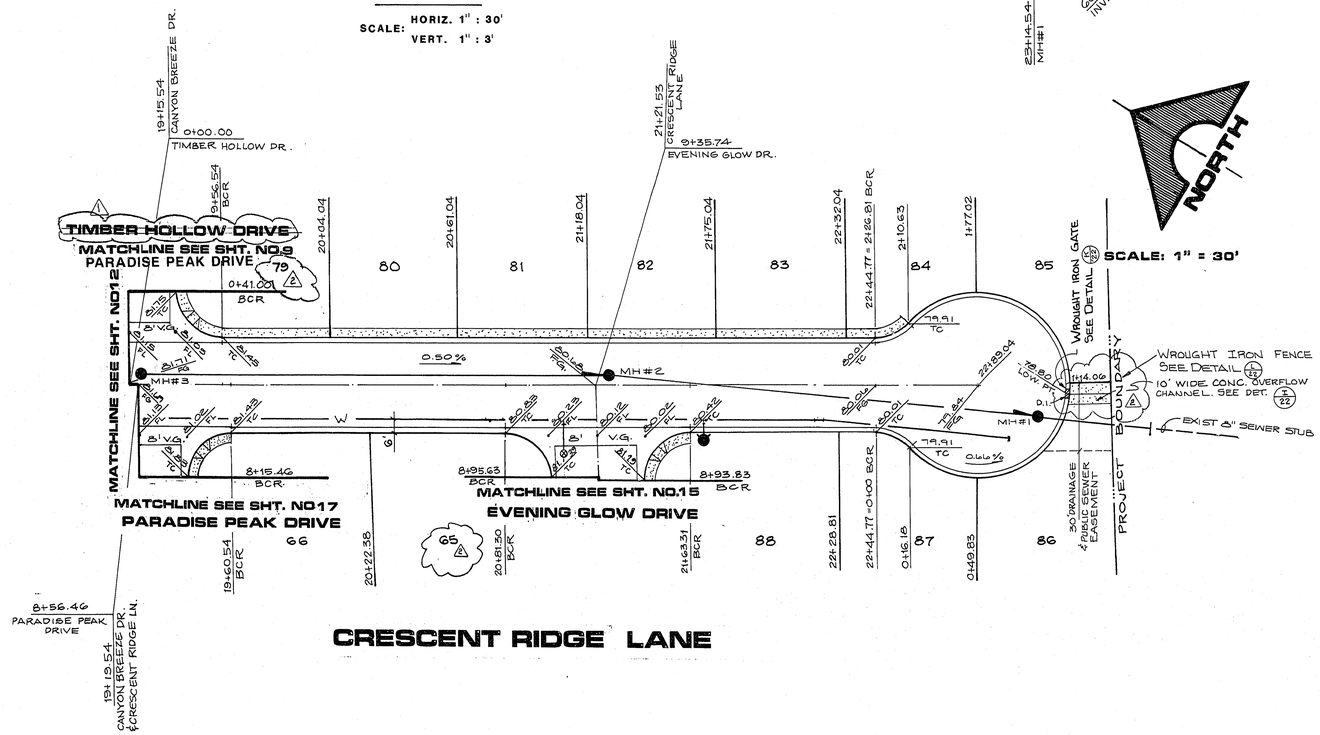

CRESCENT RIDGE LANE

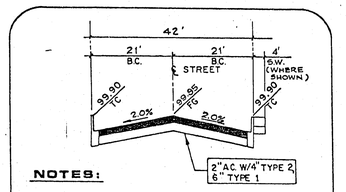

NOTES:

1. STRUCTURAL SECTION OF STREET TO CONFORM TO C.L.V. STANDARD DRAWINGS.
2. NATIVE MATERIAL MAY BE USED IN LIEU OF TYPE 1 WHEN PROCESSED FOR APPROVAL IN ACCORDANCE WITH CITY OF LAS VEGAS STATEMENT OF POLICY DATED 07/25/84.

STREET SECTION

SUMMERLIN STANDARD DWG. NO. S-8

JOB NO. 729.010

8/84 DIETERICH POST 65328

REV	DATE	DESCRIPTION	C.L.V. APP'D.	DATE
1	11-16-90	REVISED STREET NAME	KJ	11-14-90
2	12-3-90	REVISED P. PEAK DR. TO EVENING GLOW DR. & CRESCENT RIDGE LN.	KJ	12-4-90
3		REVISED STREET NUMBERS	KJ	12-10-90

RECOMMENDED FOR APPROVAL: CHIEF, DEVELOPMENT ENGINEERING DATE

5256 R.E. NO. 10-16-90 DATE

REGISTERED PROFESSIONAL ENGINEER NO. 5256 STATE OF NEVADA

G.C. WALLACE, INC.
Engineering/Architecture
1555 SOUTH RAINBOW BLVD. / LAS VEGAS, NEVADA 89102

WATT NEVADA INC.
VISIONS
CRESCENT RIDGE LANE

SHEET 13 OF 22 SHEETS

10-13-88 1097-4145