



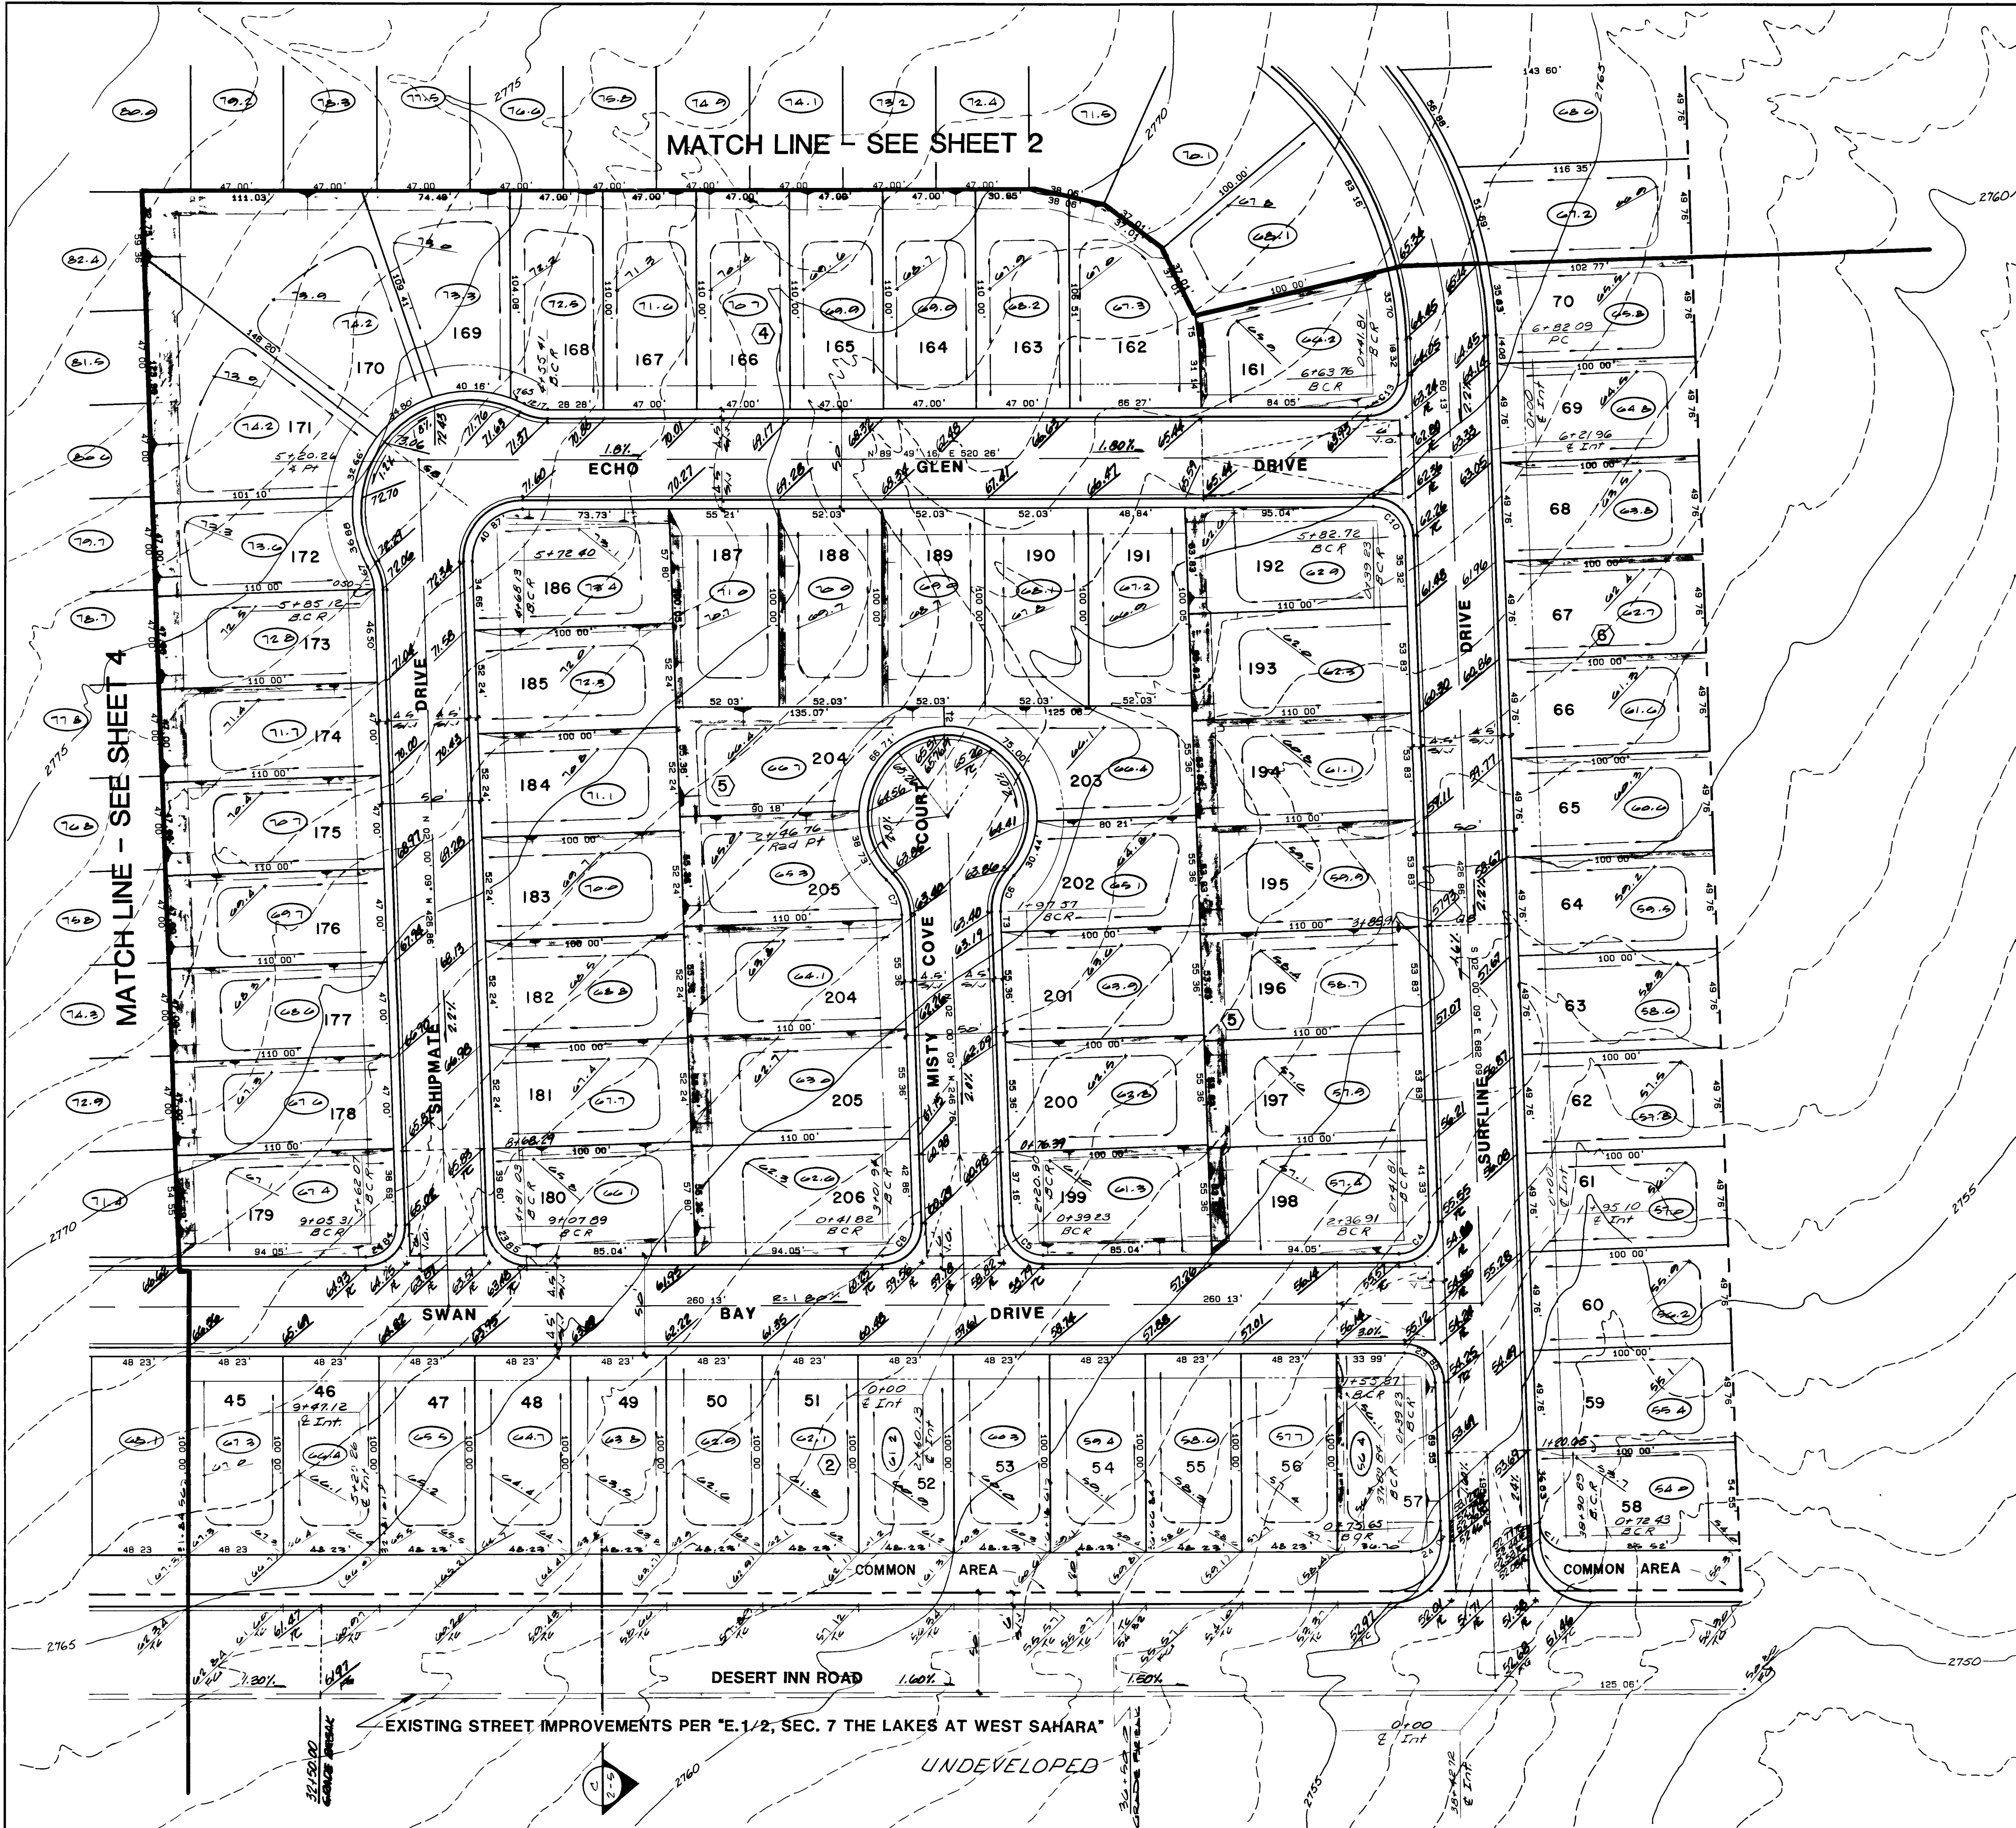


PROPOSED "MISSION MONTEREY"

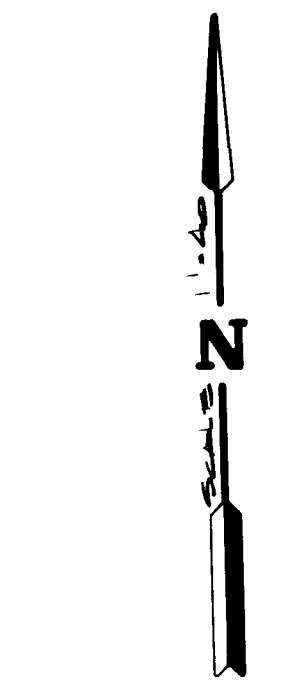

CLV CHIEF LAND DEVELOPMENT DATE

TITLE		ROUGH GRADING PLAN		PROJECT	
VISTA DEL LAGO					
WONO 5025		BY PV & JO		DATE 4-87	
SCALE 1" = 40'		SHEET 15		OF 15 SHEETS	
REVISION		BY		DATE	
1		PJS		7-15-87	
2		PJS		7-16-87	
3		BN		4-26-88	
4		BN		4-26-88	
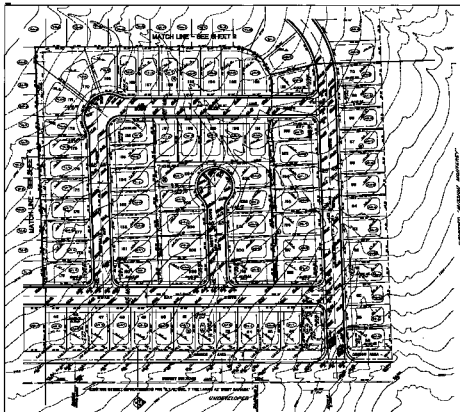

NOT TO SCALE

14

1-4-54

15	
1-4-54	

ROUGH BUILDING PLAN

VISTA DEL LAGO