


Call before
you Dig
1-800-227-2600

Avoid cutting underground
utility lines. It's costly.

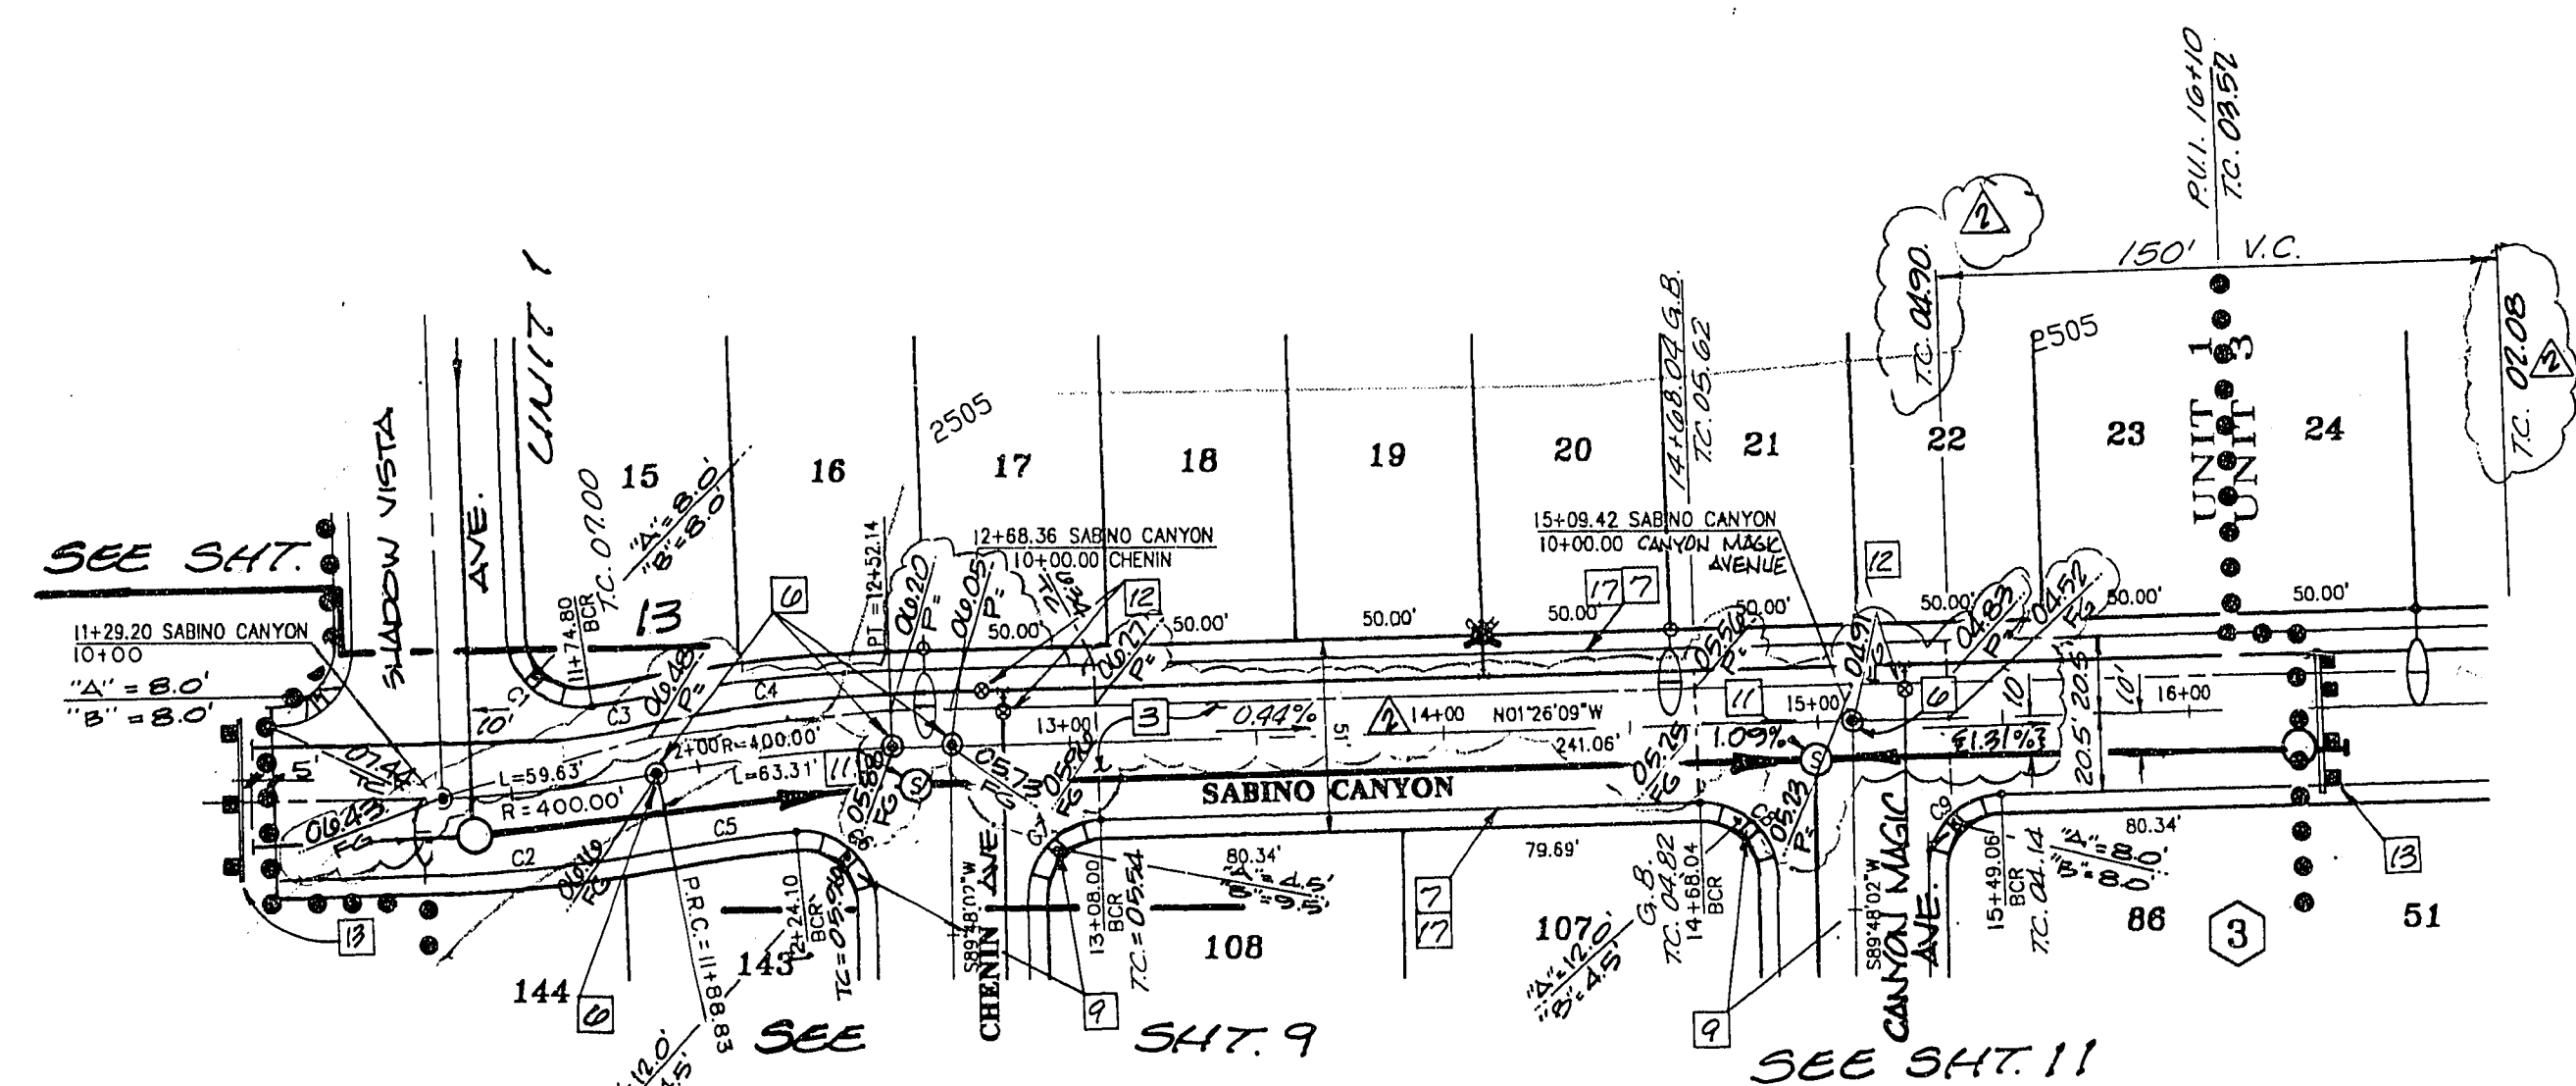

PLAN AND PROFILE

Horiz: 1"=50'
Vert: 1"=5'

CONSTRUCTION NOTES


1. CONSTRUCT ROAD SECTION (ARTERIAL) PER CLARK CO. AREA STD. DWG. NO. 203
2. CONSTRUCT ROAD SECTION (COLLECTOR) PER CLARK CO. AREA STD. DWG. NO. 205
3. SEE PLAN FOR R/W WIDTH.
4. CONSTRUCT ROAD SECTION (LOCAL RESIDENTIAL) CLARK CO. AREA STD. DWG. NO. 207
5. CONSTRUCT SURVEY MONUMENT (TYPE I) PER CLARK CO. AREA STD. DWG. NO. 239
6. CONSTRUCT SURVEY MONUMENT (TYPE II) PER CLARK CO. AREA STD. DWG. NO. 240
7. CONSTRUCT SURVEY MONUMENT (TYPE III) PER CLARK CO. AREA STD. DWG. NO. 241
8. CONSTRUCT "L" TYPE CURB AND GUTTER PER CLARK CO. AREA STD. DWG. NO. 216
9. CONSTRUCT "A" TYPE ISLAND CURB PER CLARK COUNTY AREA STD. DWG. NO. 219
10. CONSTRUCT SIDEWALK RAMP WITHIN CURB RETURN PER CLARK CO. STD. DWG. NO. 235, CASE 1
11. CONSTRUCT 8" WIDE CONC. VALLEY GUTTER PER CLARK CO. AREA STD. DWG. NO. 228
12. ADJUST MANHOLE TO GRADE
13. ADJUST WATER VALVE TO GRADE
14. CONSTRUCT BARRICADE, TYPE III
15. SAWCUT & REMOVE EXISTING ASPHALT PAVEMENT.
16. CONSTRUCT 20 LF. 8" P.V.C. AND PLUG.
17. CONSTRUCT SIDEWALK PER CLARK COUNTY AND STD. DWG. NO. 234.
18. INSTALL L FIRE HYDRANT PER CLARK CO. AREA STD. DWG. NO. 516

CURVE TABLE BACK OF CURB


CURVE	RADIUS	LENGTH	TANGENT	DELTA
C1	20.00'	33.88'	22.63'	97°03'32"
C2	420.50'	49.81'	24.93'	06°47'13"
C3	379.50'	13.31'	6.66'	02°00'35"
C4	420.50'	66.56'	33.35'	09°04'07"
C5	379.50'	33.46'	16.74'	05°03'07"
C6	20.00'	33.25'	21.92'	95°57'11"
C7	20.00'	30.98'	19.57'	88°45'49"
C8	20.00'	31.85'	20.44'	91°44'11"
C9	20.00'	30.98'	19.57'	88°45'49"

BENCHMARK Elevation = 2517.403

CLARK COUNTY B.M. No. 1000 17NNW6
SET DRIVE RIVET IN A 2" x 2" ALUMINUM PLATE,
IN A DRILLED HOLE WITH EPOXY GLUE, IN THE TOP OF CURB,
ON THE SOUTH SIDE OF CHEYENNE AVENUE AND THE EXTENDED
ALIGNMENT CAMPBELL ROAD.

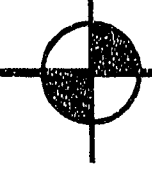

SCOPE OF WORK: CONSTRUCT ALL IMPROVEMENTS
THIS SHEET.

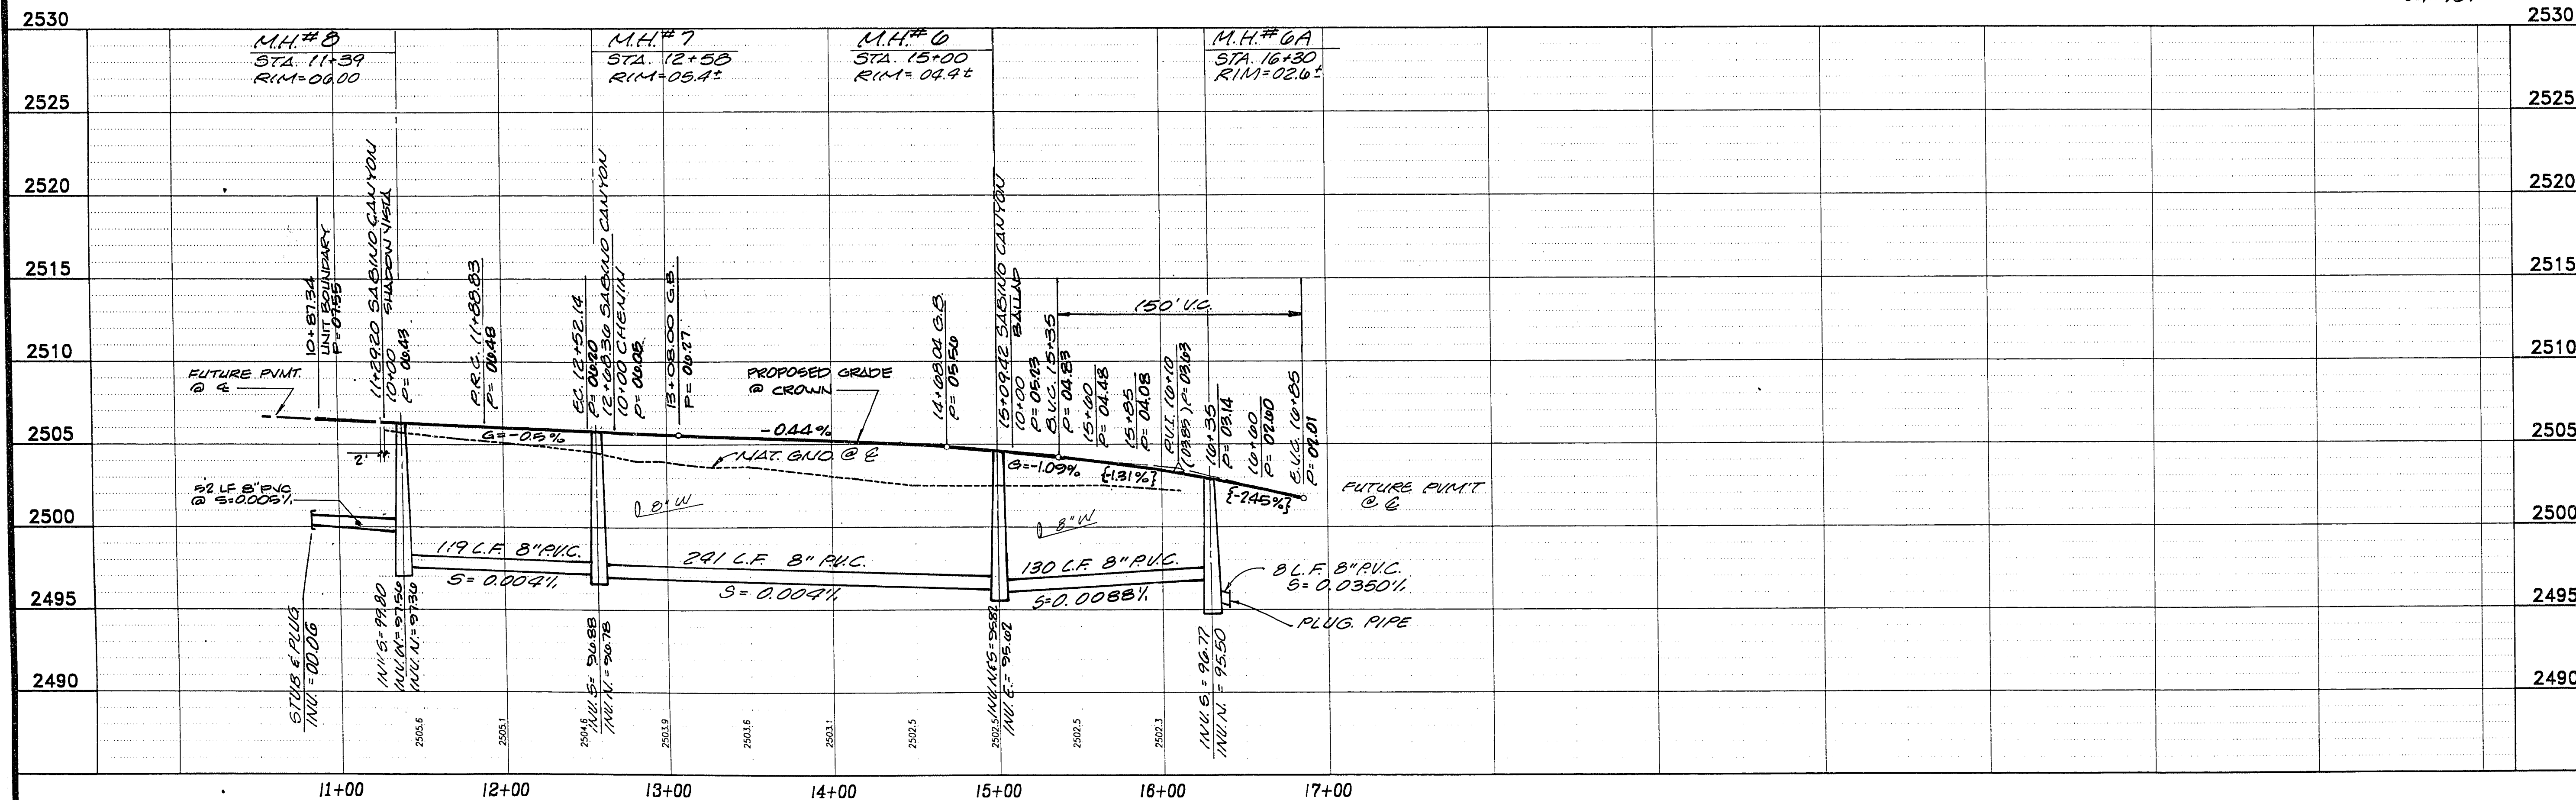

UNIT ONE
PLAN AND PROFILE
SABINO CANYON ST.

Vista ~ Pageantry

6655 West Solano Avenue
Suite 4-200
Las Vegas, NV 89103
Tel: (702) 366-3008
Fax: (702) 366-0047

CONSULTANTS, INC.
ENGINEERING - PLANNING - LAND SURVEYING

SHEET
14 OF 18