

Call before
you Dig
1-800-227-2600

CURVE TABLE BACK OF CURB


CURVE	RADIUS	LENGTH	TANGENT	DELTA
C1	20.00'	31.42'	20.00'	90°00'00"
C2	20.00'	32.77'	21.40'	93°53'05"
C3	400.00'	63.31'	31.72'	09°04'07"

CURVE TABLE BACK OF CURB

CURVE	RADIUS	LENGTH	TANGENT	DELTA
C1	20.00'	31.42'	20.00'	90°00'00"
C2	20.00'	32.77'	21.40'	93°53'05"
C3	400.00'	63.31'	31.72'	09°04'07"

BENCHMARK Elevation = 2517.483

CLARK COUNTY B.M. No. 1000 1779998
SET DRIVE PIVOT IN A 2" x 2" ALUMINUM PLATE,
IN A DRILLED HOLE WITH EPOXY GROUT, IN THE TOP OF CURB,
ON THE SOUTH SIDE OF CHEYENNE AVENUE AND THE EXTENDED
ALIGNMENT CAMPBELL ROAD.

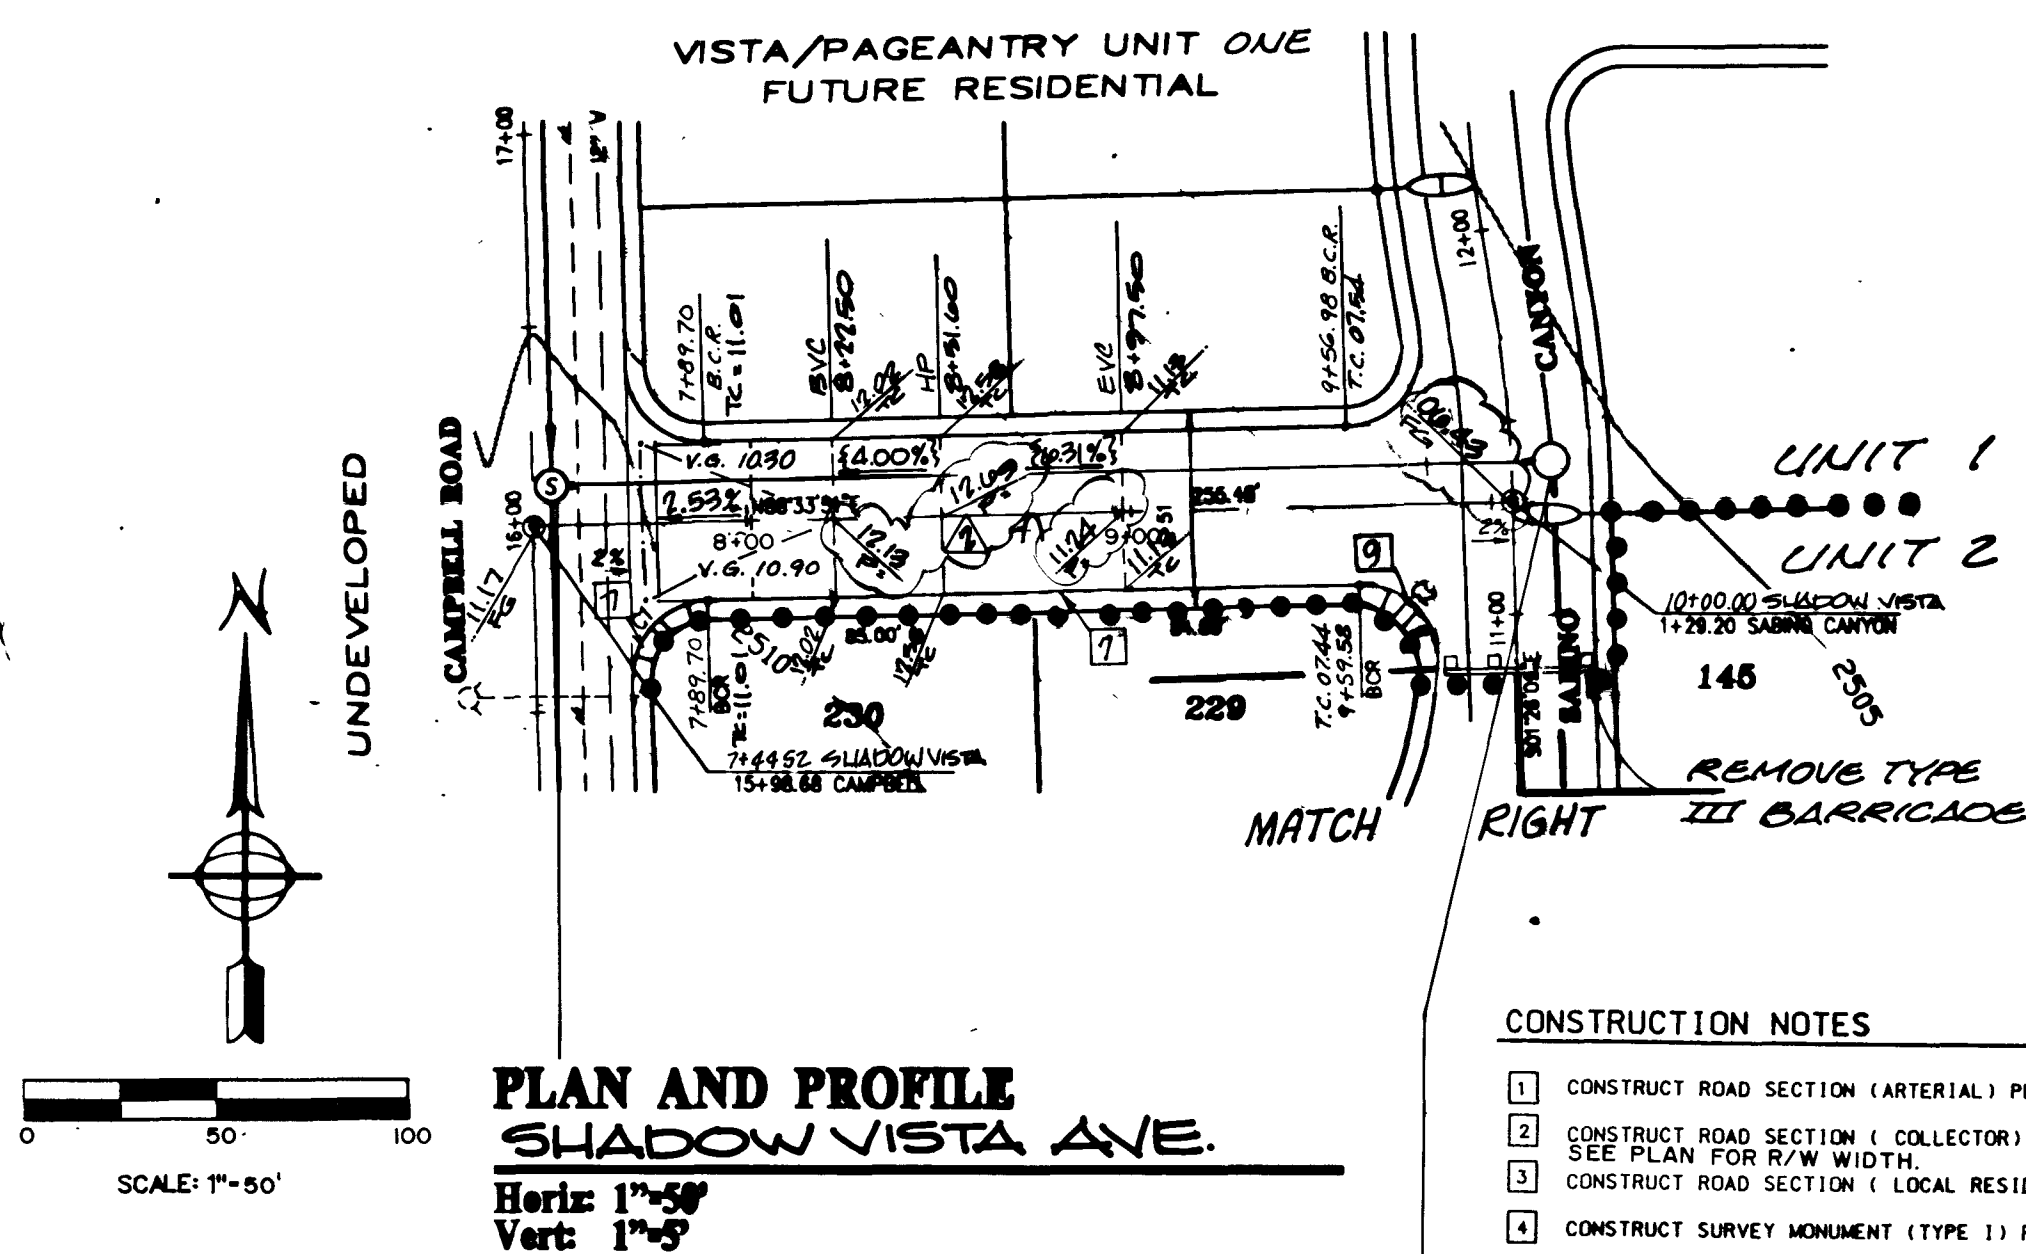


CONSTRUCTION NOTES

1. CONSTRUCT ROAD SECTION (ARTERIAL) PER CLARK CO. AREA STD. DWG. NO. 203
2. CONSTRUCT ROAD SECTION (COLLECTOR) PER CLARK CO. AREA STD. DWG. NO. 205
3. SEE PLAN FOR R/W WIDTH.
4. CONSTRUCT ROAD SECTION (LOCAL RESIDENTIAL) CLARK CO. AREA STD. DWG. NO. 207
5. CONSTRUCT SURVEY MONUMENT (TYPE 1) PER CLARK CO. AREA STD. DWG. NO. 239
6. CONSTRUCT SURVEY MONUMENT (TYPE 11) PER CLARK CO. AREA STD. DWG. NO. 240
7. CONSTRUCT SURVEY MONUMENT (TYPE 111) PER CLARK CO. AREA STD. DWG. NO. 241
8. CONSTRUCT "L" TYPE CURB AND GUTTER PER CLARK CO. AREA STD. DWG. NO. 216
9. CONSTRUCT "A" TYPE ISLAND CURB PER CLARK COUNTY AREA STD. DWG. NO. 219
10. CONSTRUCT SIDEWALK RAMP WITHIN CURB RETURN PER CLARK CO. STD. DWG. NO. 235, CASE I
11. CONSTRUCT 8" WIDE CONC. VALLEY GUTTER PER CLARK CO. AREA STD. DWG. NO. 228
12. ADJUST MANHOLE TO GRADE
13. ADJUST WATER VALVE TO GRADE
14. CONSTRUCT BARRICADE, TYPE III
15. SAWCUT & REMOVE EXISTING ASPHALT PAVEMENT. SAWCUT TO BE DONE ON CENTER LINE AND ASPHALT REMOVED NORTH OF CUT LINE.
16. CONSTRUCT REMAINING PORTION OF MEDIAN TO BE IN CONFORMANCE WITH CLARK CO. DWG. NO. 218
17. CONSTRUCT 20' L.F. 8" P.V.C. AND PLUG.
18. CONSTRUCT SIDEWALK PER CLARK COUNTY AND STD. DWG. NO. 234.
19. INSTALL FIRE HYDRANT PER CLARK CO. AREA STD. DWG. NO. 516

PLAN AND PROFILE SABINO CANYON ST.

Horiz: 1"=50'
Vert: 1"=5'

NOTE:
SCOPE OF WORK THIS SHEET
TO INCLUDE FULL IMPROVEMENTS
SOUTH OF SHADOW VISTA CENTER LINE.

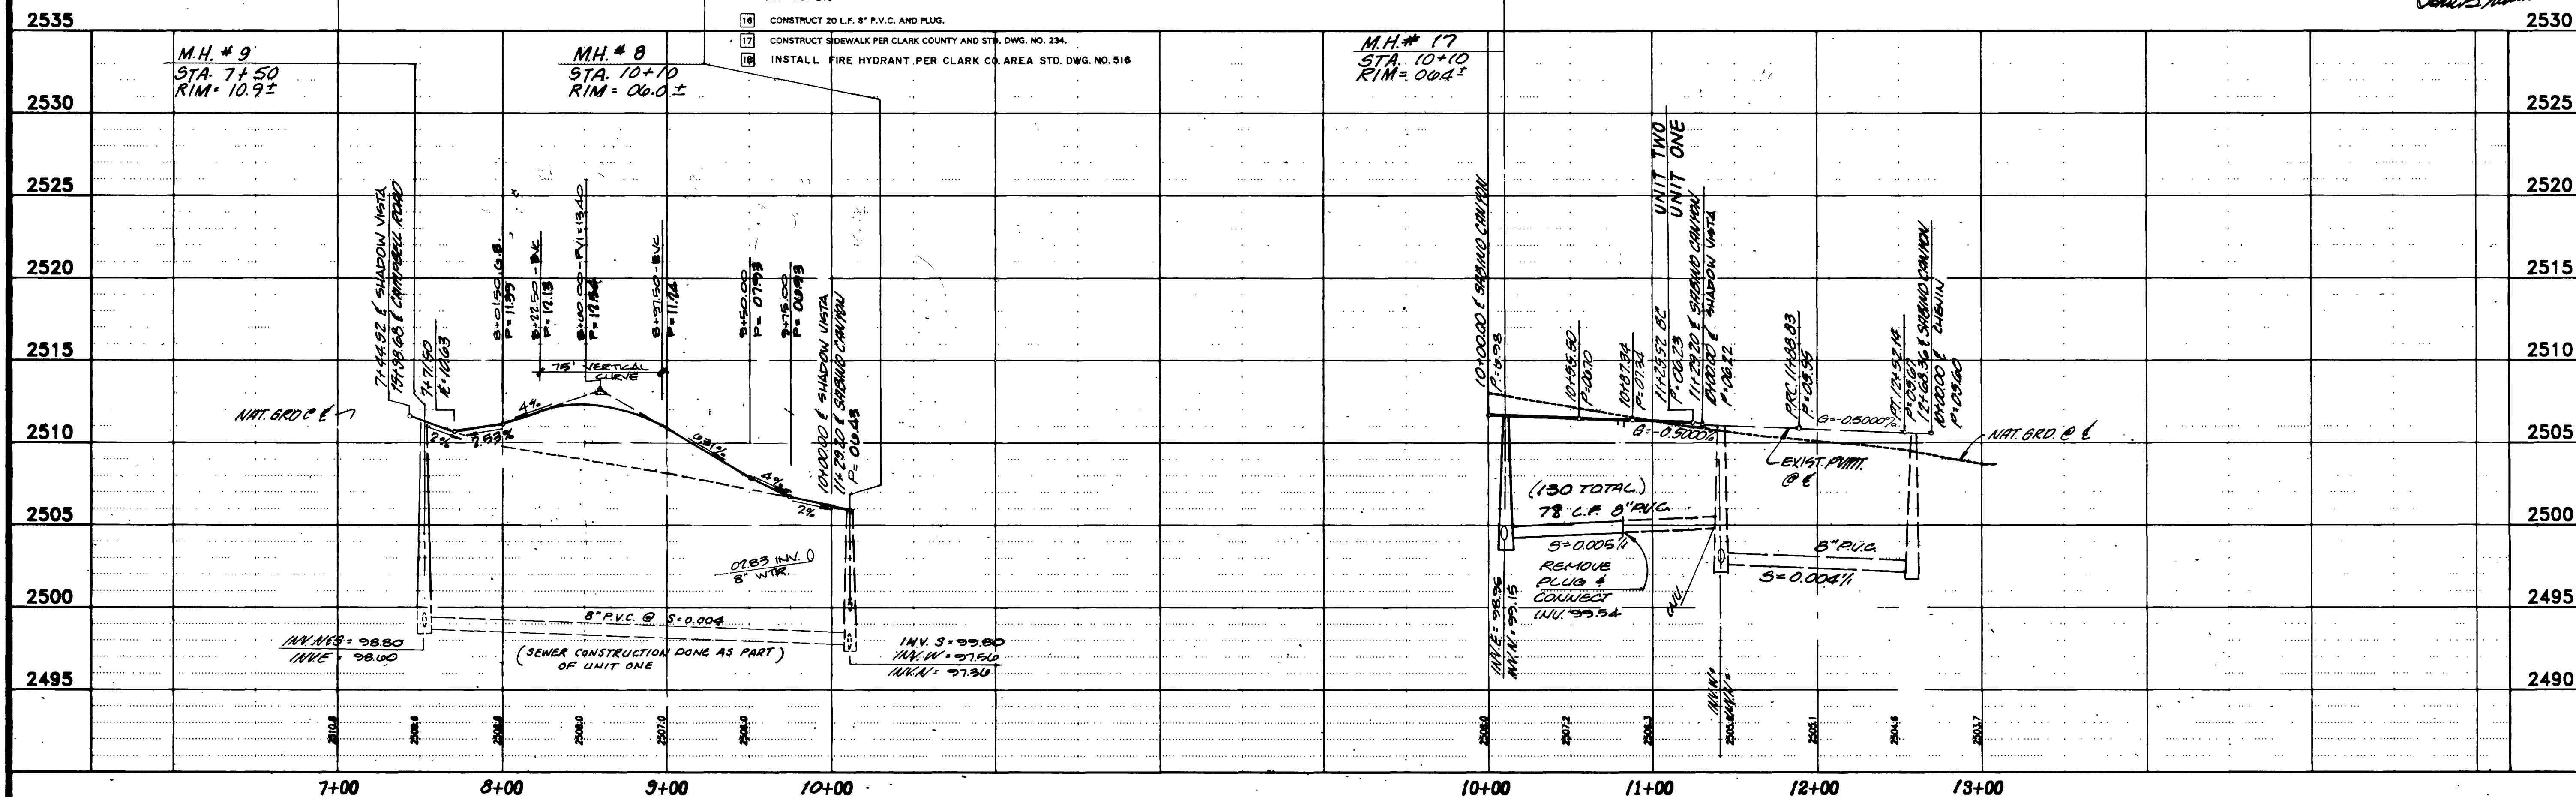




UNIT TWO
PLANS AND PROFILES
SHADOW VISTA AVE.
SABINO CANYON ST.

Vista ~ Pageantry

CONSULTANTS, INC.
SUCCESSION, PLANNING, LAND SURVEYING

SHEET
13 OF 17

**Call before
you Dig**
1-800-487-4874

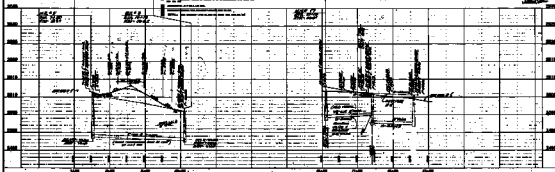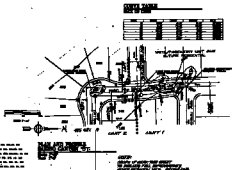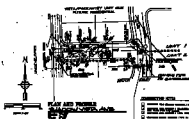

1997