



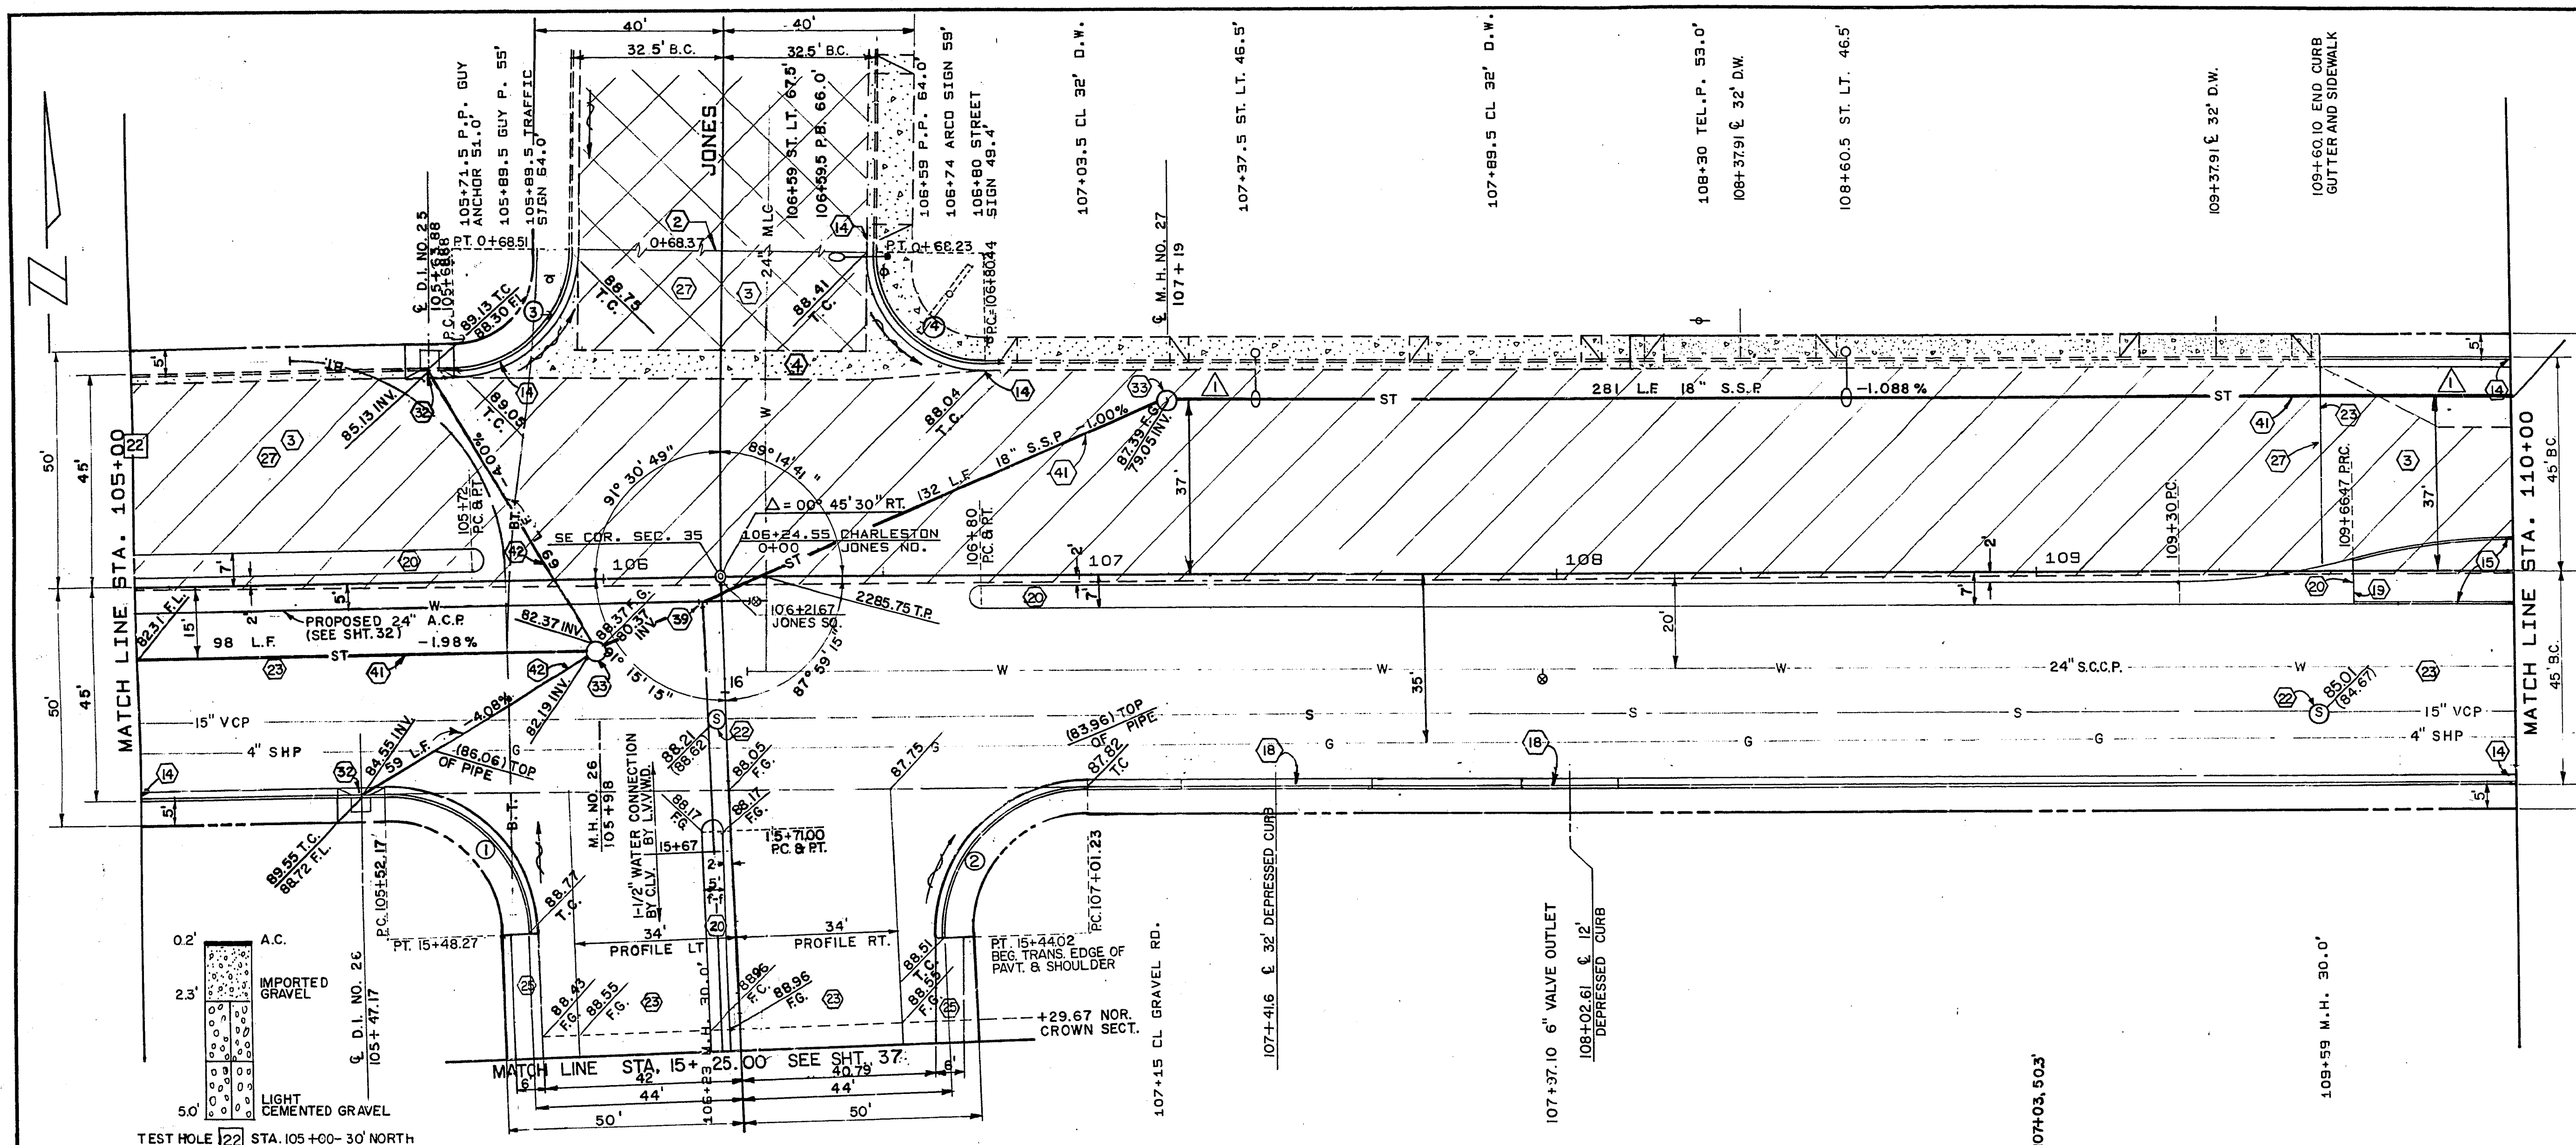

APPROXIMATE QUANTITIES — THIS SHEET						
ITEM NO.	DESCRIPTION	CLV S.I.D.	CLV.	R.S.H. S.I.D.	CO. UNIT	TOTAL
201.100	EXCAVATION	93		673	C.Y.	766
201.1004	SAWCUT A.C. PAV'T.			61	L.F.	61
201.1002	REMOVE A.C. PAV'T.			2508	S.Y.	2508
200.1103	REMOVE CONC VALLEY GUTTER			848	S.F.	848
340.236	COMM. CURB CUT	60			L.F.	60
340.014	"L" TYPE C&G—24"	230		174	L.F.	404
340.026	6" CONC. MED. CURB—TACK ON			74	L.F.	74
334.503	1 1/2" A.C. PAV'T. (MEDIAN)			4	TON	4
334.910	GREEN COLOR COATING	47			S.Y.	47
340.146	6" MON. CONC. MEDIAN			2107	S.F.	2107
302.200	TYPE II GRAVEL BASE	20		14	C.Y.	34
512.500	ADJUST MANHOLES	2			EA.	2
333.500	1/2" OPEN GRADED PLANT—MIX	391		4886	S.Y.	5277
334.112	6" A.C. PAV'T.	137		949	TON	1086
334.006	3" A.C. PAV'T.			426	TON	426
334.800	PRIME COAT			729	GAL	729
500.200	INLET STRUCTURE			2	EA.	2
302.210	6' GRAVEL SHOULDER			6	C.Y.	6
39	1-1/2" WATER CONNECTION	1			EA.	1
500.200	CONST. DROP INLET			2	EA.	2
512.600	STORM DRAIN MANHOLE			16	V.F.	16
126.118 B	18" STORM SEWER PIPE			503	L.F.	503
126.115 B	15" STORM SEWER PIPE			128	L.F.	128

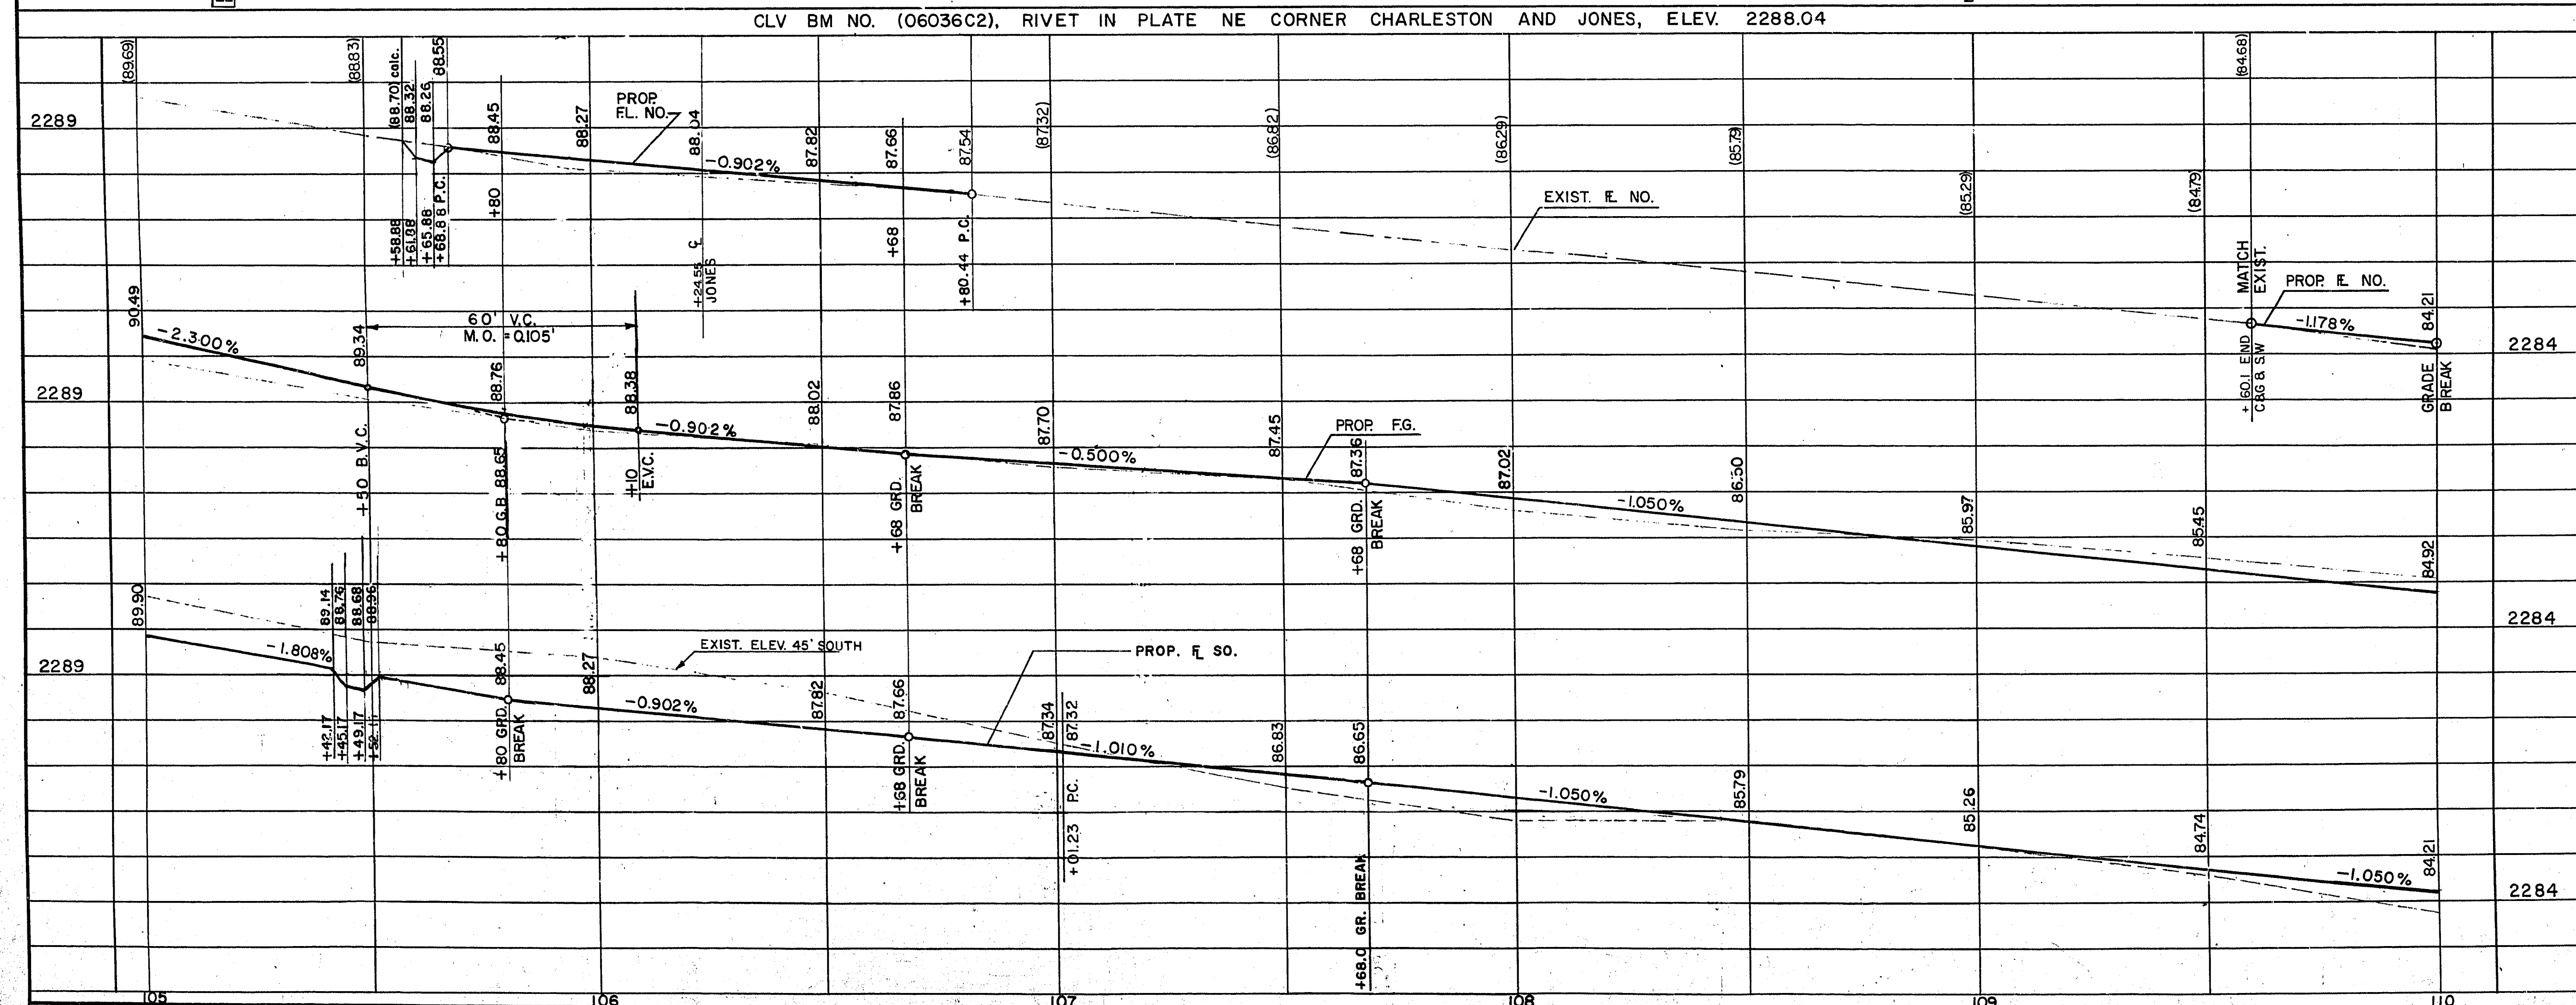

CURVE DATA				
NO.	B.C. RADIUS	DELTA	TANGENT	LENGTH
3	25.0'	88° 29' 11"	24.35'	38.61'
4	22.5'	90° 45' 19"	22.80'	35.64'
1	30.0'	88° 44' 45"	29.35'	46.72'
2	30.0'	92° 00' 45"	31.07'	48.18'

CONTRACT
DRAWING
JUN 28 1974

REV. NO.	DESCRIPTION	DATE	APPROVAL
1	CHANGED LOCATION OF S.S.P. BET. JONES & DECATUR	7/29/74	AP

CITY OF LAS VEGAS NEVADA
DEPARTMENT OF PUBLIC WORKS
SERVICES DIVISION

WEST CHARLESTON BOULEVARD
ANTELOPE WAY TO UPLAND BLVD.
STA. 105+00 TO STA. 110+00

W.D. NO. 7881	E.B. NO. 71-8X	DATE	DRAWING NO.
SC (H)	1" = 20' SC (V)	3-20-74	107V-853
DES. W.L. JAUBERT	CALCOMP-618	FILE NO.	107V-853
DR. L.Z.	APPROVED BY DIRECTOR OF PUBLIC WORKS	SHEET	22 OF 58

AP