



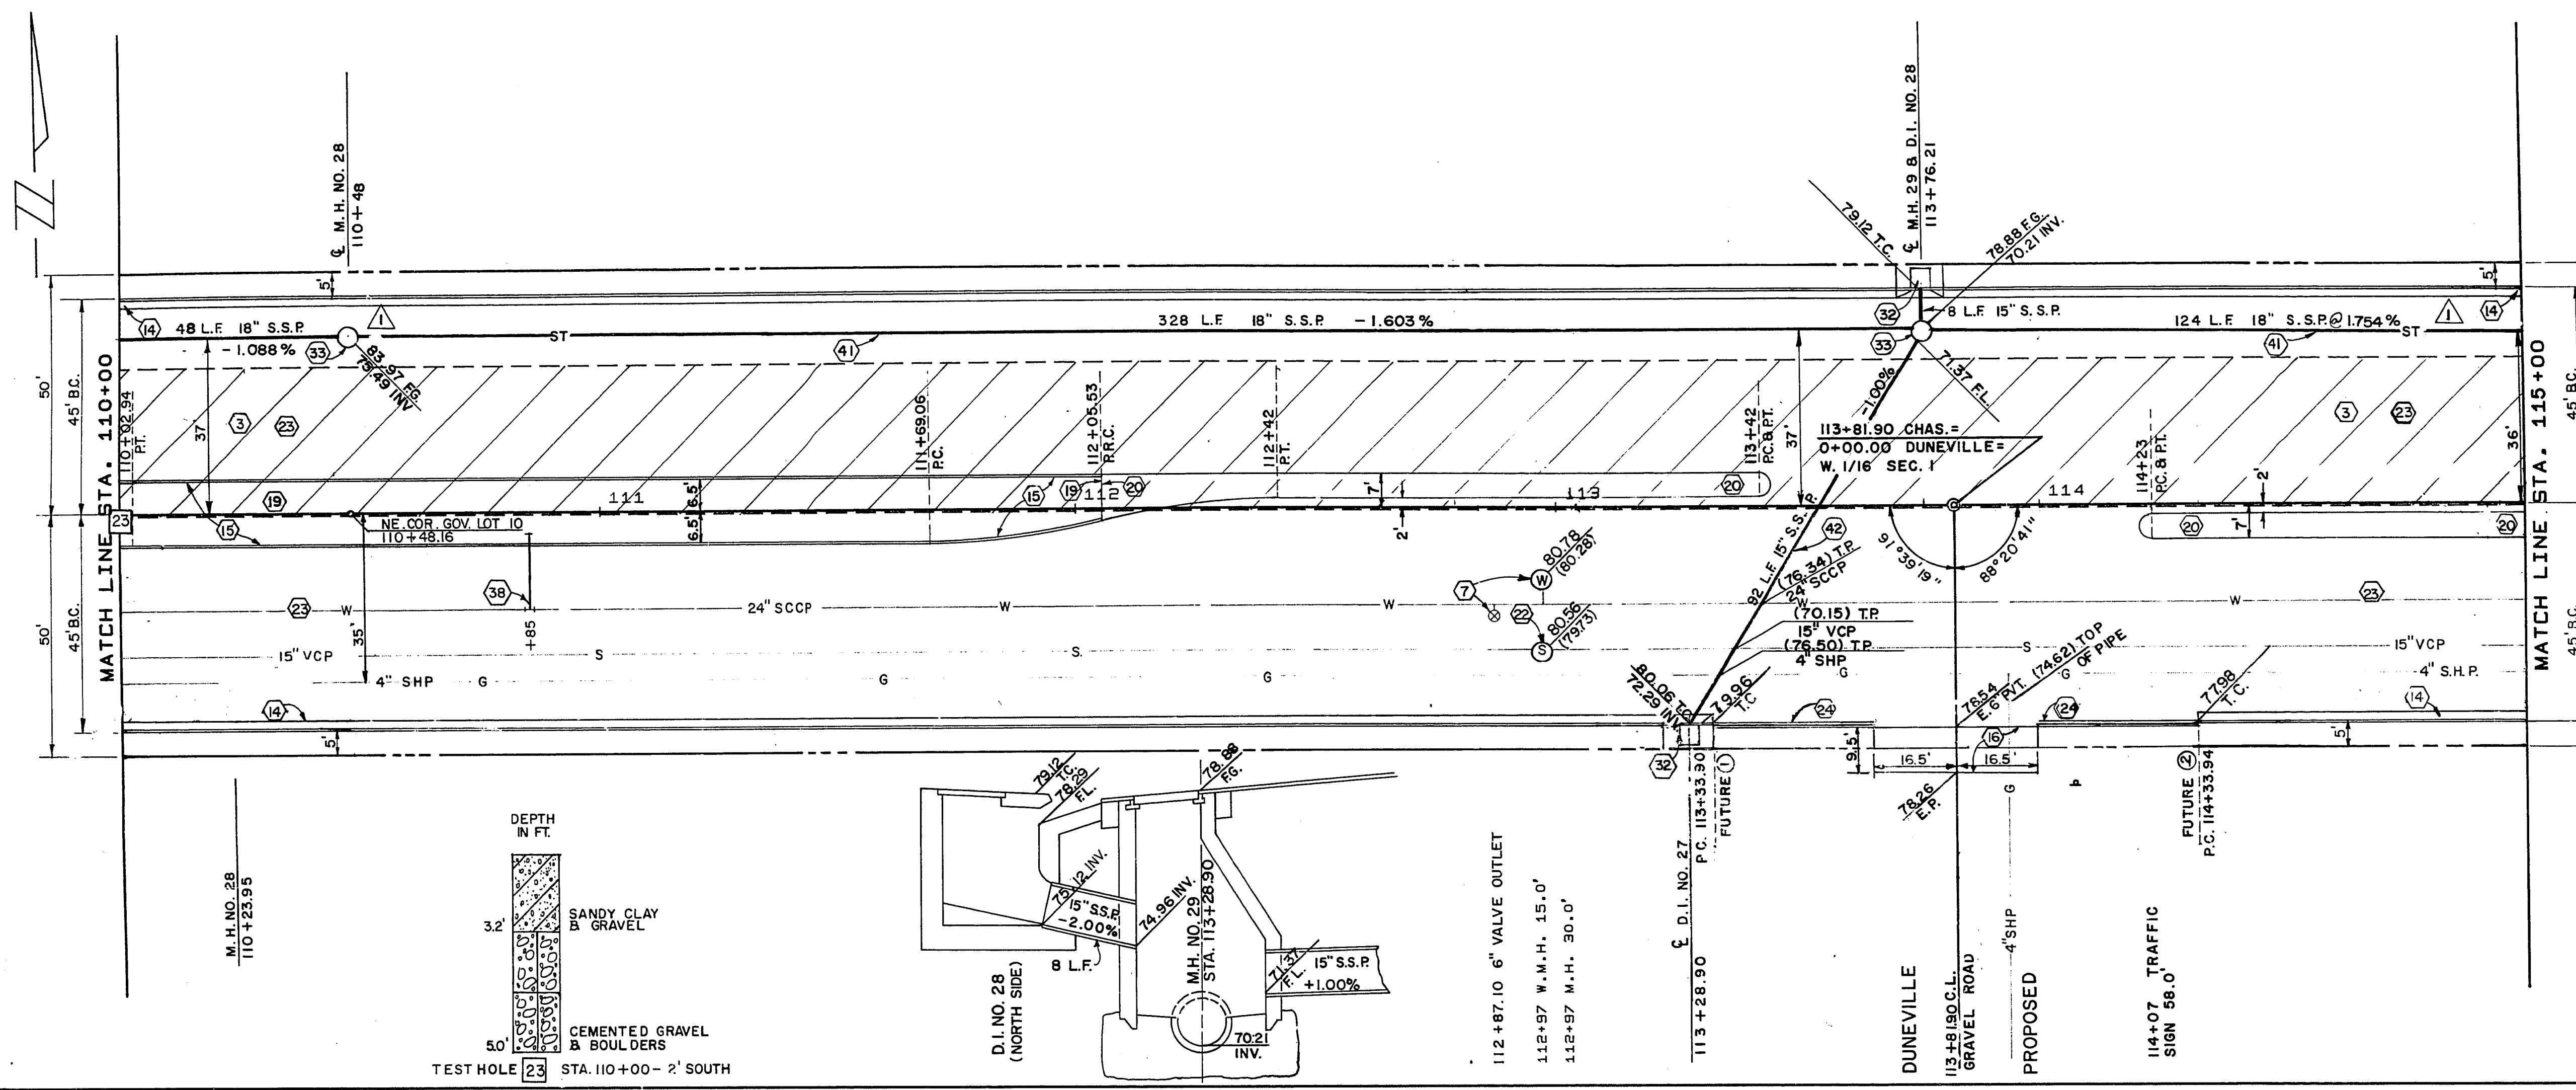

APPROXIMATE QUANTITIES — THIS SHEET						
ITEM NO.	DESCRIPTION	C.L.V. S.I.D.	C.L.V. R.S.H.	CO. S.I.D.	UNIT	TOTAL
201.100	EXCAVATION	221	545		C.Y.	766
201.1002	REMOVE A.C. PAV'T.		1666		S.Y.	1666
340.014	"L" TYPE C&G-24"	880			L.F.	880
340.026	6" CONC. MED. CURB-TACK ON		405		L.F.	405
334.912	A.C. CURB		67		L.F.	67
334.003	1-1/2" A.C. PAV'T.—TRANS.		3		TON	3
334.503	1-1/2" A.C. PAV'T. (MEDIAN)		25		TON	25
334.910	GREEN COLOR COATING	286			S.Y.	286
302.200	TYPE II GRAVEL BASE	44	40		C.Y.	84
340.146	6" MON. CONC. MEDIAN		1142		S.F.	1142
512.500	ADJUST MANHOLES		1		EA.	1
333.500	1/2" OPEN GRADED PLANT MIX	1000	3337		S.Y.	4337
334.112	6" A.C. PAV'T.	350	1248		TON	1598
333.100	FOG SEAL		5		GAL	5
	1" WATER CONNECTION		1		EA.	1
500.200	CONST. DROP INLET		2		EA.	2
512.600	STORM DRAIN MANHOLE		18		V.F.	18
126.118 B	18" STORM SEWER PIPE		500		L.F.	500
126.115 B	15" STORM SEWER PIPE		103		L.F.	103

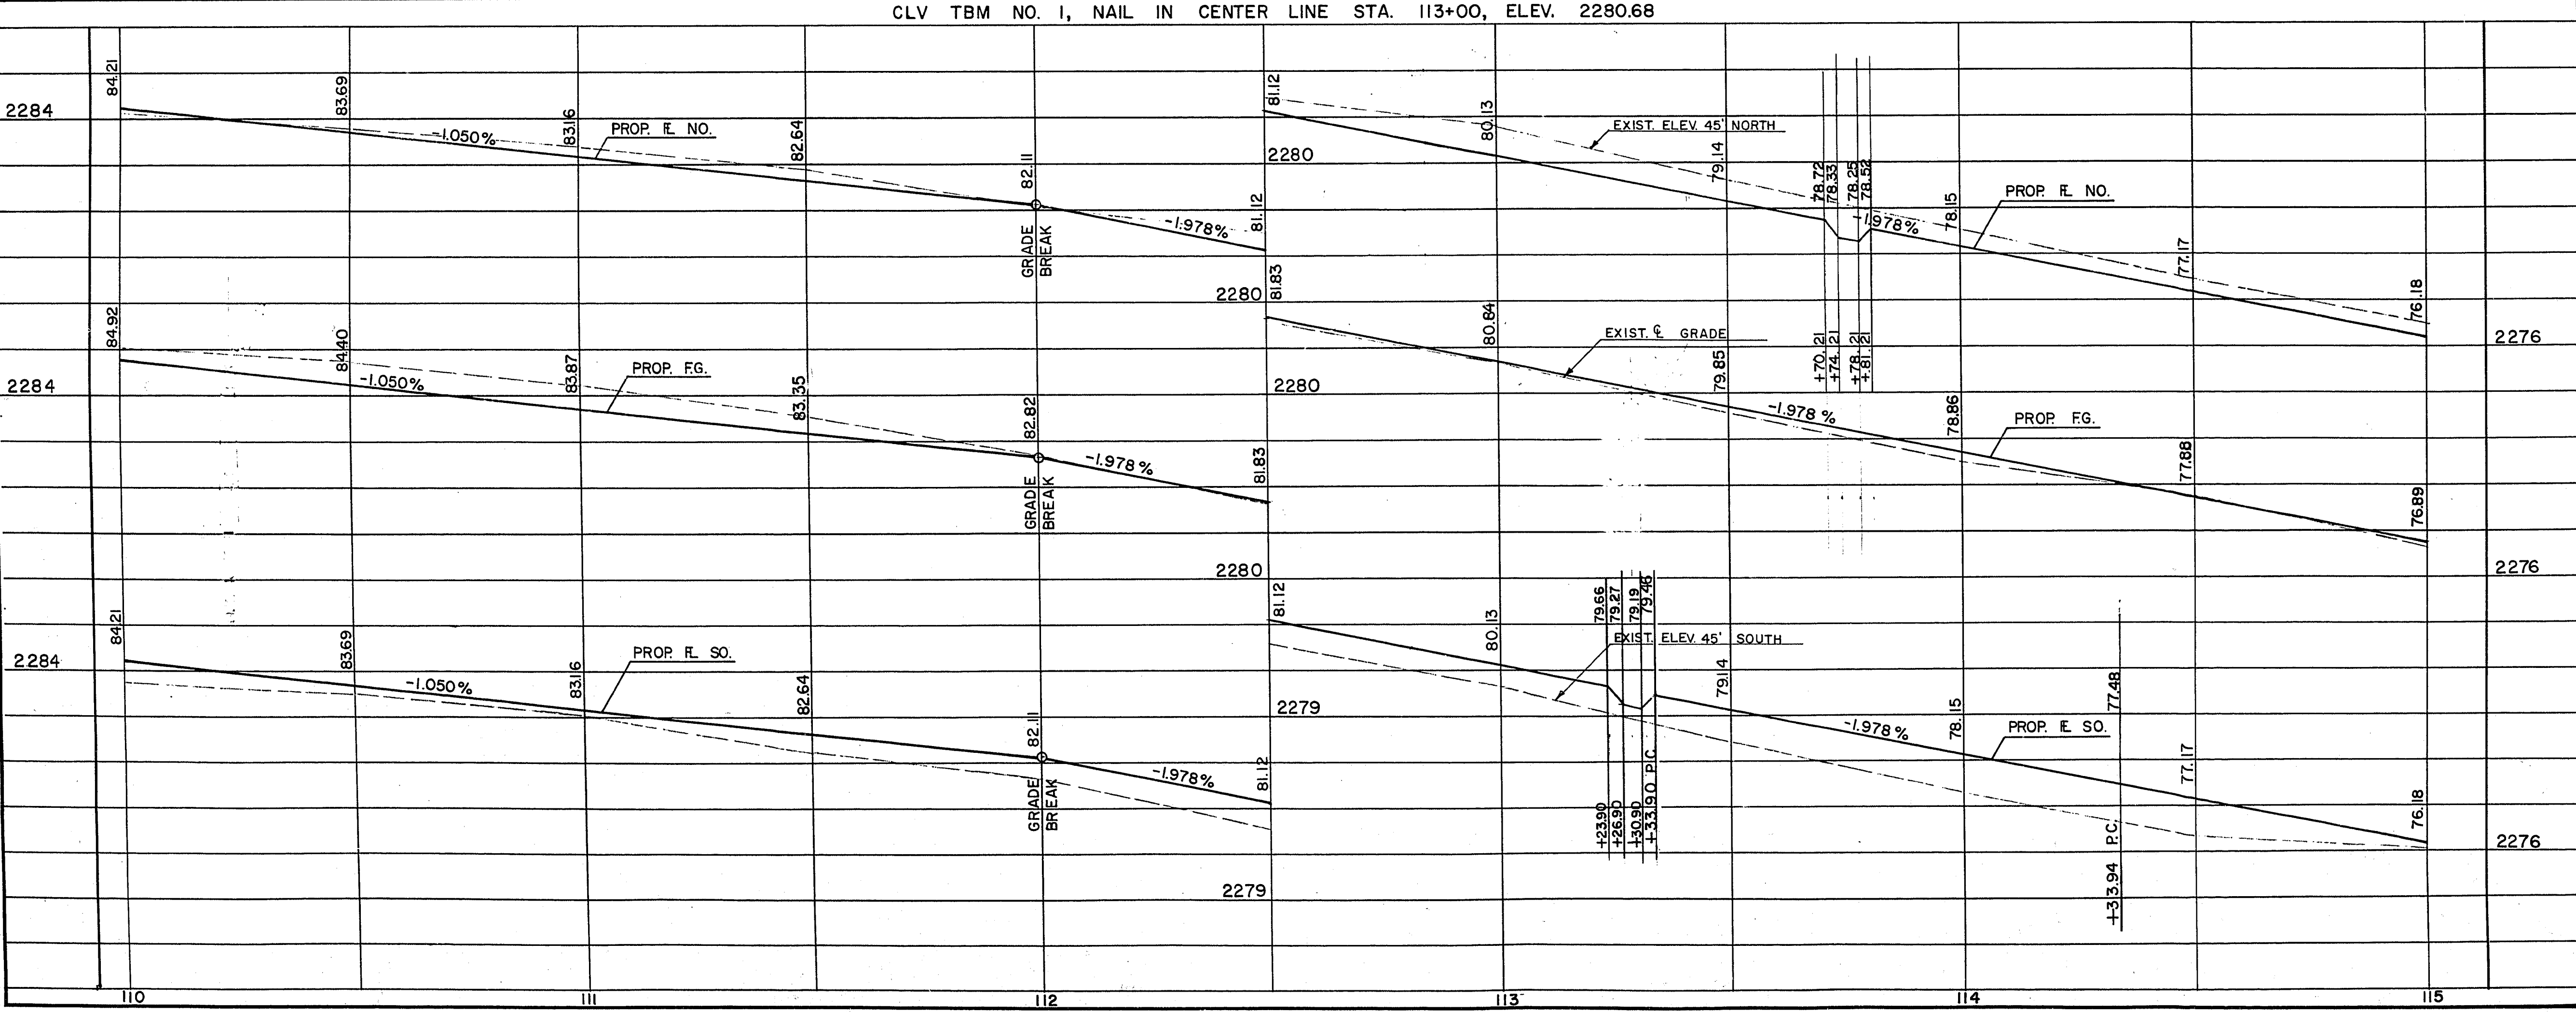

CONTRACT DRAWING
JUN 28 1974

REV. NO.	DESCRIPTION	BY	DATE	APPROVAL
1	CHANGED LOCATION OF S.S.P. BET. JONES & DECATUR	M.P.	7/29/74	<i>[Signature]</i>

CITY OF LAS VEGAS NEVADA
DEPARTMENT OF PUBLIC WORKS
SERVICES DIVISION

WEST CHARLESTON BOULEVARD
ANTELOPE WAY TO UPLAND BLVD.
STA. 110+00 TO STA. 115+00

W.O. NO. 7681	F.B.K. NO. 71-8X	DATE	DRAWING NO.
SC. (H) 1" = 20'	SC. (V) 1" = 2'	3-20-74	
DES. W.L. JAUBERT	CALCOMP-618	FILE NO.	107V-853
APPROVED BY DIRECTOR OF PUBLIC WORKS	<i>[Signature]</i>		

SHEET 23 OF 58