



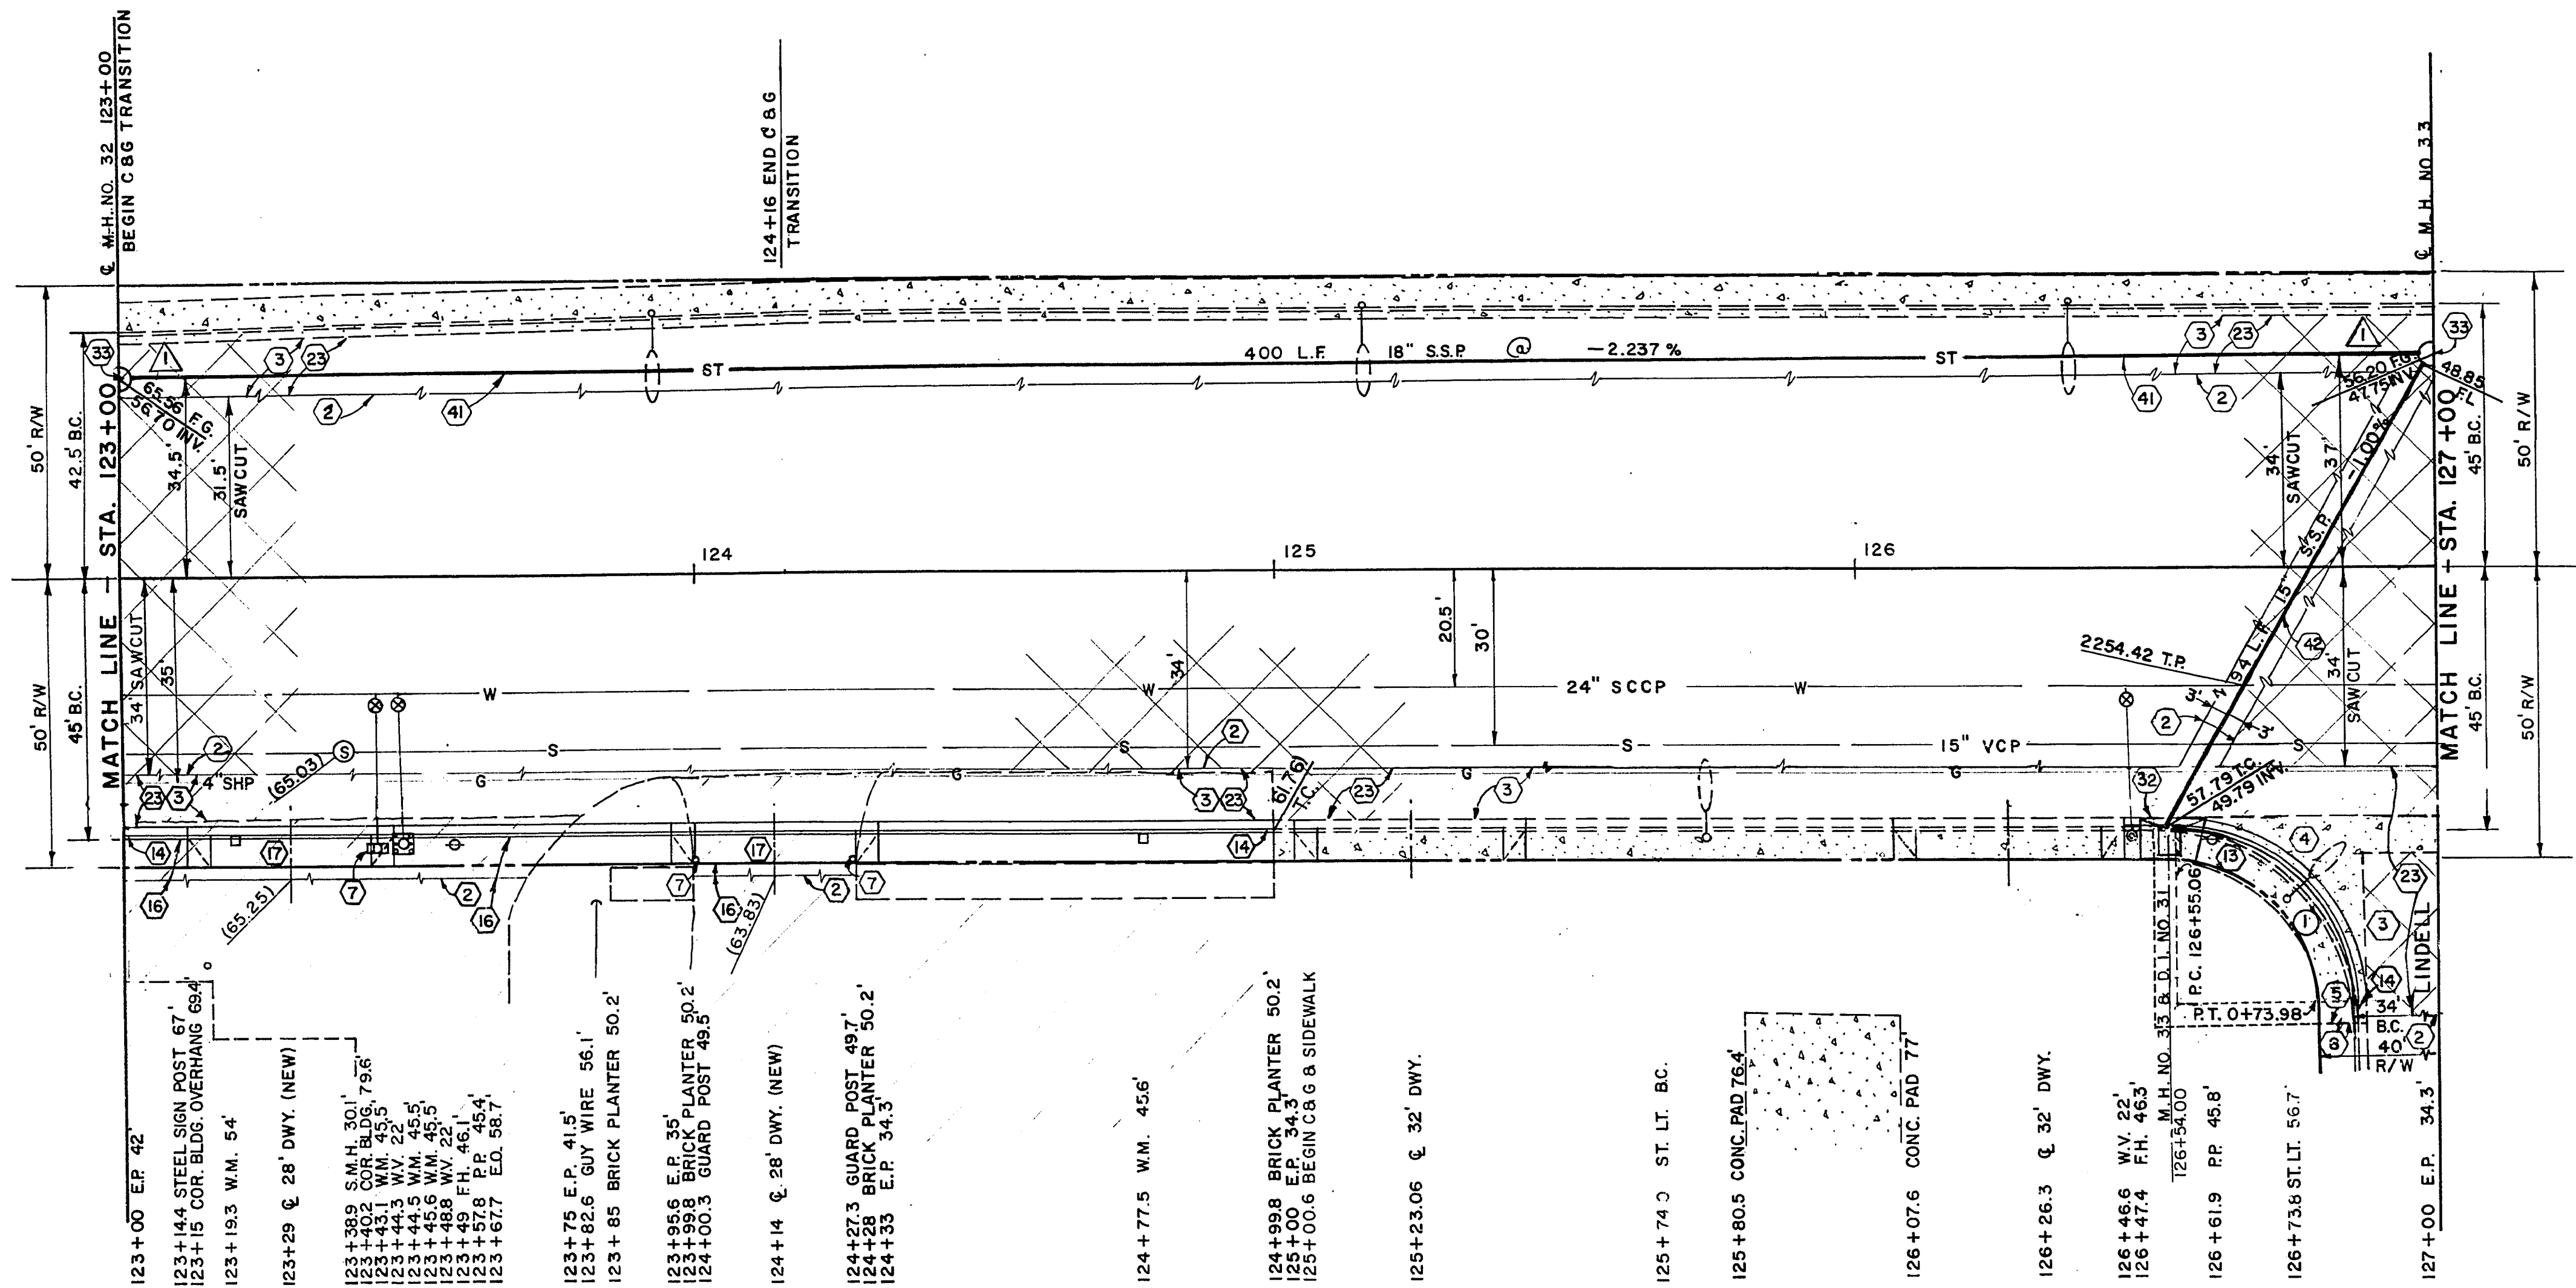

APPROXIMATE QUANTITIES — THIS SHEET									
ITEM NO.	DESCRIPTION	C.L.V. S.I.D.	C.L.V.	R.S.H.	CO. S.I.D.	UNIT	TOTAL		
200.100	EXCAVATION				46	C.Y.	46		
126.118 B	SAWCUT A.C. PAV'T.			511		L.F.	511		
126.118 B	REMOVE A.C. PAV'T.			476		S.Y.	476		
200.1103	REMOVE CONC. VALLEY GUTTER			460		S.F.	460		
200.1105	REMOVE CONC. SIDEWALK			233		S.F.	233		
200.1100	SAWCUT CONCRETE			10		L.F.	10		
340.014	"L" TYPE C&G - 24"			47	128	L.F.	175		
334.003	1 1/2" A.C. PAV'T. - TRANSITION			4		TON	4		
333.100	FOG SEAL			7		GAL	7		
340.226	CONC. COMM. DRIVEWAY			504		S.F.	504		
302.200	TYPE II GRAVEL BASE			2	24	C.Y.	26		
333.500	1/2" OPEN GRADED PLANT MIX			271	200	S.Y.	471		
334.112	6" A.C. PAV'T.			96	70	TON	166		
340.114	CONST. CONC. SIDEWALK			230		S.F.	230		
500.200	CONST. DROP INLET			1		EA	1		
512.600	STORM DRAIN MANHOLE			16		V.F.	16		
126.118 B	18" STORM SEWER PIPE			400		L.F.	400		
126.115 B	15" STORM SEWER PIPE			4		L.F.	4		

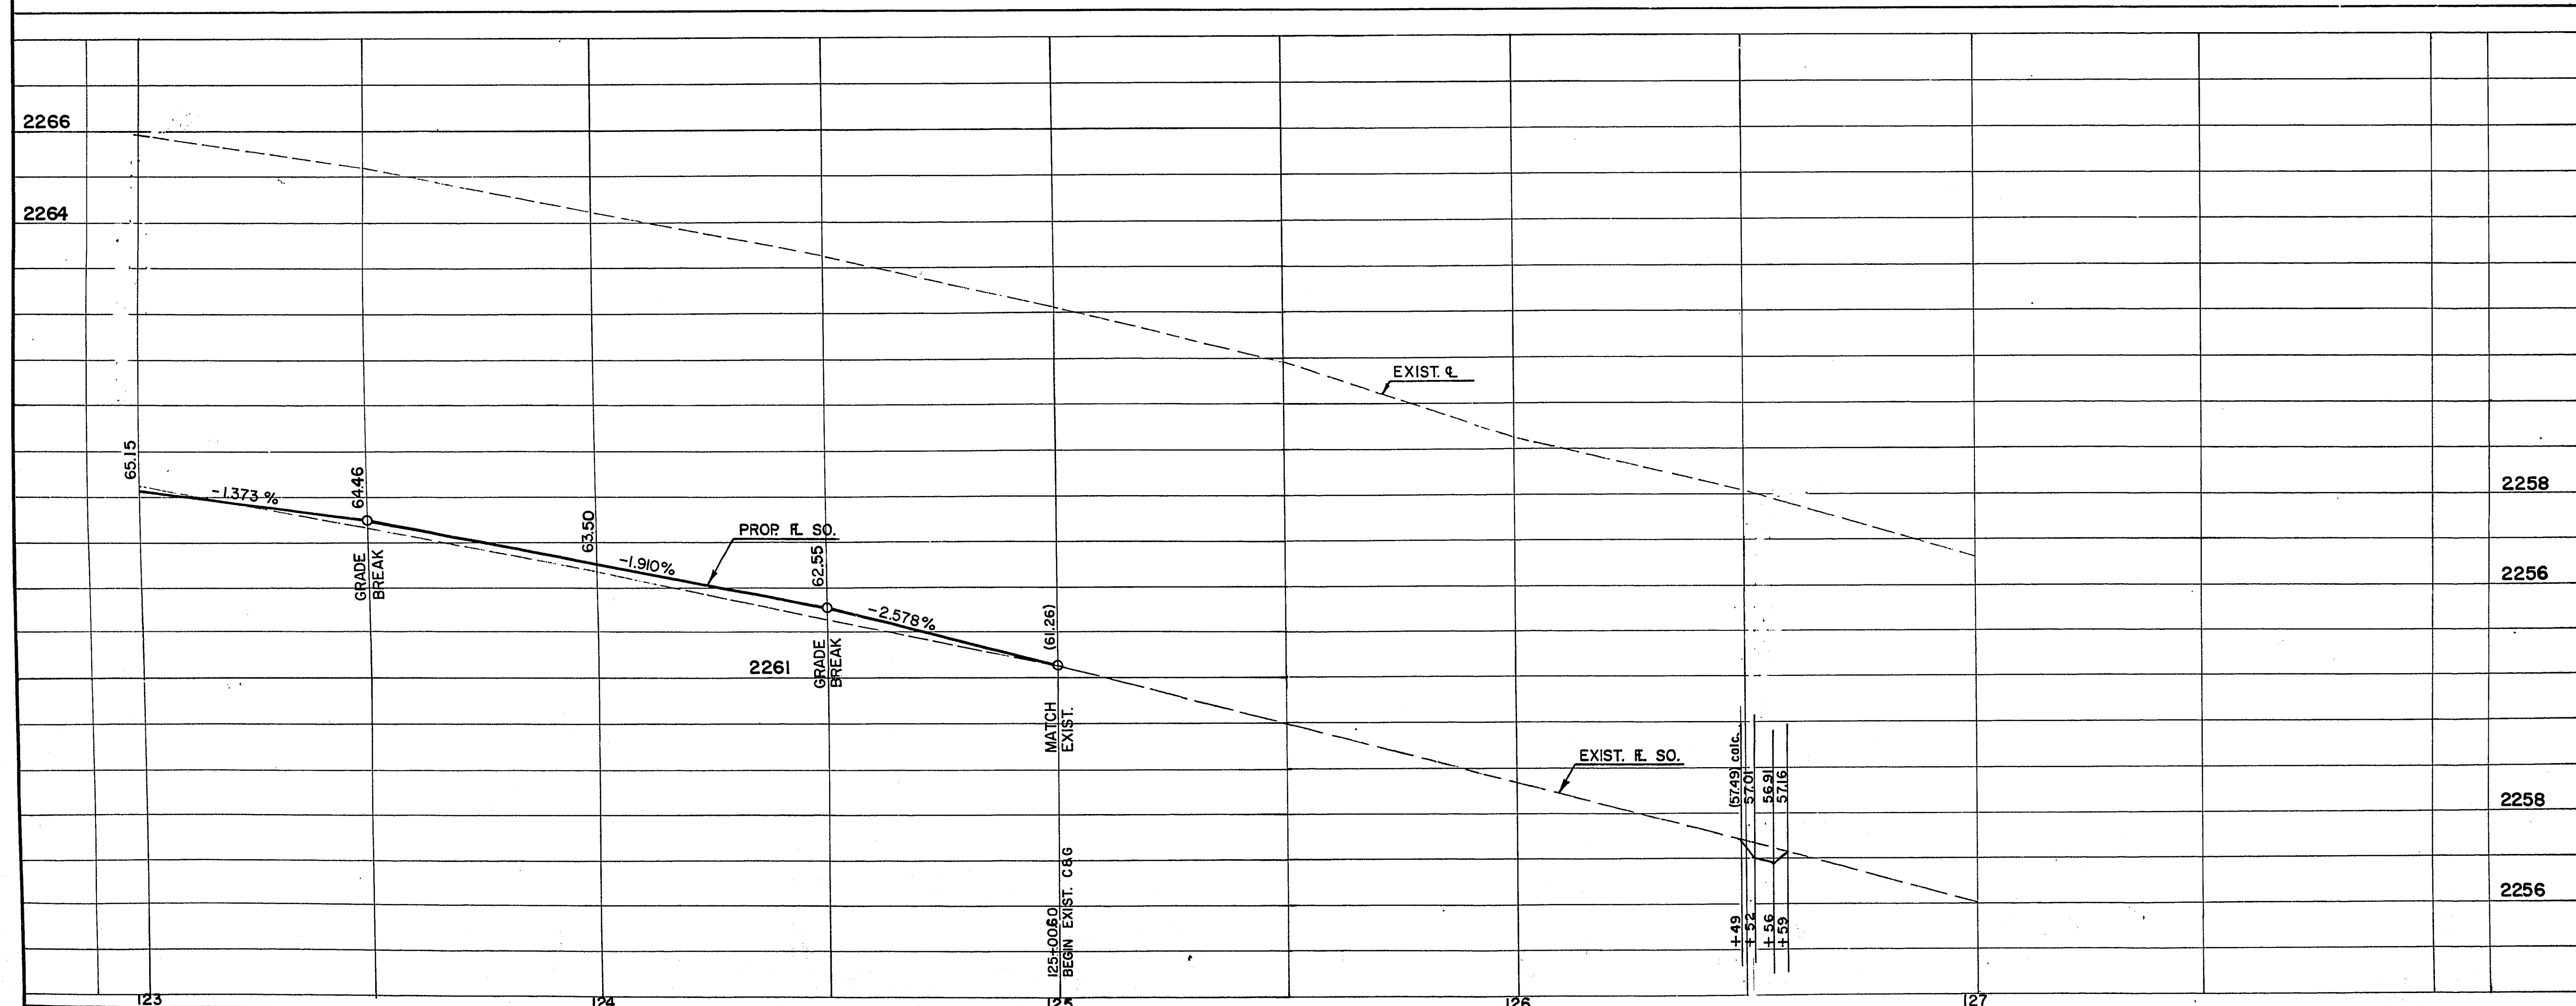

CURVE DATA				
NO.	B.C. RADIUS	DELTA	TANGENT	LENGTH
1	30.0'	89° 04' 53"	29.52'	46.64'

CONTRACT DRAWING
JUN 28 1974

REV. NO.	DESCRIPTION	BY	DATE	APPROVAL
1	CHANGED LOCATION OF S.S.P. BET. JONES & DECATUR	M.P.	7/26/74	<i>[Signature]</i>

CITY OF LAS VEGAS NEVADA
DEPARTMENT OF PUBLIC WORKS
SERVICES DIVISION

WEST CHARLESTON BLVD.
ANTELOPE WAY TO UPLAND BLVD, EXTENSION EAST
STA. 123+00 TO 127+00

W.O. NO. 7681	F.B.K. NO. 71-8X	DATE	DRAWING NO.
SC. (H) 1"=20'	SC. (V) 1"=2'	3-20-74	
DES. J.L. JAUBERT			FILE NO.
DR. J.S.H.			107 V-853
APPROVED BY DIRECTOR OF PUBLIC WORKS			SHEET 26 OF 58

[Signature]