



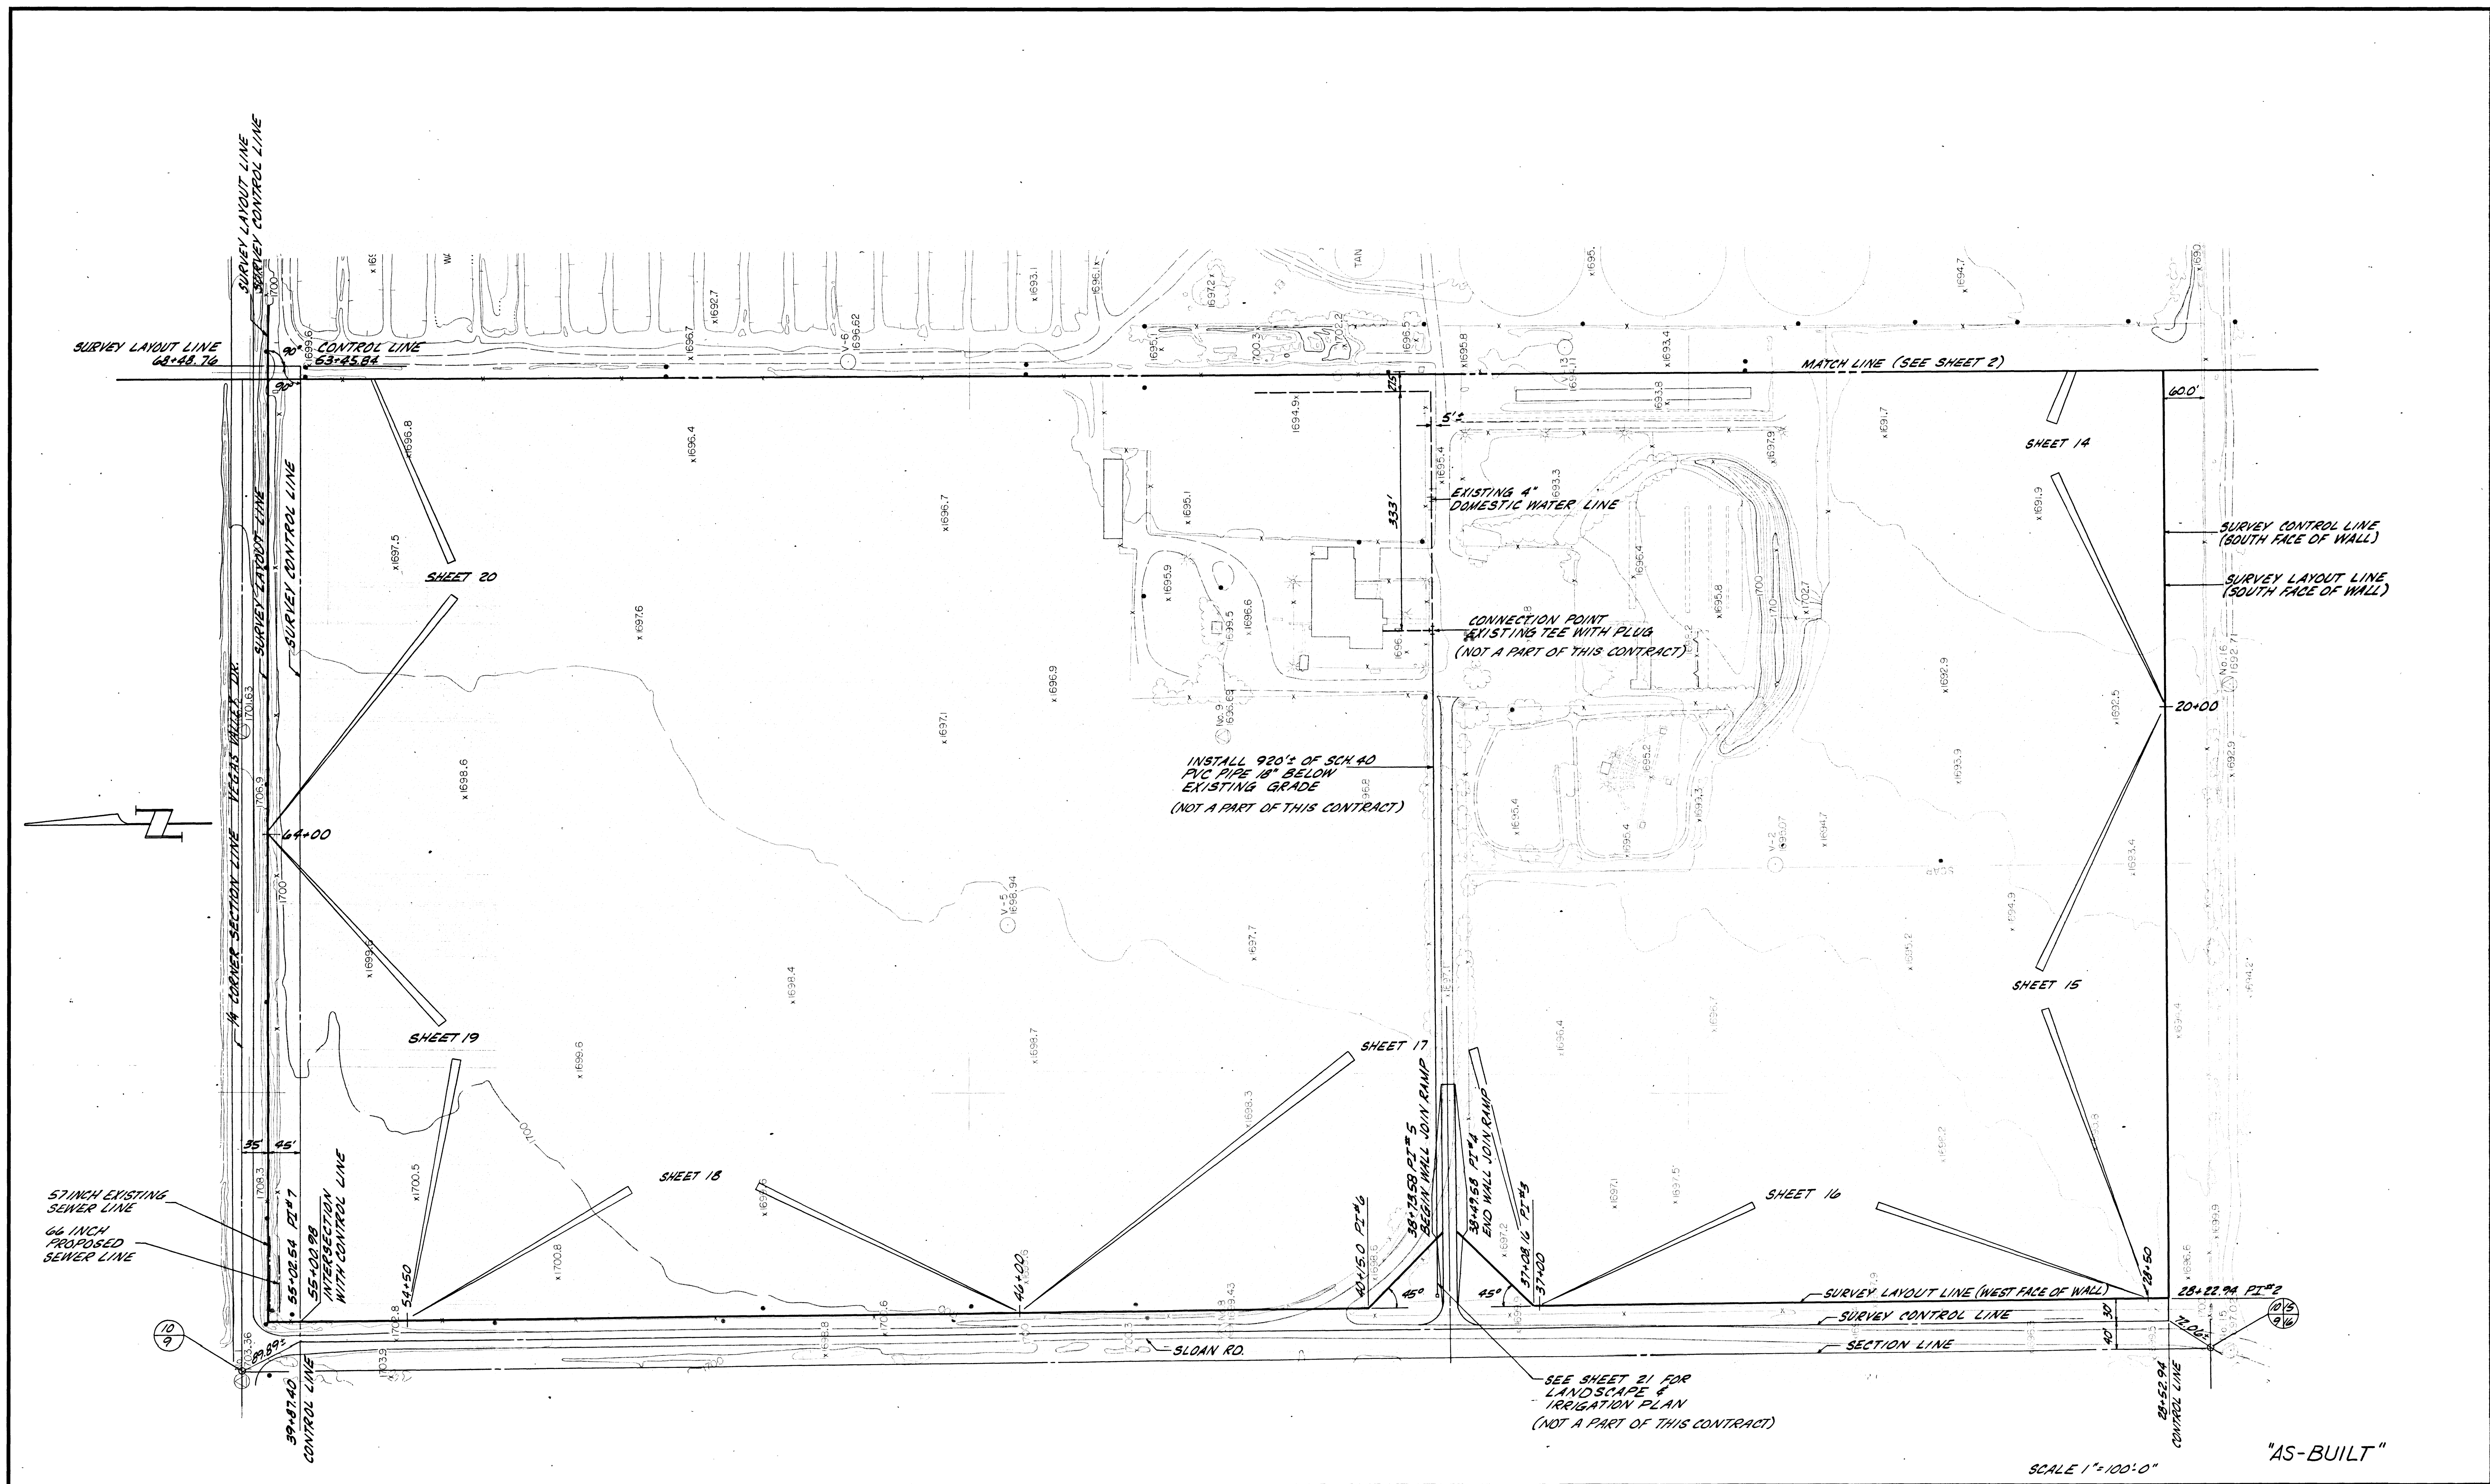

1	AAS	REVISED WALL ALIGNMENT STA 55+63 TO STA 55+00	11-01-82
NO.	BY	REVISION	DATE

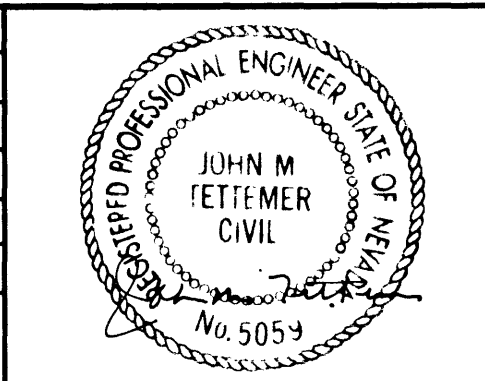

Designed	AAS	PROJECT NO.	08-3
Drawn	MK	DATE	8/81
Checked	AAS	Approved	JMT

JOHN M. TETTEMER & ASSOCIATES
CONSULTING ENGINEERS
LOS ANGELES, CALIFORNIA

CITY OF LAS VEGAS, NEVADA
WASTEWATER TREATMENT PLANT
EXPANSION
CONTRACT NO. 6
FLOODPROOFING FACILITIES

OVERALL SITE PLAN WEST SIDE	SHEET 3 OF 31
--------------------------------	------------------------

4-1-19 311.5 E