

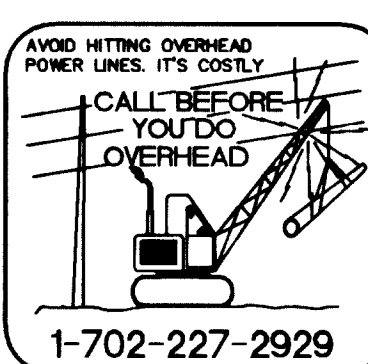


125-27-411-011

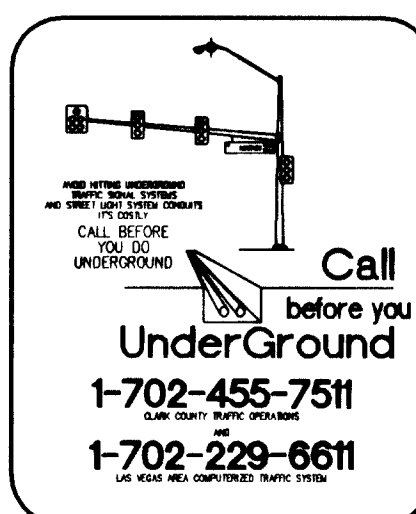

NOTE: ALL LAND SURFACE AREA DISTURBANCES OVER 1 ACRE REQUIRE A STORMWATER DISCHARGE PERMIT ISSUED BY THE NEVADA DIVISION OF ENVIRONMENTAL PROTECTION (NDEP). A PHASE 1 ENVIRONMENTAL IMPACT STATEMENT (EIS) FOR A PHASE 2 CONSTRUCTION UNIT IN A CONTIGUOUS SUBDIVISION IS CONSIDERED UNDER CONSTRUCTION UNTIL ALL STRIPPED OR DISTURBED SURFACE AREAS HAVE BEEN COVERED BY PAVING, BUILDING CONSTRUCTION OR PLANTING. A STORMWATER DISCHARGE PERMIT APPLICATION AND ASSOCIATED INFORMATION MAY BE DOWNLOADED FROM THE WEB SITE: [HTTP://WWW.STATE.NV.US/NDEP/BWPC/STORMCoul.HTM](http://www.state.nv.us/ndep/bwpc/stormcoul.htm)

THIS DISTURBANCE MAY BE COVERED BY AN EIS IF THE LAND MUST BE SUBMITTED TO NDEP FOR A "NOTICE OF INTENT" FOR INCLUSION UNDER STORMWATER PERMIT NO. NV100000 FOR PROTECTION UNDER THE APPROPRIATE FILING FEE.

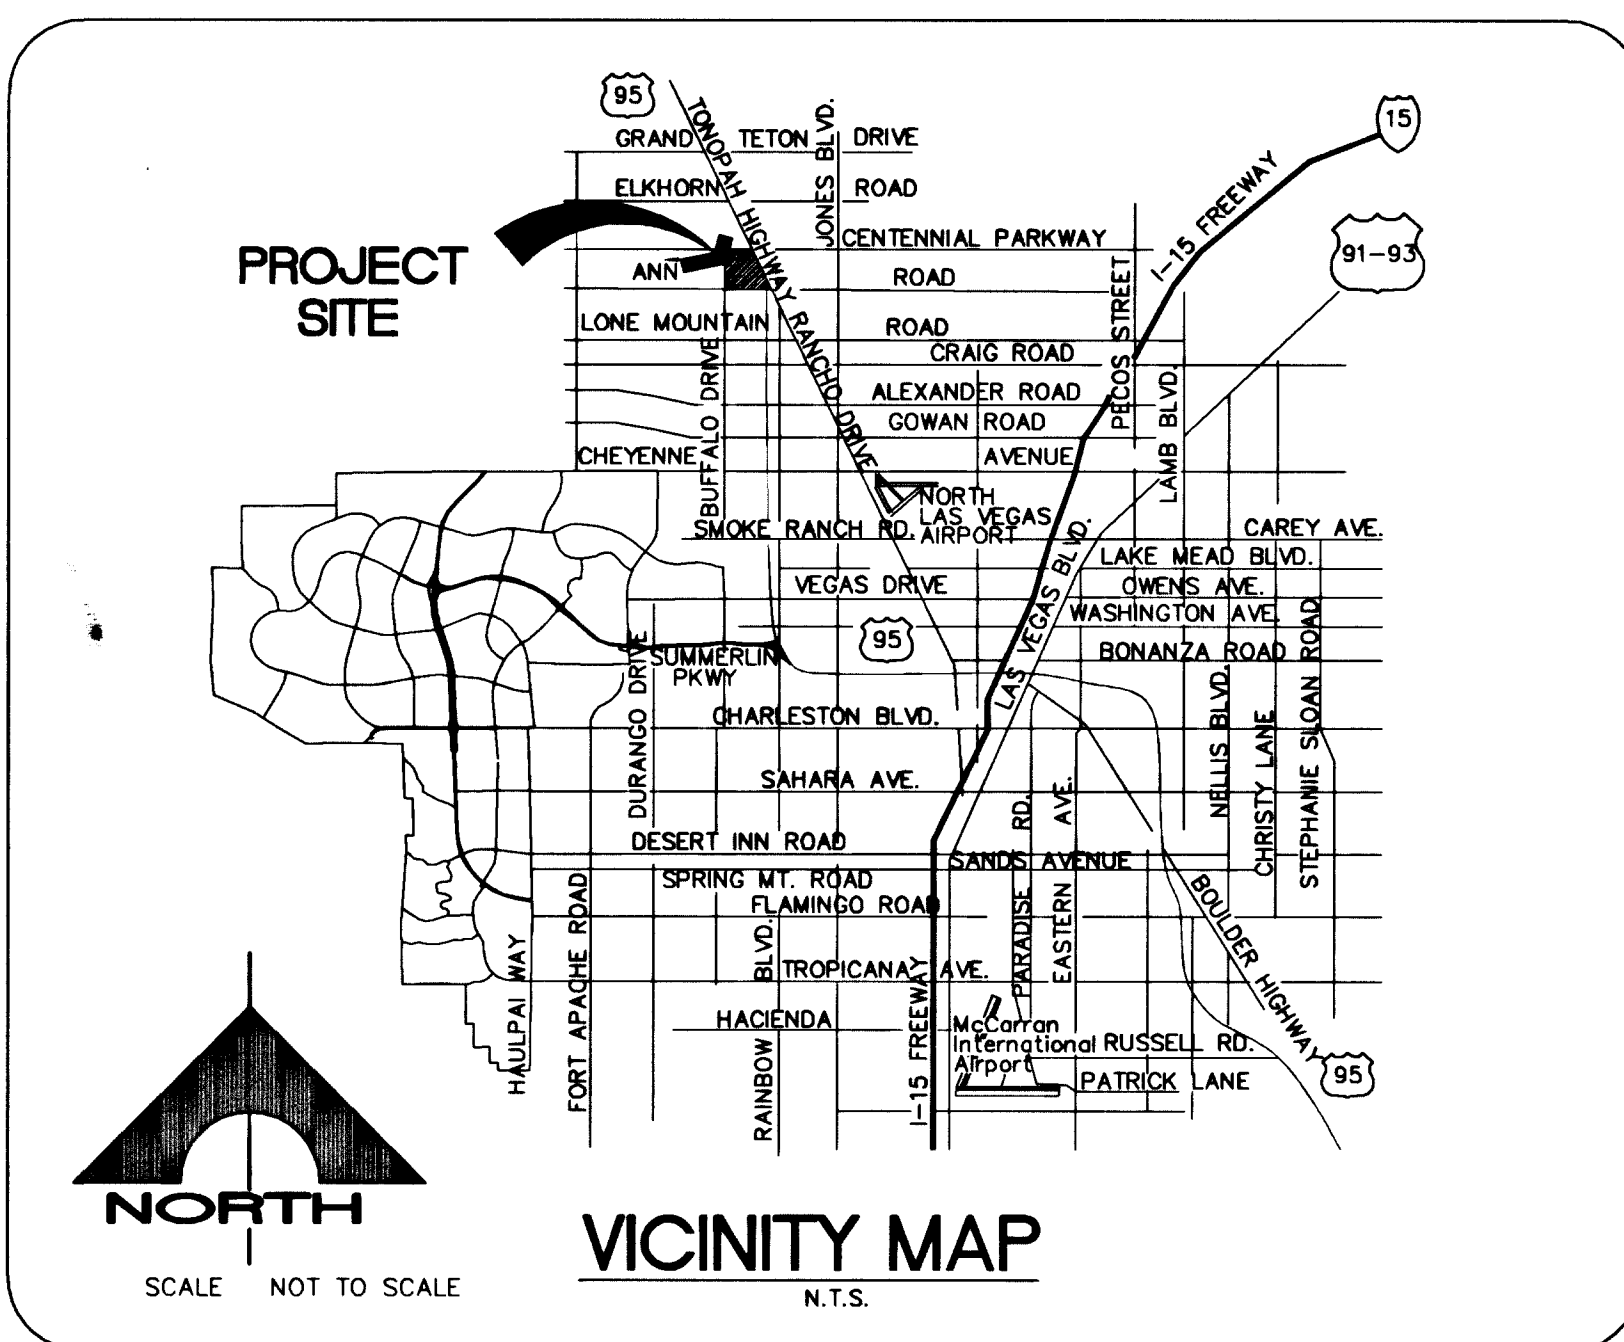

G.C. WALLACE, INC.
 Engineering/Planners/Surveyors
 1555 SOUTH RAINBOW BLVD. / LAS VEGAS, NEVADA 89146

104972 105623 108201

PROJECT NAME: Walgreens at Centennial Gateway Project #114138
This project water plan complies with the Las Vegas Valley Water District's technical requirements. However, this water plan is (Sheet C-1, C-2, C-4, C-6)
NOT APPROVED FOR CONSTRUCTION

at this time and this signature does not provide or imply a water
commitment.

Bong Lang 7/11/07
LVWWD DATE

DEVELOPED BY:
TERRITORY, INC.

5785 CENTENNIAL CENTER BLVD. #230
LAS VEGAS, NEVADA 89149
PHONE: (702)-822-8200
FAX: (702)-822-8201

REV#	REV. DESCRIPTION	SHEET(S)	APPD	BY	DATE	APPD
1	ADDED ONSITE STORM DRAIN. LIMITS OF CONSTRUCTION REVISED TO REFLECT EXISTING PANDA EXPRESS CURB ELEVATIONS.	3,5,6	KOL		1/24/08	

INDEX OF DRAWINGS		
NO.	DRAWING	TITLE AND DESCRIPTION
1	C-1	COVER SHEET
2	C-2	GENERAL NOTES
3	C-3	HORIZONTAL CONTROL PLAN
4	C-4	UTILITY PLAN
5	C-5	GRADING PLAN
6	C-6	DETAILS/ SECTIONS
7	C-7	WALL DETAILS

APPROVALS

CITY OF LAS VEGAS

"APPROVAL OF THESE PLANS BY THE CITY ENGINEER IS LIMITED TO THOSE IMPROVEMENTS CONSTRUCTED IN THE DEDICATED RIGHTS-OF-WAY AND/OR DEDICATED EASEMENTS. THIS APPROVAL DOES NOT AUTOMATICALLY CONSTITUTE AN APPROVEMENT THAT DEVIATES FROM ADOPTED STANDARDS AND SPECIFICATIONS EXCEPT THOSE SPECIFICALLY LISTED UNDER "DEVIATIONS FROM STANDARDS". THE ENGINEER SHALL REQUIRE ANY DEVIATION OTHER THAN THOSE LISTED IN "DEVIATION FROM STANDARDS" IN FAVOR OF THE SUMNERLIN IMPROVEMENT STANDARDS AND SPECIFICATIONS, CLARK COUNTY AREA NEVADA."



JORGE CERVANTES, P.E. #13977, PTOE
CITY ENGINEER

8/20/17

DATE

CITY OF LAS VEGAS, NEVADA


DOUG RANKIN, ACIP, PLANNING MANAGER

8-10-07
DATE

THIS PLAN MEETS THE APPLICABLE STANDARDS OF THE PLANNING AND DEVELOPMENT DEPARTMENT

C.L.V. FIRE DEPARTMENT 8.8.07
DATE

NEVADA POWER CO. 6-13-07
DATE

NEVADA POWER CO. _____ DATE _____

NEVADA POWER COMPANY ACKNOWLEDGES THAT WE HAVE RECEIVED YOUR PLANS AND WILL PROVIDE SERVICE TO ALL ELECTRICAL NEEDS ASSOCIATES WITH THIS PROJECT. NEVADA POWER COMPANY RESERVES THE RIGHT TO ADDRESS ANY EXISTING OR FUTURE CONFLICTS ONCE THE FINAL DESIGN IS COMPLETED. THE NEW SERVICE AND THE RESOLUTION OF ANY/CONFLICTS WILL BE ACCOMPLISHED PURSUANT TO THE NEVADA PUBLIC UTILITY COMMISSION'S RULES AND REGULATIONS.


EMBARO 06.18.07
DATE

"THE AFFIXED EMBARGO APPROVAL DOES NOT ASSUME OR GUARANTEE LIABILITY FOR KNOWN OR UNKNOWN CONFLICTS WITH EXISTING OR PROPOSED IMPROVEMENTS. RESOLUTION OF ANY CONFLICT WILL BE ACCOMPLISHED PURSUANT TO LOCAL ORDINANCES, NEVADA REVISED STATUTES AND/OR PUBLIC UTILITY COMMISSION RULES AND REGULATIONS"

Yubal A. James 7-23-05
SOUTHWEST GAS CORP. DATE

COX COMMUNICATIONS LAS VEGAS, INC. 6-13-07
DATE


LAS VEGAS VALLEY WATER DISTRICT
PROJ. # 11412R (SEE SHEETS C-1, C-2, & C-3, C-4, C-5, C-690, C-69

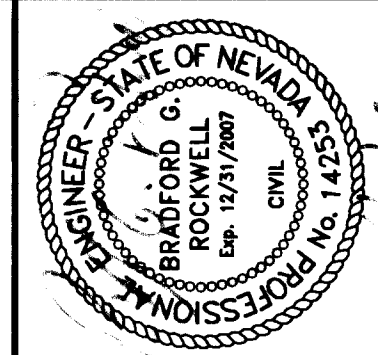

% COMPLETE

PROJECT NO.

G. C. WALLACE COMPANIES
ENGINEERS | PLANNERS | SURVEYORS
1555 S. RAINBOW BOULEVARD • LAS VEGAS, NV 89146
T: 702.804.2000 • F: 702.804.2299 • GCWALLACE.COM

Comm\Improv\010-C01.dwg

G:\822-010\DWG\c

WALGREENS 10782

CENTENNIAL GATEWAY

COVER SHEET

DRAWING

C-1

1 OF 7 SHTS