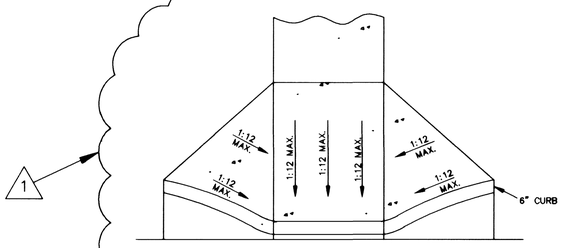

ONSITE RAMP "A"

N.T.S.

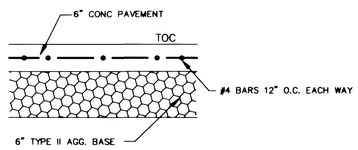

ON-SITE CONC PAVEMENT

(DRIVETHRU AND LOADING PAD) N.T.S.

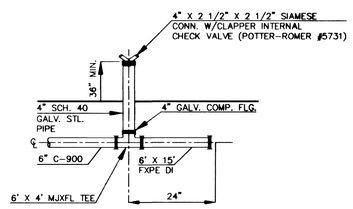

FDC DETAIL

N.T.S.

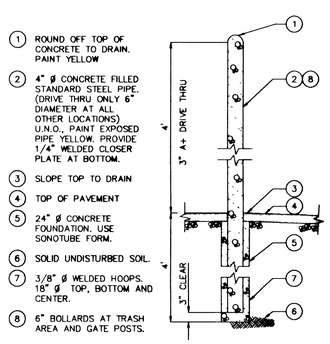

ON-SITE PIPE BOLLARD

NTS

Avoid cutting underground utility lines. It's costly.
Call before you Dig.
1-800-227-2600
UNDERGROUND SERVICE (USA)

AVOID HITTING OVERHEAD POWER LINES. IT'S COSTLY.
CALL BEFORE YOU DO OVERHEAD
1-702-593-6111

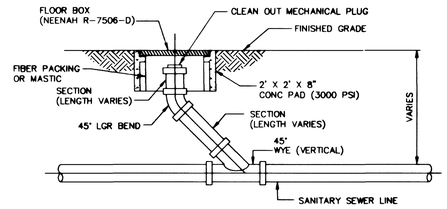

SEWER CLEAN OUT

N.T.S.

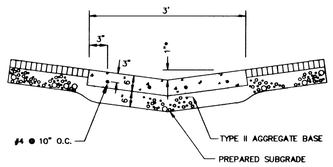

NOTE: INSTALL EXPANSION AND CONTRACTION JOINTS PER SPECS.

*EDGES OF GUTTER TRANSITION TO 1-1/2" AT "L" TYPE CURB AND GUTTER AND ARE TO BE 1/2" BELOW PAVEMENT

ON-SITE 3' VALLEY GUTTER

N.T.S.

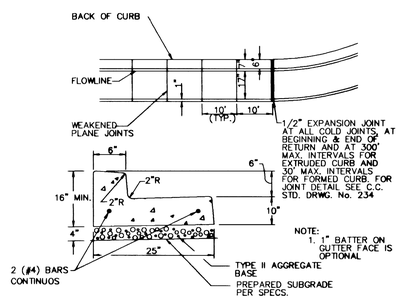

"L" TYPE CURB AND GUTTER

PER C.C.A.S.D. #216 NTS

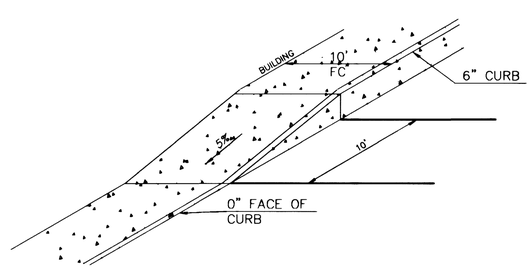

ONSITE RAMP "B"

N.T.S.

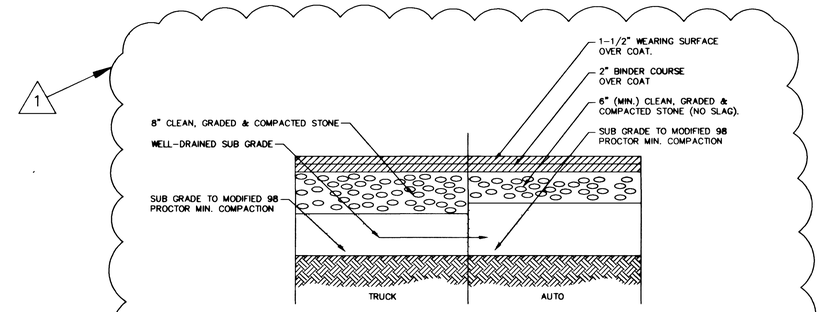

ON-SITE AC PAVEMENT SECTION

N.T.S.

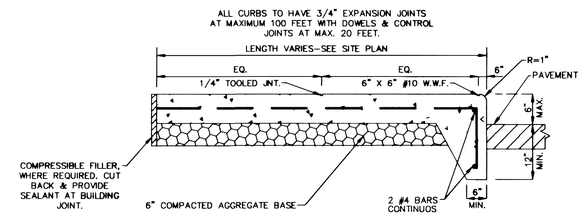

ON-SITESIDEWALK

N.T.S.

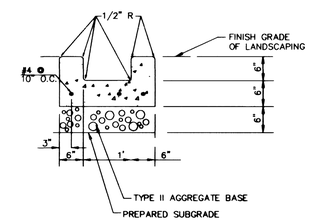

U-GUTTER DETAIL

N.T.S.

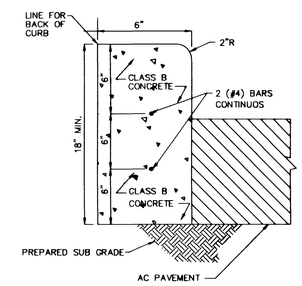

"A" TYPE CURB DETAIL

NTS

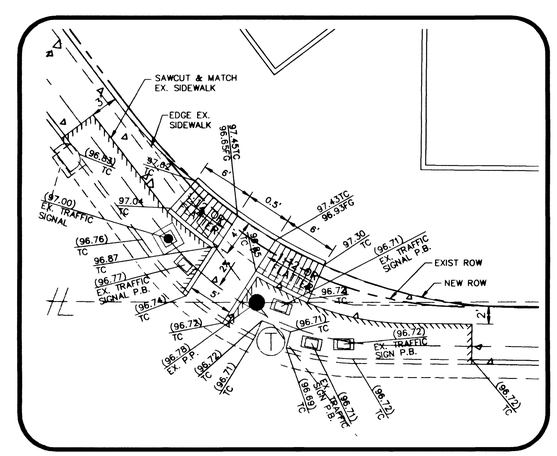

CURB RAMP DETAIL

NDOT DWG. R-5.2.2(613) MODIFIED
SCALE: 1"=8'

REV. #	BY	DATE	CLIENT REVISIONS DESCRIPTION	APP.
1	JHC	10/9/00		

REVISION APPROVAL BLOCK

SCALE: NONE
DRAWN BY TT
DESIGNED BY CCV
CHECKED BY JHC
SUBMITTAL DATE: 10-9-00
99087

OWNER / DEVELOPER
5 STAR PROPERTIES - WASHINGTON AND RANCHO, LLC
7320 W. SAHARA AVENUE, SUITE B
LAS VEGAS, NEVADA 89117
PHONE: (702) 869-9000
FAX: (702) 869-2180

THE CW GROUP
CIVIL ENGINEERS
2880 Chandler Ave. Suite 5
Las Vegas, Nevada 89120
PHONE: (702)798-9535
FAX: (702)798-9536

WALGREENS AT RANCHO AND WASHINGTON

DETAIL SHEET

PROFESSIONAL ENGINEER
JAMES H. CHILDS
12/4/00
CIVIL
NO. 11117
STATE OF NEVADA
ENGINEER'S SEAL

SHEET
C6
6 OF 6 SHEETS
DRAWING NO.
107-V3307

28267

REPLOT