


PLAN	SUBMITTED	DATE
	ALIGNMENT CHECKED	
NOTE BOOK NO.	PLOTTED	
	BY	

PROFILE	SUBMITTED	DATE
	GRADES CHECKED	
NOTE BOOK NO.	B. N. NOTED	
	STRUCTURE NOTATION CHECKED	

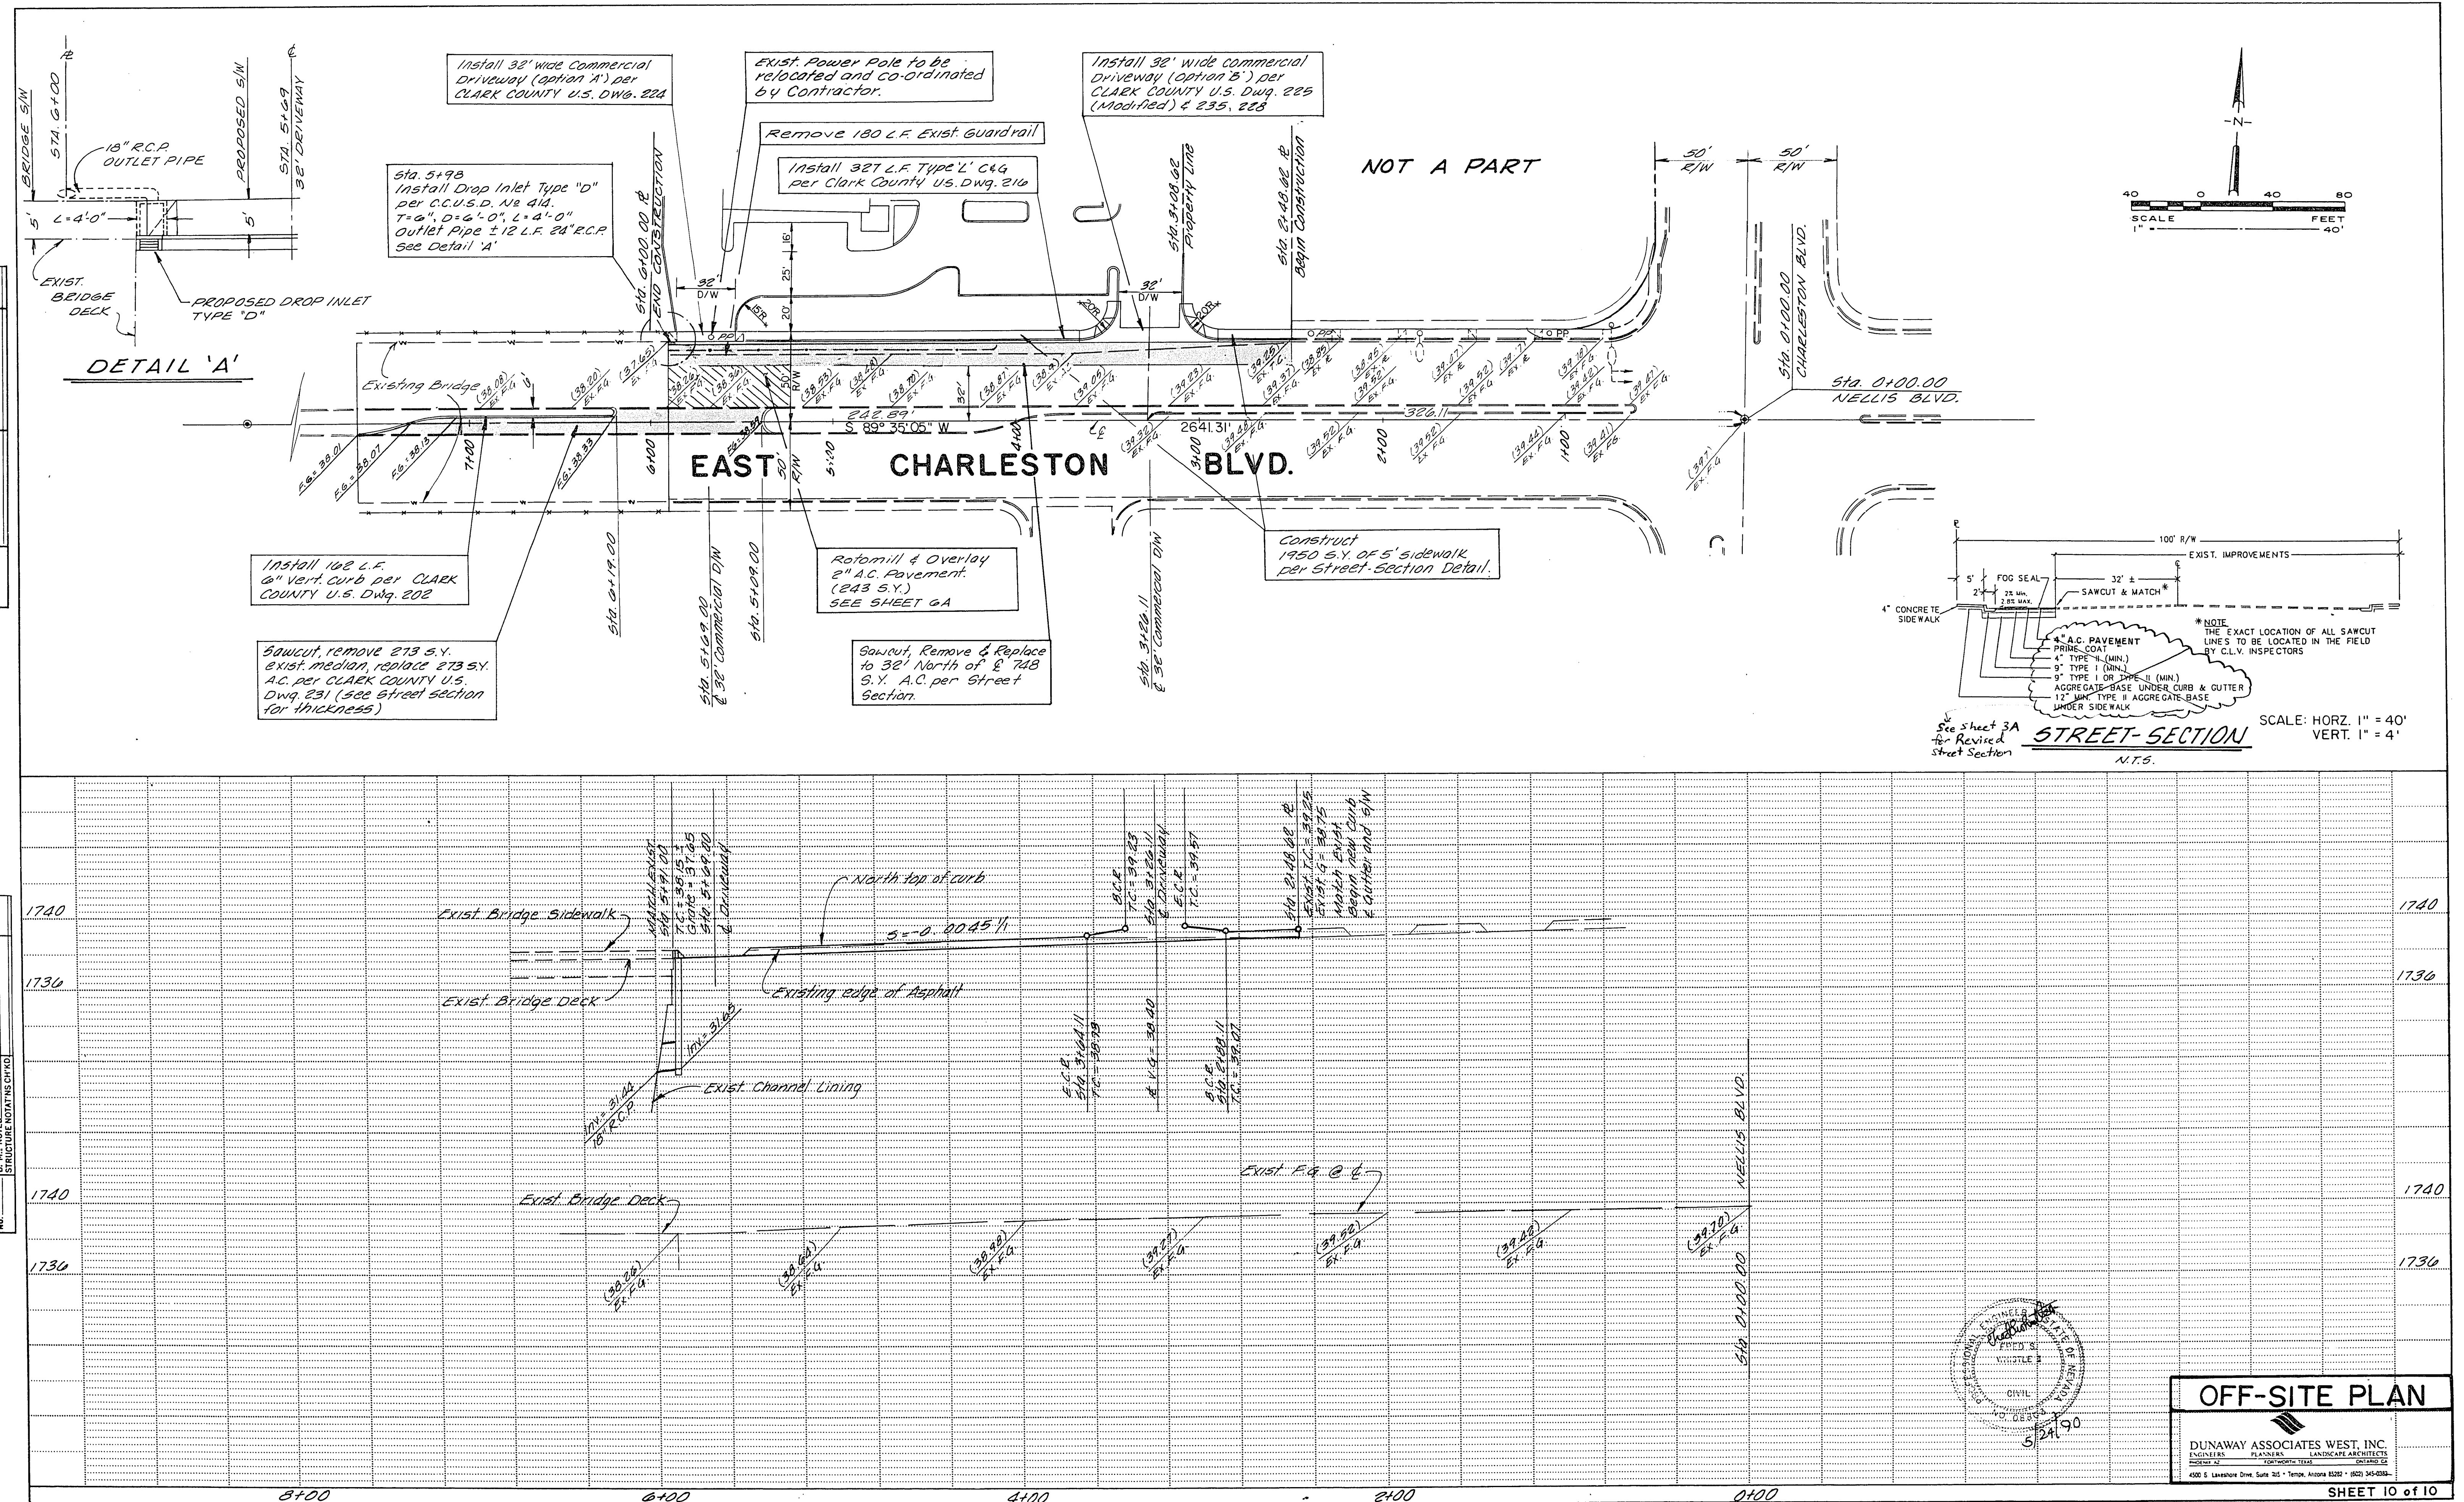

HIGHWAY FEDERAL AID SHEET
 PLATE I-SINGLE PLAN AND PROFILE-FULL DOT
 TITLE BLOCK
 PRINTED IN U.S.A.

107V1796
 22-3-54