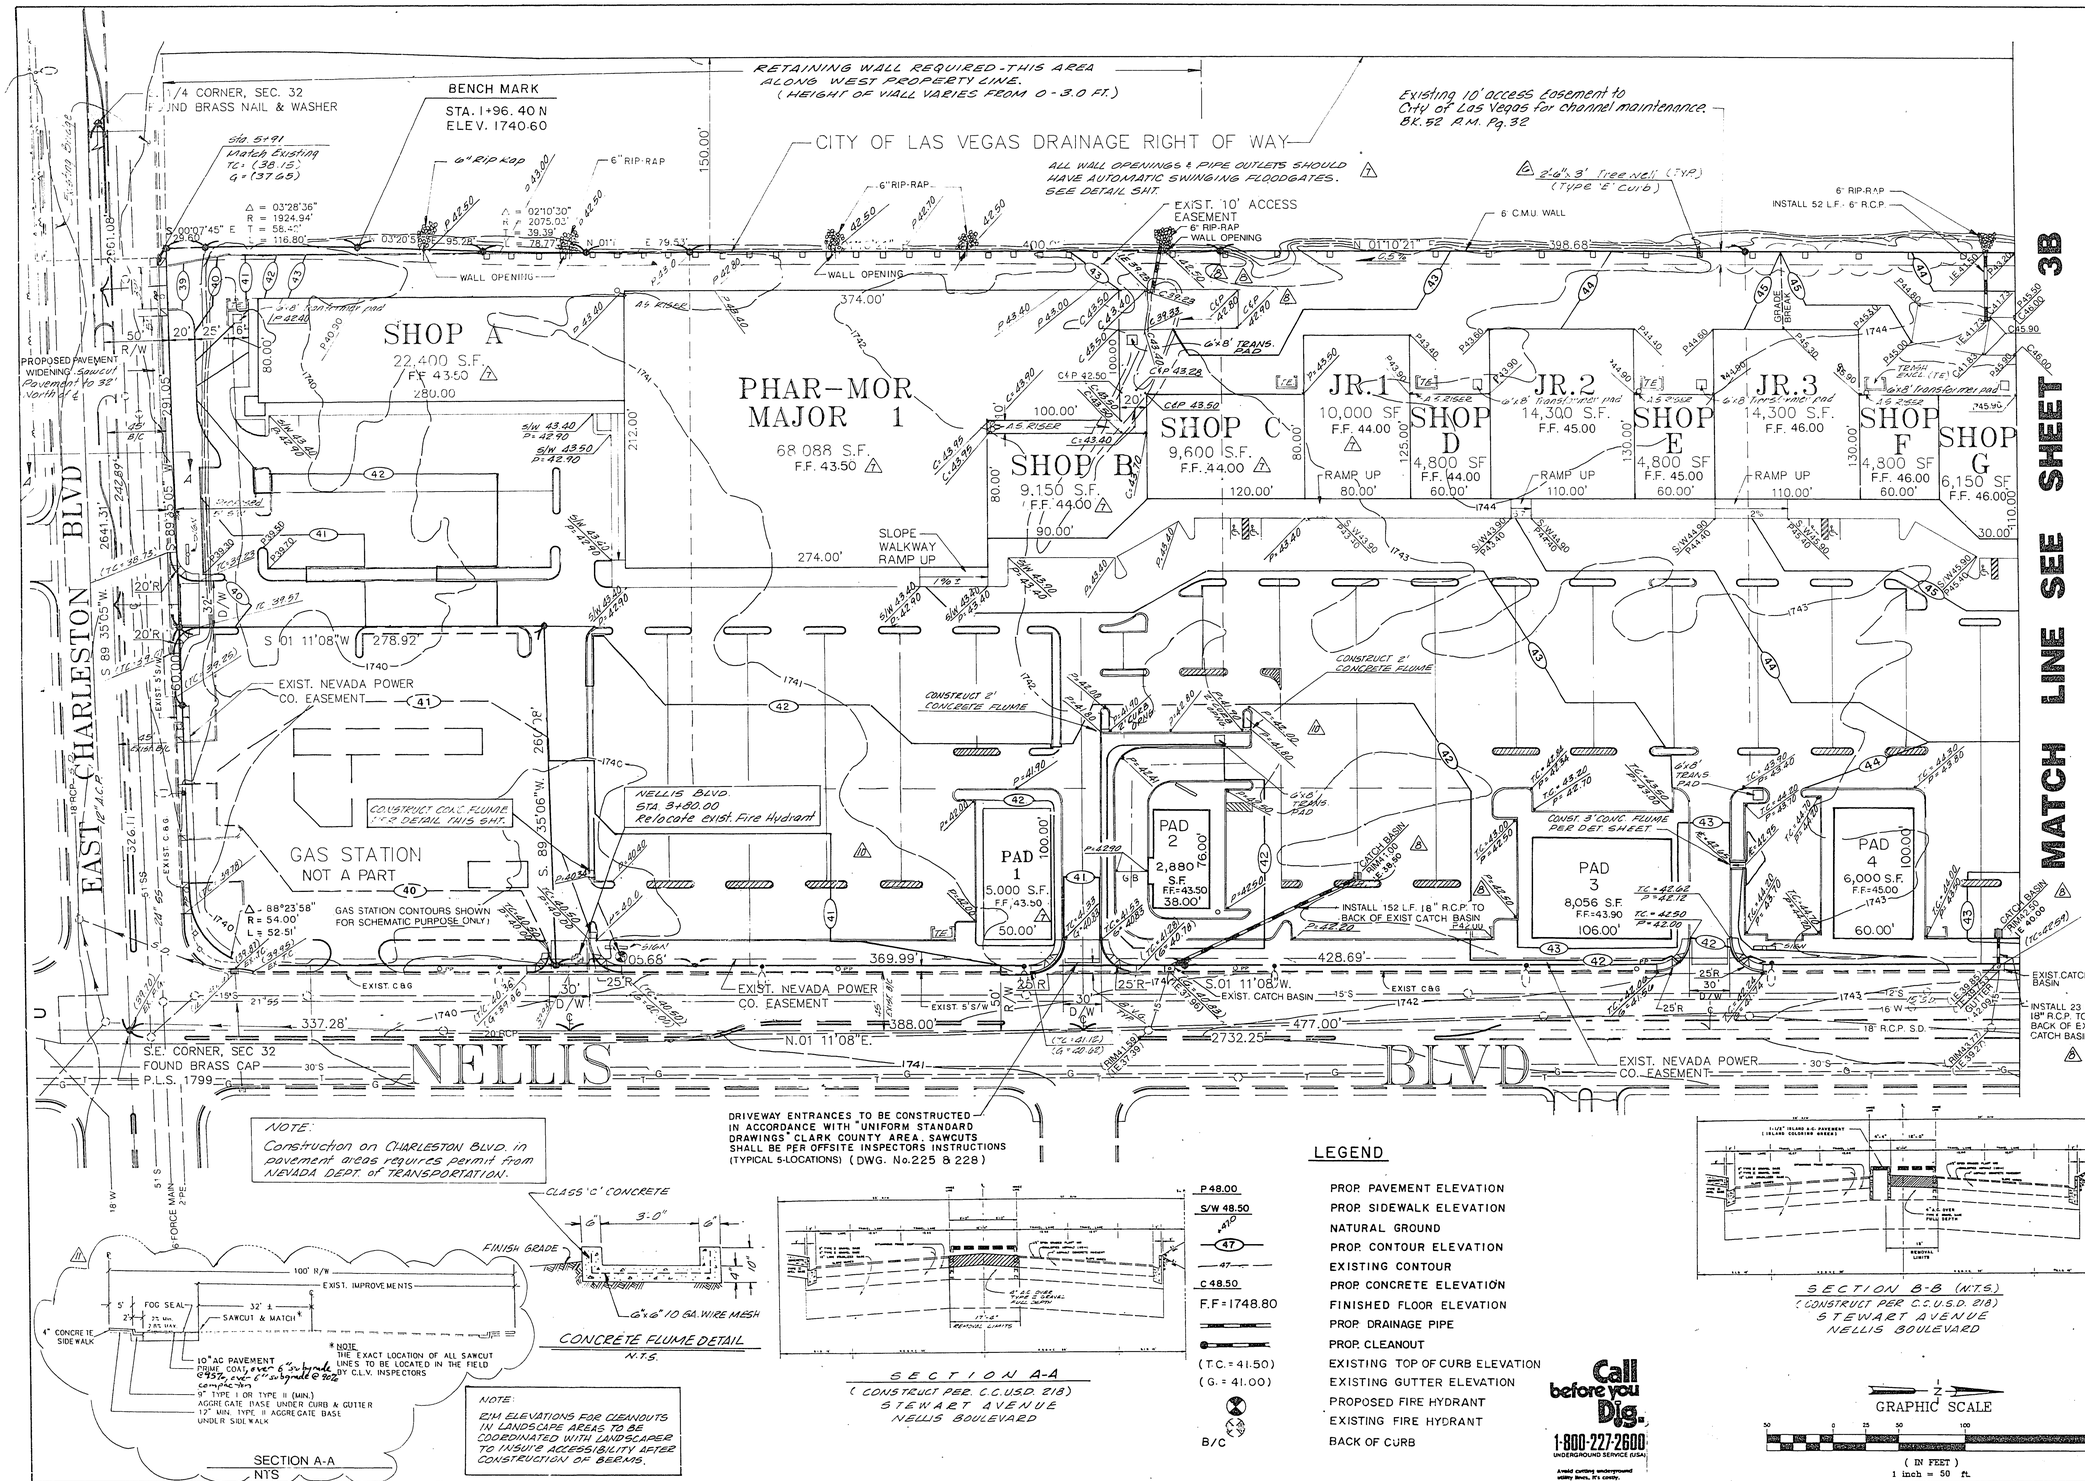

NO.	DATE	REVISION DESCRIPTION
1	2-7-90	REVISED PER NEW S-C SITE PLAN
2	4-6-90	ADDED TREEWELLS
3	5-11-90	REVISED TO REVISE FINISH FLOORS
4	5-30-90	REVISED ELEV. & PIPE SIZE
5	6-11-90	PADS & EXIST. BLDG. GRADING REV.
6	7-18-90	REVISED PAVEMENT DETAIL

Jack Robertson 5/21/90

SHEET TITLE: GRADING PLAN

PROJECT TITLE: CHARLESTON COMMONS
NELLIS AND CHARLESTON

DUNAWAY ASSOCIATES WEST INC
ENGINEERS LANDSCAPE ARCHITECTS PLANNERS
PHOENIX, AZ · FORT WORTH, TX · ONTARIO, CA
4500 S. LAKESHORE DRIVE
SUITE 215
TEMPE, ARIZONA 85282
(602) 345-0383 FAX (602) 491-2581

JOB NO. 8921900
DESIGN BY: P.L.N.
CHECKED BY: F.S.W.
DATE: APR 90
SCALE: 1" = 50'
SHEET 3A OF 10 SHEETS

23-3-44 107V1796