



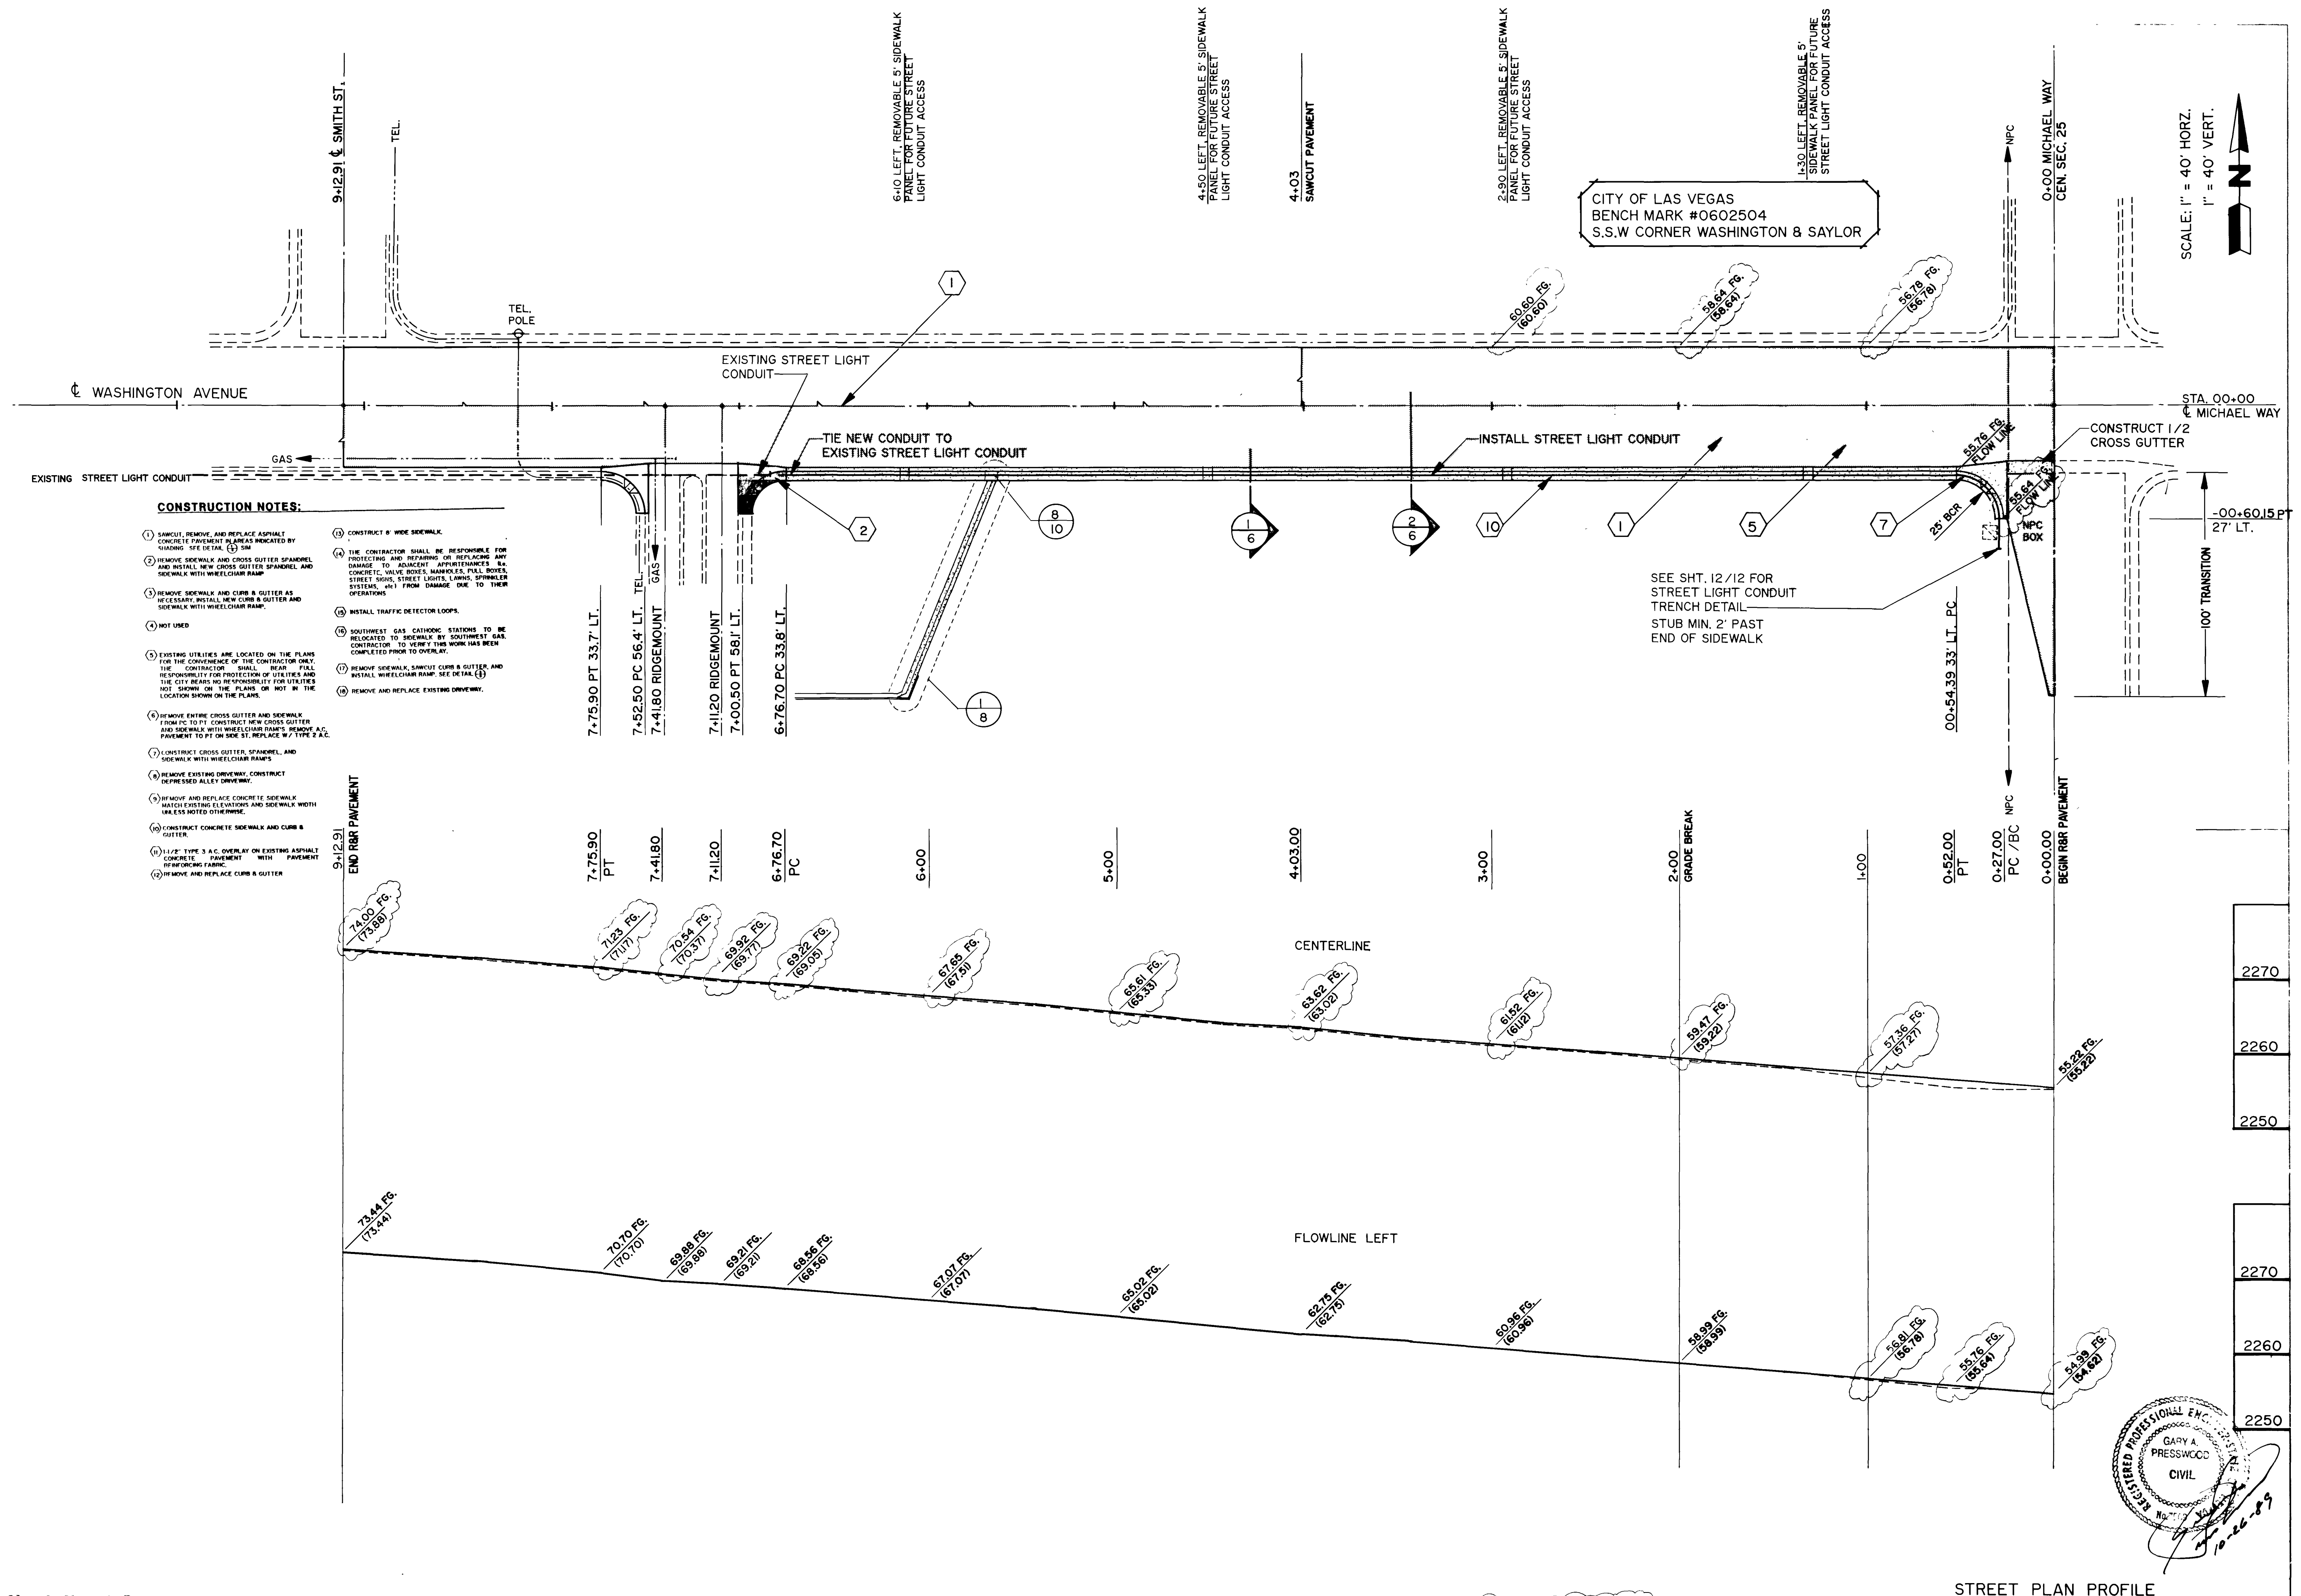

REVISD 21 FEB. 1990

13-3-52

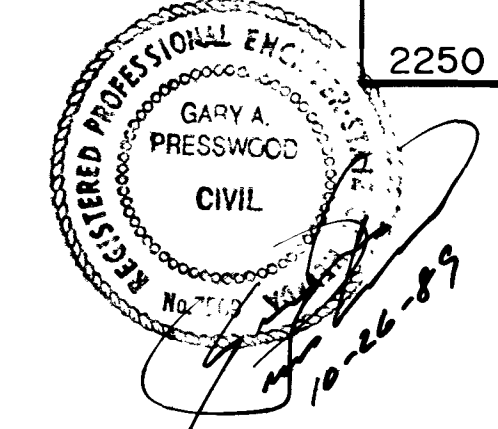

1988-1989 STREET REHABILITATION PROJECT WASHINGTON AVENUE, LORENZO BLVD. TO RANCHO DR.

