


UNIMPROVED AREA (UNIMP. ST.): (LOCATION OF TRENCH)
ANY OTHER SCENARIO THAT FAILS TO MEET THE IMPROVED AREA CRITERIA(s) WILL BE
CONSIDERED AN UNIMPROVED AREA.



1000

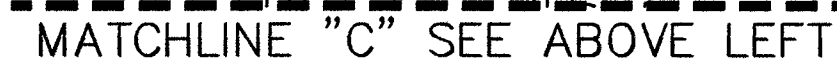

INSTALL R-36

- ### DISCLAIMER NOTE

AVOID CUTTING UNDERGROUND UTILITY LINES. IT'S COSTLY. CALL  BEFORE YOU DIG OR 1-800-227-2600 UNDERGROUND SERVICE (USA)	AVOID OVERHEAD POWER LINE CONTACT CALL BEFORE YOU OVERHEAD 1-702-227-2929 NEVADA POWER ENVIRONMENT AND SAFETY SERVICE DEPARTMENT
---	--




[illegible]


APPROVED FOR CONSTRUCTION

THIS APPROVAL IS FOR WORK IN CLV R/W OR CLV EASEMENT ONLY. OBTAINING PERMISSION OR EASEMENT FOR WORK SHOWN IN PRIVATE PROPERTY IS THE RESPONSIBILITY OF THE UTILITY.

[illegible][illegible]

SHEET 2 OF 4

TrueNet# 11190

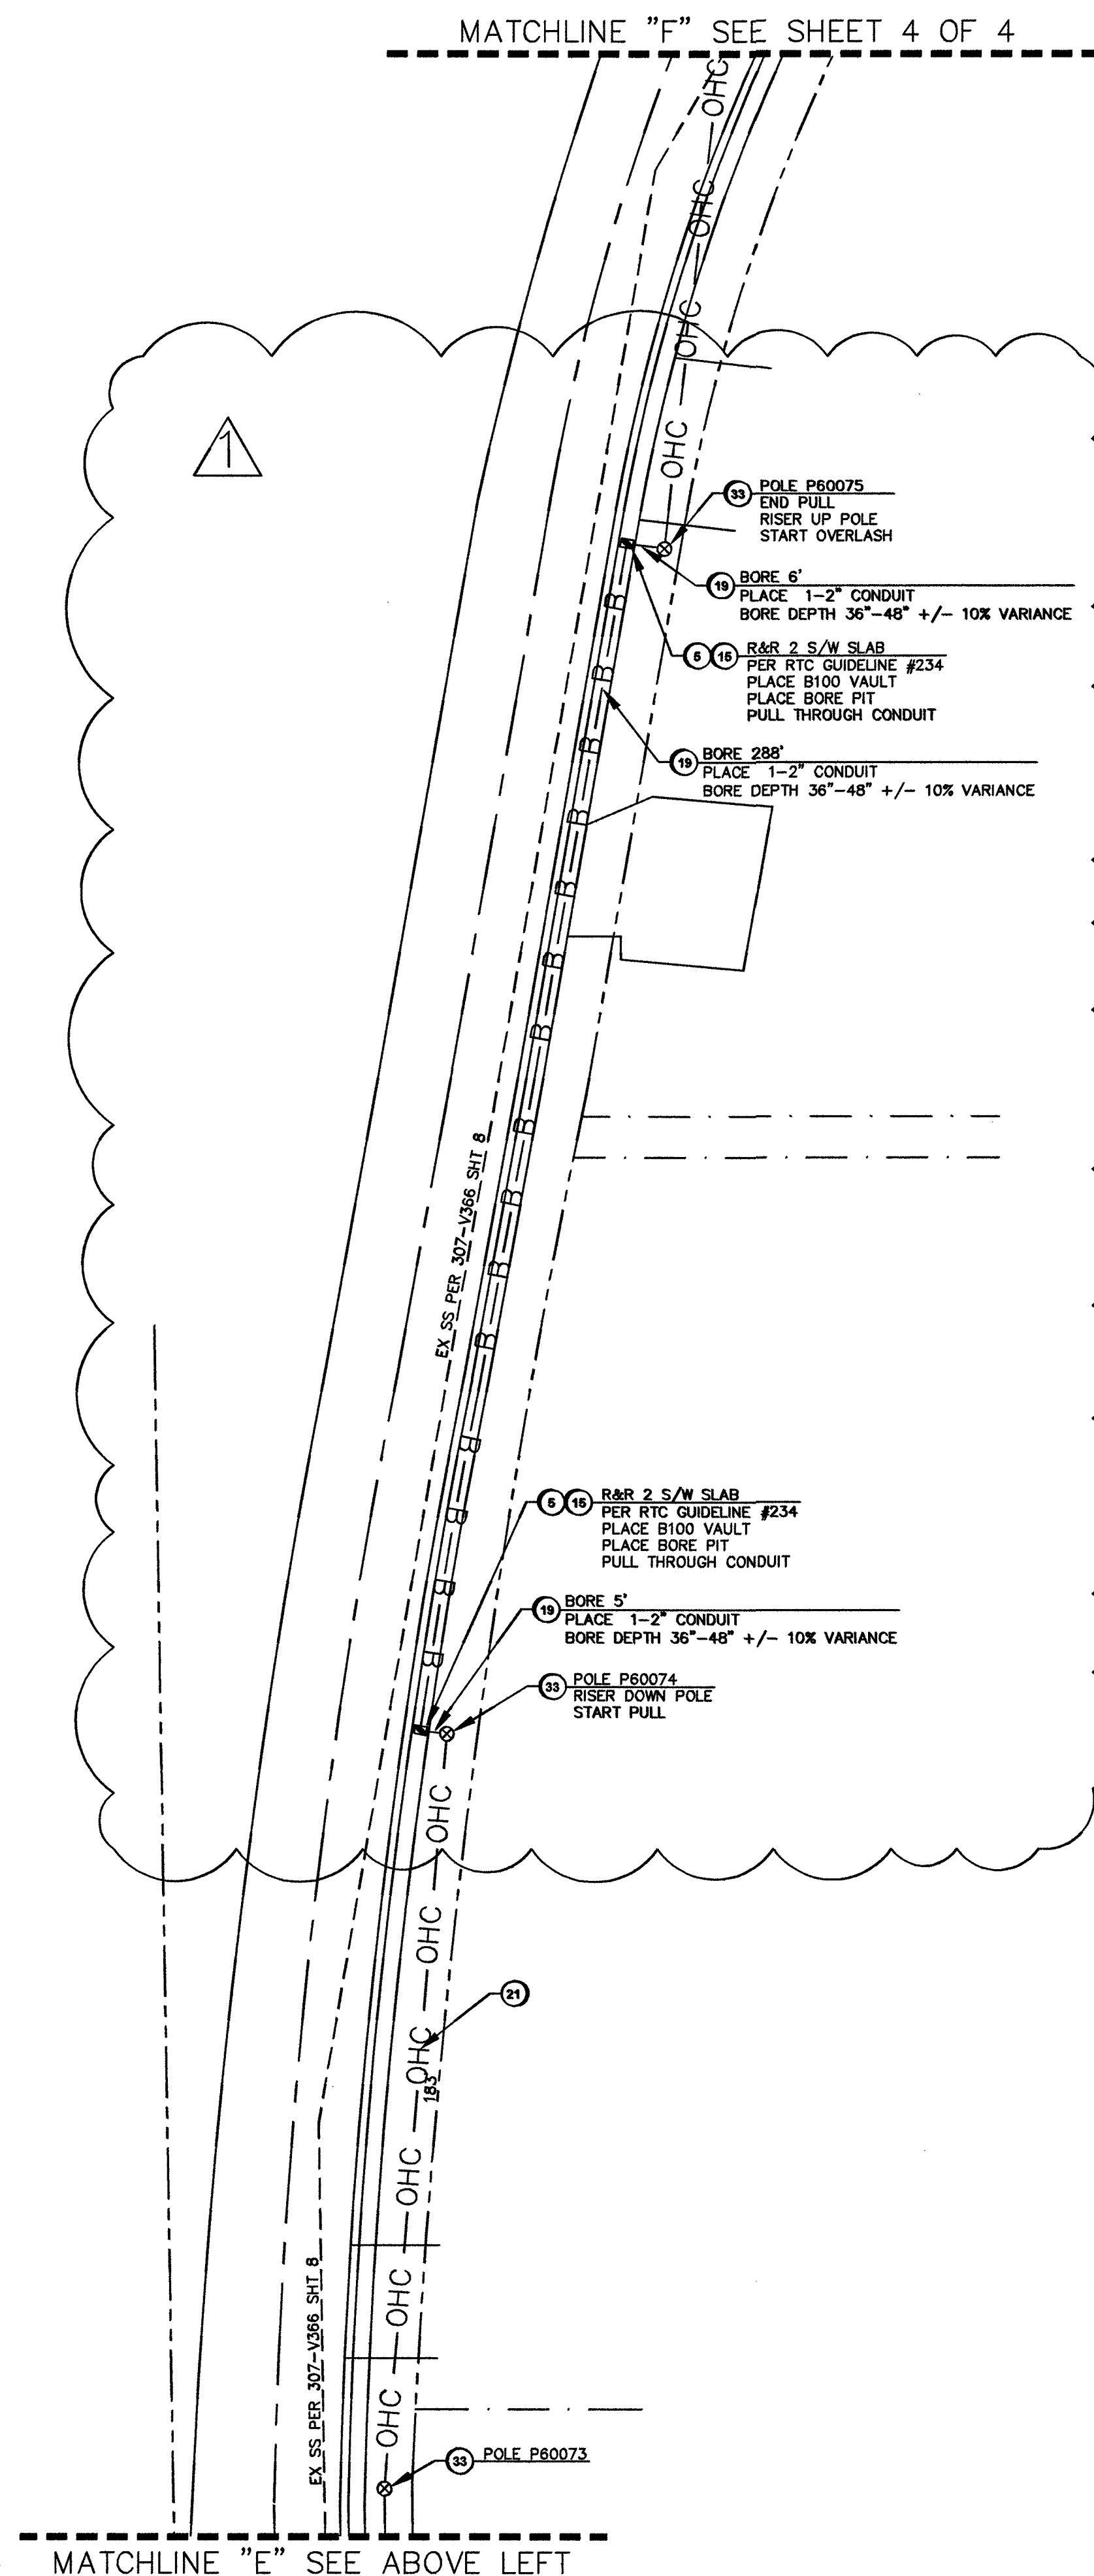

LEGEND	
1	INSTALL B-36 PULL BOX (24"x36"x24")
2	EXISTING B-36 PULL BOX (24"x36"x24")
3	INSTALL B-50 PULL BOX (13"x24"x24")
4	EXISTING B-50 PULL BOX (13"x24"x24")
5	INSTALL B-100 PULL BOX (24"x36"x24")
6	EXISTING B-100 PULL BOX (24"x36"x24")
7	INSTALL T-200 CATV VAULT (30"x48"x36")
8	EXISTING T-200 CATV VAULT (30"x48"x36")
9	INSTALL T-400 CATV VAULT (36"x60"x36")
10	EXISTING T-400 CATV VAULT (36"x60"x36")
11	INSTALL T-600 CATV VAULT (48"x72"x36")
12	EXISTING T-600 CATV VAULT (48"x72"x36")
13	INSTALL NEW CATV PEDESTAL
14	EXISTING NEW CATV PEDESTAL
15	R&R S/W SLAB(S)
16	POTHOLE
17	----- SIDEWALK/DIRT TRENCH INSTALL
18	----- ASPHALT/STREET TRENCH INSTALL
19	---B--- PROPOSED BORE
20	-x-x- EXISTING CATV CONDUIT(S)
21	---OHC--- PROPOSED OVERHEAD FIBER OPTIC CABLE OR COAX INSTALL
22	---XOHC--- EXISTING OVERHEAD FIBER OPTIC CABLE OR COAX
23	--- U.G. FIBER/COAX PULL
24	----- RIGHT OF WAY LINE
25	----- LOT/PROPERTY LINE
26	 EDGE OF PAVEMENT
27	P EXISTING NVE PULL BOX
28	T EXISTING TELCO PULL BOX
29	TM EXISTING TELCO MANHOLE
30	T EXISTING TELCO POLE
31	EXISTING NVE POLE
32	NVE EXISTING NVE TRANSMISSION POLE
33	EXISTING JOINT POLE
34	EXISTING JOINT POLE WITH TRANSFORMER
35	POLE ANCHOR
36	EXISTING NVE TRANSFORMER TRANSFORMER PAD
37	TS SNWA TEST STATION
38	COX POWER SUPPLY (49"x24"x52")
39	RC INSTALL RHINO CABINET
40	RISER POLE/QUADRANT DETAIL RISER OWNERSHIP NOTED
41	RAILROAD
42	MF EXISTING MANHOLE (SS),(SD)..., ECT
43	----- 1in CONDUIT LATERAL
44	
45	

DISCLAIMER NOTE

UTILITY LOCATIONS SHOWN HEREON ARE APPROXIMATE ONLY. IT SHALL BE THE CONTRACTOR'S RESPONSIBILITY TO DETERMINE THE EXACT HORIZONTAL AND VERTICAL LOCATION OF ALL EXISTING UNDERGROUND AND OVERHEAD UTILITIES PRIOR TO COMMENCING CONSTRUCTION. NO REPRESENTATION IS MADE THAT ALL EXISTING UTILITIES ARE SHOWN HEREON. THE ENGINEER ASSUMES NO RESPONSIBILITY FOR UTILITIES NOT SHOWN OR UTILITIES NOT SHOWN IN THEIR PROPER LOCATIONS.

**AVOID CUTTING UNDERGROUND
UTILITY LINES. IT'S COSTLY.**

**CALL
811**



**BEFORE YOU DIG
OR 1-800-227-2600
UNDERGROUND SERVICE (USA)**

**AVOID HITTING UNDERGROUND
TRAFFIC SIGNAL SYSTEMS AND
STREET LIGHT SYSTEMS. IT'S COSTLY!**

**CALL BEFORE
YOU DO
UNDERGROUND**

**BEFORE YOU
UNDERGROUND**

1-702-455-7511

**CLARK COUNTY TRAFFIC OPERATIONS
AND
1-702-432-5300**

LAS VEGAS AREA COMPUTERIZED SYSTEM




**AVOID OVERHEAD POWER
LINE CONTACT**

**CALL
BEFORE YOU
OVERHEAD**

1-702-227-2929
**NEVADA POWER ENVIRONMENT AND
SAFETY SERVICE DEPARTMENT**

TOTAL BORE	609'
TOTAL DIRT TRENCH	0'
TOTAL ASPHALT TRENCH	49'
TOTAL TRENCH	49'
<u>SIDEWALK REMOVAL/REPAIR</u>	
TOTAL S/W PANELS	11
TOTAL LINEAR FOOTAGE	55'

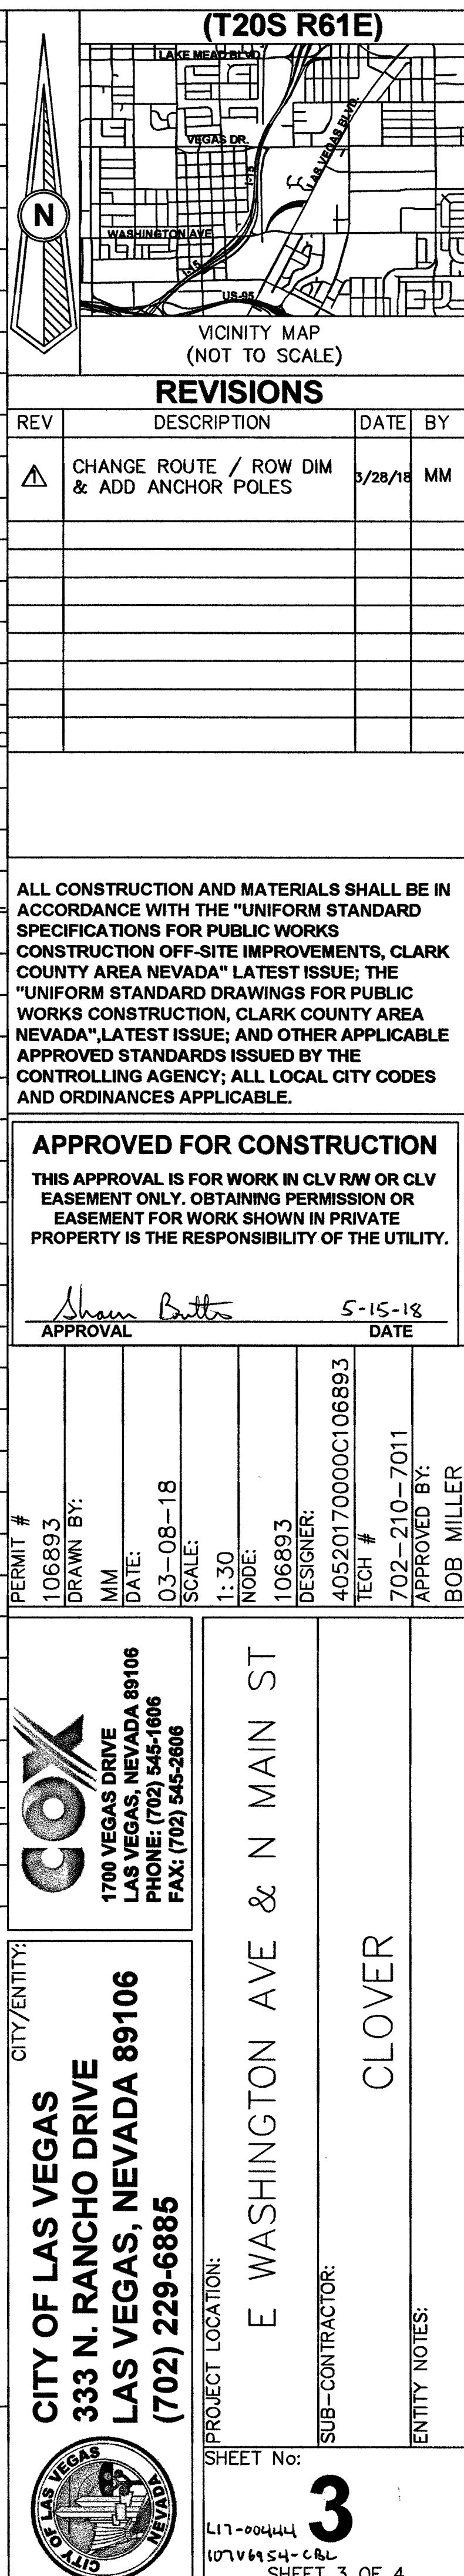



W OWENS AVE
(PUBLIC)

TOTAL BORE	609'
TOTAL DIRT TRENCH	0'
TOTAL ASPHALT TRENCH	49'
TOTAL TRENCH	49'
<u>SIDEWALK REMOVAL/REPAIR</u>	
TOTAL S/W PANELS	11
TOTAL LINEAR FOOTAGE	55'

