



MATCHLINE "A" SEE BELOW RIGHT

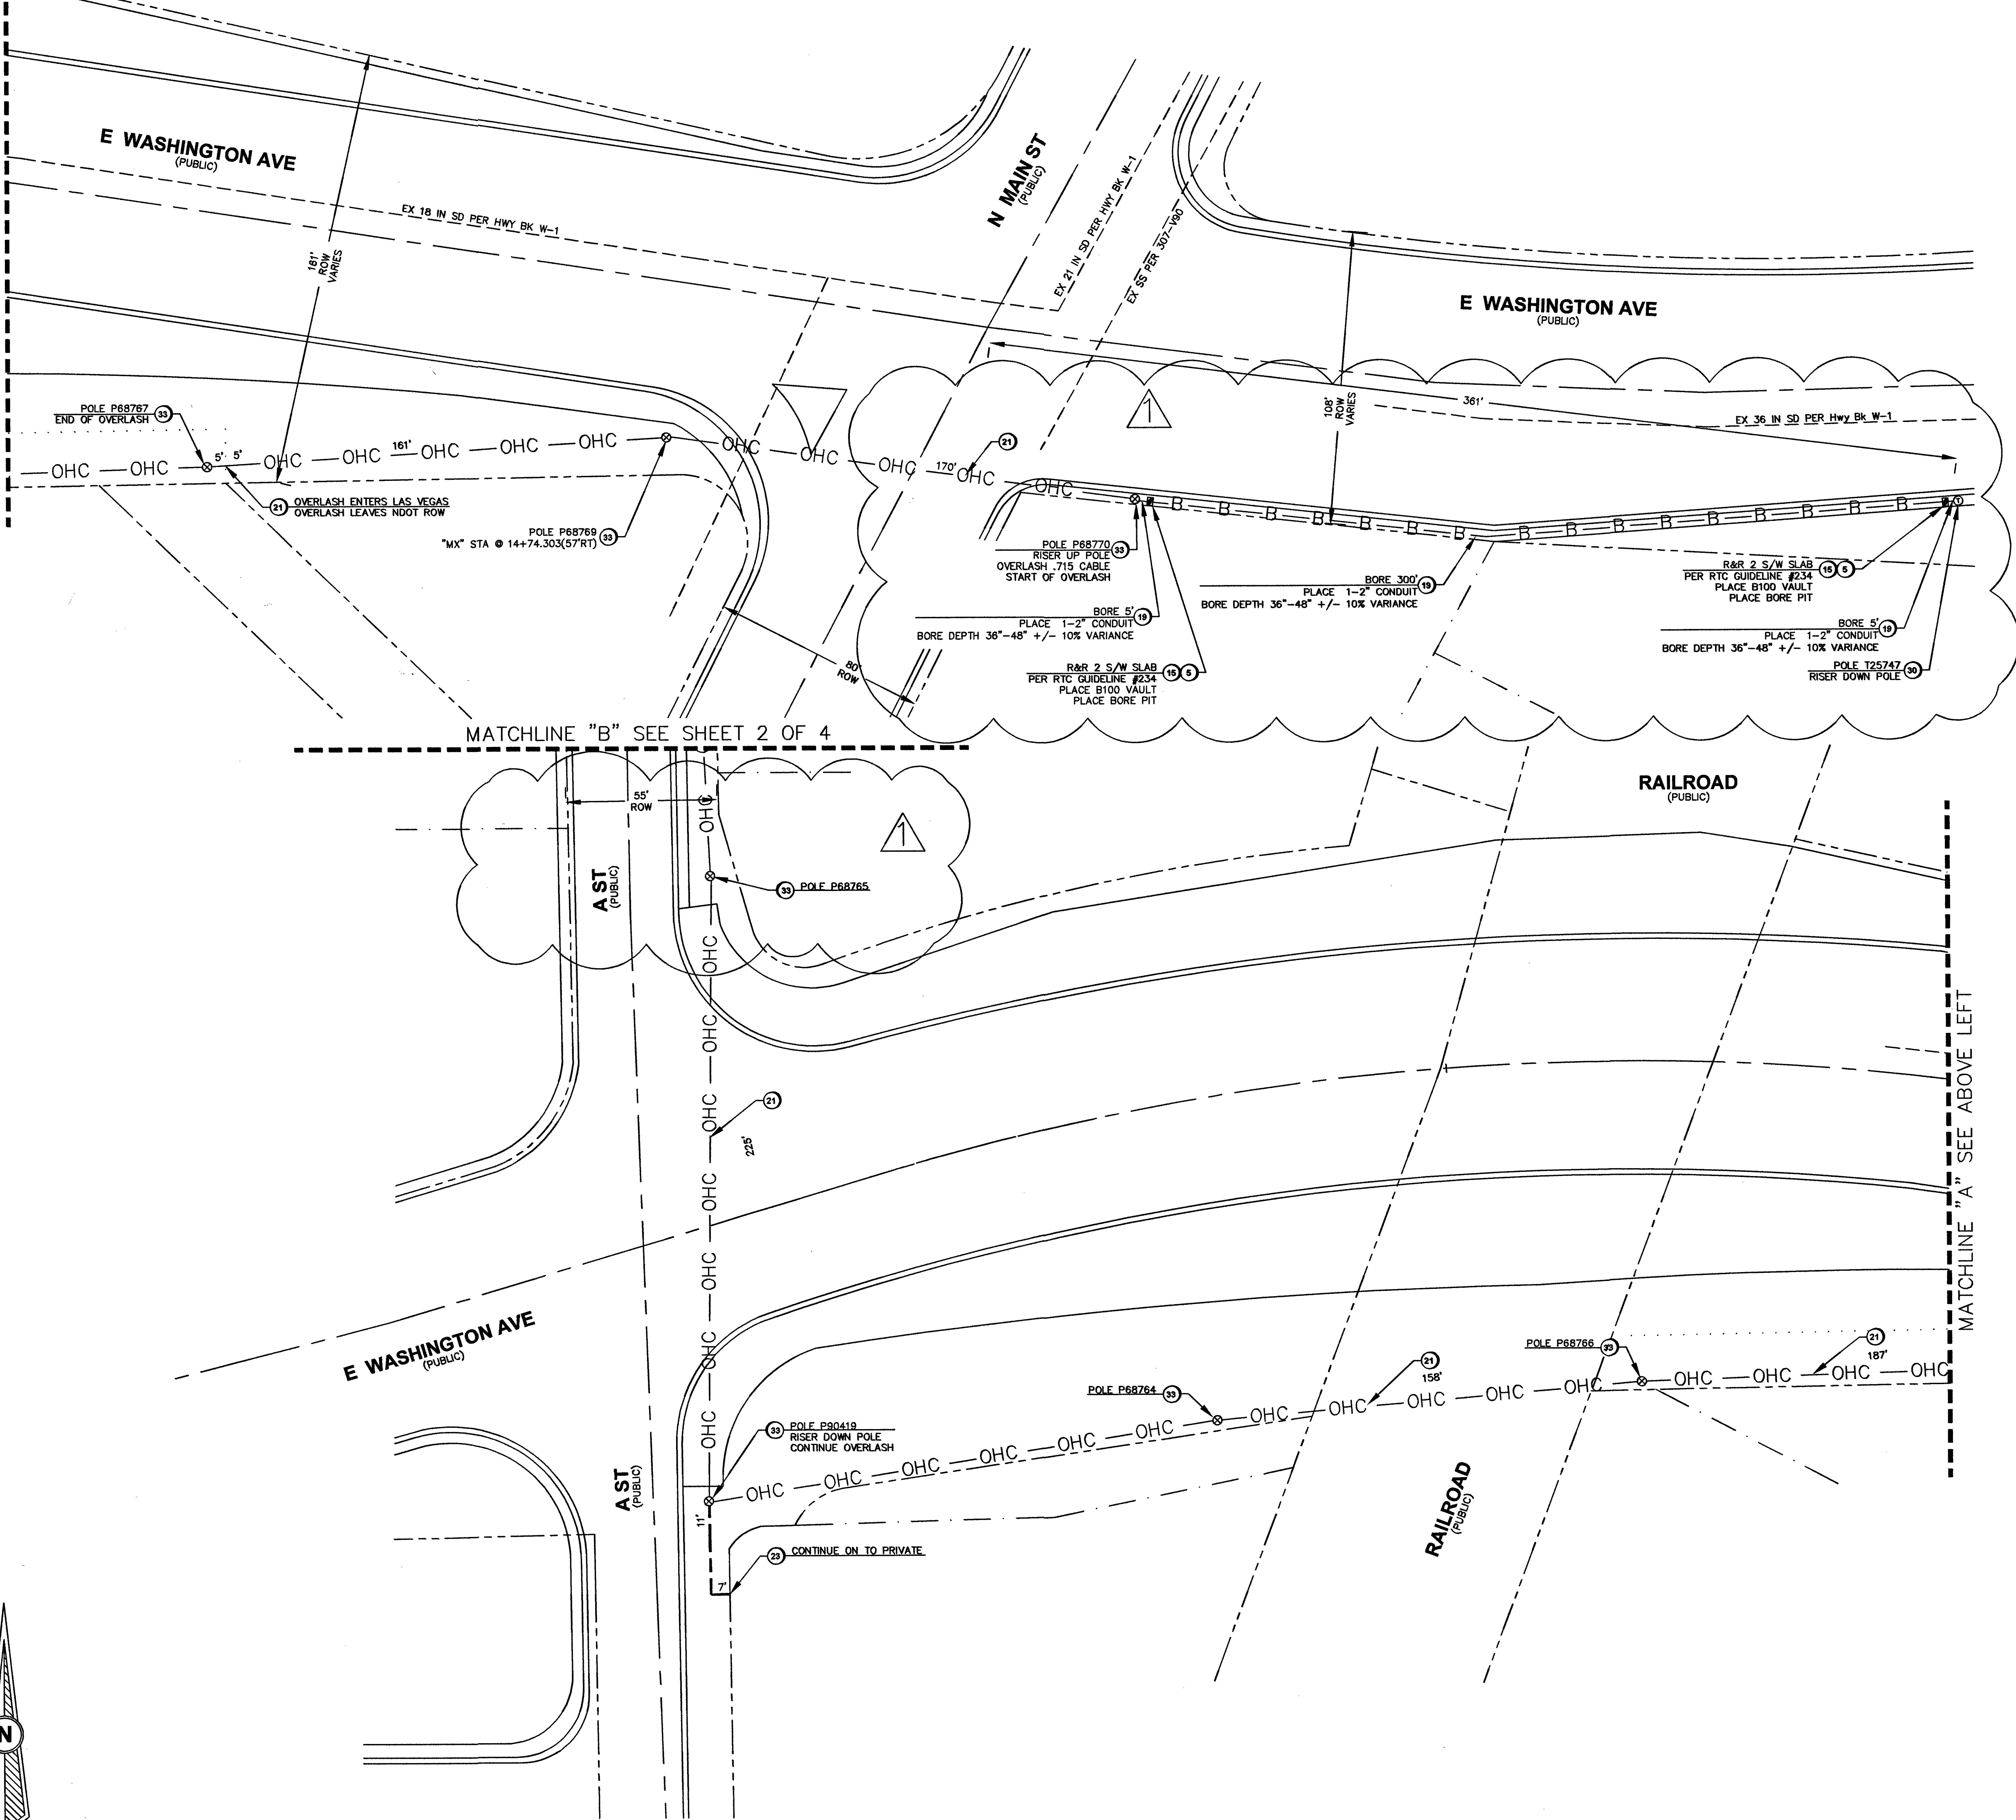

LEGEND	
1	INSTALL B-36 PULL BOX (24"x36"x24")
2	EXISTING B-36 PULL BOX (24"x36"x24")
3	INSTALL B-50 PULL BOX (13"x24"x24")
4	EXISTING B-50 PULL BOX (13"x24"x24")
5	INSTALL B-100 PULL BOX (24"x36"x24")
6	EXISTING B-100 PULL BOX (24"x36"x24")
7	INSTALL T-200 CATV VAULT (30"x48"x36")
8	EXISTING T-200 CATV VAULT (30"x48"x36")
9	INSTALL T-400 CATV VAULT (36"x60"x36")
10	EXISTING T-400 CATV VAULT (36"x60"x36")
11	INSTALL T-600 CATV VAULT (48"x72"x36")
12	EXISTING T-600 CATV VAULT (48"x72"x36")
13	INSTALL NEW CATV PEDESTAL
14	EXISTING NEW CATV PEDESTAL
15	R&R S/W SLAB(S)
16	POTHOLE
17	— — — — — SIDEWALK/DIRT TRENCH INSTALL
18	— — — — — ASPHALT/STREET TRENCH INSTALL
19	— — — — — PROPOSED BORE
20	— x — — — — EXISTING CATV CONDUIT(S)
21	— OHC — — — — PROPOSED OVERHEAD FIBER OPTIC CABLE OR COAX INSTALL
22	— XOHC — — — — EXISTING OVERHEAD FIBER OPTIC CABLE OR COAX
23	— — — — — U.G. FIBER/COAX PULL
24	— — — — — RIGHT OF WAY LINE
25	— — — — — LOT/PROPERTY LINE
26	— — — — — EDGE OF PAVEMENT
27	[P] EXISTING NVE PULL BOX
28	[T] EXISTING TELCO PULL BOX
29	[TM] EXISTING TELCO MANHOLE
30	[T] EXISTING TELCO POLE
31	[NVE] EXISTING NVE POLE
32	[NVE] EXISTING NVE TRANSMISSION POLE
33	[X] EXISTING JOINT POLE
34	[X] EXISTING JOINT POLE WITH TRANSFORMER
35	[A] POLE ANCHOR
36	[NVE] EXISTING NVE TRANSFORMER TRANSFORMER PAD
37	[TS] SNWA TEST STATION
38	[CPS] COX POWER SUPPLY (49"x24"x52")
39	[RC] INSTALL RHINO CABINET
40	[R] RISER POLE/QUADRANT DETAIL RISER OWNERSHIP NOTED
41	[RR] RAILROAD
42	[MH] EXISTING MANHOLE (SS),(SD)...ECT
43	— — — — — 1in CONDUIT LATERAL
44	
45	

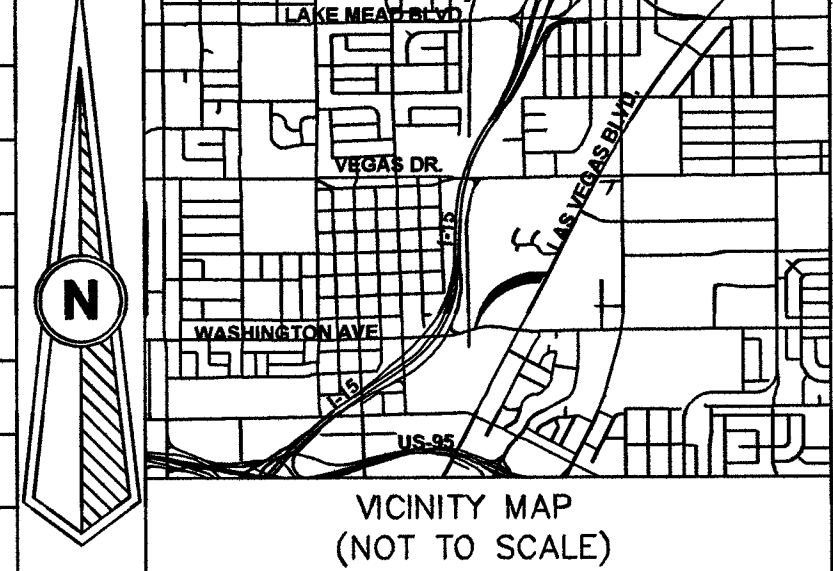

REVISIONS			
REV	DESCRIPTION	DATE	BY
1	CHANGE ROUTE / ROW DIM & ADD ANCHOR POLES	3/28/18	MM

ALL CONSTRUCTION AND MATERIALS SHALL BE IN ACCORDANCE WITH THE "UNIFORM STANDARD SPECIFICATIONS FOR PUBLIC WORKS CONSTRUCTION OFF-STATE IMPROVEMENTS, CLARK COUNTY AREA NEVADA" LATEST ISSUE; THE "UNIFORM STANDARD DRAWINGS FOR PUBLIC WORKS CONSTRUCTION, CLARK COUNTY AREA NEVADA" LATEST ISSUE; AND OTHER APPLICABLE APPROVED STANDARDS ISSUED BY THE CONTROLLING AGENCY; ALL LOCAL CITY CODES AND ORDINANCES APPLICABLE.

APPROVED FOR CONSTRUCTION
THIS APPROVAL IS FOR WORK IN CLV RW OR CLV EASEMENT ONLY. OBTAINING PERMISSION OR EASEMENT FOR WORK SHOWN IN PRIVATE PROPERTY IS THE RESPONSIBILITY OF THE UTILITY.

APPROVAL: *Shawn Butler* DATE: 5-15-18

PERMIT #	106893
DRAWN BY	MM
DATE	03-08-18
SCALE	1:30
NODE	106893
DESIGNER	40520170000C106893
TECH #	702-210-7011
APPROVED BY	BOB MILLER

COX
1700 VEGAS DRIVE
LAS VEGAS, NEVADA 89106
PHONE: (702) 545-1806
FAX: (702) 545-2806

DISCLAIMER NOTE
UTILITY LOCATIONS SHOWN HEREON ARE APPROXIMATE ONLY. IT SHALL BE THE CONTRACTOR'S RESPONSIBILITY TO DETERMINE THE EXACT HORIZONTAL AND VERTICAL LOCATION OF ALL EXISTING UNDERGROUND AND OVERHEAD UTILITIES PRIOR TO COMMENCING CONSTRUCTION. NO REPRESENTATION IS MADE THAT ALL EXISTING UTILITIES ARE SHOWN HEREON. THE ENGINEER ASSUMES NO RESPONSIBILITY FOR UTILITIES NOT SHOWN OR UTILITIES NOT SHOWN IN THEIR PROPER LOCATIONS.

CALL BEFORE YOU DIG
OR 1-800-227-2600
UNDERGROUND SERVICE (USA)

CALL BEFORE YOU OVERHEAD
1-702-227-2929
NEVADA POWER ENVIRONMENT AND SAFETY SERVICE DEPARTMENT


TOTAL BORE	609'
TOTAL DIRT TRENCH	0'
TOTAL ASPHALT TRENCH	49'
TOTAL TRENCH	49'
SIDEWALK REMOVAL/REPAIR	
TOTAL S/W PANELS	11
TOTAL LINEAR FOOTAGE	55'

CITY OF LAS VEGAS
333 N. RANCHO DRIVE
LAS VEGAS, NEVADA 89106
(702) 229-6885


CITY/ENTITY:
PROJECT LOCATION: E WASHINGTON AVE & N MAIN ST
SUB-CONTRACTOR: CLOVER
ENTITY NOTES:

SHEET No:
1
SHEET 1 OF 4


MATCHLINE "D" SEE SHEET 3 OF 4

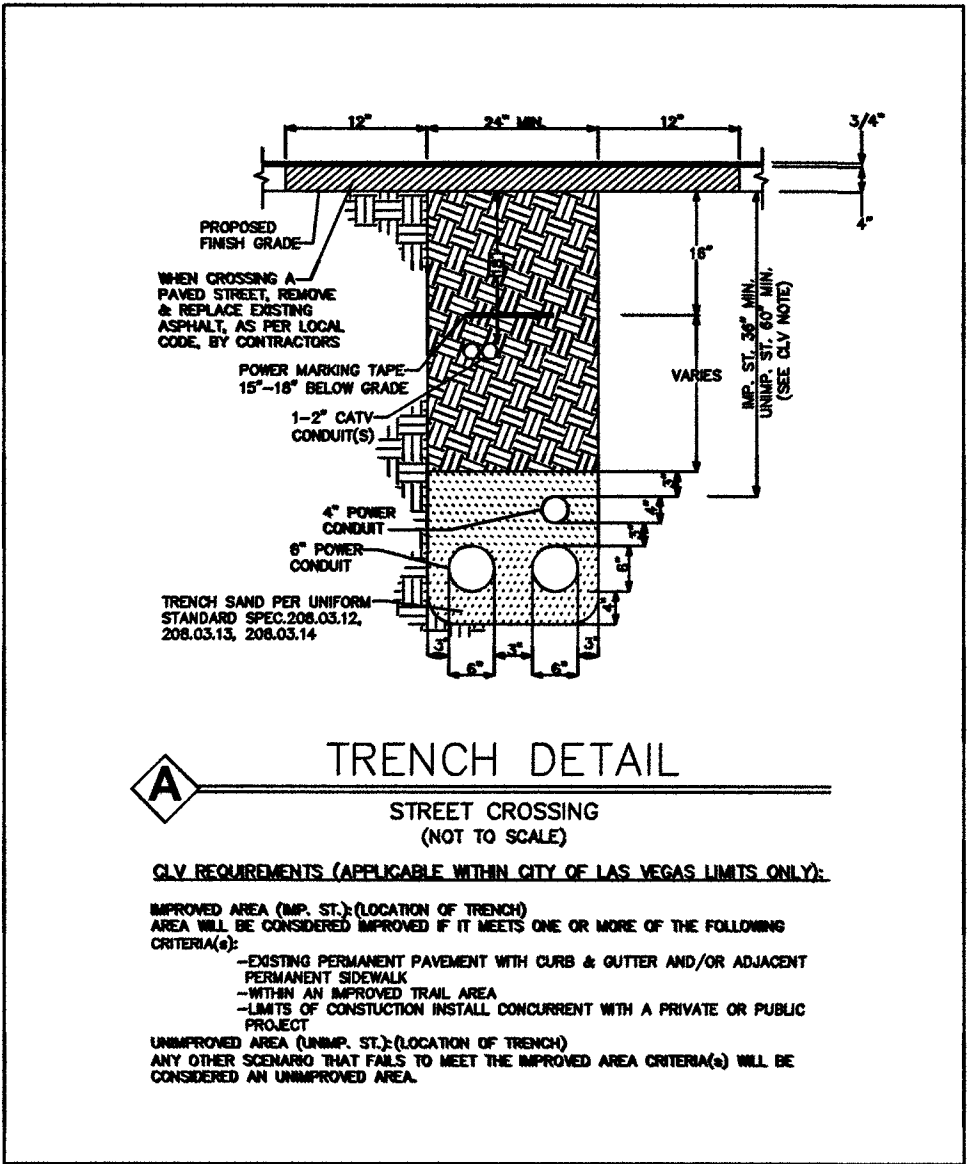

MATCHLINE "C" SEE BELOW RIGHT

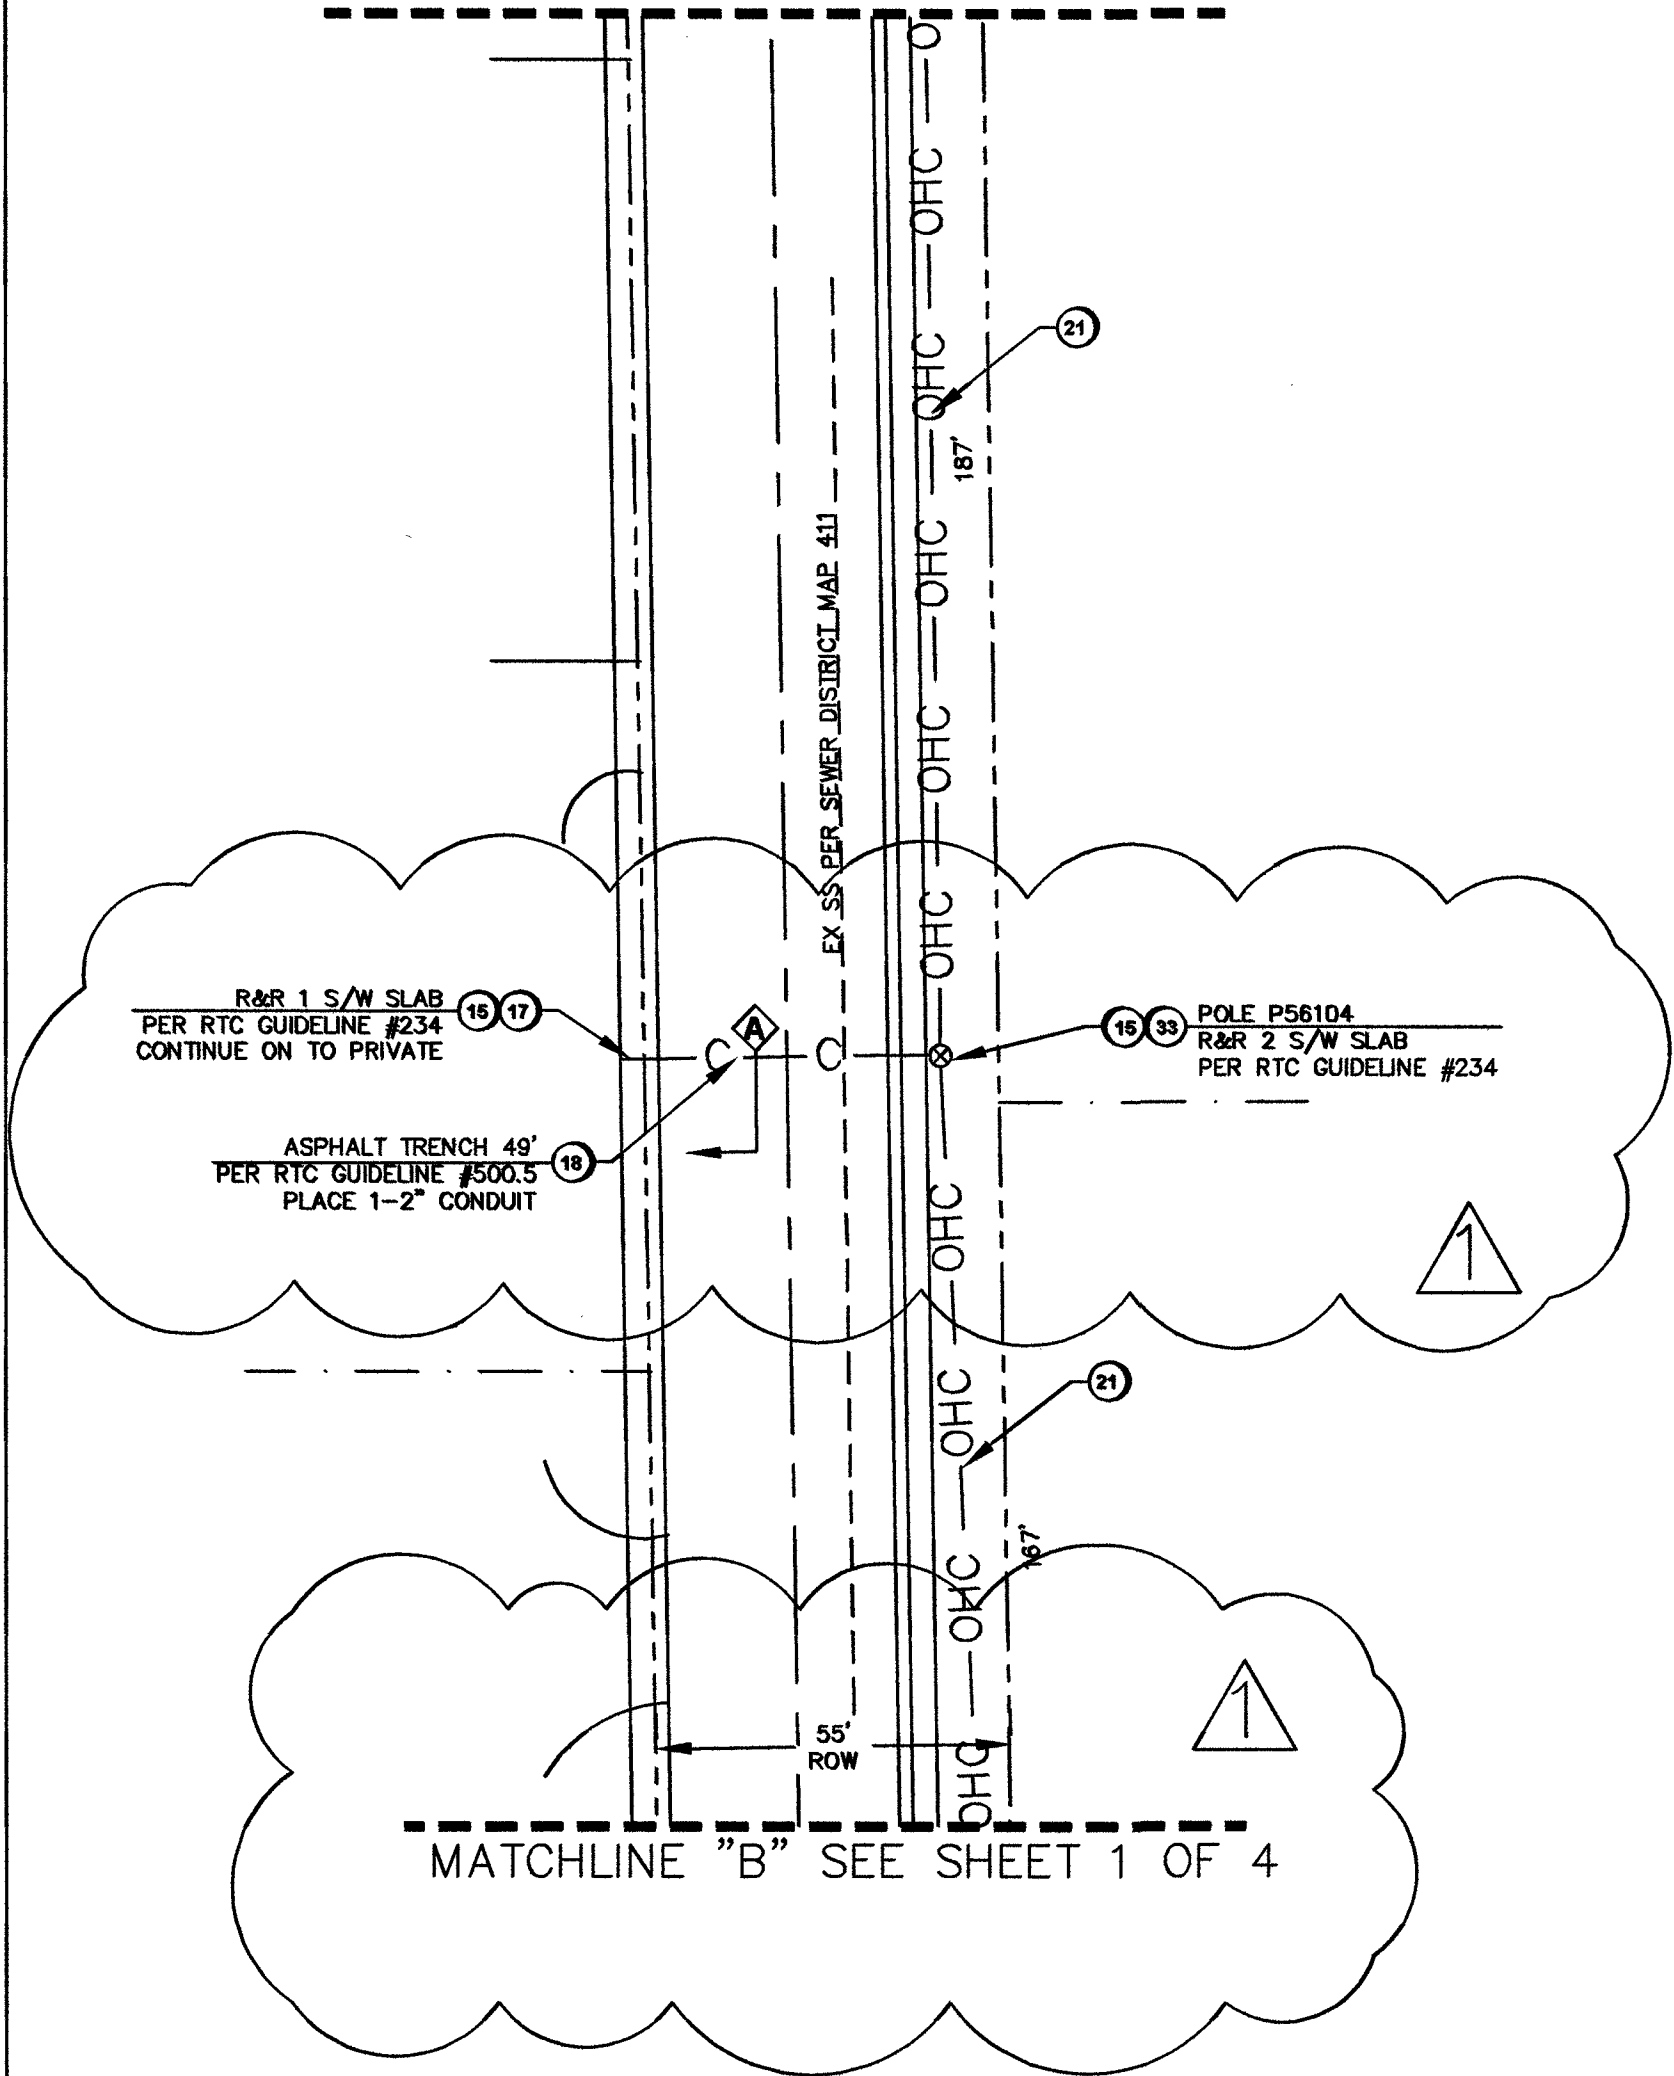

N 115
(PUBLIC)

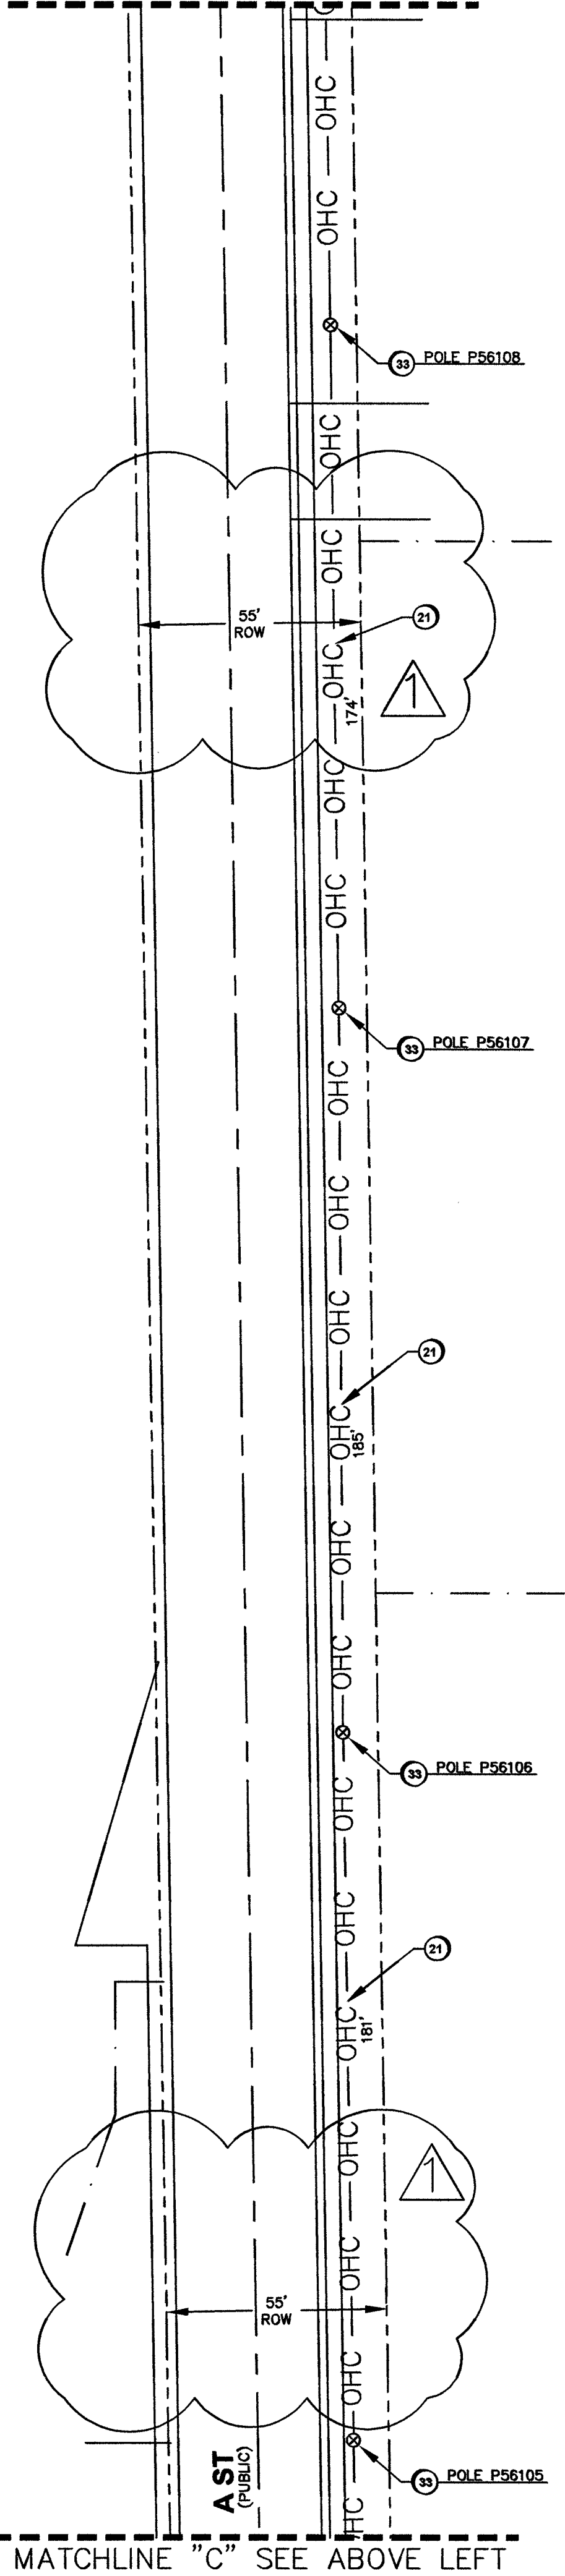

LEGEND

1. INSTALL B-36 PULL BOX (24"x36"x24")
2. EXISTING B-36 PULL BOX (24"x36"x24")
3. INSTALL B-50 PULL BOX (13"x24"x24")
4. EXISTING B-50 PULL BOX (13"x24"x24")
5. INSTALL B-100 PULL BOX (24"x36"x24")
6. EXISTING B-100 PULL BOX (24"x36"x24")
7. INSTALL T-200 CATV VAULT (30"x48"x36")
8. EXISTING T-200 CATV VAULT (30"x48"x36")
9. INSTALL T-400 CATV VAULT (36"x60"x36")
10. EXISTING T-400 CATV VAULT (36"x60"x36")
11. INSTALL T-600 CATV VAULT (48"x72"x36")
12. EXISTING T-600 CATV VAULT (48"x72"x36")
13. INSTALL NEW CATV PEDESTAL
14. EXISTING NEW CATV PEDESTAL
15. R&R S/W SLAB(S)
16. POT HOLE
17. C-C-C-SIDEWALK/DIRT TRENCH INSTALL
18. C-C-C- ASPHALT/STREET TRENCH INSTALL
19. B-B- PROPOSED BORE
20. X-X- EXISTING CATV CONDUIT(S)
21. OHC- PROPOSED OVERHEAD FIBER OPTIC CABLE OR COAX INSTALL
22. XOHC- EXISTING OVERHEAD FIBER OPTIC CABLE OR COAX
23. --- U.G. FIBER/COAX PULL
24. --- RIGHT OF WAY LINE
25. --- LOT/PROPERTY LINE
26. EDGE OF PAVEMENT
27. P- EXISTING NVE PULL BOX
28. T- EXISTING TELCO PULL BOX
29. TM- EXISTING TELCO MANHOLE
30. T- EXISTING TELCO POLE
31. NVE- EXISTING NVE POLE
32. NVE- EXISTING NVE TRANSMISSION POLE
33. X- EXISTING JOINT POLE
34. X- EXISTING JOINT POLE WITH TRANSFORMER
35. POLE ANCHOR
36. EXISTING NVE TRANSFORMER TRANSFORMER PAD
37. TS- SNWA TEST STATION
38. COX POWER SUPPLY (49"x24"x52")
39. RG- INSTALL RHINO CABINET
40. RISER POLE/QUADRANT DETAIL RISER OWNERSHIP NOTED
41. RAILROAD
42. MH- EXISTING MANHOLE (SS),(SD)...ECT
43. --- 1in CONDUIT LATERAL
- 44.
- 45.

DISCLAIMER NOTE

UTILITY LOCATIONS SHOWN HEREON ARE APPROXIMATE ONLY. IT SHALL BE THE CONTRACTOR'S RESPONSIBILITY TO DETERMINE THE EXACT HORIZONTAL AND VERTICAL LOCATION OF ALL EXISTING UNDERGROUND AND OVERHEAD UTILITIES PRIOR TO COMMENCING CONSTRUCTION. NO REPRESENTATION IS MADE THAT ALL EXISTING UTILITIES ARE SHOWN HEREON. THE ENGINEER ASSUMES NO RESPONSIBILITY FOR UTILITIES NOT SHOWN OR UTILITIES NOT SHOWN IN THEIR PROPER LOCATIONS.

AVOID CUTTING UNDERGROUND UTILITY LINES. IT'S COSTLY.
CALL BEFORE YOU DIG
OR 1-800-227-2600
UNDERGROUND SERVICE (USA)

AVOID OVERHEAD POWER LINE CONTACT
CALL BEFORE YOU OVERHEAD
1-702-227-2929
NEVADA POWER ENVIRONMENT AND SAFETY SERVICE DEPARTMENT

TOTAL BORE 609'
TOTAL DIRT TRENCH 0'
TOTAL ASPHALT TRENCH 49'
TOTAL TRENCH 49'
SIDEWALK REMOVAL/REPAIR
TOTAL S/W PANELS 11
TOTAL LINEAR FOOTAGE 55'

(T20S R61E)

VICINITY MAP (NOT TO SCALE)

REVISIONS

REV	DESCRIPTION	DATE	BY
1	CHANGE ROUTE / ROW DIM & ADD ANCHOR POLES	3/28/18	MM

ALL CONSTRUCTION AND MATERIALS SHALL BE IN ACCORDANCE WITH THE "UNIFORM STANDARD SPECIFICATIONS FOR PUBLIC WORKS CONSTRUCTION OFF-SITE IMPROVEMENTS, CLARK COUNTY AREA NEVADA" LATEST ISSUE; THE "UNIFORM STANDARD DRAWINGS FOR PUBLIC WORKS CONSTRUCTION, CLARK COUNTY AREA NEVADA" LATEST ISSUE; AND OTHER APPLICABLE APPROVED STANDARDS ISSUED BY THE CONTROLLING AGENCY; ALL LOCAL CITY CODES AND ORDINANCES APPLICABLE.

APPROVED FOR CONSTRUCTION

THIS APPROVAL IS FOR WORK IN CLV R/W OR CLV EASEMENT ONLY. OBTAINING PERMISSION OR EASEMENT FOR WORK SHOWN IN PRIVATE PROPERTY IS THE RESPONSIBILITY OF THE UTILITY.

Approval: *Alan Butler* DATE: 5-15-18

PERMIT # 106893
DRAWN BY: MM
DATE: 03-08-18
SCALE: 1"=30'
NO. 106893
DESIGNER: 405201700000106893
TECH # 702-210-7011
APPROVED BY: BOB MILLER

COX
1700 VEGAS DRIVE
LAS VEGAS, NEVADA 89106
PHONE: (702) 545-1606
FAX: (702) 545-2806

CITY OF LAS VEGAS
333 N. RANCHO DRIVE
LAS VEGAS, NEVADA 89106
(702) 229-6886



PROJECT LOCATION: E WASHINGTON AVE & N MAIN ST

SUB-CONTRACTOR: CLOVER

ENTITY NOTES:

SHEET No: 2
417-00444
10746954-C&L
SHEET 2 OF 4

TrueNet# 11190

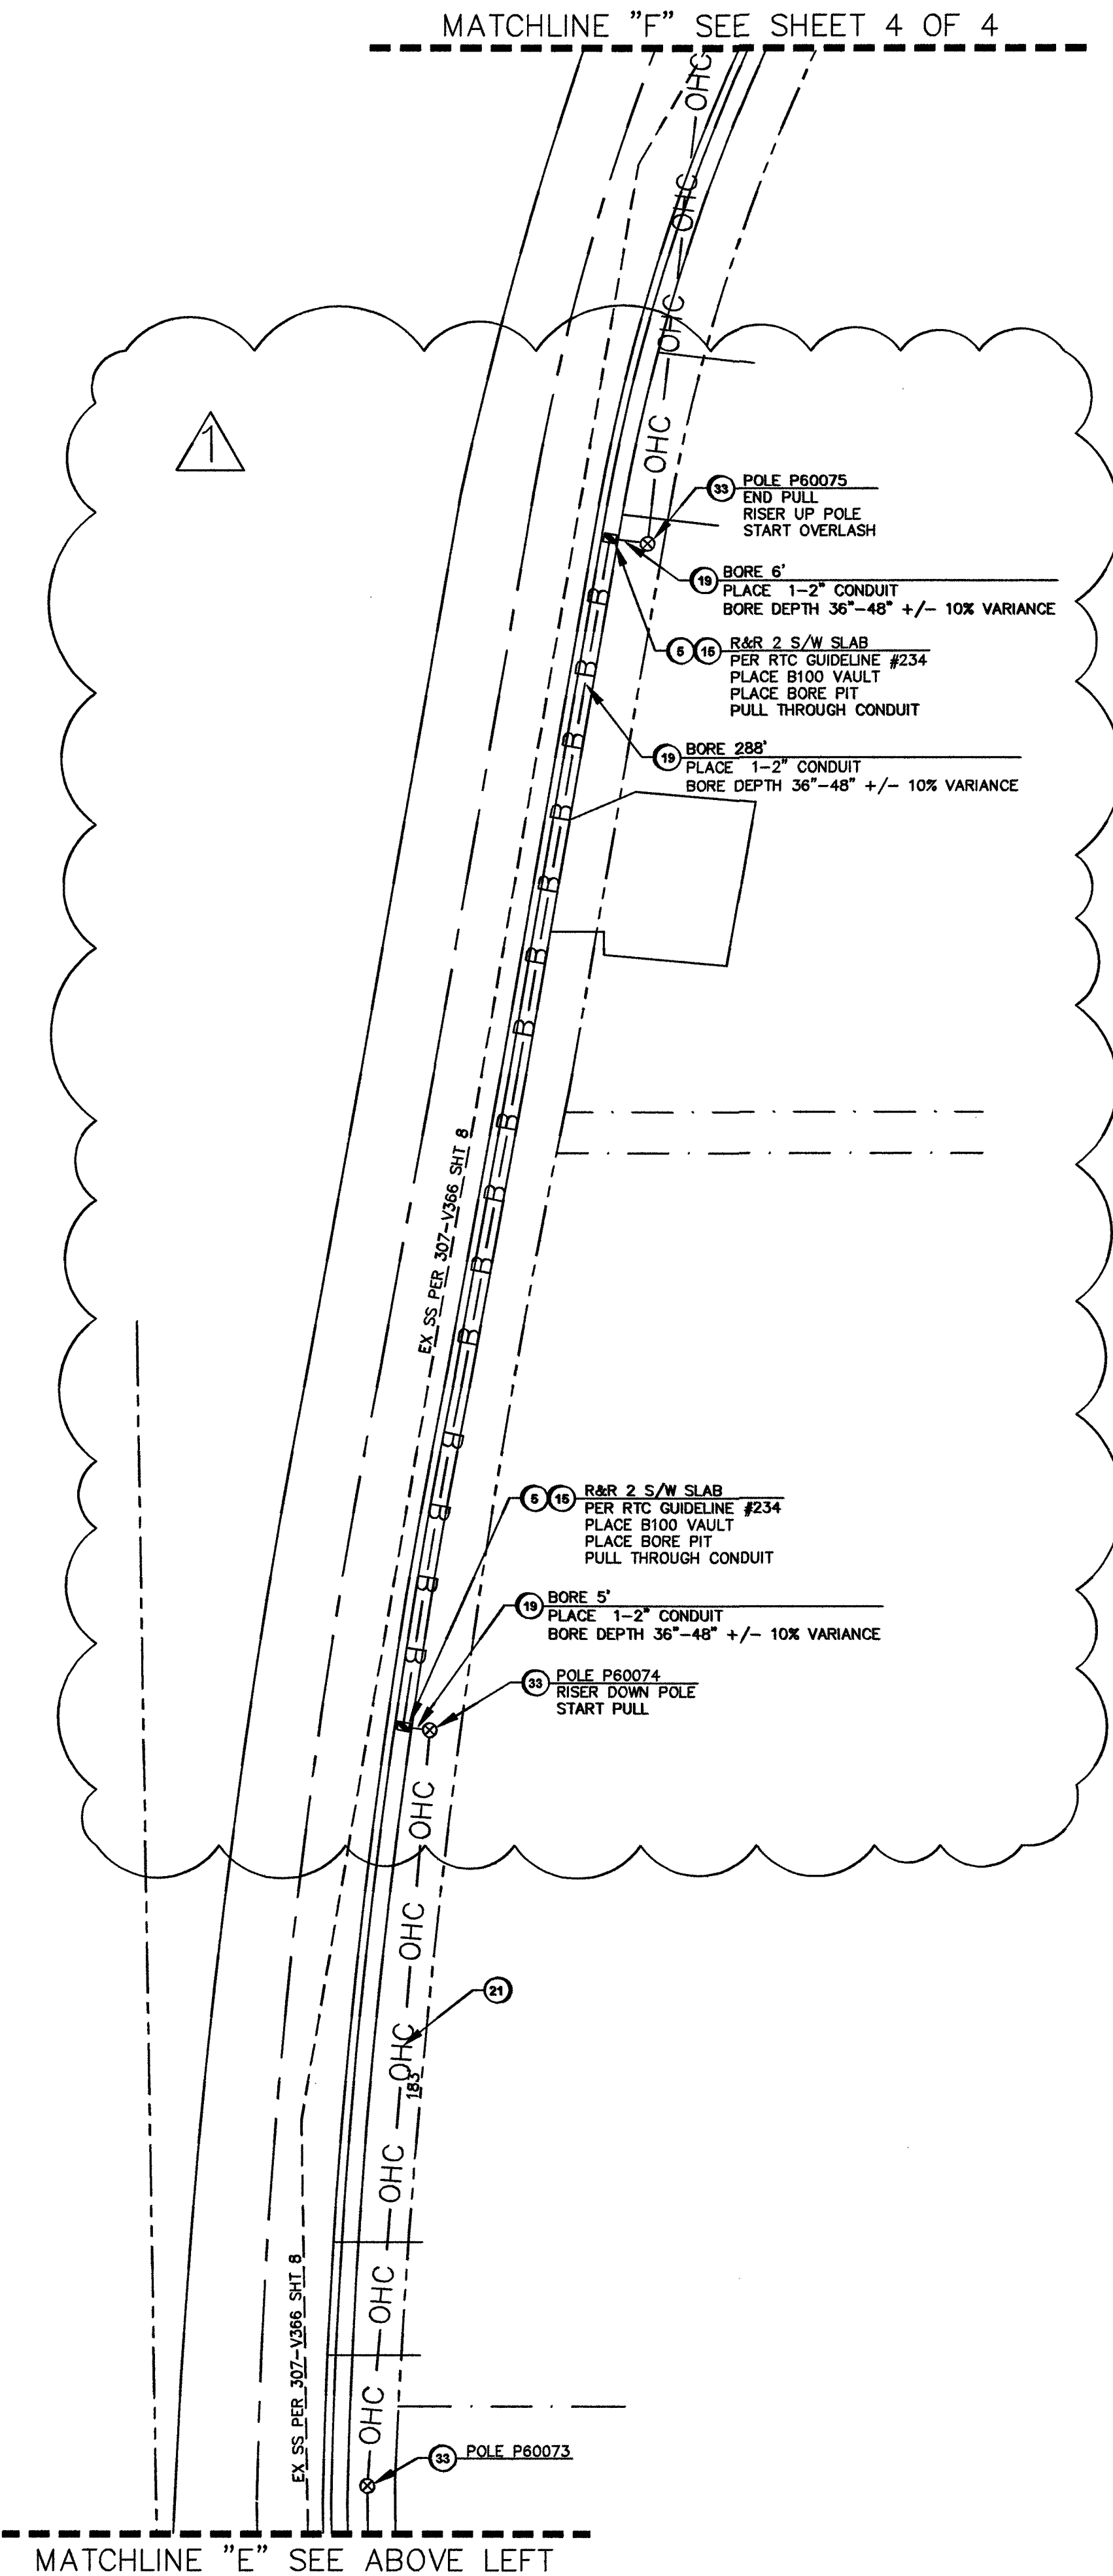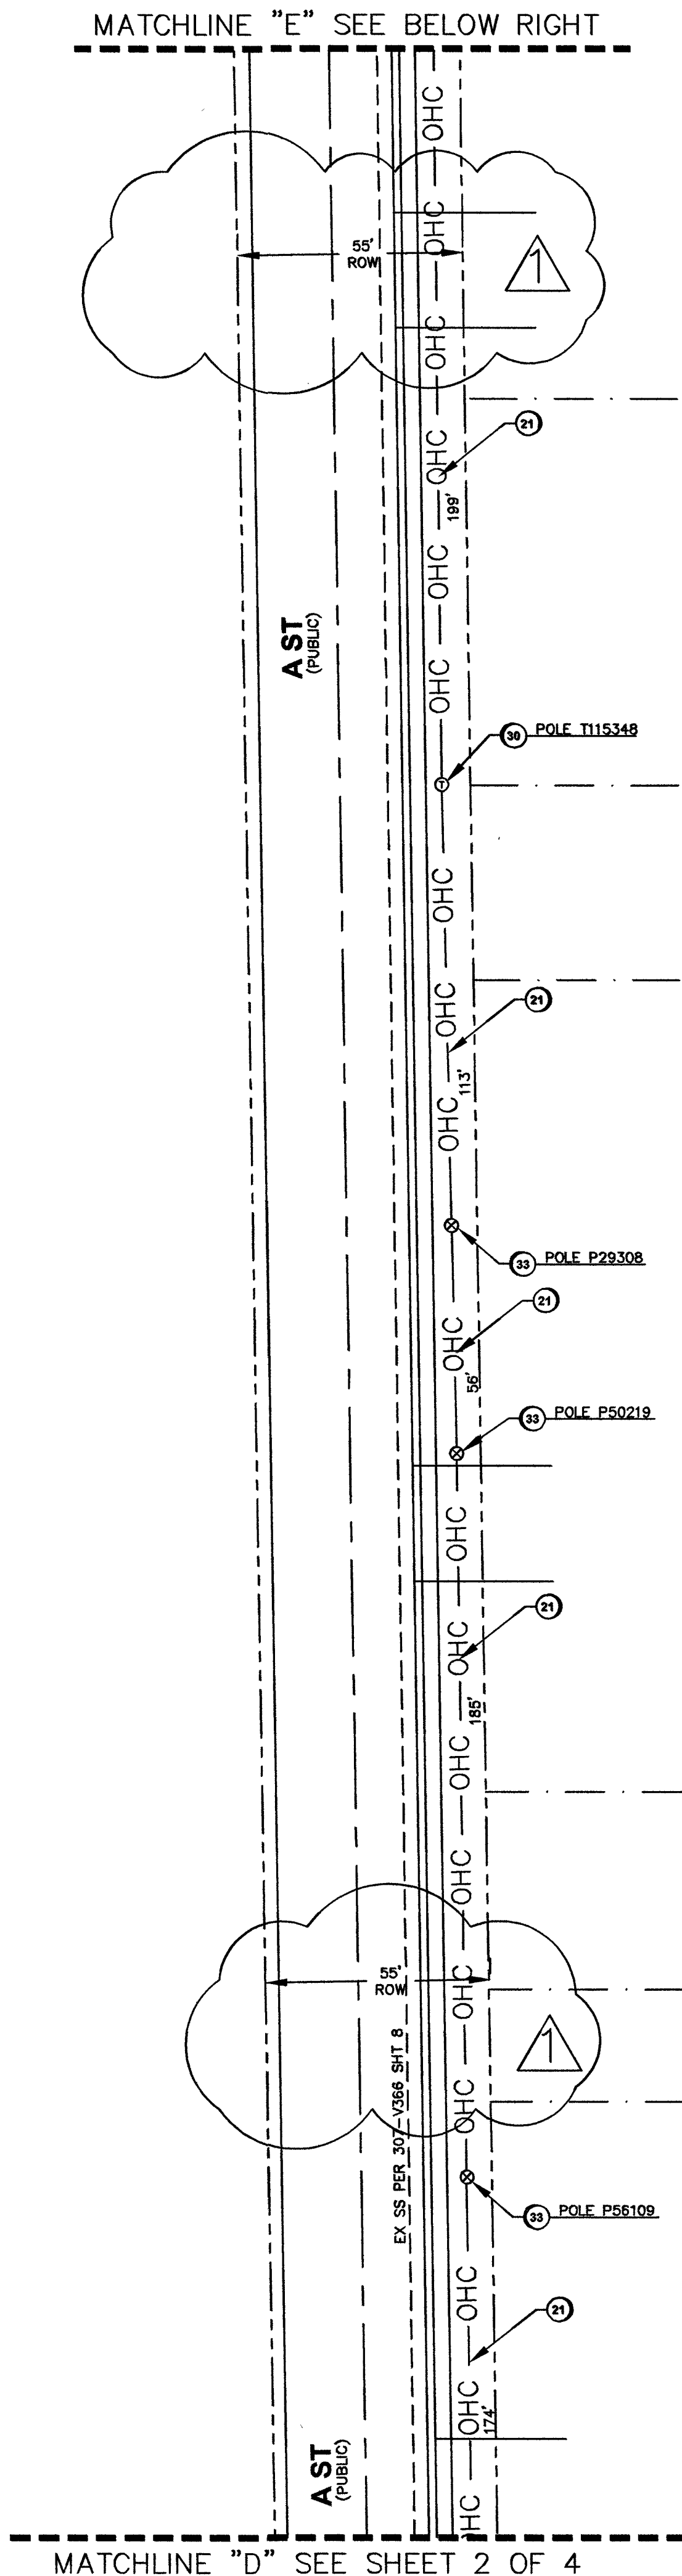

LEGEND	
1	INSTALL B-36 PULL BOX (24"x36"x24")
2	EXISTING B-36 PULL BOX (24"x36"x24")
3	INSTALL B-50 PULL BOX (13"x24"x24")
4	EXISTING B-50 PULL BOX (13"x24"x24")
5	INSTALL B-100 PULL BOX (24"x36"x24")
6	EXISTING B-100 PULL BOX (24"x36"x24")
7	INSTALL T-200 CATV VAULT (30"x48"x36")
8	EXISTING T-200 CATV VAULT (30"x48"x36")
9	INSTALL T-400 CATV VAULT (36"x60"x36")
10	EXISTING T-400 CATV VAULT (36"x60"x36")
11	INSTALL T-600 CATV VAULT (48"x72"x36")
12	EXISTING T-600 CATV VAULT (48"x72"x36")
13	INSTALL NEW CATV PEDESTAL
14	EXISTING NEW CATV PEDESTAL
15	R&R S/W SLAB(S)
16	POT HOLE
17	—C—C— SIDEWALK/DIRT TRENCH INSTALL
18	—C—C— ASPHALT/STREET TRENCH INSTALL
19	—B—B— PROPOSED BORE
20	—X—X— EXISTING CATV CONDUIT(S)
21	—OHC— PROPOSED OVERHEAD FIBER OPTIC CABLE OR COAX INSTALL
22	—XOHC— EXISTING OVERHEAD FIBER OPTIC CABLE OR COAX
23	— — — U.G. FIBER/COAX PULL
24	— — — RIGHT OF WAY LINE
25	— — — LOT/PROPERTY LINE
26	— · — · — EDGE OF PAVEMENT
27	[P] EXISTING NVE PULL BOX
28	[T] EXISTING TELCO PULL BOX
29	[TM] EXISTING TELCO MANHOLE
30	[T] EXISTING TELCO POLE
31	[NVE] EXISTING NVE POLE
32	[NVE] EXISTING NVE TRANSMISSION POLE
33	[X] EXISTING JOINT POLE
34	[X] EXISTING JOINT POLE WITH TRANSFORMER
35	[A] POLE ANCHOR
36	[T] EXISTING NVE TRANSFORMER TRANSFORMER PAD
37	[TS] SNWA TEST STATION
38	[PS] COX POWER SUPPLY (49"x24"x52")
39	[RC] INSTALL RHINO CABINET
40	[R] RISER POLE/QUADRANT DETAIL RISER OWNERSHIP NOTED
41	[RR] RAILROAD
42	[MH] EXISTING MANHOLE (SS),(SD)...ECT
43	— — — 1in CONDUIT LATERAL
44	
45	

DISCLAIMER NOTE	
UTILITY LOCATIONS SHOWN HEREON ARE APPROXIMATE ONLY. IT SHALL BE THE CONTRACTOR'S RESPONSIBILITY TO DETERMINE THE EXACT HORIZONTAL AND VERTICAL LOCATION OF ALL EXISTING UNDERGROUND AND OVERHEAD UTILITIES PRIOR TO COMMENCING CONSTRUCTION. NO REPRESENTATION IS MADE THAT ALL EXISTING UTILITIES ARE SHOWN HEREON. THE ENGINEER ASSUMES NO RESPONSIBILITY FOR UTILITIES NOT SHOWN OR UTILITIES NOT SHOWN IN THEIR PROPER LOCATIONS.	
BEFORE YOU DIG OR 1-800-227-2600 UNDERGROUND SERVICE (USA)	BEFORE YOU OVERHEAD 1-702-227-2929 NEVADA POWER ENVIRONMENT AND SAFETY SERVICE DEPARTMENT
TOTAL BORE 609' TOTAL DIRT TRENCH 0' TOTAL ASPHALT TRENCH 49' TOTAL TRENCH 49' TOTAL S/W PANELS 11 TOTAL LINEAR FOOTAGE 55'	

(T20S R61E)

VICINITY MAP (NOT TO SCALE)

REVISIONS

REV	DESCRIPTION	DATE	BY
1	CHANGE ROUTE / ROW DIM & ADD ANCHOR POLES	5/28/18	MM

APPROVED FOR CONSTRUCTION

THIS APPROVAL IS FOR WORK IN CLV R/W OR CLV EASEMENT ONLY. OBTAINING PERMISSION OR EASEMENT FOR WORK SHOWN IN PRIVATE PROPERTY IS THE RESPONSIBILITY OF THE UTILITY.

Shawn Butts 5-15-18
APPROVAL DATE

PERMIT # 106893
DRAWN BY: MM
DATE: 03-08-18
SCALE: 1"=30'
NODE: 106893
DESIGNER: 40520170000C106893
TECH # 702-210-7011
APPROVED BY: BOB MILLER

LAS VEGAS, NEVADA 89106
PHONE: (702) 545-1606
FAX: (702) 545-2606

CITY/ENTITY:
CITY OF LAS VEGAS
333 N. RANCHO DRIVE
LAS VEGAS, NEVADA 89106
(702) 229-6885

PROJECT LOCATION:
E WASHINGTON AVE & N MAIN ST


SUB-CONTRACTOR:
CLOVER

ENTITY NOTES:



W OWENS AVE
(PUBLIC)

1		INSTALL B-36 PULL BOX (24"x36"x24")
2		EXISTING B-36 PULL BOX (24"x36"x24")
3		INSTALL B-50 PULL BOX (13"x24"x24")
4		EXISTING B-50 PULL BOX (13"x24"x24")
5		INSTALL B-100 PULL BOX (24"x36"x24")
6		EXISTING B-100 PULL BOX (24"x36"x24")
7		INSTALL T-200 CATV VAULT (30"x48"x36")
8		EXISTING T-200 CATV VAULT (30"x48"x36")
9		INSTALL T-400 CATV VAULT (36"x60"x36")
10		EXISTING T-400 CATV VAULT (36"x60"x36")
11		INSTALL T-600 CATV VAULT (48"x72"x36")
12		EXISTING T-600 CATV VAULT (48"x72"x36")
13		INSTALL NEW CATV PEDESTAL
14		EXISTING NEW CATV PEDESTAL
15		R&R S/W SLAB(S)
16		POTHOLE
17		SIDEWALK/DIRT TRENCH INSTALL
18		ASPHALT/STREET TRENCH INSTALL
19		PROPOSED BORE
20		EXISTING CATV CONDUIT(S)
21		PROPOSED OVERHEAD FIBER OPTIC CABLE OR COAX INSTALL
22		EXISTING OVERHEAD FIBER OPTIC CABLE OR COAX
23		U.G. FIBER/COAX PULL
24		RIGHT OF WAY LINE
25		LOT/PROPERTY LINE
26		EDGE OF PAVEMENT
27		EXISTING NVE PULL BOX
28		EXISTING TELCO PULL BOX
29		EXISTING TELCO MANHOLE
30		EXISTING TELCO POLE
31		EXISTING NVE POLE
32		EXISTING NVE TRANSMISSION POLE
33		EXISTING JOINT POLE
34		EXISTING JOINT POLE WITH TRANSFORMER
35		POLE ANCHOR
36		EXISTING NVE TRANSFORMER TRANSFORMER PAD
37		SNWA TEST STATION
38		COX POWER SUPPLY (49"x24"x52")
39		INSTALL RHINO CABINET
40		RISER POLE/QUADRANT DETAIL RISER OWNERSHIP NOTED
41		RAILROAD
42		EXISTING MANHOLE (SS),(SD)...ECT
43		1in CONDUIT LATERAL
44		
45		

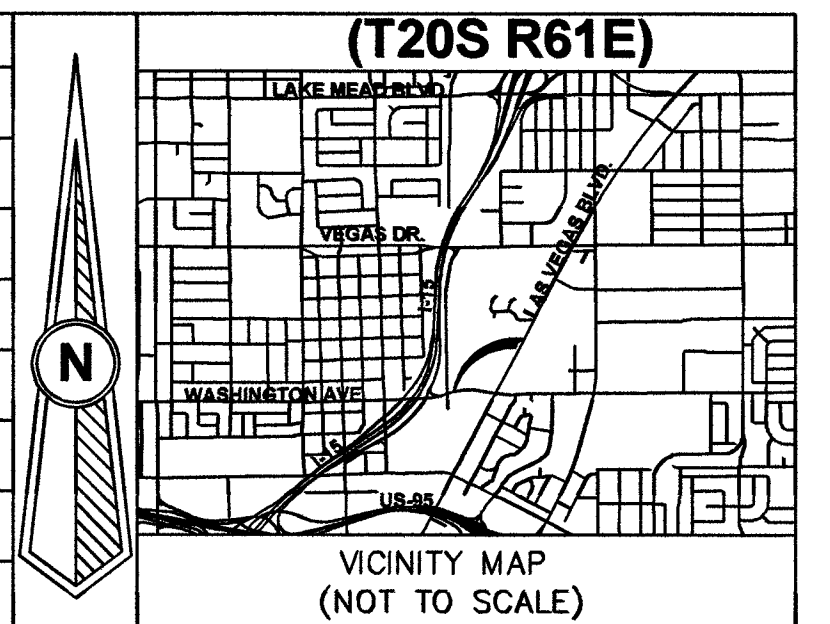[illegible]

APPROVED FOR CONSTRUCTION
THIS APPROVAL IS FOR WORK IN CLV R/W OR CLV
EASEMENT ONLY. OBTAINING PERMISSION OR
EASEMENT FOR WORK SHOWN IN PRIVATE
PROPERTY IS THE RESPONSIBILITY OF THE UTILITY.

APPROVAL Sham Bhatt DATE 5-15-18

PERMIT #	106893
DRAWN BY:	MM
DATE:	03-08-18
SCALE:	1:30
NODE:	106893
DESIGNER:	40520170000C106893
TECH #	702-210-7011
APPROVED BY:	BOB MILLER

COX
1700 VEGAS DRIVE
LAS VEGAS, NEVADA 89106
PHONE: (702) 545-1606
FAX: (702) 545-2606

**CITY OF LAS VEGAS
333 N. RANCHO DRIVE
LAS VEGAS, NEVADA 89106
(702) 229-6885**

CATION: E WASHINGTON AVE & N MAIN ST

CLOVER

IDENTITY NOTES:

SHEET No:

617-00444
107V6954-CBL
SHEET 4 OF 4

TrueNet# 11190

UTILITY LOCATIONS SHOWN
HEREON ARE APPROXIMATE ONLY.
IT SHALL BE THE CONTRACTOR'S
RESPONSIBILITY TO DETERMINE
THE EXACT LOCATION AND
VERTICAL LOCATION OF ALL
EXISTING UNDERGROUND AND
OVERHEAD UTILITIES PRIOR
TO COMMENCING CONSTRUCTION.
NO REPRESENTATION IS MADE
THAT ALL EXISTING UTILITIES ARE
SHOWN HEREON. THE USER
HEREOF ASSUMES NO RESPONSIBILITY
FOR UTILITIES NOT SHOWN OR
UTILITIES NOT SHOWN IN THEIR
PROPER LOCATIONS.

FOR FURTHER UNDERGROUND
TRACING, SIGNAL SYSTEMS, AND
STREET LIGHTS, SEE THE
CITY'S COSTLY

CALL BEFORE
YOU DO
UNDERGROUND

CALL
BEFORE YOU
DO
UNDERGROUND

4-702-465-7511
CLARK COUNTY TRAFFIC OPERATIONS AND
1-702-432-5300
LAS VEGAS AREA COMPUTERIZED UTILITIES

**AVOID CUTTING UNDERGROUND
UTILITY LINES. IT'S COSTLY.**

**CALL
811**



**BEFORE YOU DIG
OR 1-800-227-2600
UNDERGROUND SERVICE (USA)**

**AVOID OVERHEAD POWER
LINE CONTACT**

**CALL
BEFORE YOU
OVERHEAD**

1-702-227-2929
**NEVADA POWER ENVIRONMENT AND
SAFETY SERVICE DEPARTMENT**

TOTAL BORE	609'
TOTAL DIRT TRENCH	0'
TOTAL ASPHALT TRENCH	49'
TOTAL TRENCH	49'
<u>SIDEWALK REMOVAL/REPAIR</u>	
TOTAL S/W PANELS	11
TOTAL LINEAR FOOTAGE	55'