


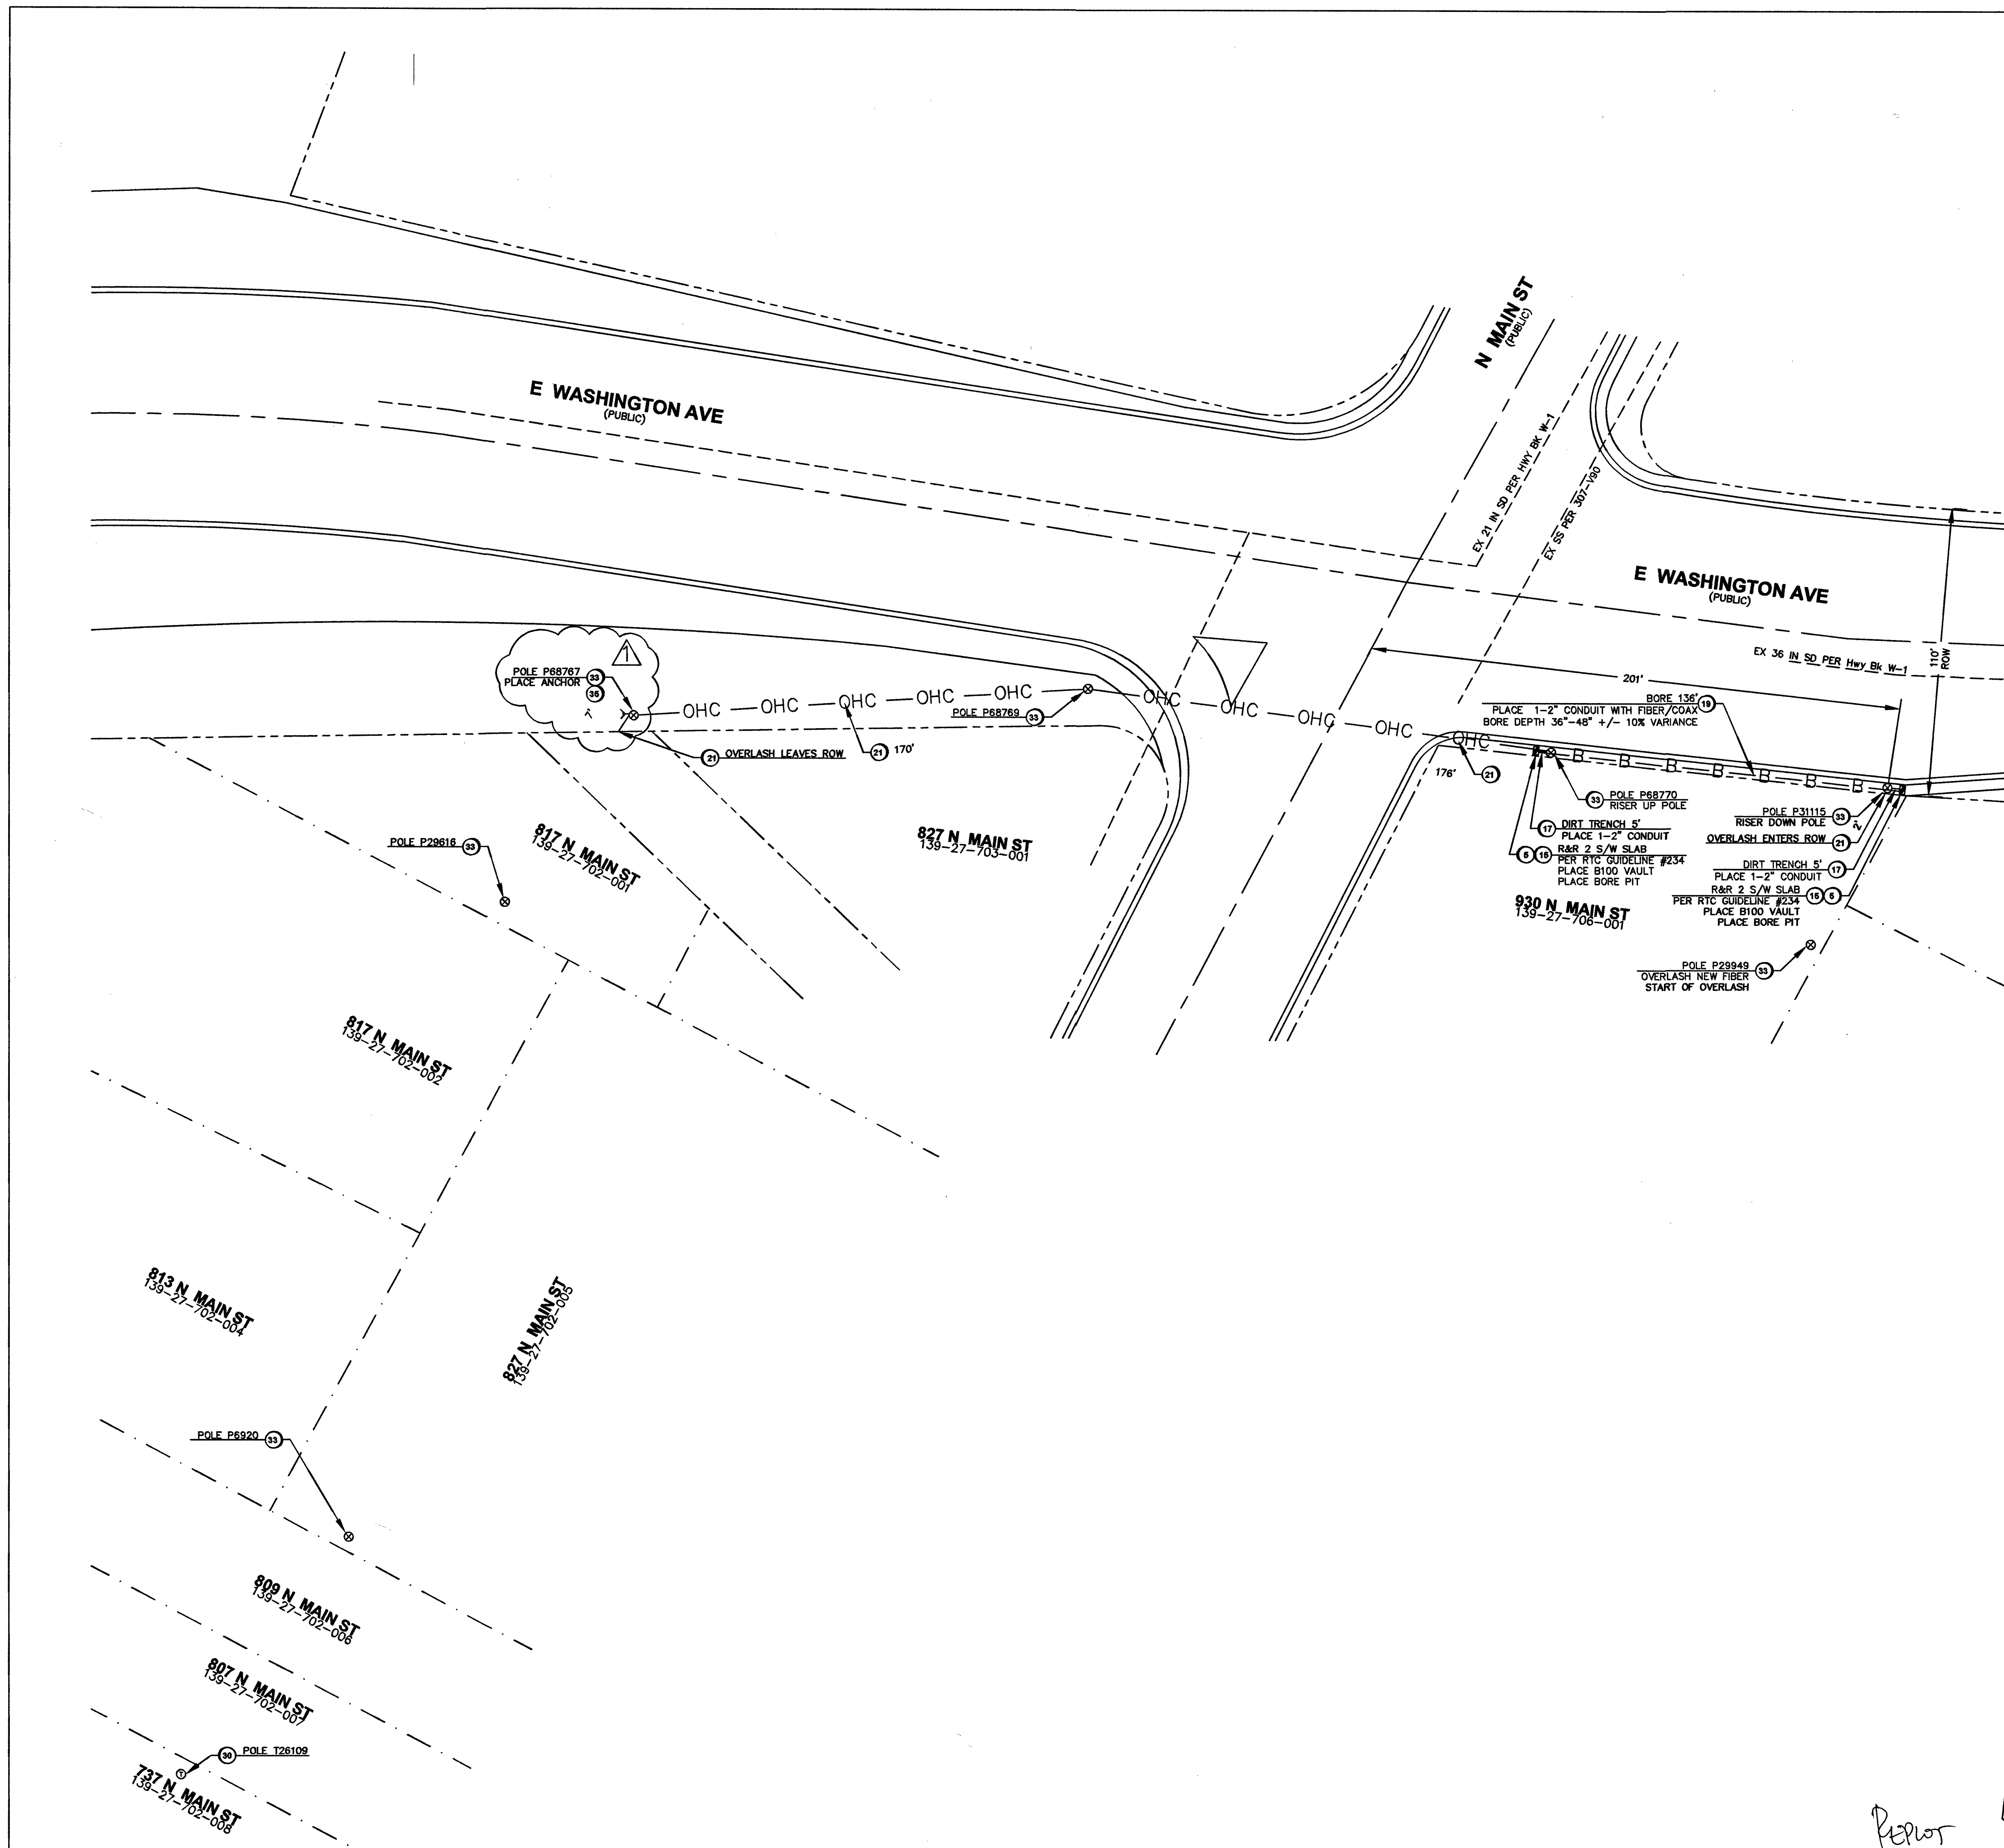

LEGEND	
1	INSTALL B-36 PULL BOX (24\"X36\"X24\")
2	EXISTING B-36 PULL BOX (24\"X36\"X24\")
3	INSTALL B-50 PULL BOX (13\"X24\"X24\")
4	EXISTING B-50 PULL BOX (13\"X24\"X24\")
5	INSTALL B-100 PULL BOX (24\"X36\"X24\")
6	EXISTING B-100 PULL BOX (24\"X36\"X24\")
7	INSTALL T-200 CATV VAULT (30\"X48\"X36\")
8	EXISTING T-200 CATV VAULT (30\"X48\"X36\")
9	INSTALL T-400 CATV VAULT (36\"X60\"X36\")
10	EXISTING T-400 CATV VAULT (36\"X60\"X36\")
11	INSTALL T-600 CATV VAULT (48\"X72\"X36\")
12	EXISTING T-600 CATV VAULT (48\"X72\"X36\")
13	INSTALL NEW CATV PEDESTAL
14	EXISTING NEW CATV PEDESTAL
15	R&R S/W SLAB(S)
16	POTHOLE
17	—c—c—c— SIDEWALK/DIRT TRENCH INSTALL
18	—c—c—c— ASPHALT/STREET TRENCH INSTALL
19	—B—B— PROPOSED BORE
20	—x—x— EXISTING CATV CONDUIT(S)
21	—OHC— PROPOSED OVERHEAD FIBER OPTIC CABLE OR COAX INSTALL
22	—OHG— EXISTING OVERHEAD FIBER OPTIC CABLE OR COAX
23	—U.G.— U.G. FIBER/COAX PULL
24	—R—R— RIGHT OF WAY LINE
25	—P—P— LOT/PROPERTY LINE
26	—E—E— EDGE OF PAVEMENT
27	[P] EXISTING NVE PULL BOX
28	[T] EXISTING TELCO PULL BOX
29	[TM] EXISTING TELCO MANHOLE
30	[T] EXISTING TELCO POLE
31	[NVE] EXISTING NVE POLE
32	[NVE] EXISTING NVE TRANSMISSION POLE
33	[X] EXISTING JOINT POLE
34	[X] EXISTING JOINT POLE WITH TRANSFORMER
35	[A] POLE ANCHOR
36	[A] EXISTING NVE TRANSFORMER TRANSFORMER PAD
37	[TS] SNWA TEST STATION
38	[C] COX POWER SUPPLY (49\"X24\"X52\")
39	[RC] INSTALL RHINO CABINET
40	[R] RISER POLE/QUADRANT DETAIL RISER OWNERSHIP NOTED
41	[R] RAILROAD
42	[M] EXISTING MANHOLE (SS),(SD)...ECT
43	—1in— 1in CONDUIT LATERAL
44	
45	

DISCLAIMER NOTE													
UTILITY LOCATIONS SHOWN HEREON ARE APPROXIMATE ONLY. IT SHALL BE THE CONTRACTOR'S RESPONSIBILITY TO DETERMINE THE EXACT HORIZONTAL AND VERTICAL LOCATION OF ALL EXISTING UNDERGROUND AND OVERHEAD UTILITIES PRIOR TO COMMENCING CONSTRUCTION. NO REPRESENTATION IS MADE THAT ALL EXISTING UTILITIES ARE SHOWN HEREON. THE ENGINEER ASSUMES NO RESPONSIBILITY FOR UTILITIES NOT SHOWN OR UTILITIES NOT SHOWN IN THEIR PROPER LOCATIONS.													
BEFORE YOU DIG OR 1-800-227-2600 UNDERGROUND SERVICE (USA) BEFORE YOU UNDERGROUND CALL 1-702-455-7511 CLARK COUNTY TRAFFIC OPERATIONS 1-702-452-5300 LAS VEGAS AREA COMPUTERIZED SYSTEM													
AVOID CUTTING UNDERGROUND UTILITY LINES. IT'S COSTLY. CALL 811 BEFORE YOU DIG OR 1-800-227-2600 UNDERGROUND SERVICE (USA) AVOID OVERHEAD POWER LINE CONTACT CALL BEFORE YOU OVERHEAD 1-702-227-2829 NEVADA POWER ENVIRONMENT AND SAFETY SERVICE DEPARTMENT													
<table> <tr><td>TOTAL BORE</td><td>136'</td></tr> <tr><td>TOTAL DIRT TRENCH</td><td>10'</td></tr> <tr><td>TOTAL ASPHALT TRENCH</td><td>0'</td></tr> <tr><td>TOTAL TRENCH</td><td>10'</td></tr> <tr><td>TOTAL S/W PANELS</td><td>4</td></tr> <tr><td>TOTAL LINEAR FOOTAGE</td><td>20'</td></tr> </table>		TOTAL BORE	136'	TOTAL DIRT TRENCH	10'	TOTAL ASPHALT TRENCH	0'	TOTAL TRENCH	10'	TOTAL S/W PANELS	4	TOTAL LINEAR FOOTAGE	20'
TOTAL BORE	136'												
TOTAL DIRT TRENCH	10'												
TOTAL ASPHALT TRENCH	0'												
TOTAL TRENCH	10'												
TOTAL S/W PANELS	4												
TOTAL LINEAR FOOTAGE	20'												

(T20S R61E)

VICINITY MAP (NOT TO SCALE)

REVISIONS

REV	DESCRIPTION	DATE	BY
1	ADDED POLE ANCHOR	11/28	WTB

APPROVED FOR CONSTRUCTION

THIS APPROVAL IS FOR WORK IN CLV R/W OR CLV EASEMENT ONLY. OBTAINING PERMISSION OR EASEMENT FOR WORK SHOWN IN PRIVATE PROPERTY IS THE RESPONSIBILITY OF THE UTILITY.

APPROVAL: DATE: 9/12/19

PERMIT # 143532
DRAWN BY: MM
DATE: 07-18-18
SCALE: 1:30
NODE: 143532
DESIGNER: 405201800000143532
TECH # 702-210-7011
APPROVED BY: BOB MILLER

COX
1700 VEGAS DRIVE
LAS VEGAS, NEVADA 89106
PHONE: (702) 545-1606
FAX: (702) 545-2005

CITY OF LAS VEGAS
333 N. RANCHO DRIVE
LAS VEGAS, NEVADA 89106
(702) 229-6885

PROJECT LOCATION:
E WASHINGTON AVE & N MAIN ST

SUB-CONTRACTOR:
CLOVER CABLE

ENTITY NOTES:

CITY OF LAS VEGAS
SHEET NO: 1
SHEET 1 OF 1

118-02624-0013/4/19