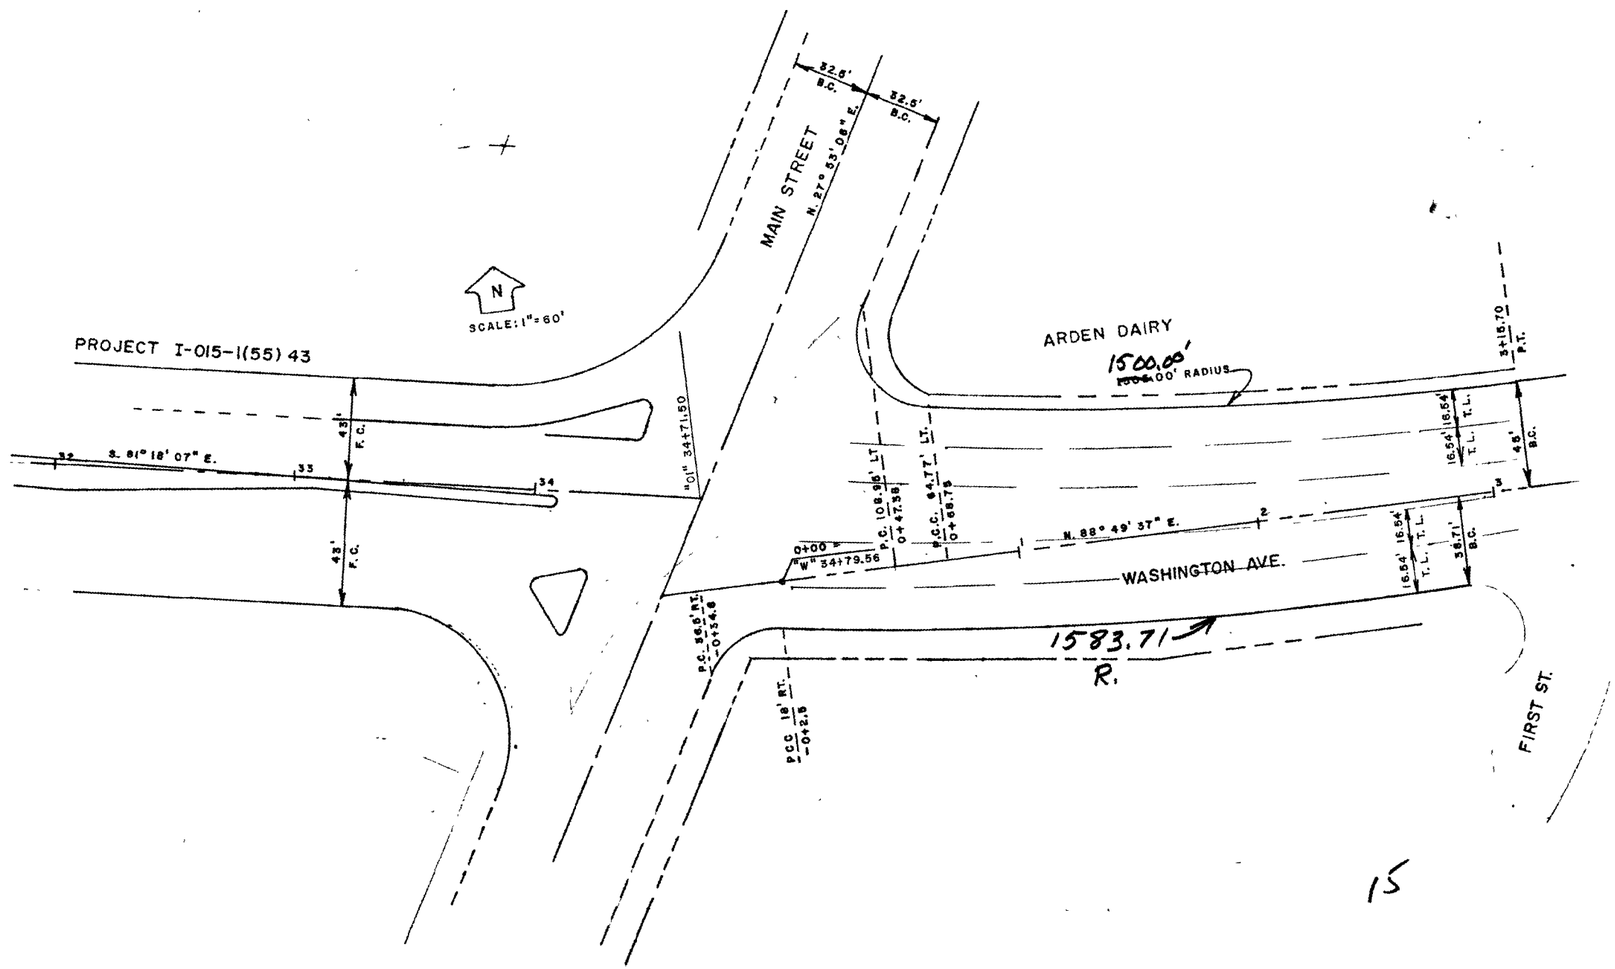
N
SCALE: 1" = 60'
PROJECT I-015-1(55) 43
MAIN STREET
N. 27° 53' 08" E.
32.6' B.C.
32.5' B.C.
ARDEN DAIRY
1500.00'
~~1004~~.00' RADIUS
3+15.70 P.T.
43' F.C.
43' F.C.
"01" 34+71.50
S. 81° 18' 07" E.
32
33
34
P.C. 106.96' LT.
0+47.38
P.C.C. 64.77' LT.
0+68.75
16.54' T.L.
16.54' T.L.
48' B.C.
N. 88° 49' 37" E.
0+00
"W" 34+79.56
WASHINGTON AVE.
16.54' T.L.
16.54' T.L.
35.71' B.C.
P.C. 86.6' RT.
0+34.8
1583.71
R.
P.C.C. 18' RT.
0+22.9
FIRST ST.

15

53574