

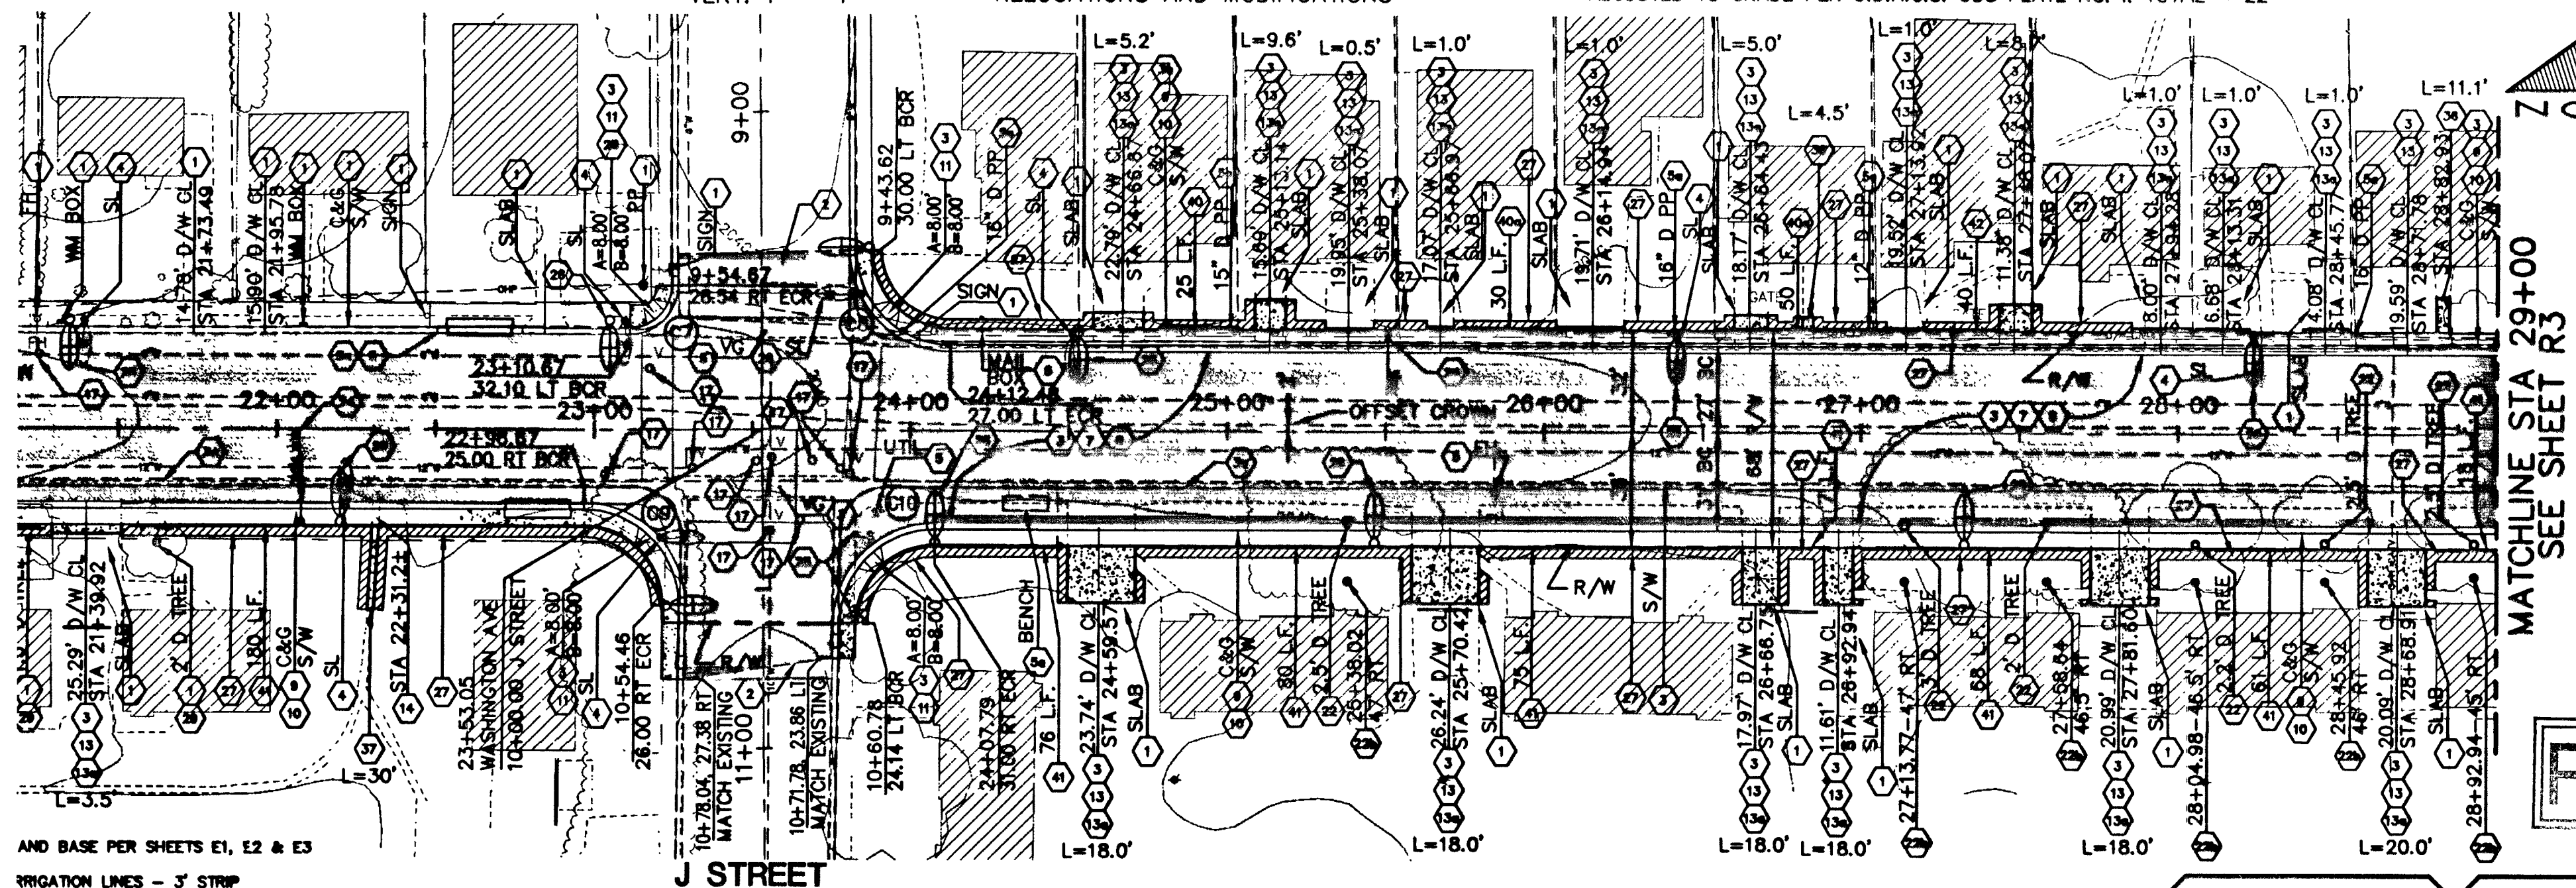


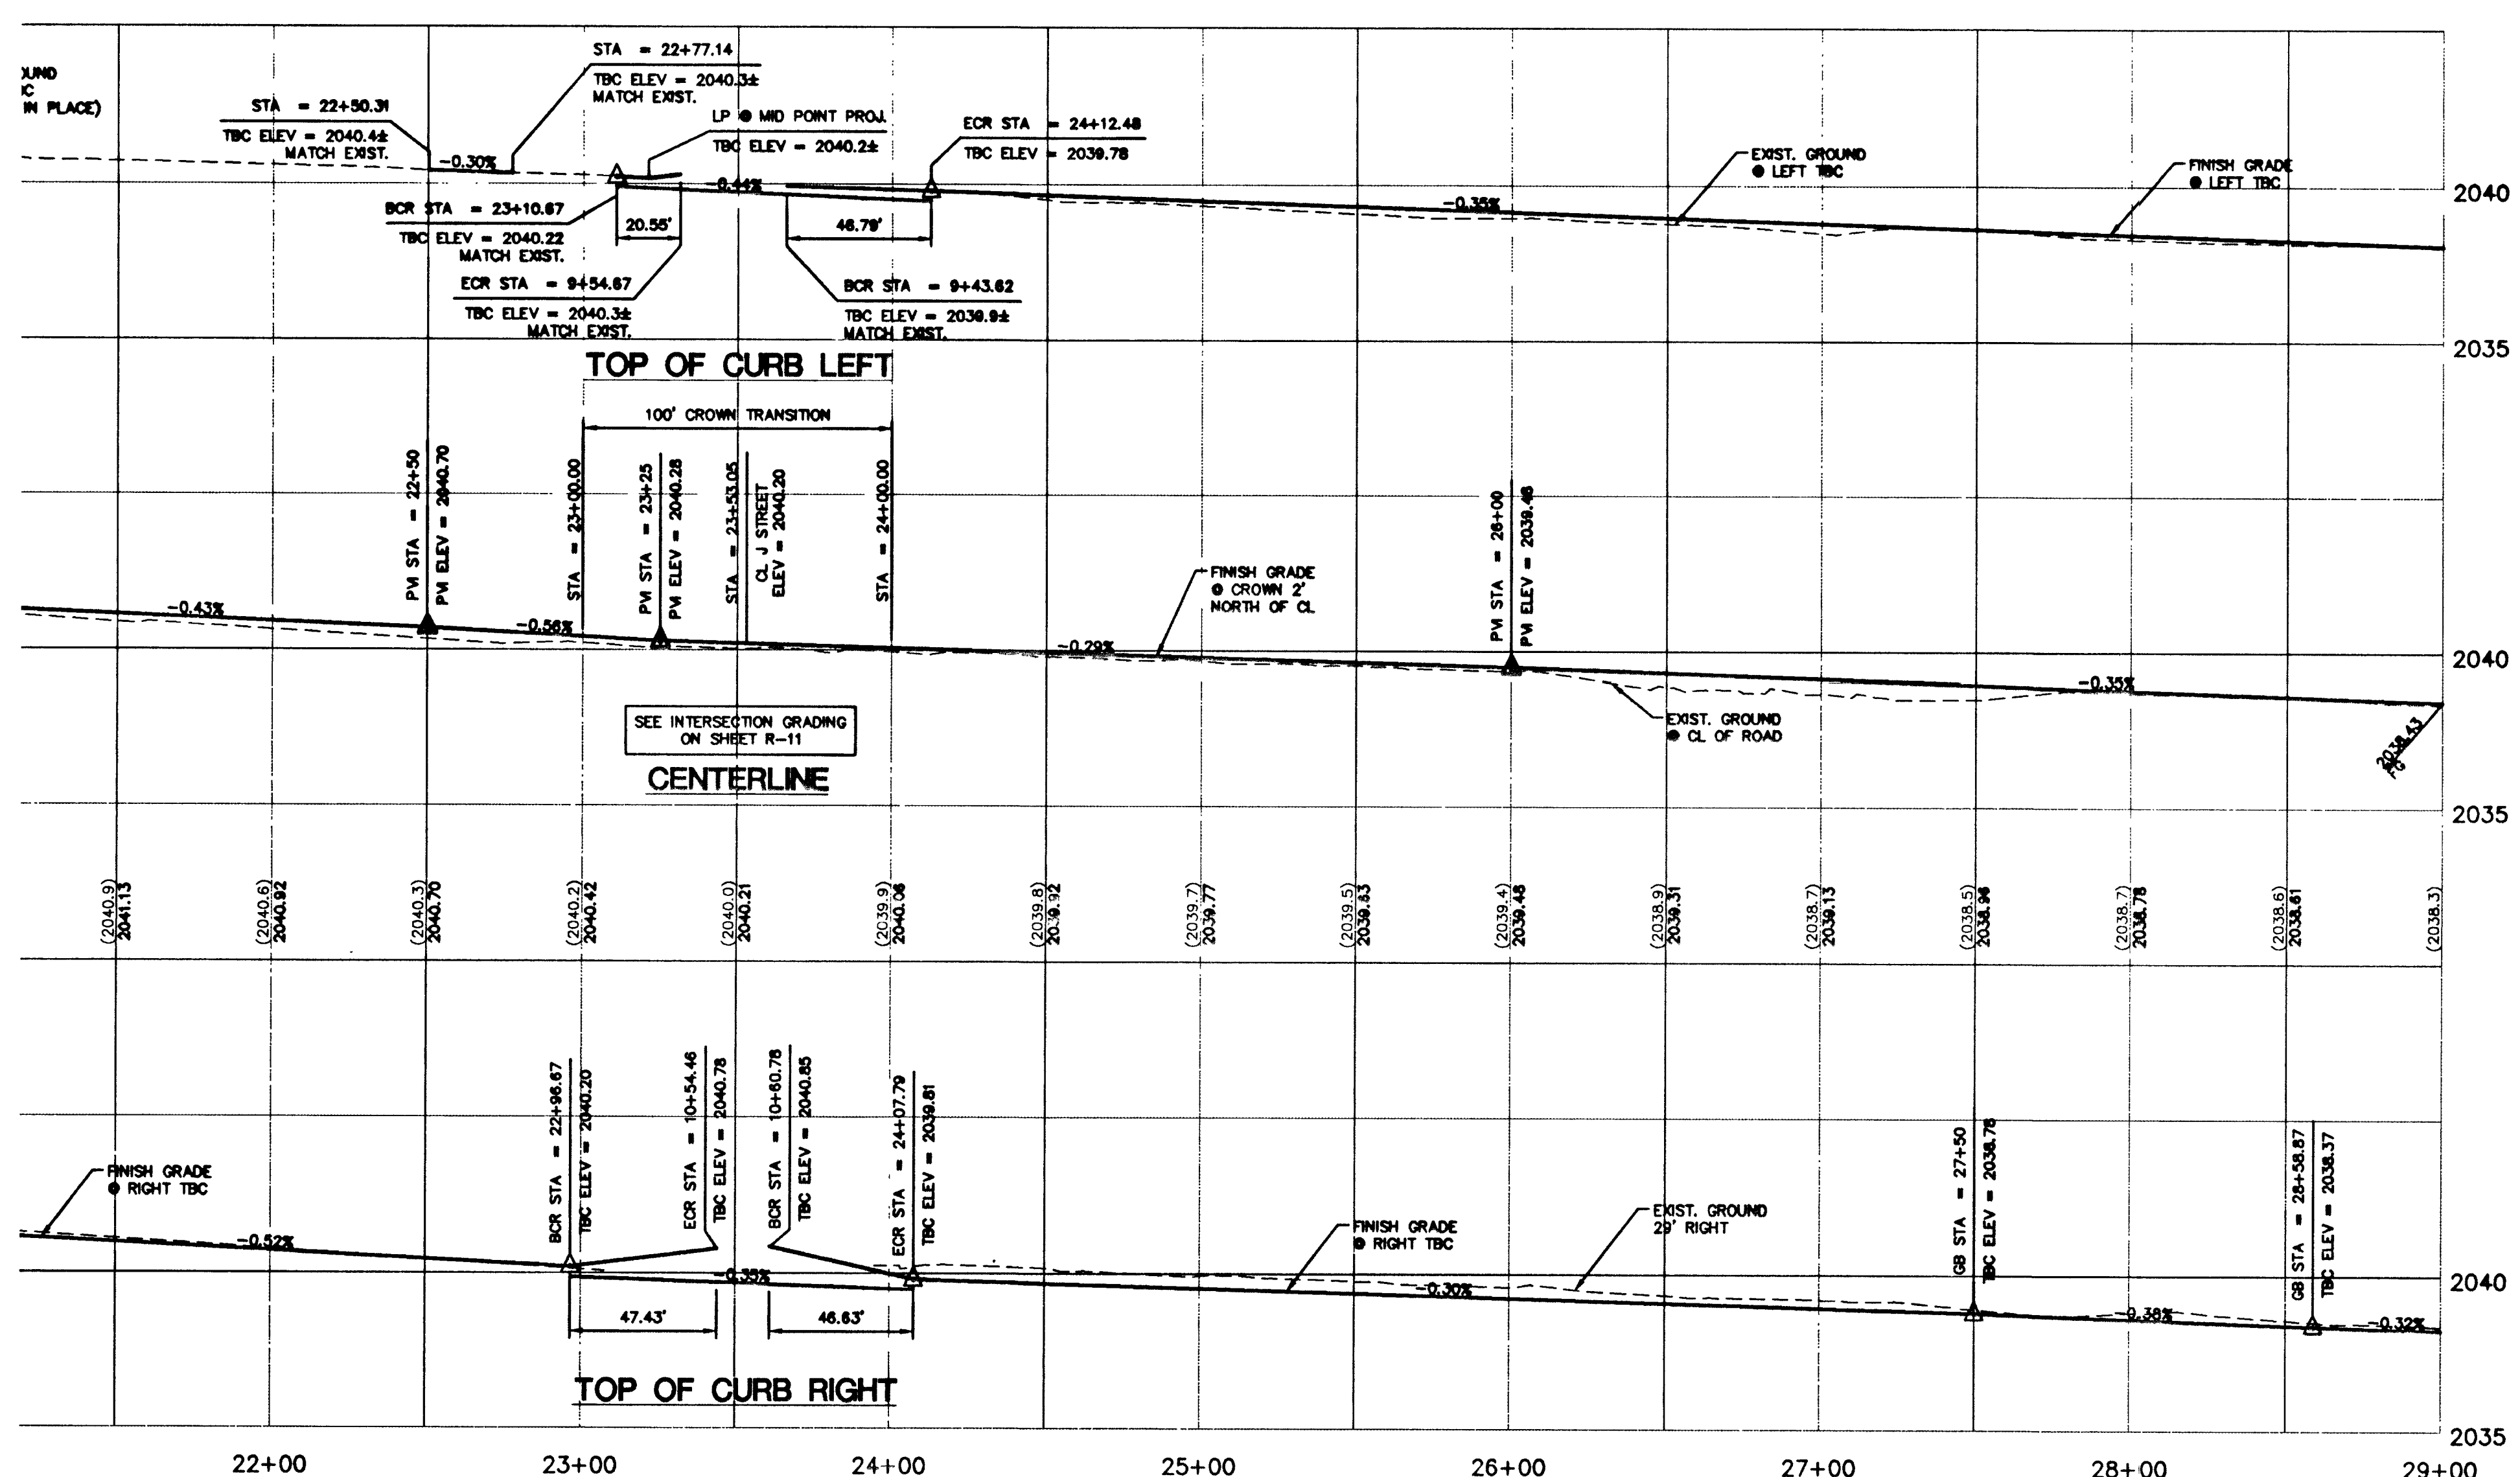

- AND BASE PER SHEETS E1, E2 & E3
- IRRIGATION LINES - 3" STRIP
- TYPE CURBS AND GUTTER PER C.C.U.S.D. NO. 219
- DETAIL 2 SHEET R-15
- TROL BARRIER PER DETAIL 3 SHEET R-14
- WALKWAY PER DETAIL 4 SHEET R-14
- GUTTER PER DETAIL 5 SHEET R-14
- 1 WROUGHT IRON FENCE - MATCH EXISTING
- CHAIN LINK FENCE PER C.C.U.S.D. NO. 252
- 1 PER DETAIL 1 SHEET R-16
- 1 PER DETAIL 2 SHEET R-16

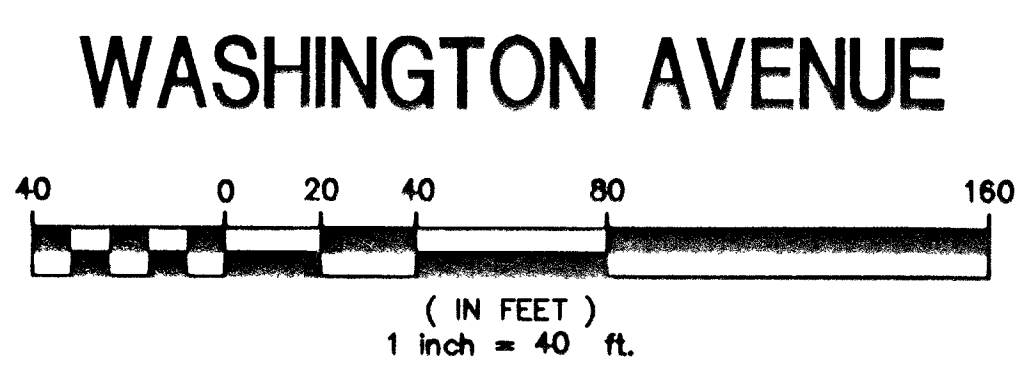

| No. | Radius | Delta     | Tangent | Length |
|-----|--------|-----------|---------|--------|
| C6  | 25.00' | 90°38'11" | 25.28'  | 39.55' |
| C7  | 13.00' | 90°33'20" | 13.13'  | 20.55' |
| C8  | 30.00' | 89°22'16" | 29.67'  | 46.79' |
| C9  | 30.00' | 90°35'10" | 30.31'  | 47.43' |
| C10 | 30.00' | 89°07'08" | 29.54'  | 46.66' |

Avoid hitting overhead power lines. It's costly.

**Call before you do Overhead**

**1-702-593-6111**

Avoid cutting underground utility lines. It's costly.

**Call before you Dig.**

**1-800-227-2600**

UNDERGROUND SERVICE ALERT (USA)

DATE: 02/10/00

PM: NWBT

DRAWN BY: JRL/MTA

DESIGNED BY: J.B.T

CHECKED BY: J.B.T

ADA CHECKED:

JOB NO.: 03330141

SCALE: 40' H / 4" V

NO. DESCRIPTION

APPROVED

**PENTACORE**

CIVIL ENGINEERING • LAND SURVEYING • PLANNING  
CONSTRUCTION MANAGEMENT • ADA CONSULTING

8783 WEST CHARLESTON BOULEVARD  
LAS VEGAS, NEVADA 89146 (702)256-0115

CITY OF LAS VEGAS

WASHINGTON AVENUE

WASHINGTON AVENUE

PLAN & PROFILE

STA 18+00 TO STA 29+00

**RECORD**

PROFESSIONAL ENGINEER-STATE

MYRON R. [Signature]

NO. 2645

12561

SHEET 9

**R2**

OF 59

48795