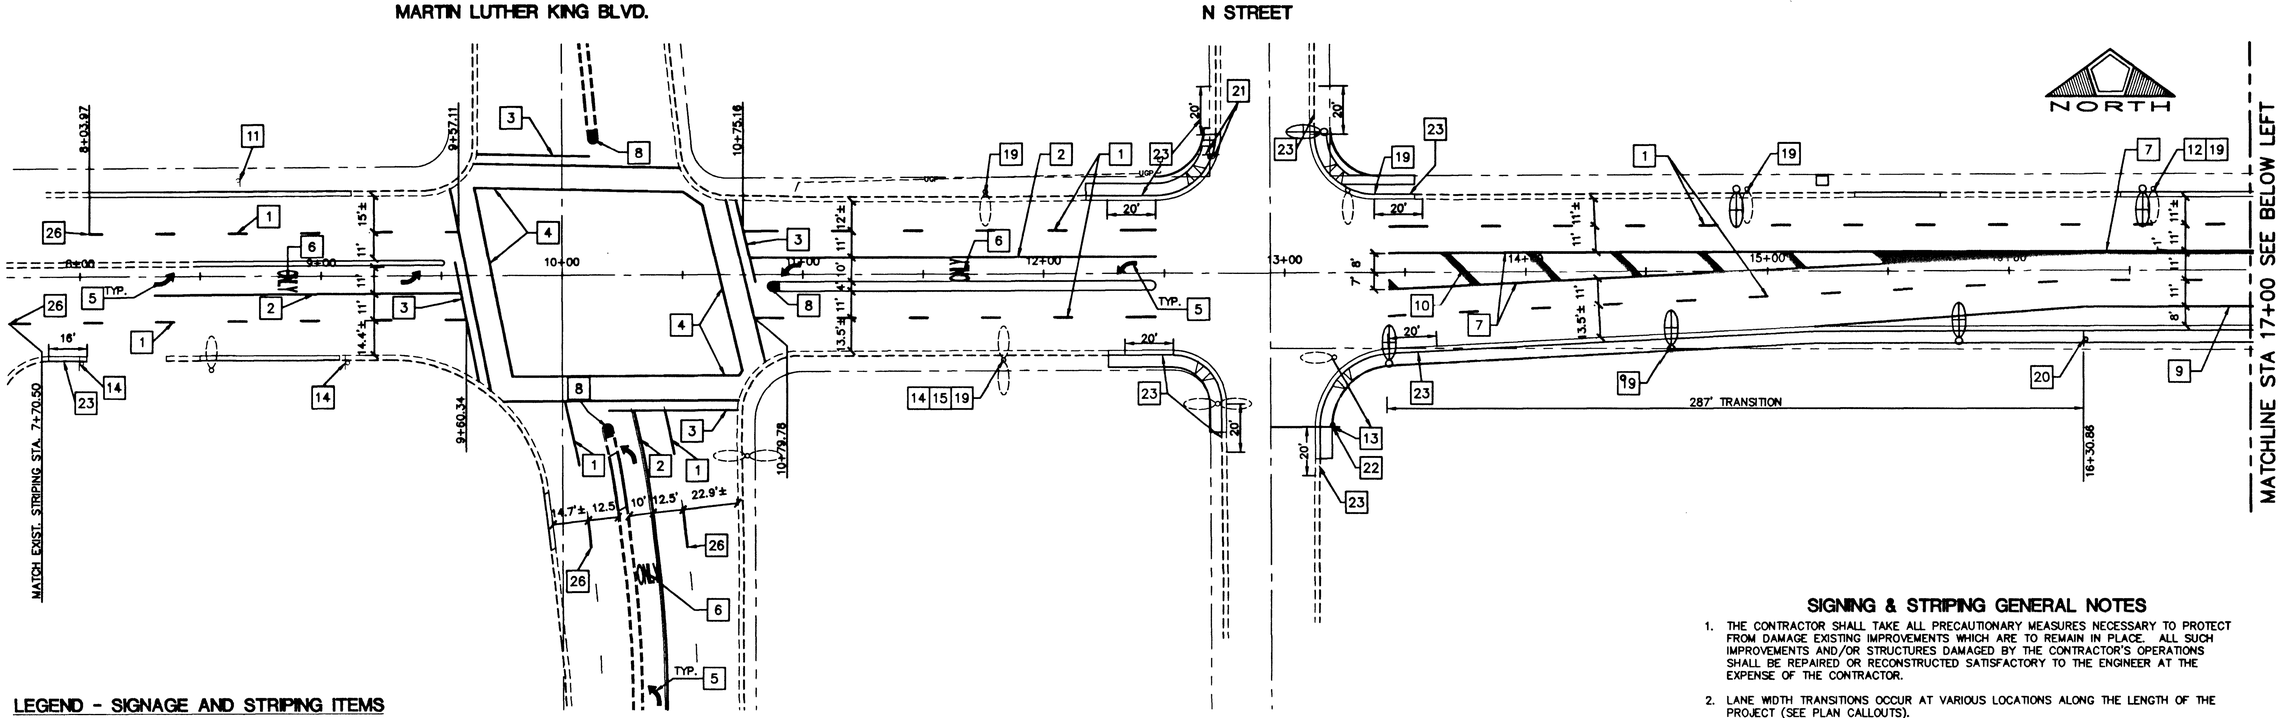

LEGEND - SIGNAGE AND STRIPING ITEMS

1. INSTALL TYPE 4 LANE LINE PER UNIFORM STD. DWG. #244A.
2. INSTALL STORAGE LANE LINE PER UNIFORM STD. DWG. #246; FOR RIGHT TURN LANES, USE RAISED PAVEMENT MARKERS ALSO.
3. INSTALL 24" WIDE STOP BAR USING WHITE COLD POLYMER FILM (4' MINIMUM WIDTH BETWEEN CROSSWALK LINE AND STOP BAR) PER UNIFORM STD. DWG. #254A. SEE GENERAL NOTE 4. EXACT LOCATION TO BE DETERMINED IN THE FIELD BY THE ENGINEER.
4. INSTALL WHITE COLD POLYMER FILM CROSSWALK LINES (12" WIDE AND 10' CLEAR WIDTH BETWEEN LINES) PER UNIFORM STD. DWG. #254A. SEE GENERAL NOTE 4 AND TYPICAL CROSSWALK MARKING DETAIL ON SHEET S-3. EXACT LOCATION TO BE DETERMINED IN THE FIELD BY THE ENGINEER.
5. INSTALL WHITE COLD POLYMER PAVEMENT ARROW
6. INSTALL WHITE COLD POLYMER PAVEMENT "ONLY" LEGEND. SEE GENERAL NOTE 4.
7. INSTALL TYPE 1 CENTERLINE PER UNIFORM STD. DWG. #244.
8. INSTALL MEDIAN NOSE MARKINGS PER UNIFORM STD. DWG. #248.
9. INSTALL 6" SOLID WHITE LINE USING TYPE II FILM.
10. INSTALL 24" WIDE YELLOW STRIPES PER UNIFORM STD. DWG. #245.
11. EXISTING SIGN(S) & POST TO REMAIN.
12. EXISTING SIGN(S) ON STREET LIGHT POLE TO REMAIN.
13. RELOCATE EXISTING SIGN PANEL(S).
14. REMOVE & SALVAGE EXISTING SIGN(S).
15. INSTALL R2-1 "SPEED LIMIT 35" SIGN (24" X 30").
19. INSTALL R8-3A "NO PARKING" SYMBOL (24"X 24") & R7-1AP. "ANY TIME W/DOUBLE HEADED ARROW" SYMBOL (24" X 24").
20. INSTALL R8-3A "NO PARKING" SYMBOL (24"X 24") & SUPPLEMENTAL PLATE W/LEGEND "THIS SIDE OF SIGN" (24" X 24").
21. RELOCATE EXISTING SIGN(S) & POST.
22. INSTALL NEW SIGN POST PER MUTCD.
23. PAINT CURB RED.
24. INSTALL R8-3A "NO PARKING" SYMBOL (24" X 24") & SUPPLEMENTAL PLATE W/LEGEND "HERE TO CORNER" (24" X 24").
25. INSTALL WHITE COLD POLYMER FILM CROSSWALK LINES (LONGITUDINAL LINES ONLY -- 2' WIDE, CENTERED BETWEEN & ON LANE LINES) PER UNIFORM STD. DWG. #254A.
26. MATCH EXISTING.
27. INSTALL S1-1 "SCHOOL ADVANCE" SIGN (30" X 30").
28. INSTALL S2-1 "SCHOOL CROSSING" SIGN (30" X 30").

SIGNING & STRIPING GENERAL NOTES

1. THE CONTRACTOR SHALL TAKE ALL PRECAUTIONARY MEASURES NECESSARY TO PROTECT FROM DAMAGE EXISTING IMPROVEMENTS WHICH ARE TO REMAIN IN PLACE. ALL SUCH IMPROVEMENTS AND/OR STRUCTURES DAMAGED BY THE CONTRACTOR'S OPERATIONS SHALL BE REPAIRED OR RECONSTRUCTED SATISFACTORY TO THE ENGINEER AT THE EXPENSE OF THE CONTRACTOR.
2. LANE WIDTH TRANSITIONS OCCUR AT VARIOUS LOCATIONS ALONG THE LENGTH OF THE PROJECT (SEE PLAN CALLOUTS). BEGINNING/ENDING OF LANE TRANSITIONS ARE IDENTIFIED ON THE PLANS.
3. THE CONTRACTOR SHALL PROVIDE PILOT AND ALIGNMENT LINES FOR THE ENGINEER'S APPROVAL PRIOR TO PERFORMING ANY MARKING WORK. CONTACT THE ENGINEER 48 HOURS IN ADVANCE.
4. ALL COLD POLYMER PAVEMENT MARKING FILM SHALL BE TYPE N440 OR APPROVED EQUAL. THE HIGH DURABILITY, INTERSECTION GRADE RETROREFLECTIVE PREFORMED MARKING FILM WITH 3 COAT CONTACT CEMENT APPLICATION SYSTEM, SHALL BE APPLIED AND TAMPED IN ACCORDANCE WITH THE MANUFACTURER'S SPECIFICATIONS. THE MANUFACTURER'S REPRESENTATIVE SHALL BE PRESENT AT THE TIME OF INSTALLATION. ALL APPLICATION METHODS SHALL BE CONFIRMED BY THE CITY TRAFFIC ENGINEER AND MANUFACTURER PRIOR TO INSTALLATION. SAID PAVEMENT MARKING FILM SHALL NOT BE PLACED EARLIER THAN TWO (2) WEEKS AFTER FINAL A.C. LAYER IS PLACED. ALL MATERIALS AND EQUIPMENT SHALL BE IN ACCORDANCE WITH THE MANUFACTURER'S SPECIFICATIONS. THE CONTRACTOR SHALL PROVIDE TEMPORARY PAVEMENT MARKINGS AS NEEDED.
5. EXACT LOCATION OF ALL PAVEMENT MARKINGS SHALL BE LOCATED BY THE CONTRACTOR FOR REVIEW AND APPROVAL BY THE ENGINEER.

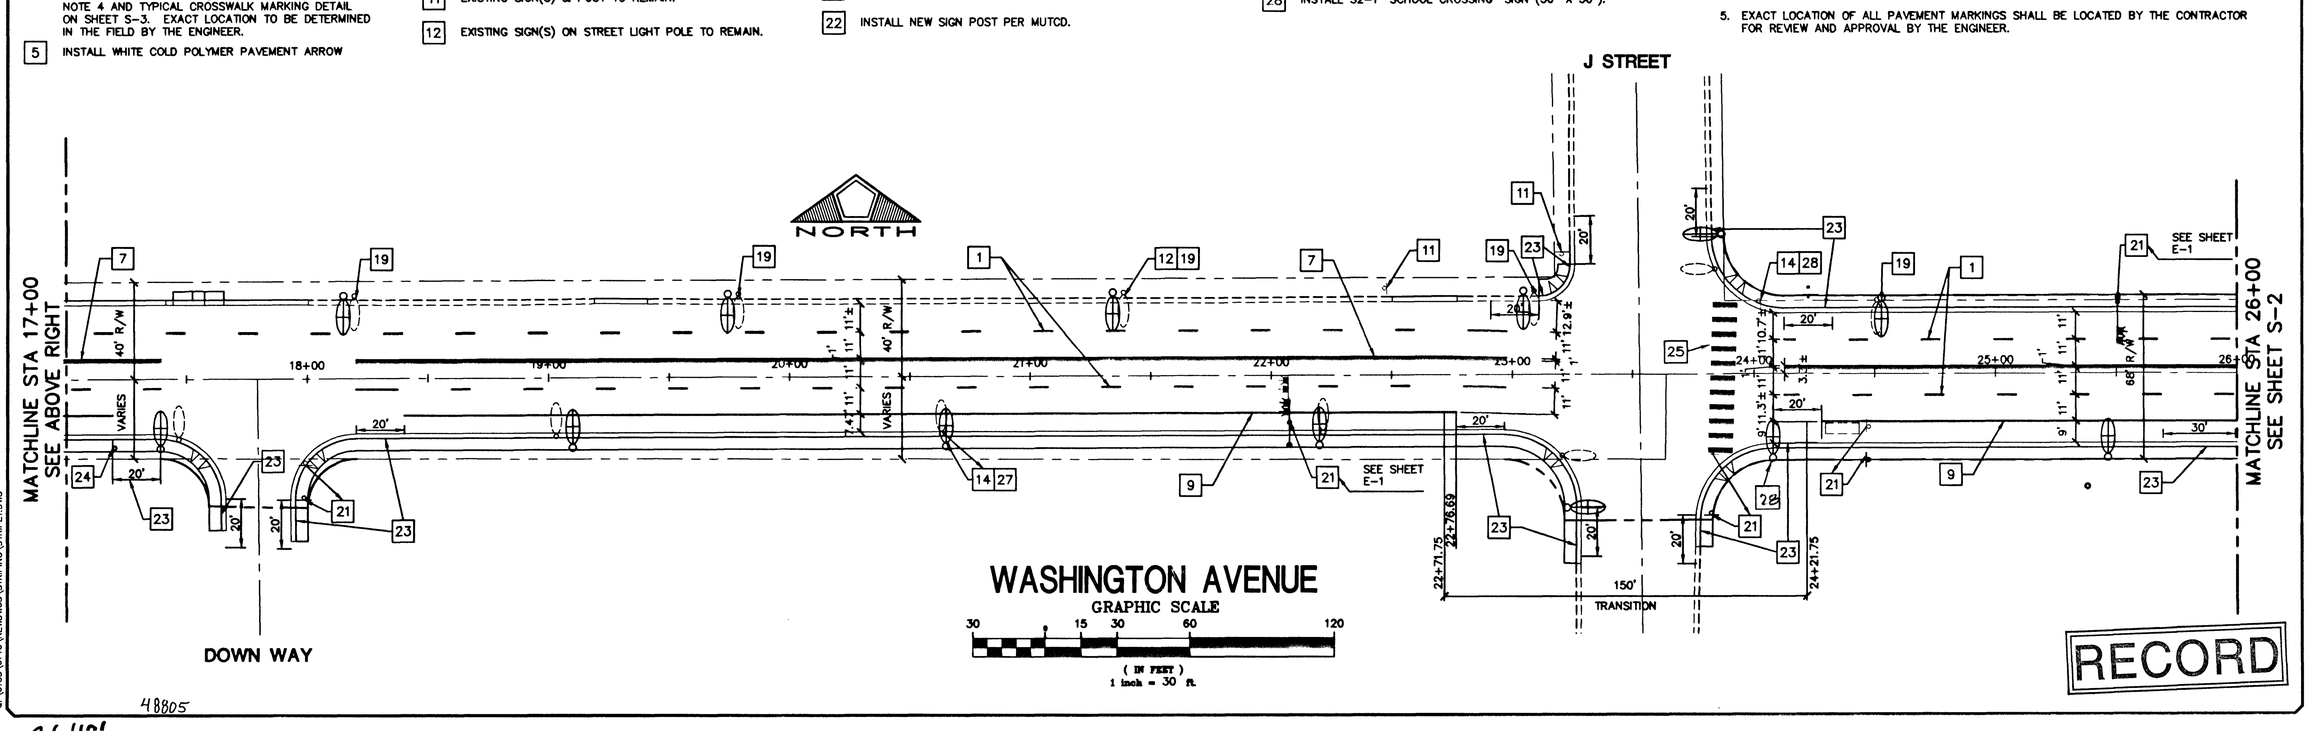

WASHINGTON AVENUE

GRAPHIC SCALE

30 15 30 60 120

(IN FEET)
1 inch = 30 ft.

RECORD

48805

NO.	DESCRIPTION	DATE	APPD

DATE : 03/31/00
PM : MWBT
DRAWN BY : JR.KATA
DESIGNED BY : DF
CHECKED BY : JL
ADA CHECKED :
JOB NO. : 0133.0141
SCALE : AS SHOWN

PENTACORE
CIVIL ENGINEERING • LAND SURVEYING • PLANNING
CONSTRUCTION MANAGEMENT • ADA CONSULTING
6763 WEST CHARLESTON BOULEVARD
LAS VEGAS, NEVADA 89146 (702)258-0115

CITY OF LAS VEGAS
WASHINGTON AVENUE
WASHINGTON AVENUE SIGNING & STRIPING PLAN
STA 8+50 TO STA 26+00

PROFESSIONAL ENGINEER-STATE OF NEVADA
MYRON R. WELSH
CIVIL
NO. 2646
7/12/00

SHEET 24
S-1
OF 56

DWG NO. 107.V2190

Q:\0133\0140\NEWDWGS\STRIPING\STRIPE1.DWG