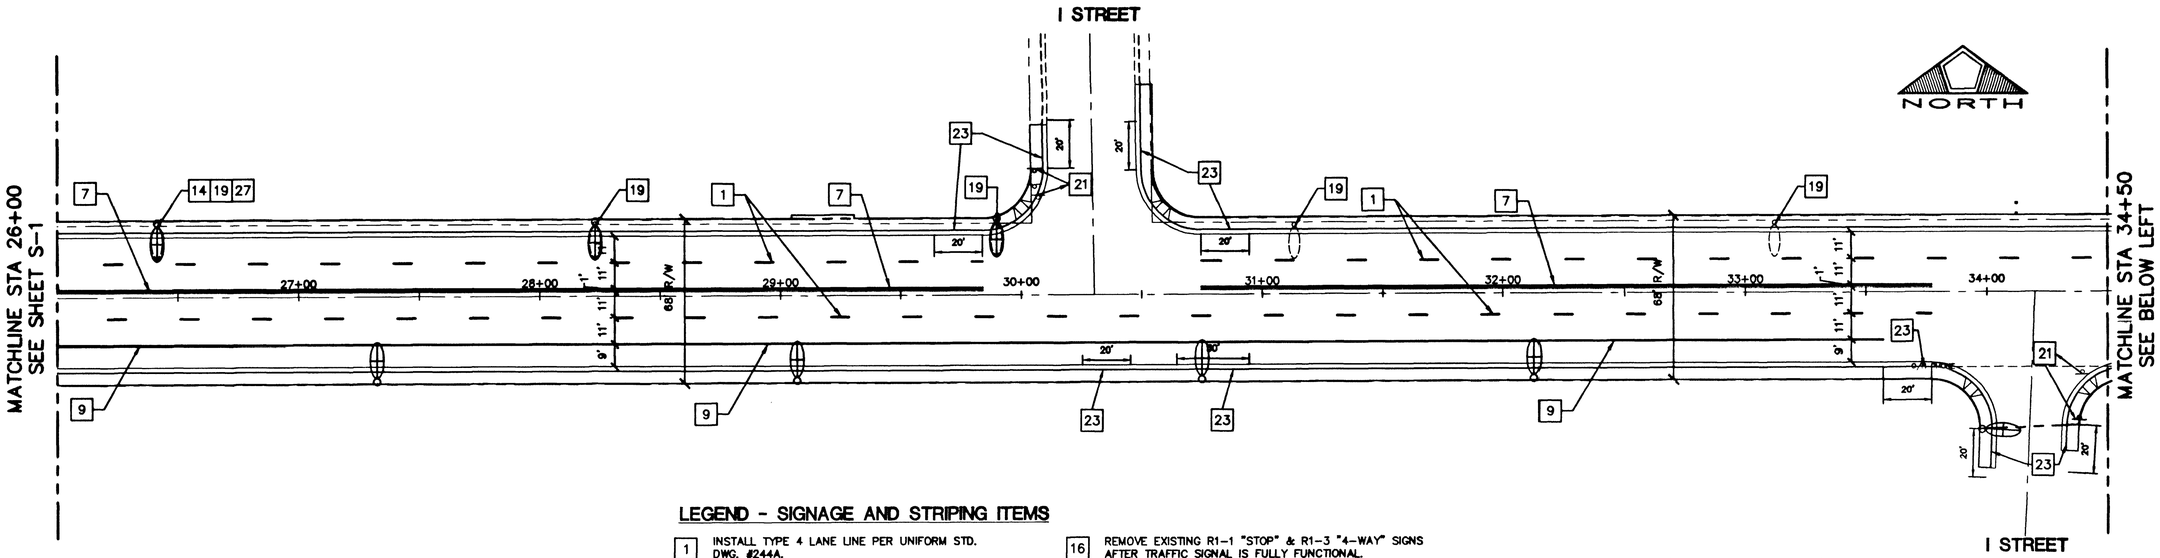

LEGEND - SIGNAGE AND STRIPING ITEMS

1. INSTALL TYPE 4 LANE LINE PER UNIFORM STD. DWG. #244A.
3. INSTALL 24" WIDE STOP BAR USING WHITE COLD POLYMER FILM (4' MINIMUM WIDTH BETWEEN CROSSWALK LINE AND STOP BAR) PER UNIFORM STD. DWG. #254A. SEE GENERAL NOTE 4. EXACT LOCATION TO BE DETERMINED IN THE FIELD BY THE ENGINEER.
4. INSTALL WHITE COLD POLYMER FILM CROSSWALK LINES (12" WIDE AND 10' CLEAR WIDTH BETWEEN LINES) PER UNIFORM STD. DWG. #254A. SEE GENERAL NOTE 4 AND TYPICAL CROSSWALK MARKING DETAIL ON SHEET S-3. EXACT LOCATION TO BE DETERMINED IN THE FIELD BY THE ENGINEER.
5. INSTALL WHITE COLD POLYMER PAVEMENT ARROW.
6. INSTALL WHITE COLD POLYMER PAVEMENT "ONLY" LEGEND. SEE GENERAL NOTE 4.
7. INSTALL TYPE 1 CENTERLINE PER UNIFORM STD. DWG. #244.
9. INSTALL 6" SOLID WHITE LINE USING TYPE II FILM.
11. EXISTING SIGN(S) & POST TO REMAIN.
12. EXISTING SIGN(S) ON STREET LIGHT POLE TO REMAIN.
14. REMOVE & SALVAGE EXISTING SIGN(S).
15. INSTALL R2-1 "SPEED LIMIT 35" SIGN (24" X 30").
16. REMOVE EXISTING R1-1 "STOP" & R1-3 "4-WAY" SIGNS AFTER TRAFFIC SIGNAL IS FULLY FUNCTIONAL.
17. REMOVE EXISTING STREET NAME SIGNS & POST AFTER ILLUMINATED STREET NAME SIGNS ARE INSTALLED & FUNCTIONAL.
18. INSTALL "CAT 208" BUS ROUTE SIGN, SEE DETAIL A, SHEET S-3.
19. INSTALL R8-3A "NO PARKING" SYMBOL (24"X 24") & R7-1AP "ANY TIME W/DOUBLE HEADED ARROW" SYMBOL (24" X 24").
21. RELOCATE EXISTING SIGN(S) & POST.
23. PAINT CURB RED.
24. INSTALL R8-3A "NO PARKING" SYMBOL (24"X 24") & SUPPLEMENTAL PLATE W/LEGEND "HERE TO CORNER" (24" X 24").
26. MATCH EXISTING.
27. INSTALL S1-1 "SCHOOL ADVANCE" SIGN (30" X 30").
29. INSTALL R3-7R "RIGHT LANE MUST TURN RIGHT" SIGN (30" X 30").
30. INSTALL FORCED RIGHT TURN LANE LINE PER UNIFORM STD. DWG. #248A WITH 150' STORAGE & 240' DROP LINE PATTERN, USING RAISED PAVEMENT MARKERS.
31. BEGIN FORCED RIGHT TURN LANE DROP LINE PATTERN AT STA. 7+91.63, END AT STA. 5+51.63 AND MATCH EXISTING STRIPING. INSTALL ONE SET OF PAVEMENT MARKINGS CONTAINING ONE ARROW SYMBOL AND ONE "ONLY" SYMBOL AT THE BEGINNING OF THE DROP LANE, NEAR STA. 5+51.63.

SIGNING & STRIPING GENERAL NOTES

1. THE CONTRACTOR SHALL TAKE ALL PRECAUTIONARY MEASURES NECESSARY TO PROTECT FROM DAMAGE EXISTING IMPROVEMENTS WHICH ARE TO REMAIN IN PLACE. ALL SUCH IMPROVEMENTS AND/OR STRUCTURES DAMAGED BY THE CONTRACTOR'S OPERATIONS SHALL BE REPAIRED OR RECONSTRUCTED SATISFACTORY TO THE ENGINEER AT THE EXPENSE OF THE CONTRACTOR.
2. LANE WIDTH TRANSITIONS OCCUR AT VARIOUS LOCATIONS ALONG THE LENGTH OF THE PROJECT (SEE PLAN CALLOUTS). BEGINNING/ENDING OF LANE TRANSITIONS ARE IDENTIFIED ON THE PLANS.
3. THE CONTRACTOR SHALL PROVIDE PILOT AND ALIGNMENT LINES FOR THE ENGINEER'S APPROVAL PRIOR TO PERFORMING ANY MARKING WORK. CONTACT THE ENGINEER 48 HOURS IN ADVANCE.
4. ALL COLD POLYMER PAVEMENT MARKING FILM SHALL BE TYPE N440 OR APPROVED EQUAL. THE HIGH DURABILITY, INTERSECTION GRADE RETROREFLECTIVE PREFORMED MARKING FILM WITH 3 COAT CONTACT CEMENT APPLICATION SYSTEM, SHALL BE APPLIED AND TAMPED IN ACCORDANCE WITH THE MANUFACTURER'S SPECIFICATIONS. THE MANUFACTURER'S REPRESENTATIVE SHALL BE PRESENT AT THE TIME OF INSTALLATION. ALL APPLICATION METHODS SHALL BE CONFIRMED BY THE CITY TRAFFIC ENGINEER AND MANUFACTURER PRIOR TO INSTALLATION. SAID PAVEMENT MARKING FILM SHALL NOT BE PLACED EARLIER THAN TWO (2) WEEKS AFTER FINAL A.C. LAYER IS PLACED. ALL MATERIALS AND EQUIPMENT SHALL BE IN ACCORDANCE WITH THE MANUFACTURER'S SPECIFICATIONS. THE CONTRACTOR SHALL PROVIDE TEMPORARY PAVEMENT MARKINGS AS NEEDED.
5. EXACT LOCATION OF ALL PAVEMENT MARKINGS SHALL BE LOCATED BY THE CONTRACTOR FOR REVIEW AND APPROVAL BY THE ENGINEER. NOTIFY TRAFFIC DIVISION FIELD OPERATIONS 48 HOURS PRIOR TO PERFORMING ANY PAVEMENT MARKING WORK.

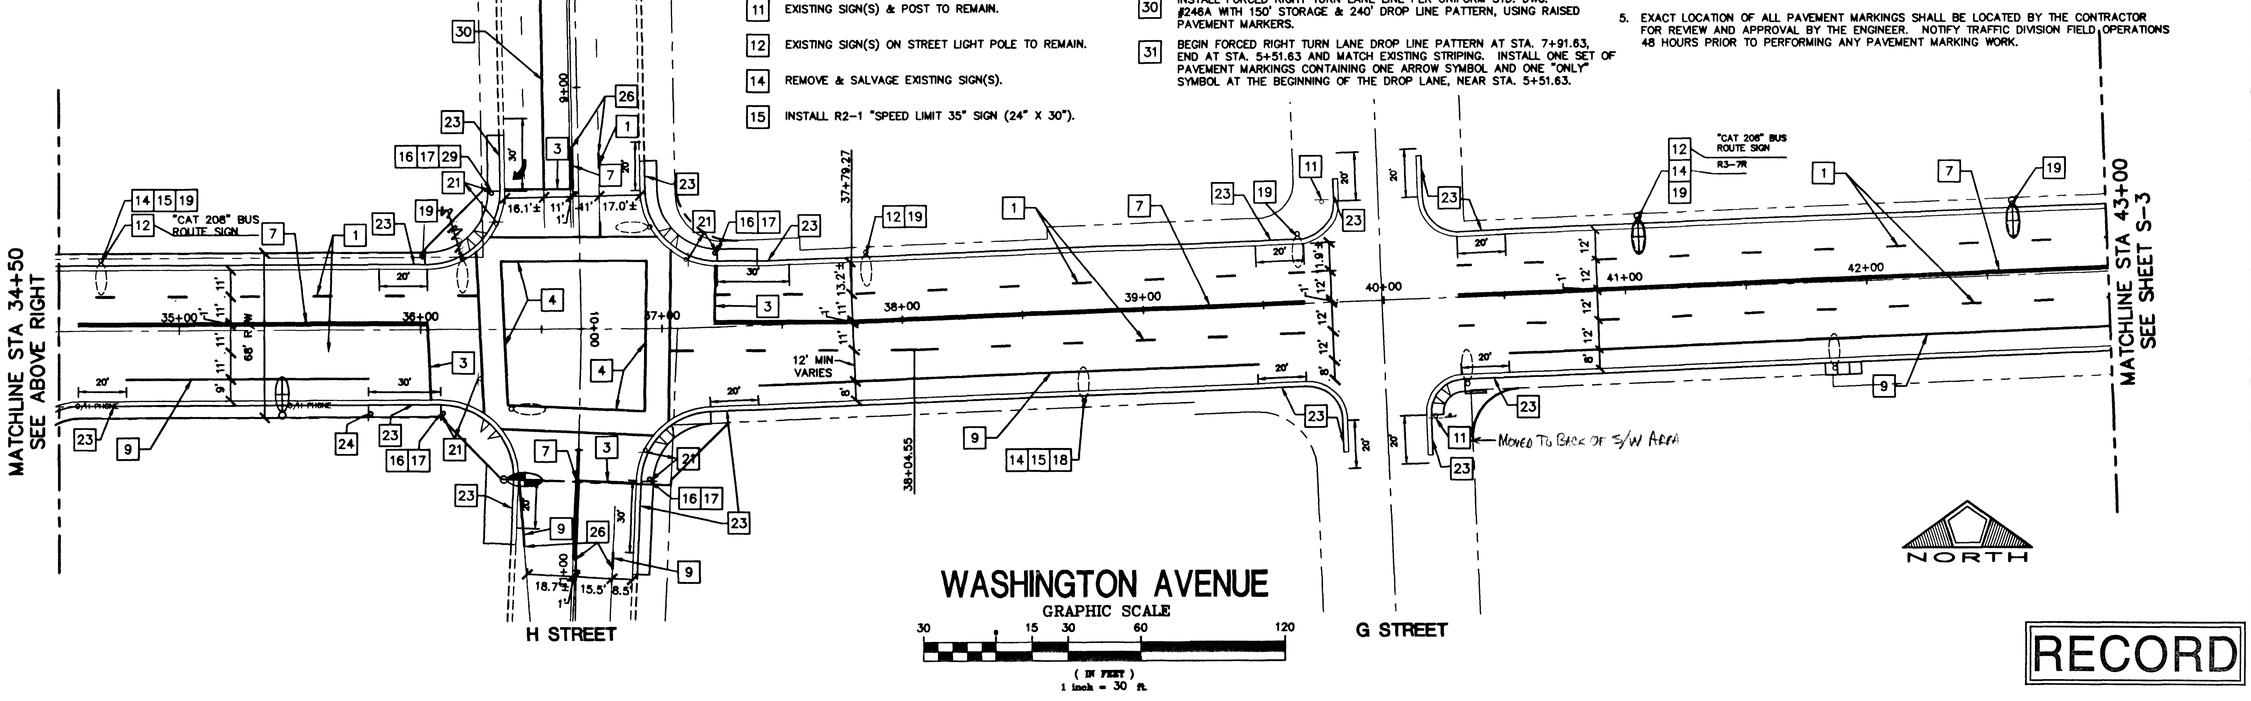

WASHINGTON AVENUE

GRAPHIC SCALE

30 15 30 60 120

(IN FEET)

1 inch = 30 ft.

RECORD

NO.	DESCRIPTION	DATE	APPD

DATE : 03/31/00
PM : MWBT
DRAWN BY : JR/KATA
DESIGNED BY : DF
CHECKED BY : JL
ADA CHECKED :
JOB NO. : 0133.0141
SCALE : AS SHOWN

PENTACORE
CIVIL ENGINEERING • LAND SURVEYING • PLANNING
CONSTRUCTION MANAGEMENT • ADA CONSULTING
6763 WEST CHARLESTON BOULEVARD
LAS VEGAS, NEVADA 89146 (702)258-0115

CITY OF LAS VEGAS
WASHINGTON AVENUE
WASHINGTON AVENUE SIGNING & STRIPING PLAN
STA 26+00 TO STA 43+00

PROFESSIONAL ENGINEER-STATE OF NEVADA
MYRON R. WELSH
CIVIL
No. 2646
12/00

SHEET 23
S-2
OF 50

DWG NO. 107-V2119

48806

G:\0133\0140\NEWDWGS\STRIPING\STRIPE2.DWG Mar 31 00 03:38:41 2000