


CONSTRUCTION ITEMS

- 1 PROTECT IN PLACE
- 4 REMOVE
- 5 RELOCATE BY OTHERS
- 15 REMOVE AND RESET
- 51 CONSTRUCT 18" RCP OR RGRP. SEE LATERAL PROFILE SHEETS
- 52 CONSTRUCT 24" RCP OR RGRP. SEE LATERAL PROFILE SHEETS
- 53 CONSTRUCT 36" RCP
- 55 60" x 38" VERTICAL ELLIPTICAL RCP
- 56 CONSTRUCT 48" TYPE 1 SD OR SS MANHOLE PER C.C.U.S.D. DWG. NO. 403 (30" DIAMETER OPENINGS) IN RCB INSTALL RUNGS PER SECTION A SHEET U-23
- 57 CONSTRUCT 60" TYPE 1 SD MANHOLE PER C.C.U.S.D. DWG. NO. 403
- 58 CONSTRUCT 54" RCP
- 59 ABANDON IN PLACE - FOR RCP, SEE DETAIL 6 SHEET U-26
- 62 INSTALL PLUG SEE DETAIL 6 SHEET U-26
- 63 CONSTRUCT 7'x6' PRECAST RCB
- 64 CONSTRUCT 9'x6' PRECAST RCB

WASHINGTON AVENUE

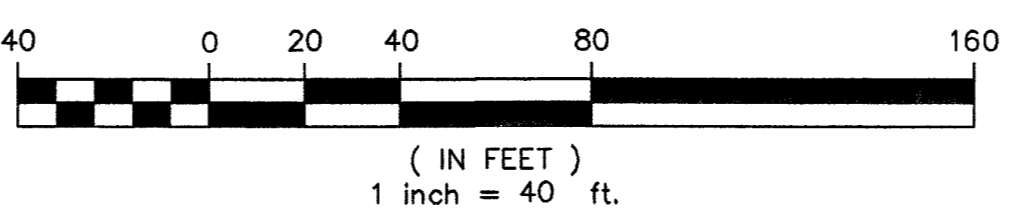

GENERAL NOTES

1. RCB JOINTS SHALL BE MORTAR GROUTED ON THE INSIDE FACE AND OUTSIDE FACE, ALL SIDES, EXCEPT BOTTOM, UNLESS NOTED OTHERWISE, IN WHICH CASE, A CONCRETE COLLAR WILL BE UTILIZED.
2. PRIOR TO TRENCHING AT THE INTERSECTION OF MARTIN LUTHER KING AND WASHINGTON, THE CONTRACTOR SHALL NOTIFY THE CITY LAS VEGAS TO LOCATE EXISTING TRAFFIC SIGNAL CONDUITS AND WIRES. THE CONTRACTOR SHALL PROTECT-IN-PLACE ALL TRAFFIC SIGNAL CONDUITS AND WIRES.
3. Three-inch (3") diameter weep holes shall be placed in both walls of the RCB at a height of six inches (6") above the invert of the RCB. The Maximum distance between the weep holes will be ten-feet (10'). Screens or grates shall be placed at the outside of the weep hole to prevent the backfill material from entering into the RCB (see attached detail).
Cost of the weep holes will not be paid for separately but will be included in the contract unit price bid for the RCB. Drawg U-26 (Back)


Avoid hitting overhead power lines. It's costly.

Call before you do Overhead
1-702-593-6111

Avoid cutting underground utility lines. It's costly.

Call before you Dig.
1-800-227-2600
UNDERGROUND SERVICE ALERT (USA)

RECORD

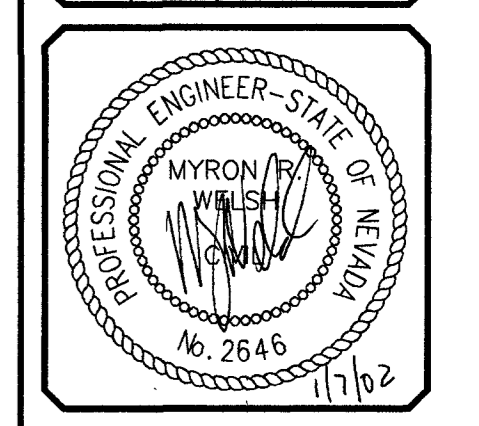

SHEET
U-1
OF 59

DWG. NO. 107-V3119

DATE:	02/10/00
PM:	MWB/T
DRAWN BY:	JRL/WTA
CHECKED BY:	JLBT
ADA CHECKED:	JLBT
JOB NO.:	0133.0141
SCALE:	AS SHOWN
NO.	DESCRIPTION
1	REVISE STORM DRAIN LATERALS
	DATE
	12/27/01
	APP'D

PENTACORE
CIVIL ENGINEERING - LAND SURVEYING - PLANNING
CONSTRUCTION MANAGEMENT - ADA CONSULTING
6783 WEST CHARLESTON BOULEVARD
LAS VEGAS, NEVADA 89146 (702)258-0115

CITY OF LAS VEGAS
WASHINGTON AVENUE
UTILITY PLAN & PROFILE
STA 7+00 TO STA 18+00

Q:\0133\0140\NEW\DWGS\UTILITY\U-001.DWG

48811