


NOTES:  
 1. AT THE CONTRACTORS OPTION, ELBOWS MAY BE PRECAST BY RCP MANUFACTURER  
 • 8" MIN. COLLAR DEPTH, MORE IF CMP

**CASE A: HORIZ. AND OR VERTICAL ANGLE PT. CONNECTIONS**

NOT TO SCALE


4

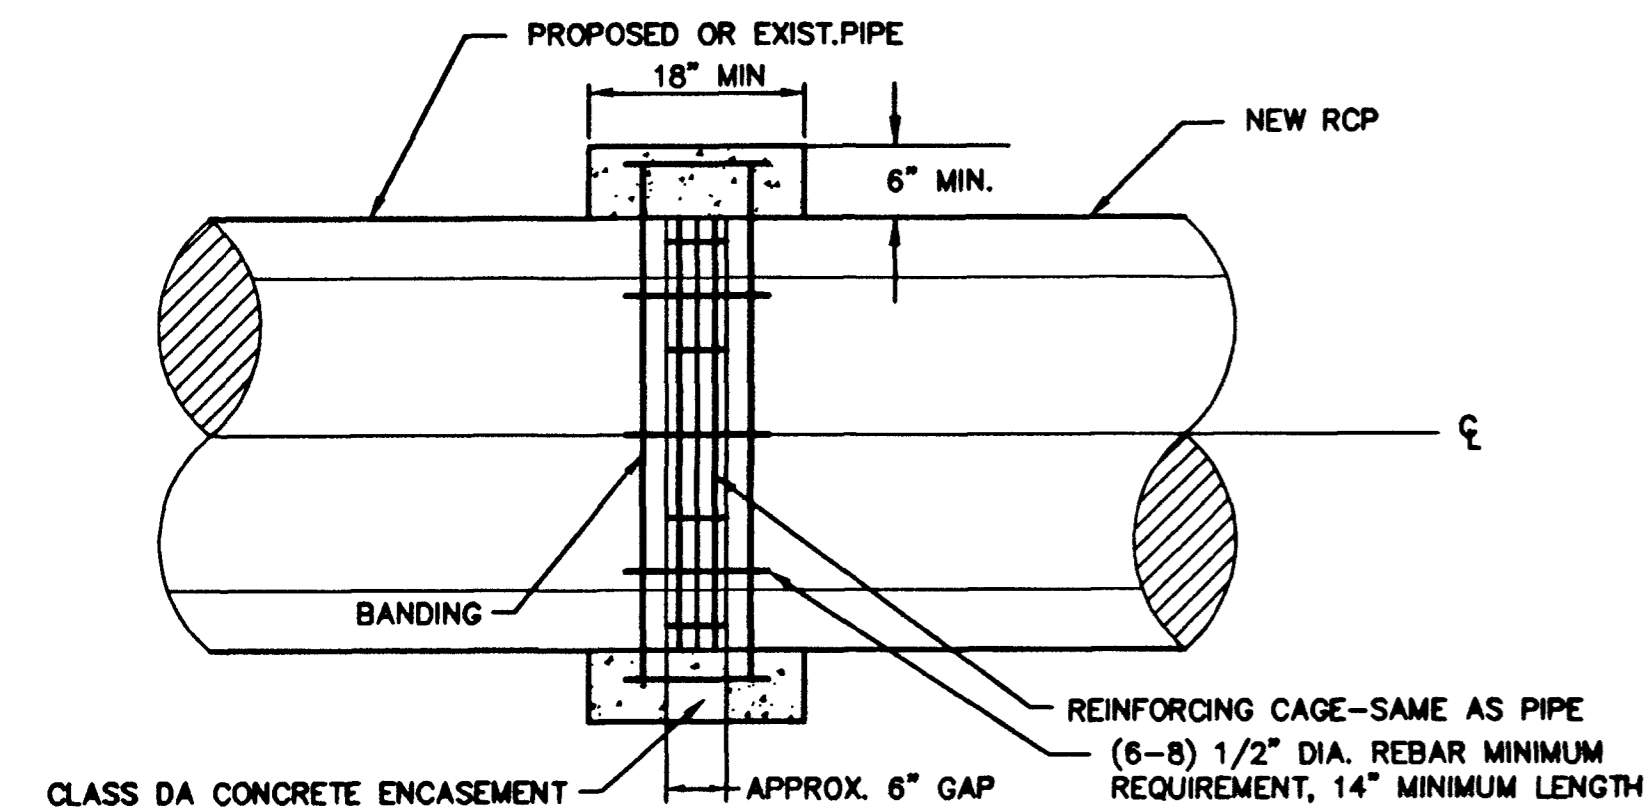

**CASE B: TANGENT PIPE CONNECTIONS**

NOT TO SCALE

5

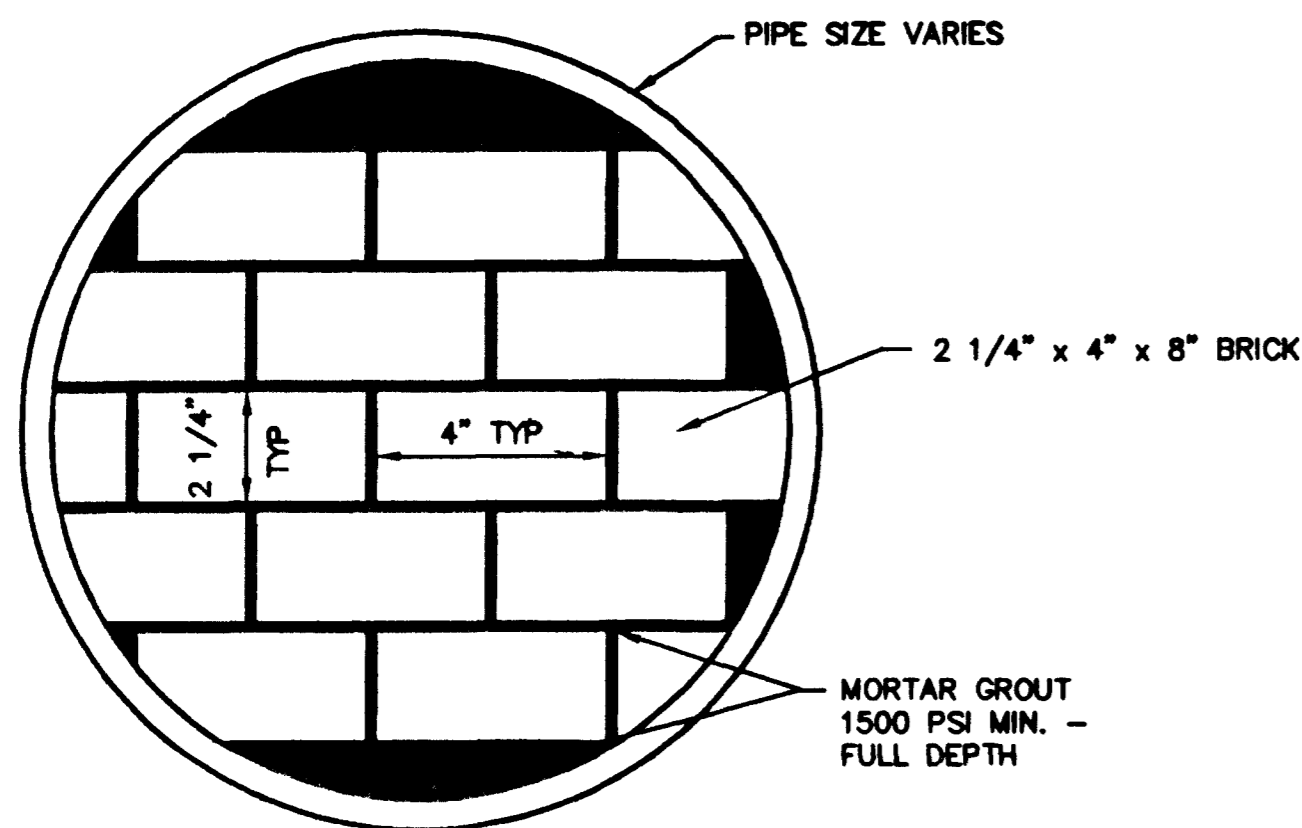


**PIPE PLUG DETAIL**

NOT TO SCALE

6

1. SEE SECTION 208 OF THE UNIFORM STANDARD SPECIFICATIONS FOR CLARK COUNTY FOR ADDITIONAL INFORMATION AND SAFETY REQUIREMENTS.  
 2. IF CRUSHED ROCK IS USED TO BACKFILL THE RCB, THEN A DAM OF IMPERVIOUS MATERIAL SHALL BE PLACED AROUND THE RCB (SEE WRITTEN ADDENDUM). 2' CLASS DA CONC DAMS @ 300'

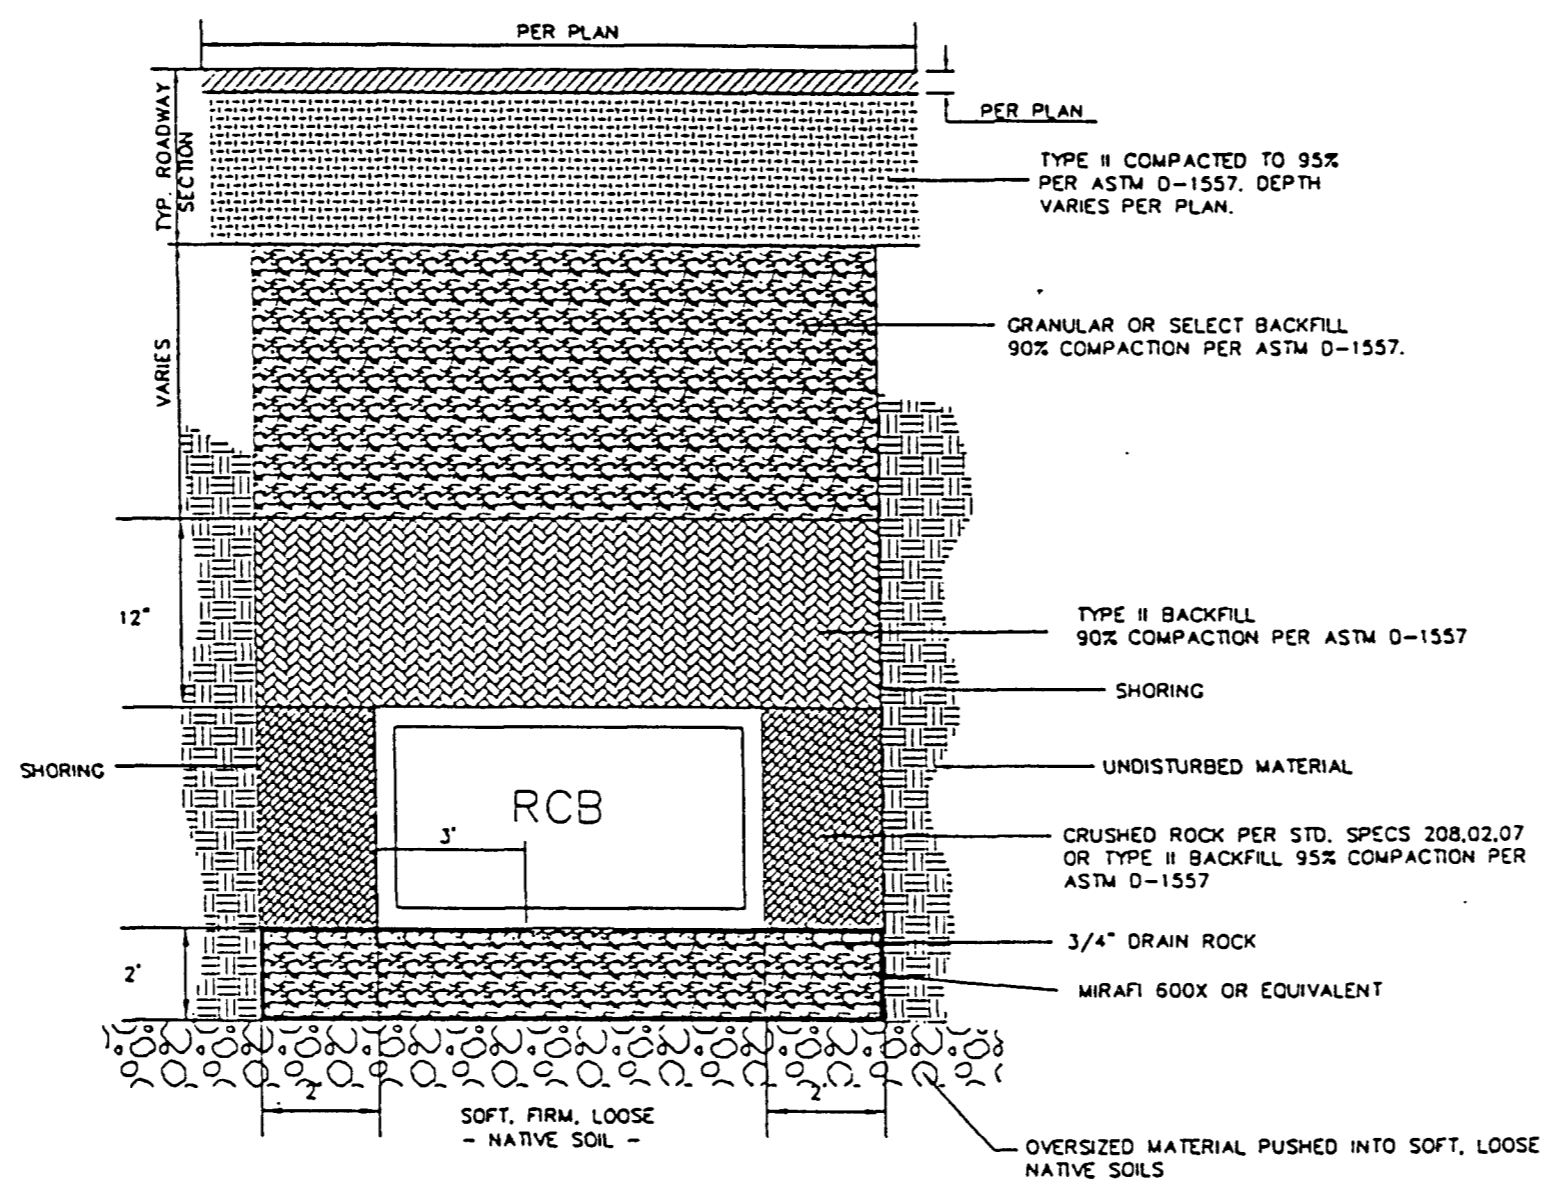


**B STREET  
 TYPICAL RCB TRENCH DETAILS  
 RCB STA 70+50 TO RCB STA 100+20**


NOT TO SCALE

1

CITY OF LAS VEGAS  
 WASHINGTON AVENUE  
 ADDENDUM NO. 1



**PENTACORE**  
 CIVIL ENGINEERING • TRANSPORTATION  
 LAND SURVEYING • PLANNING  
 CONSTRUCTION MANAGEMENT • ADA CONSULTING  
 6763 WEST CHARLESTON BOULEVARD  
 LAS VEGAS, NEVADA 89146 (702)258-0115

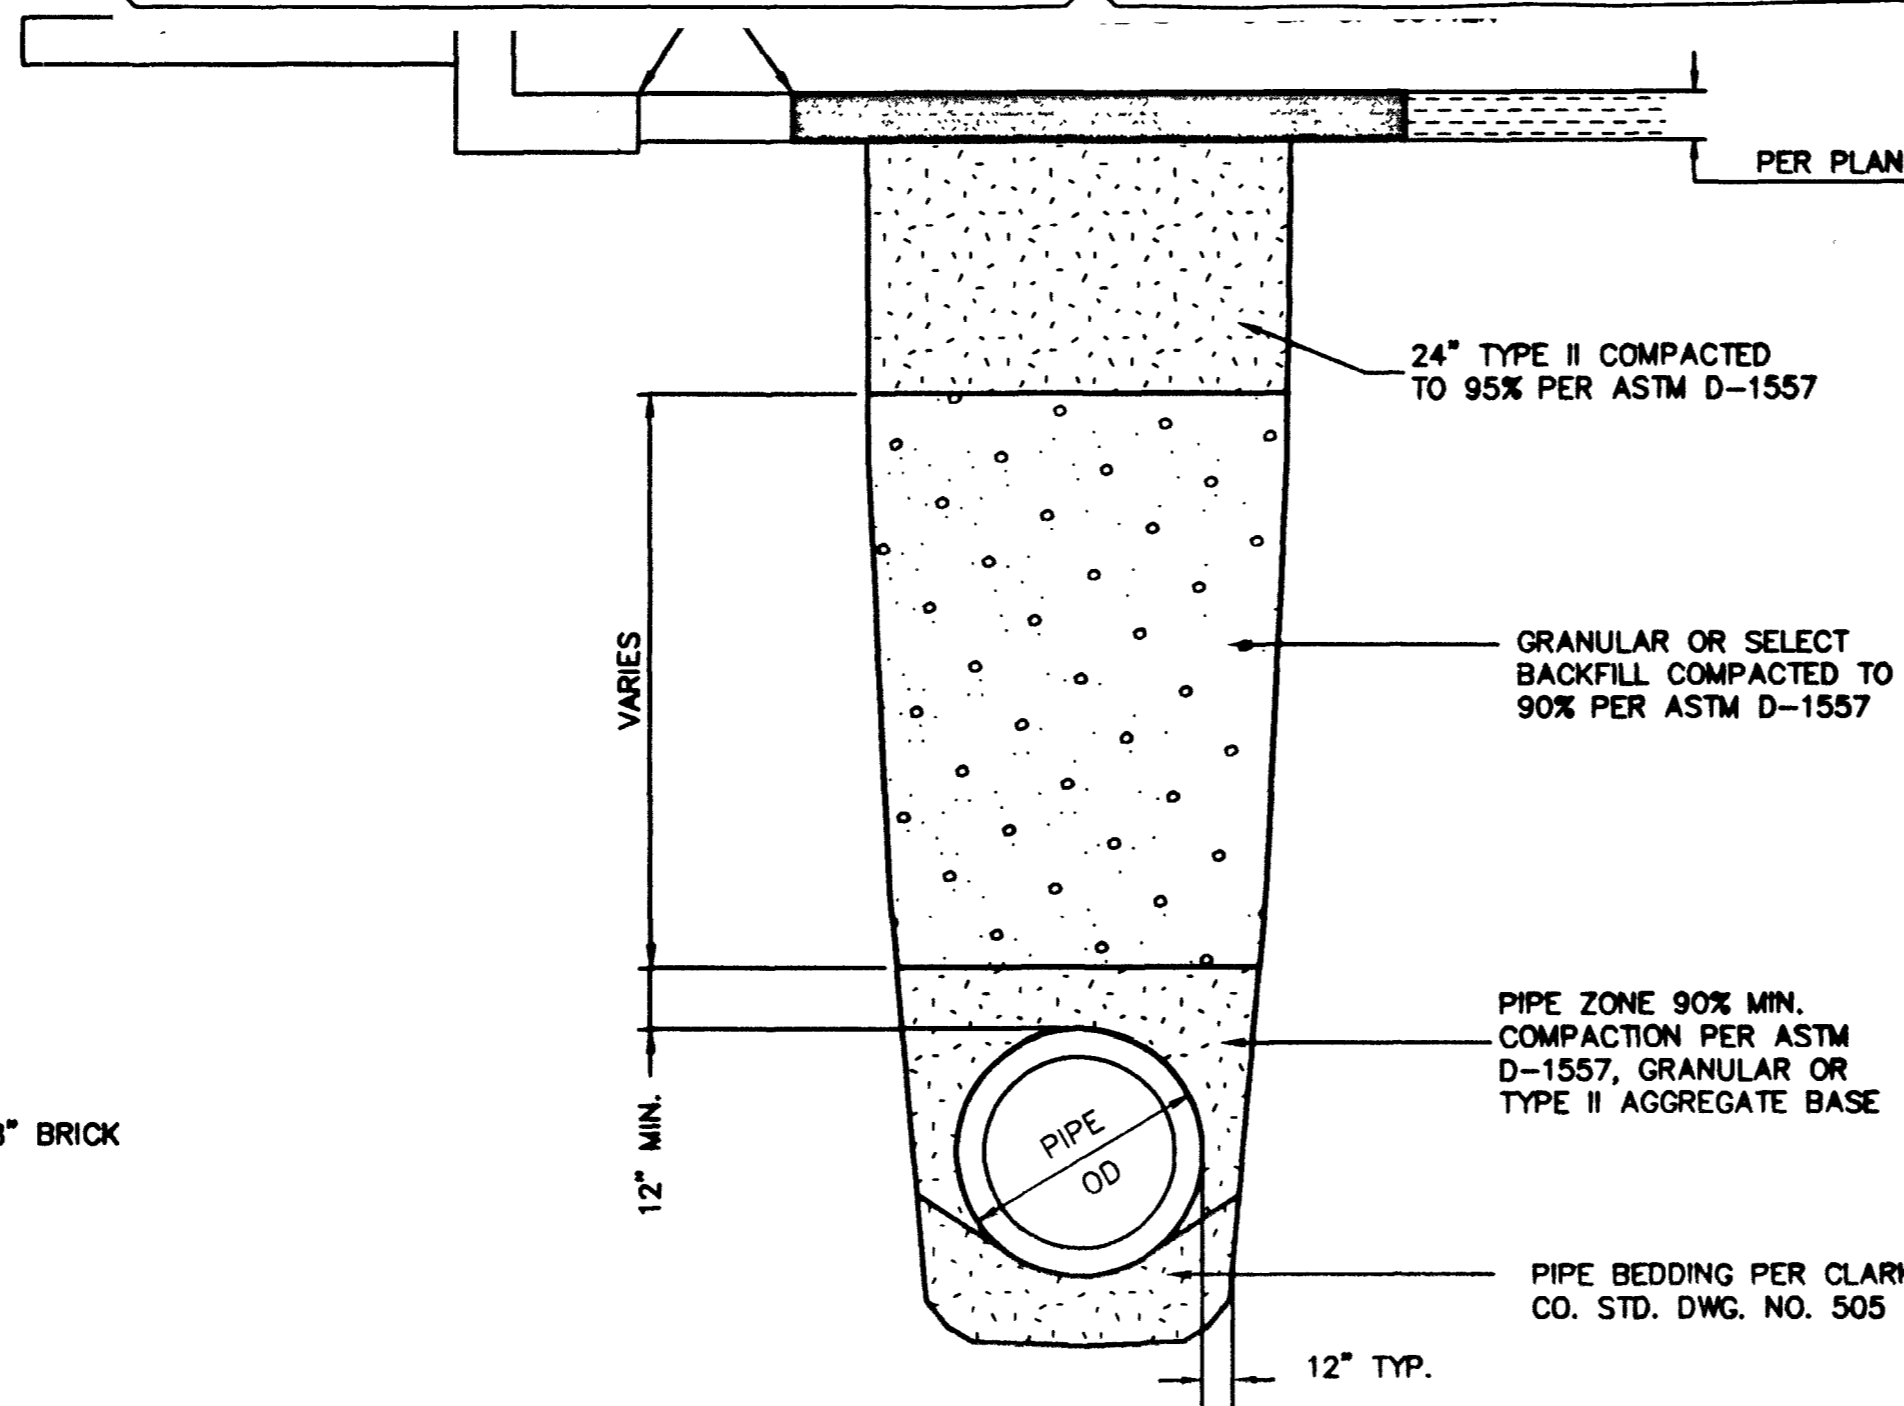


NOTE:  
 SEE SECTION 208 OF THE UNIFORM STANDARD SPECIFICATIONS FOR CLARK COUNTY FOR ADDITIONAL INFORMATION AND SAFETY REQUIREMENTS.

**TYPICAL STORM DRAIN PIPE TRENCH DETAIL**

NOT TO SCALE


2

NOTE:  
 SEE SECTION 208 OF THE UNIFORM STANDARD SPECIFICATIONS FOR CLARK COUNTY FOR ADDITIONAL INFORMATION AND SAFETY REQUIREMENTS.

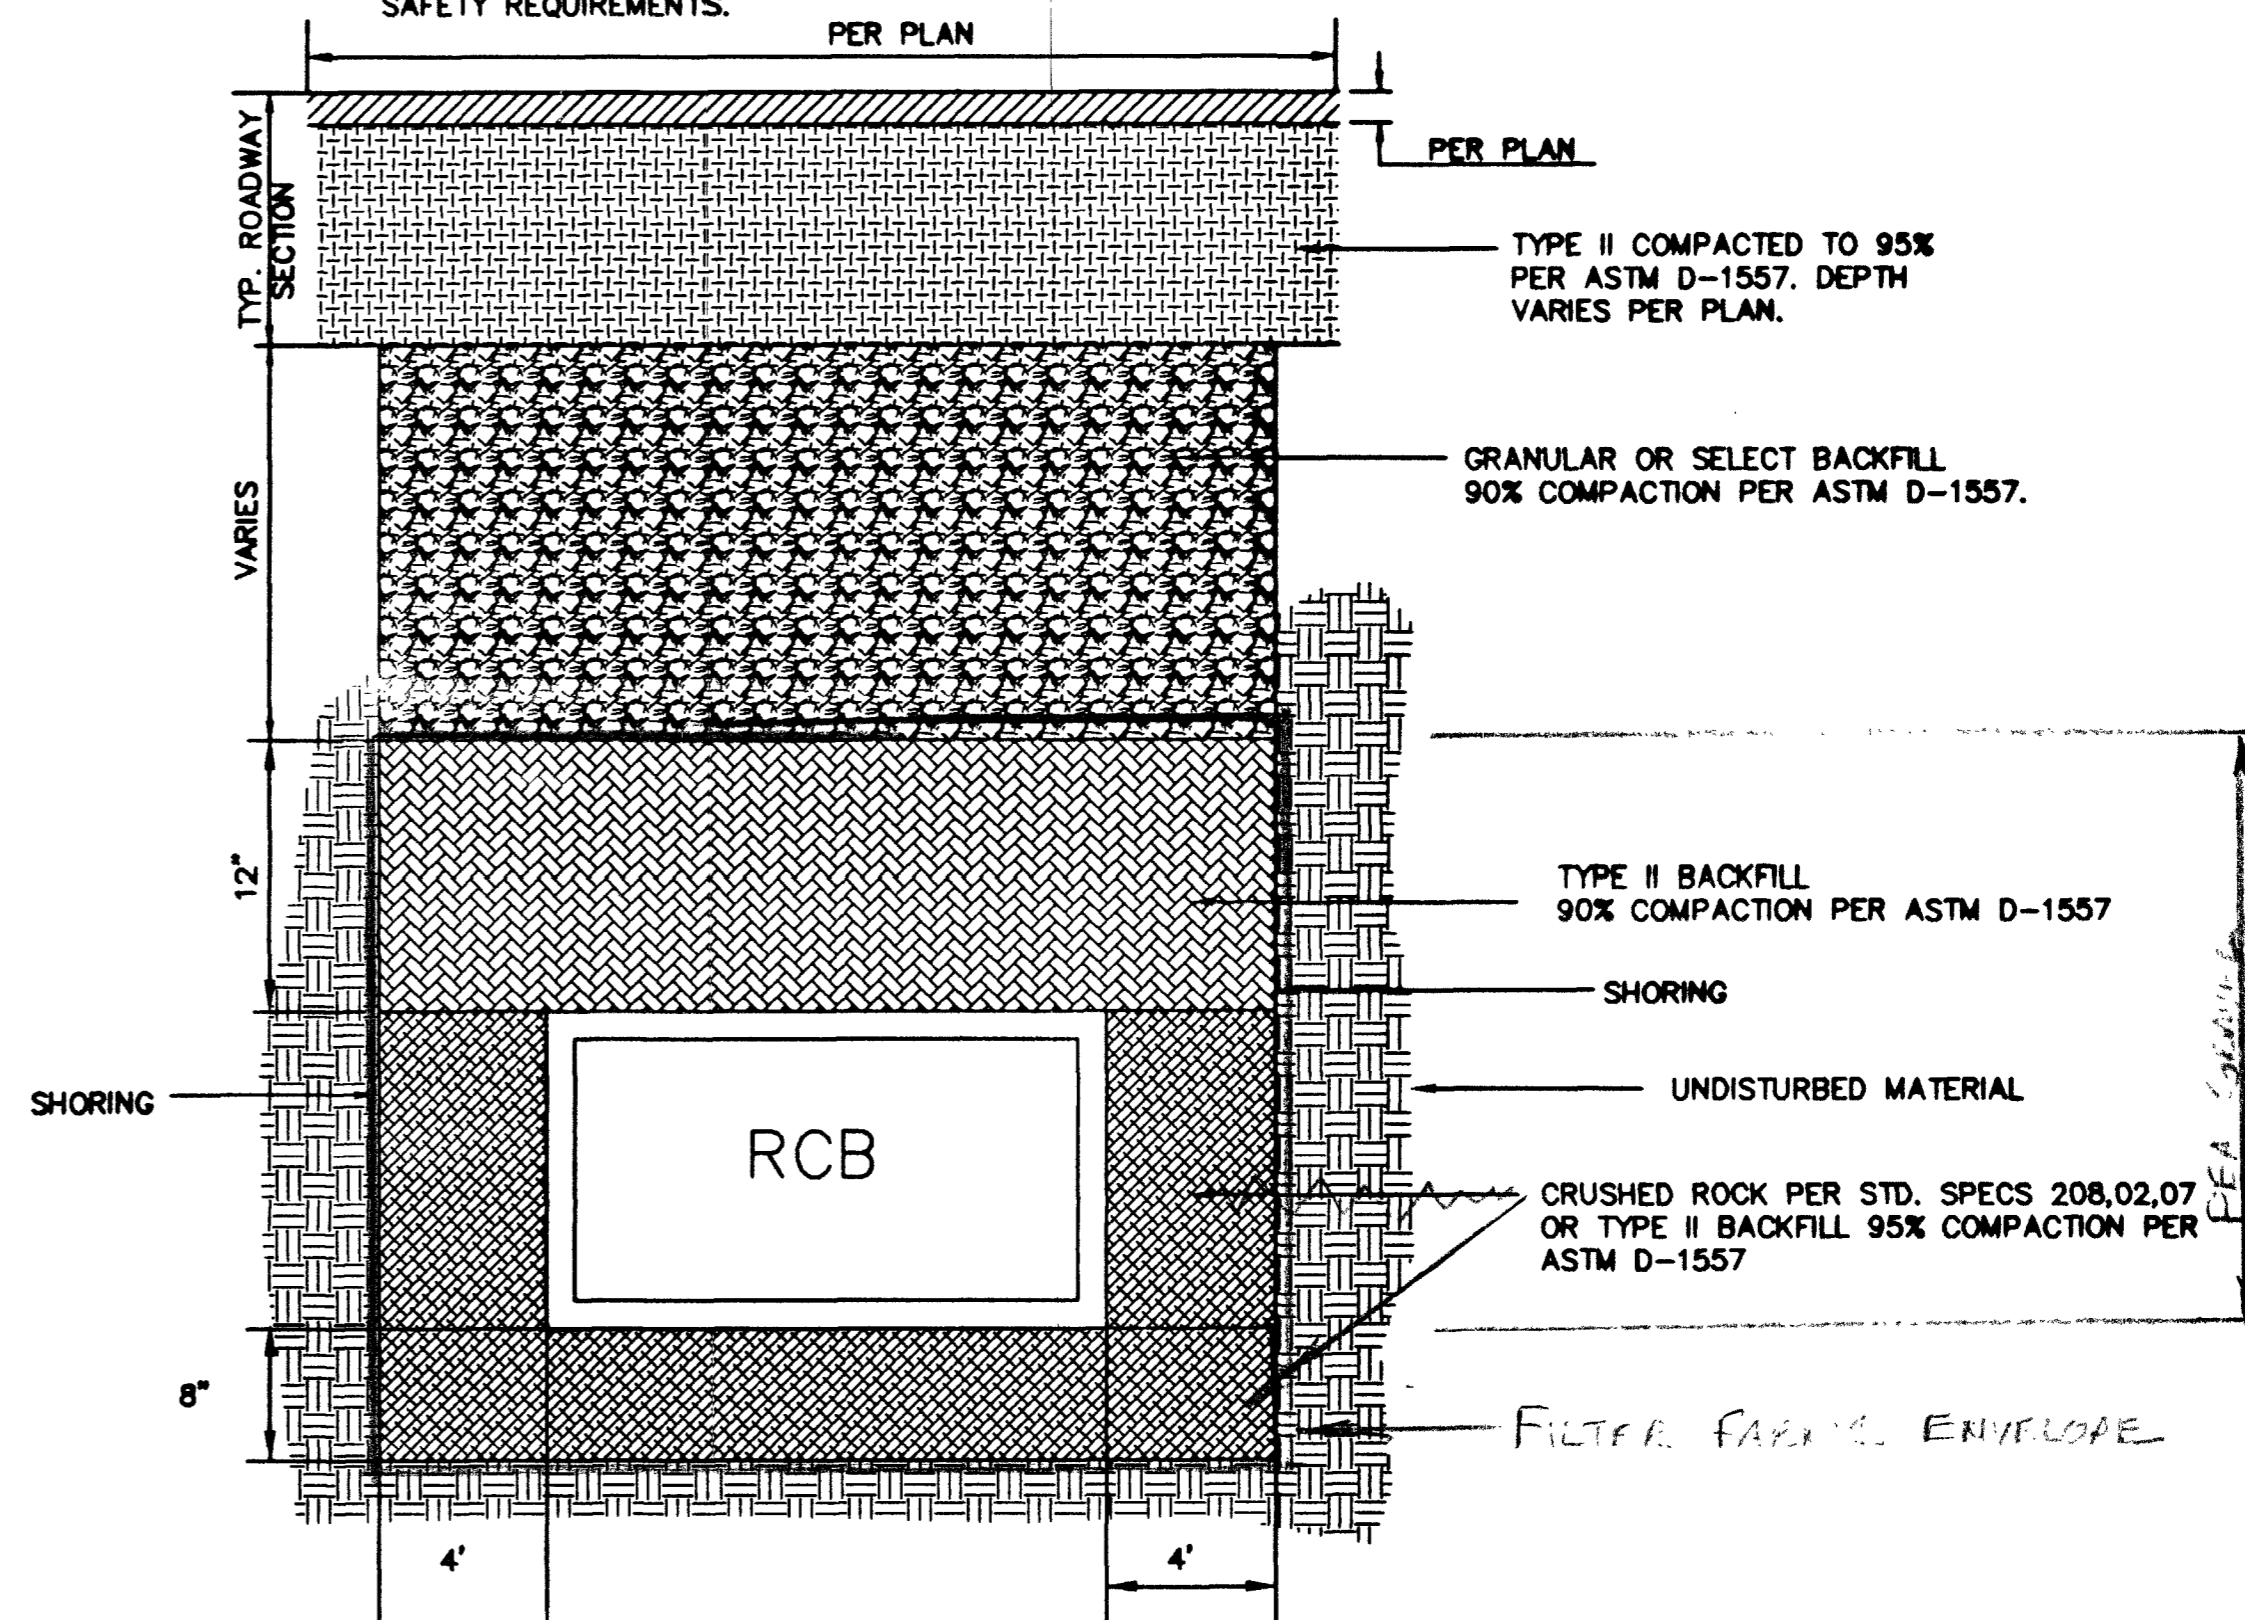

**WASHINGTON AVENUE  
 RCB STA 8+50 TO RCB STA 70+50**

NOTE:  
 SEE SECTION 208 OF THE UNIFORM STANDARD SPECIFICATIONS FOR CLARK COUNTY FOR ADDITIONAL INFORMATION AND SAFETY REQUIREMENTS.

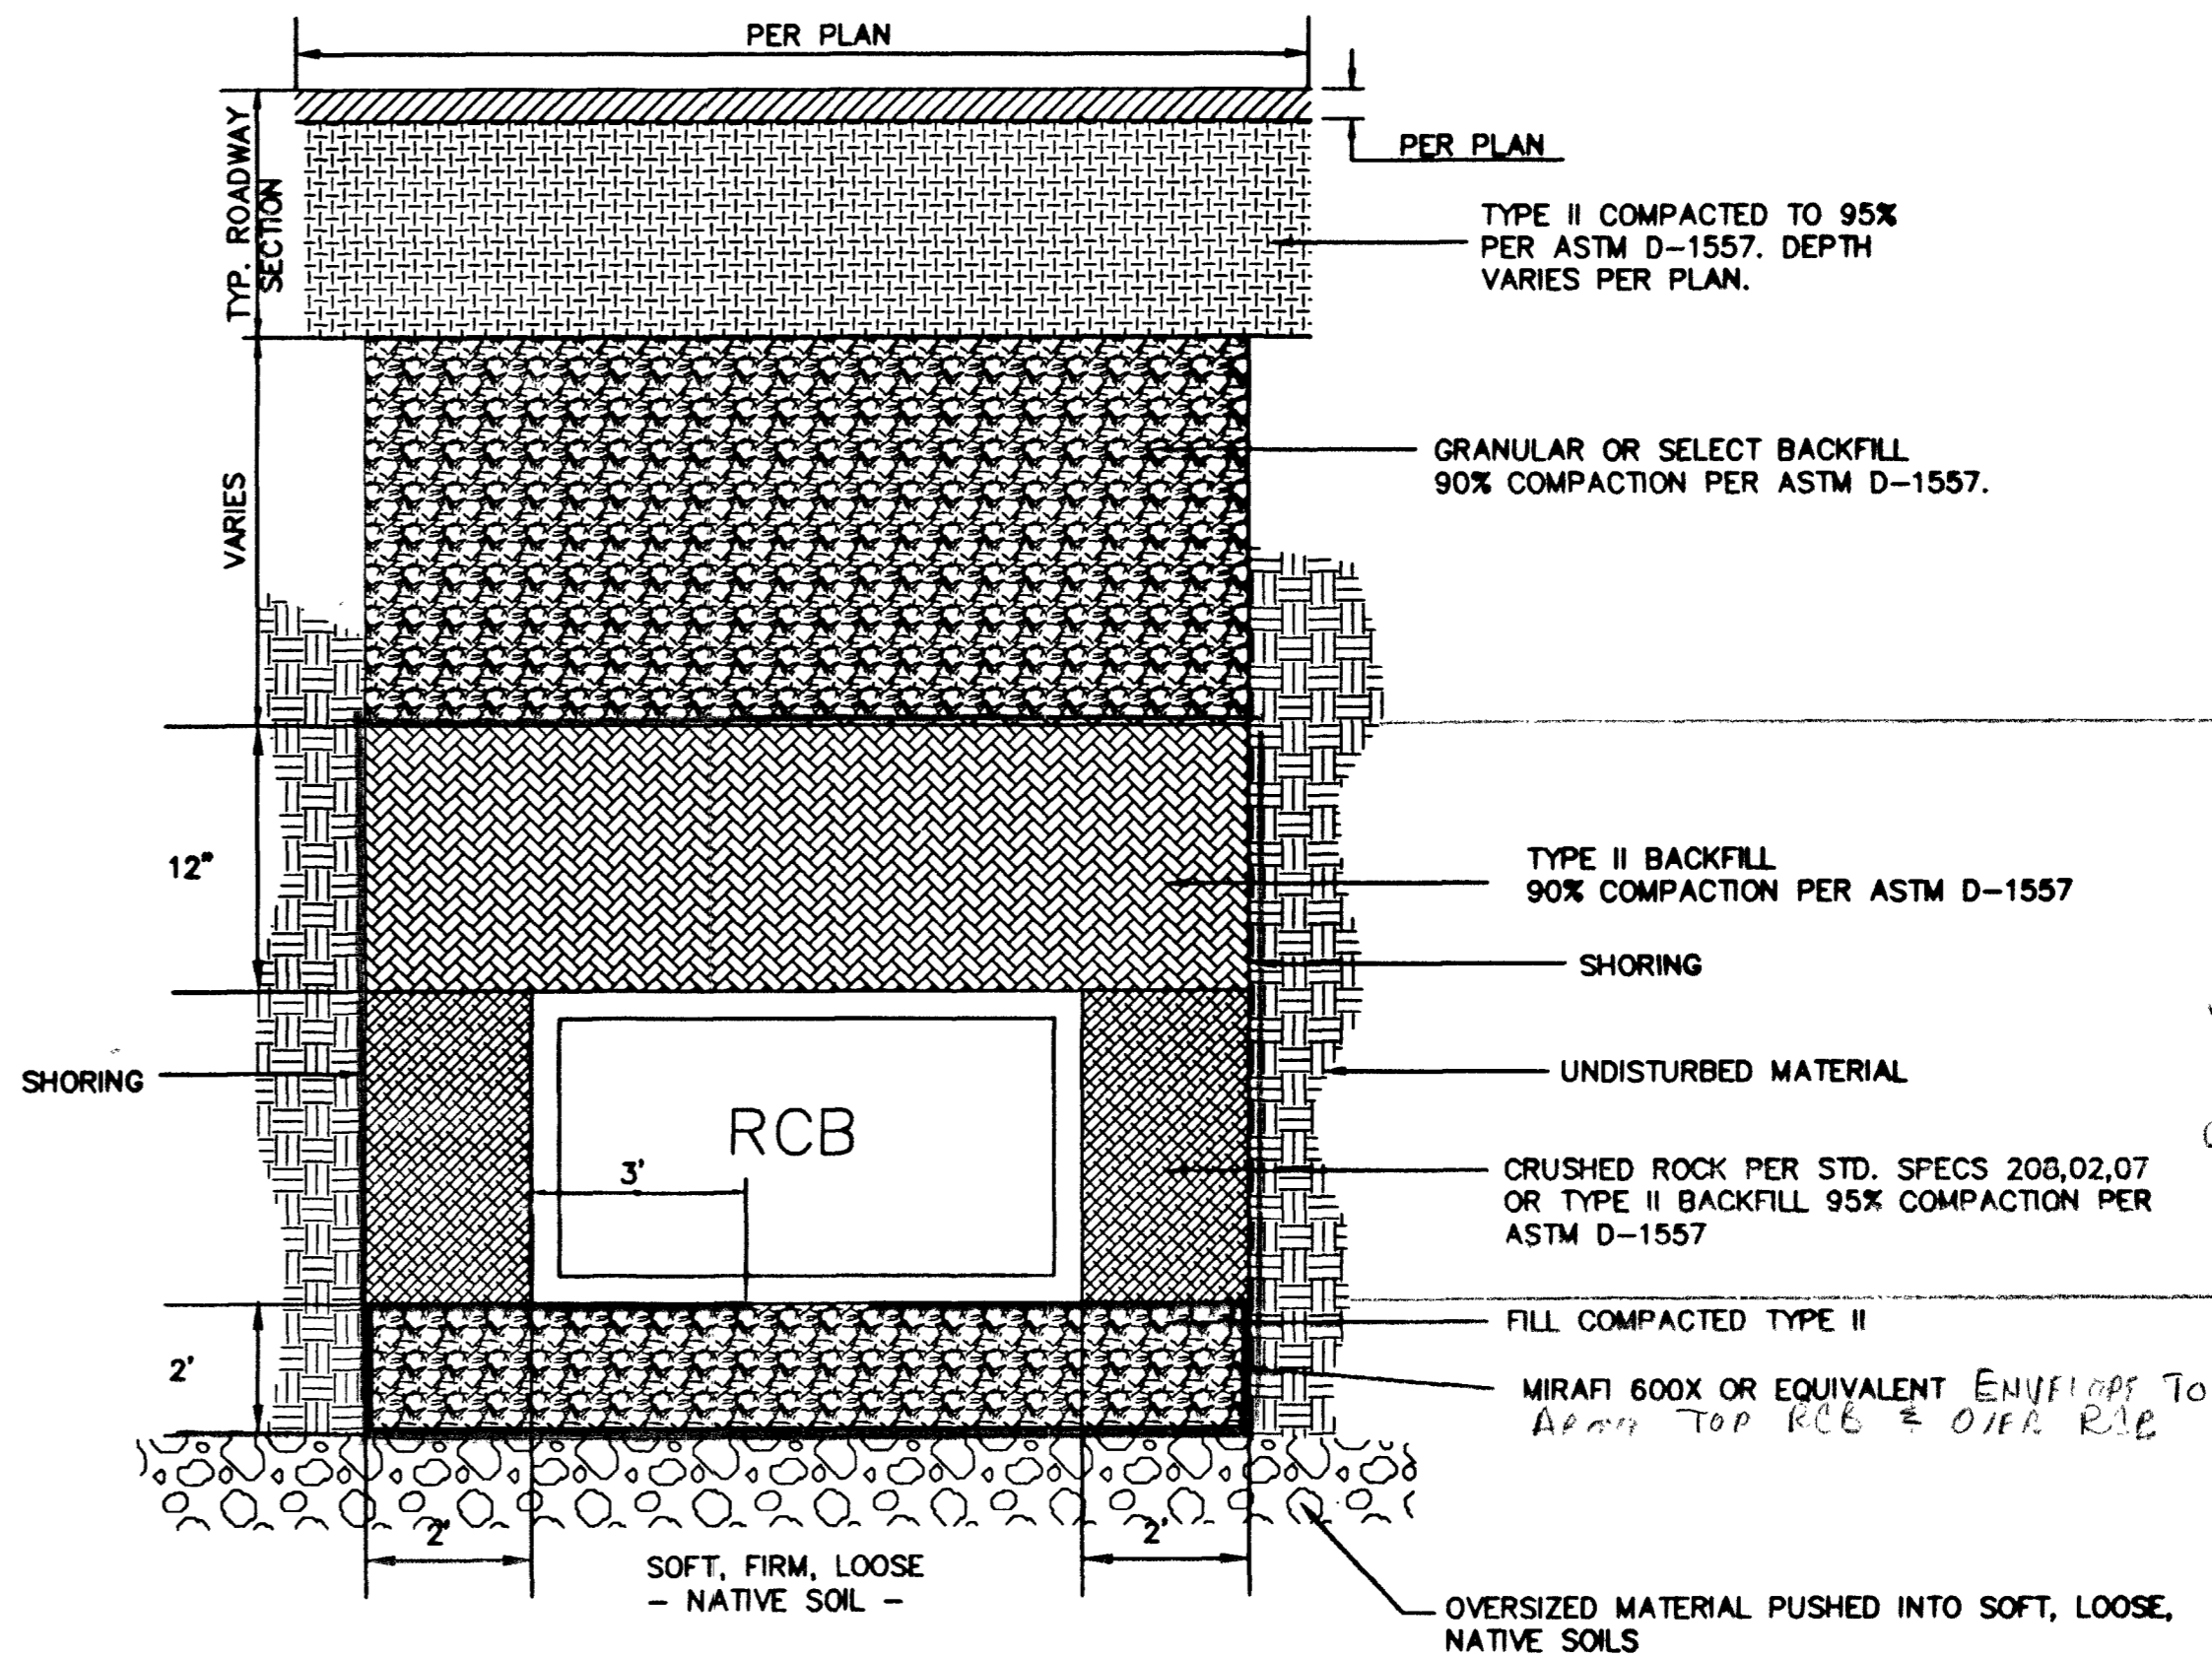

**B STREET  
 TYPICAL RCB TRENCH DETAILS  
 RCB STA 70+50 TO RCB STA 100+20**


NOT TO SCALE

**RECORD**


1

DATE: 02/10/09	DRAWN BY: JRL/MTA	CHECKED BY: JLT	JOB NO.: 0133.0141	SCALE: AS SHOWN
APP'D:	DATE:	DESCRIPTION:	NO.:	DATE:

**PENTACORE**  
 CIVIL ENGINEERING • LAND SURVEYING • PLANNING  
 CONSTRUCTION MANAGEMENT • ADA CONSULTING  
 6763 WEST CHARLESTON BOULEVARD  
 LAS VEGAS, NEVADA 89146 (702)258-0115

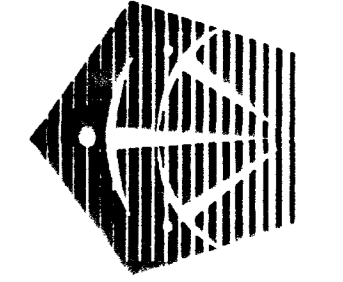

CITY OF LAS VEGAS  
 WASHINGTON AVENUE  
 MISCELLANEOUS STORM DRAIN DETAILS - 1

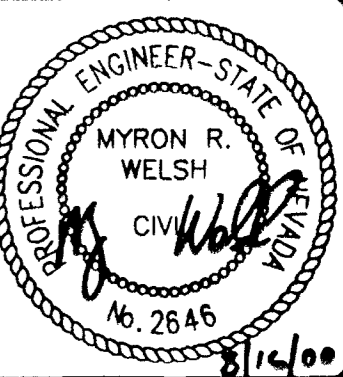

SHEET 57  
**U-26**  
 OF 59

DWG. NO. 107-V3119

48833  
 26529