


JOB NO. 5502.0070

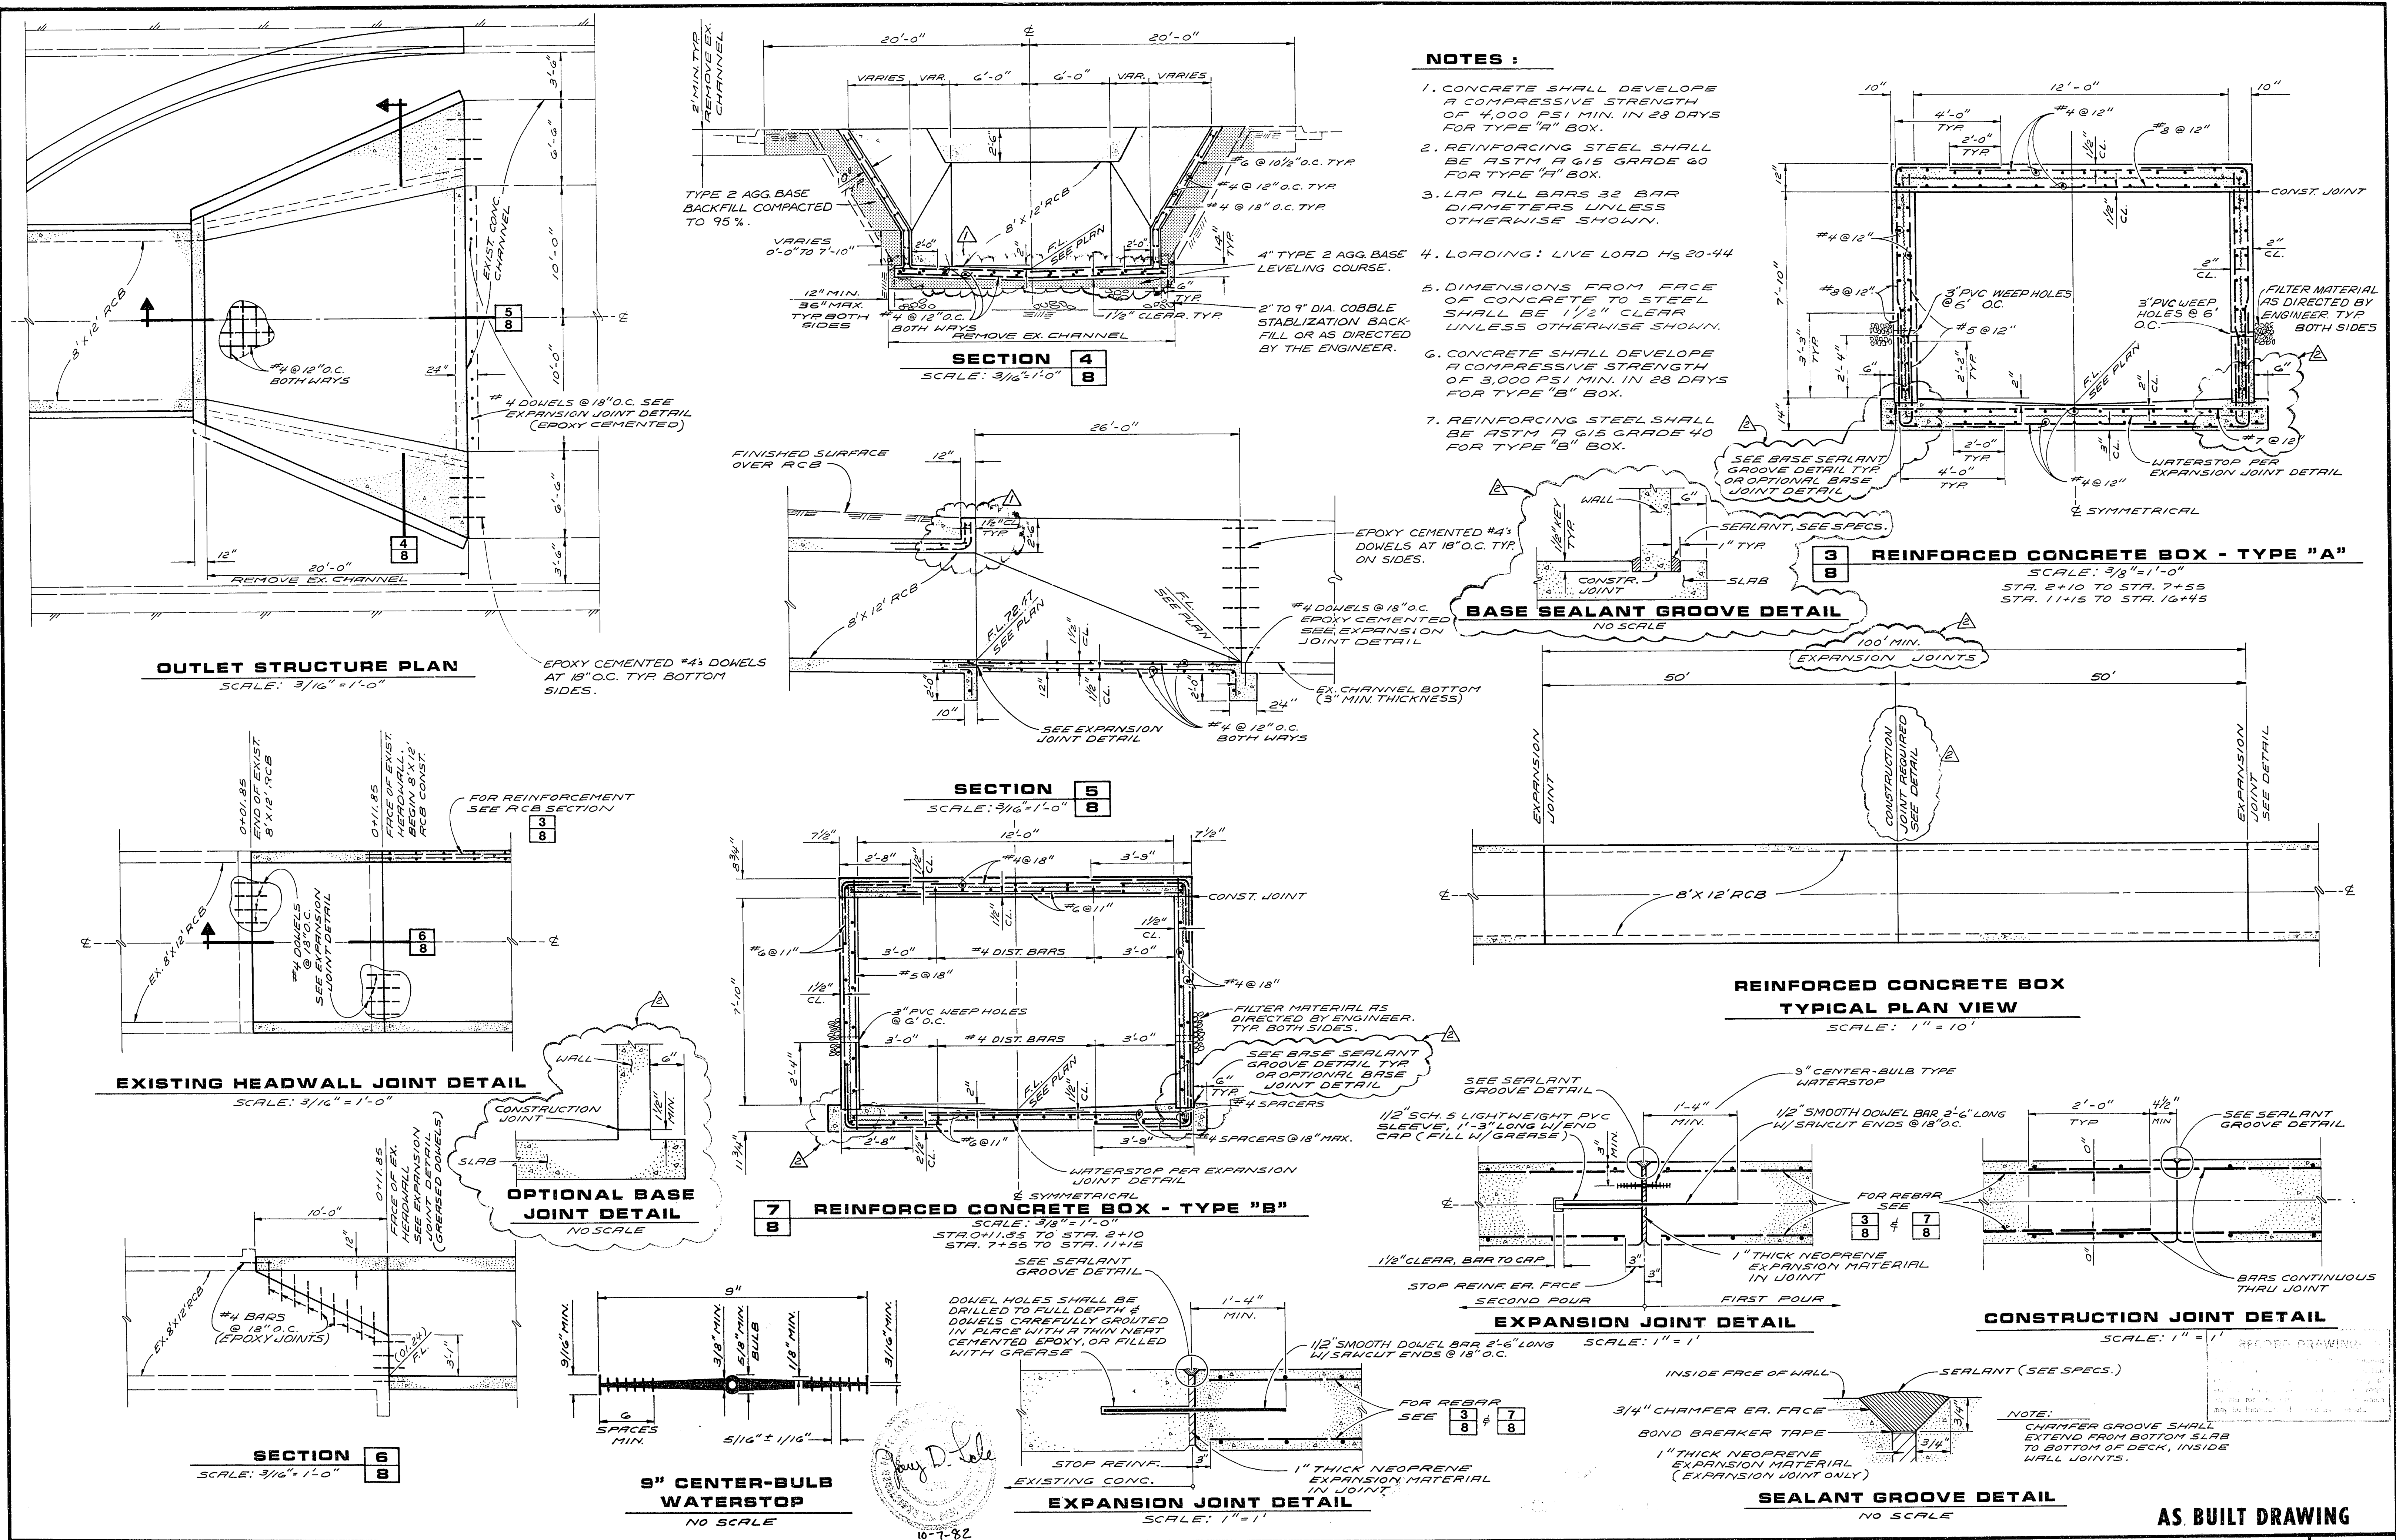

10-21-82 HOLT REVISE STEEL				APPROVED: _____ DATE _____				CITY OF LAS VEGAS				SHEET	
11-4-82 WOODS REVISE BASE JOINT				APPROVED: _____ DATE _____				WASHINGTON AVENUE CHANNEL				8	
								REINFORCED CONCRETE BOX				OF 9 SHEETS	
								STRUCTURAL DETAILS					

SCALE:	DESIGNED: <i>Shih-Lake</i>	SUBMITTED: <i>Shih-Lake</i>	5464	10-7-82	MONTGOMERY ENGINEERS OF NEVADA		1100 EAST SAHARA AVENUE, LAS VEGAS, NEVADA 89104	
AS NOTED	DRAWN: <i>J. Woods</i>	RECOMMENDED: <i>Richard J. Island</i>	2315	10/1/82				
REV	DATE	BY	DESCRIPTION	CHECKED: <i>Lake</i>	R.E. NO.	DATE		