


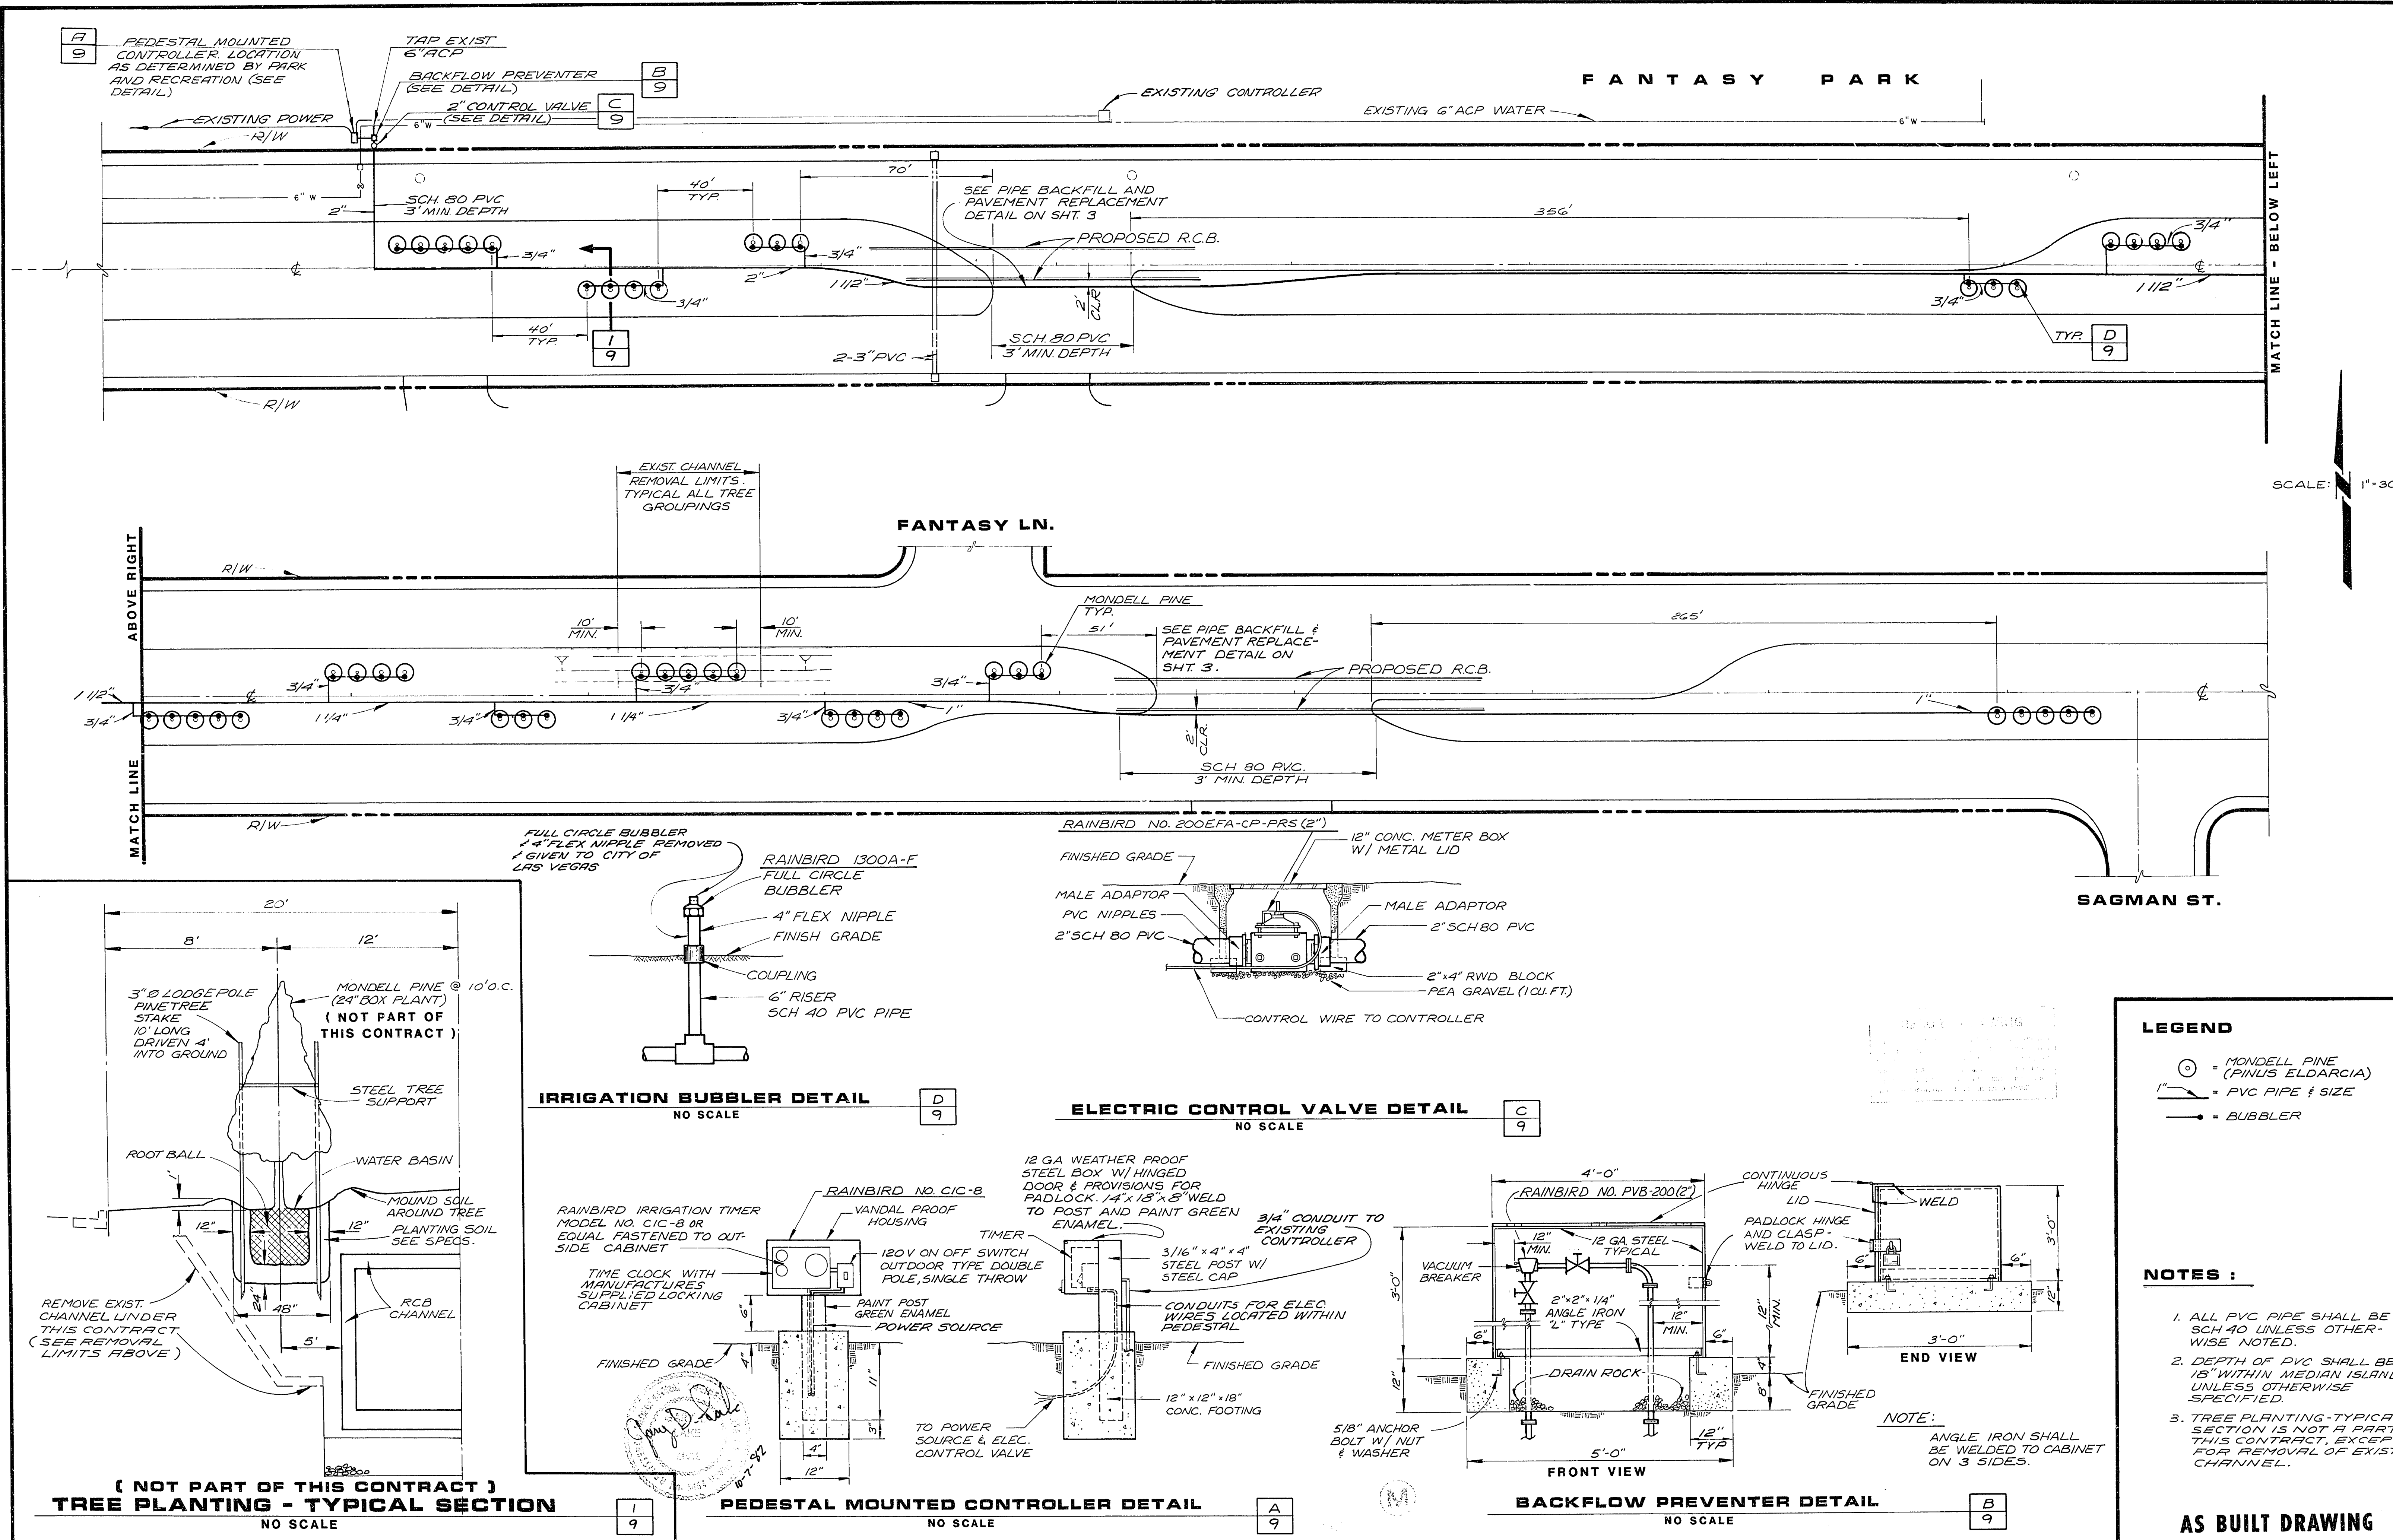

JOB NO. 5502.0070

DESIGNED: H. H. T. THEISEN DRAWN: T. THEISEN CHECKED: Lake				SUBMITTED: 5/24/84 10-7-82 RECOMMENDED: Richard J. Island 23/15 10/7/82				APPROVED: _____ DATE _____ APPROVED: _____ DATE _____				CITY OF LAS VEGAS WASHINGTON AVENUE CHANNEL LANDSCAPE PLAN AND DETAILS				SHEET 9 OF 9 SHEETS
SCALE: AS NOTED DATE: 10/7/82				MONTGOMERY ENGINEERS OF NEVADA 1100 EAST SAHARA AVENUE, LAS VEGAS, NEVADA 89104				C.L.V. DWG. NO. 327-178								