

These Record Drawings have been prepared based on information provided by others. The Engineer has not verified the accuracy of such information and shall not be responsible for any errors or omissions which may be incorporated herein as a result.




Avoid cutting underground utility lines. It's costly.

**Call
before you
Dig.**

1-800-227-2600
(ask for an 800-227-2600)

DESIGNED:	LHC
DRAWN:	JHC/PSM
CHECKED:	LHC
JOB NO.	343-90
SCALE:	
HORIZ.	AS
VERT.	NOTED

1055 EAST TROPICANA
SUITE 800
LAS VEGAS, NEVADA 89119
(702)798-1007

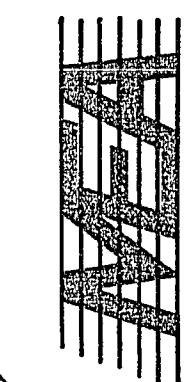

SHEET

6

6 OF 15