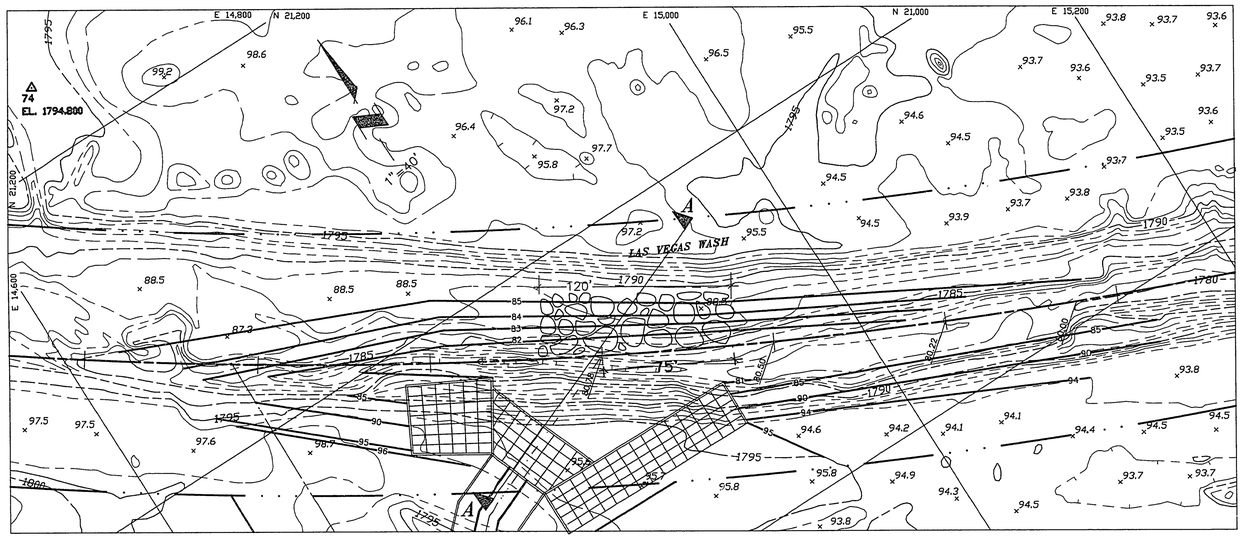

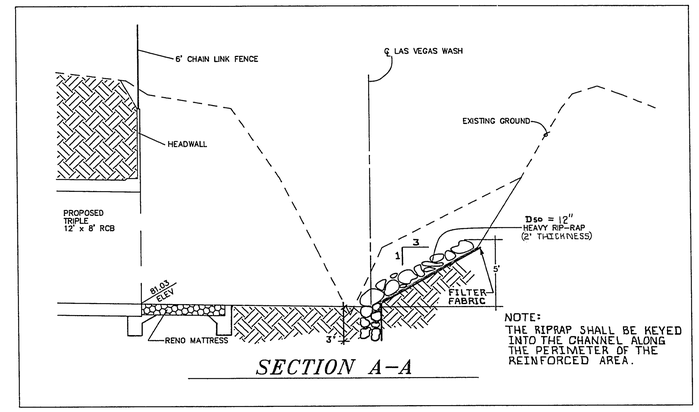

SECTION A–A

NOTE:
THE RIPRAP SHALL BE KEYED INTO THE CHANNEL ALONG THE PERIMETER OF THE REINFORCED AREA.

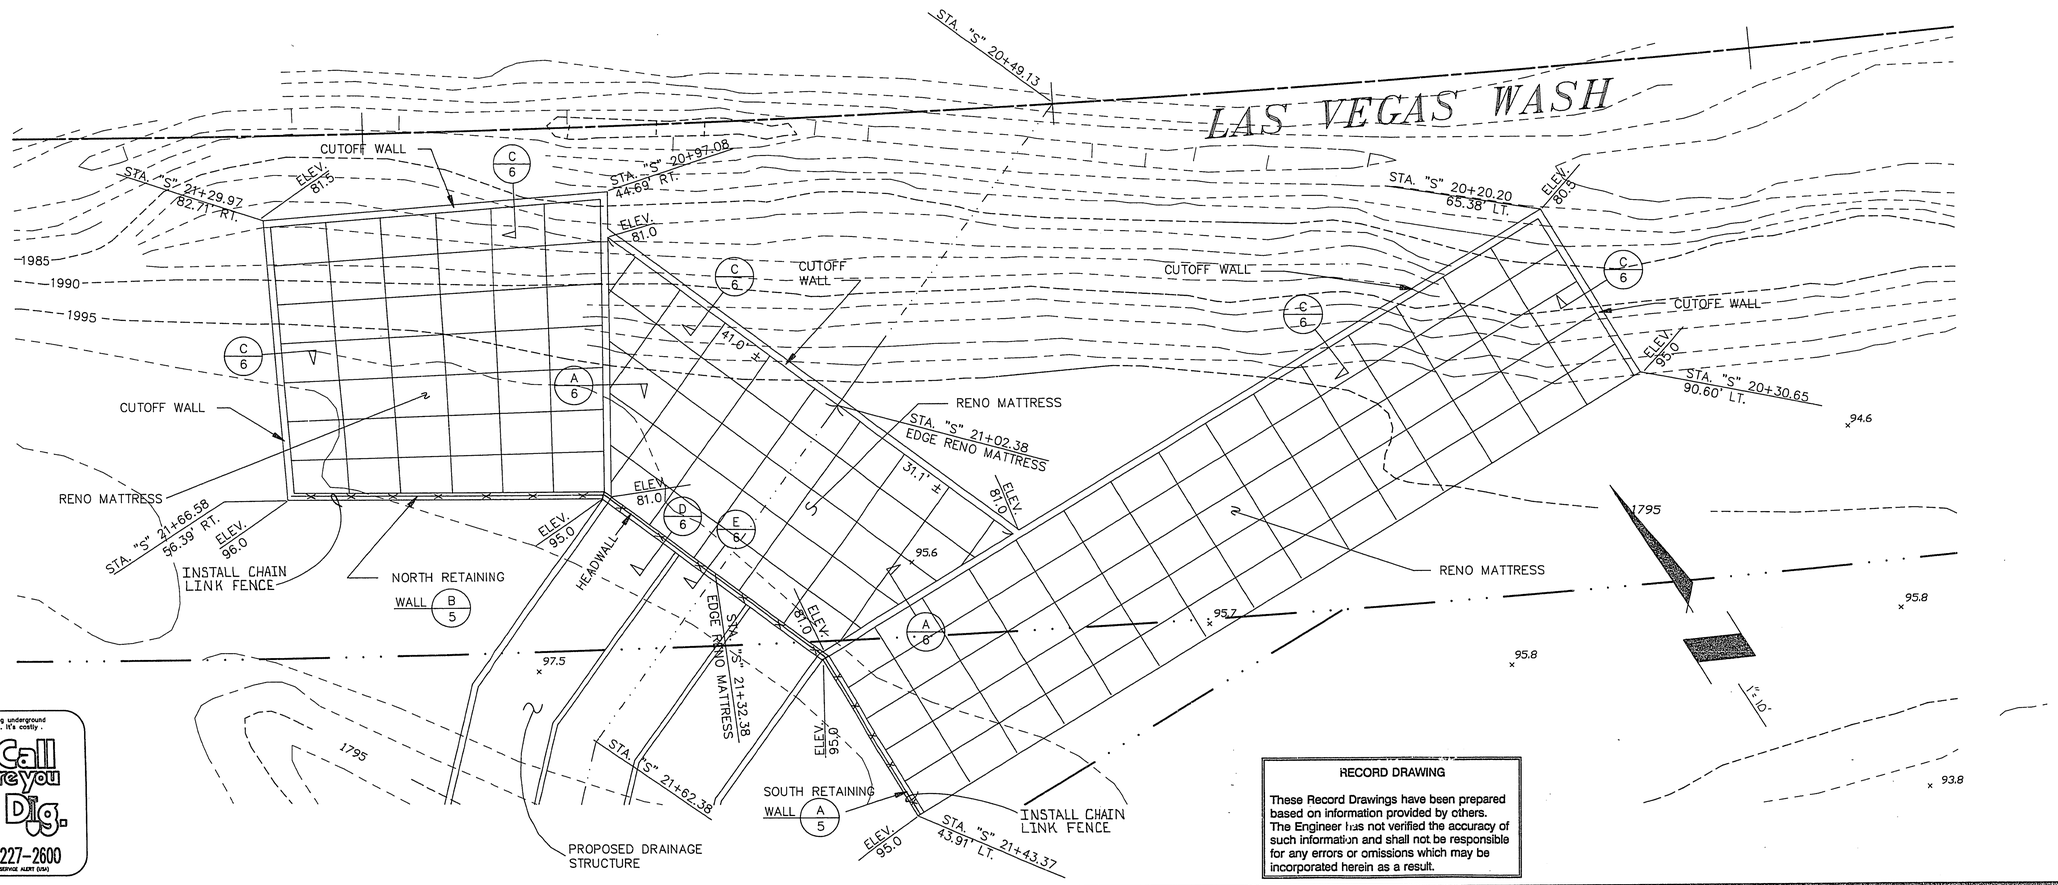

Avoid cutting underground utility lines. It's costly.
Call before you Dig.
1-800-227-2600
UNDERGROUND SERVICE ALERT (USA)

RECORD DRAWING

These Record Drawings have been prepared based on information provided by others. The Engineer has not verified the accuracy of such information and shall not be responsible for any errors or omissions which may be incorporated herein as a result.

REVISIONS			
No.	Date	CHKD.	APPD.

DESIGNED: LHC
DRAWN: MDS
CHECKED: LHC
JOB NO: 343-90
SCALE: AS NOTED
HORIZ:
VERT: NONE

1055 EAST TROPICANA
SUITE 800
LAS VEGAS, NEVADA 89119
(702)798-1007
CONSULTING ENGINEERS

PROJECT: WASHINGTON AVE. CONVEYANCE SYSTEM
SANDHILL ROAD OUTFALL STRUCTURE

DESCRIPTION: LAS VEGAS WASH
OUTFALL PLAN & GRADING

SHEET 4
4 OF 15

12/12/91 DWG. No. 731-54