



MATCHLINE SEE SHEET IR-1

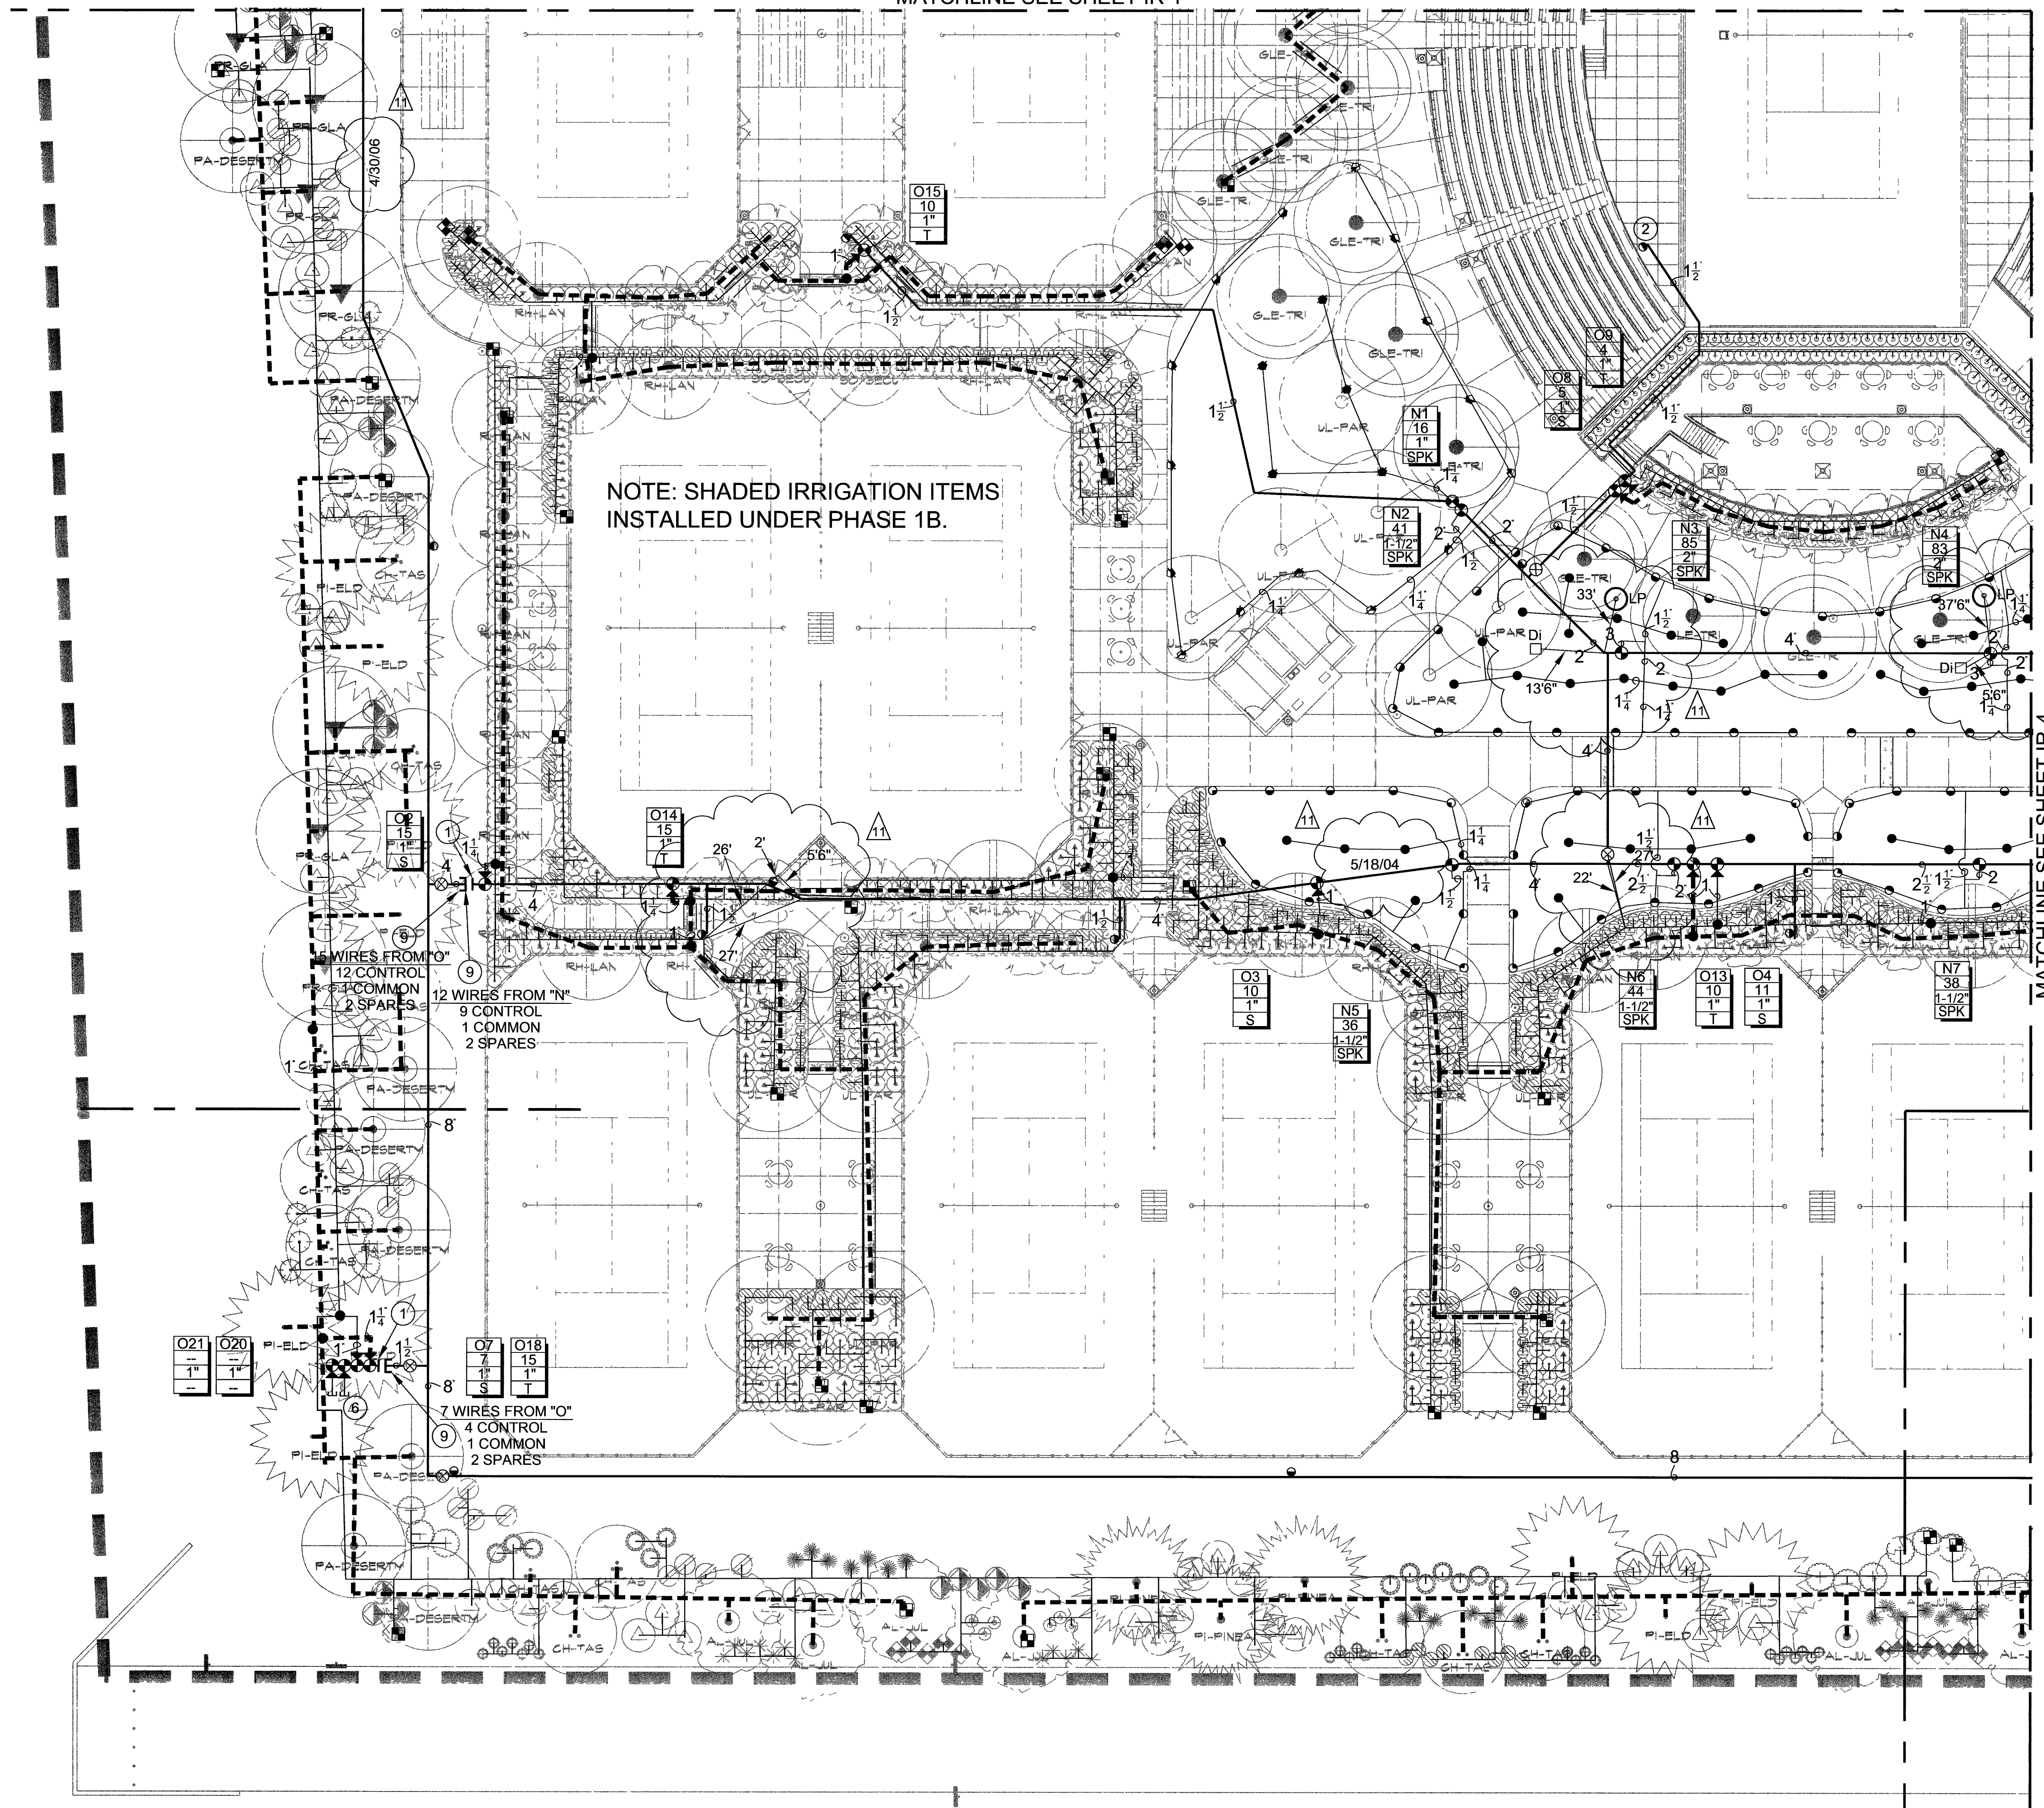


NOTE: SHADED IRRIGATION ITEMS
INSTALLED UNDER PHASE 1B.

RECORD DOCUMENTS ARE
PREPARED FROM DATA AND
INFORMATION SUPPLIED BY THE
CONTRACTOR. INFORMATION
PROVIDED BY THE CONTRACTOR IS
INCOMPLETE. AQUA ENGINEERING,
INC. DOES NOT CERTIFY, NOR
WARRANT IN ANY MANNER, THE
ACCURACY OR COMPLETENESS OF
RECORD DOCUMENTS. AQUA
ENGINEERING, INC. ADVISES
ANYONE USING RECORD
DOCUMENTS, FOR ANY PURPOSE,
TO INDEPENDENTLY VERIFY THE
ACCURACY OR COMPLETENESS OF
THE INFORMATION PRESENTED; AND
TO VERIFY THE SUITABILITY OF
INFORMATION FOR PURPOSE FOR
WHICH THEY INTEND TO USE THE
INFORMATION. AQUA ENGINEERING,
INC. IS NOT RESPONSIBLE FOR
PROBLEMS, DISCREPANCIES OR
RELATED COSTS FROM USE OF
RECORD DOCUMENTS.

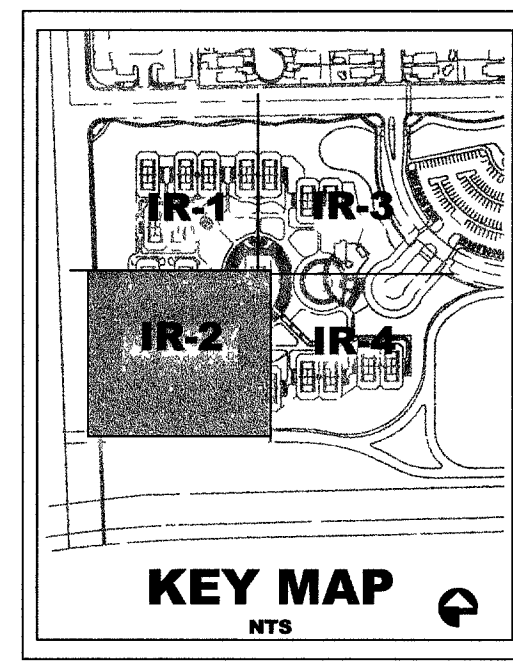

Aqua Engineering, Inc.
Irrigation System Design, Water Management,
and Water Feature Engineering
4803 Innovation Drive
Fort Collins, Colorado 80525
Phone (970) 229-9668, FAX (970) 226-3855

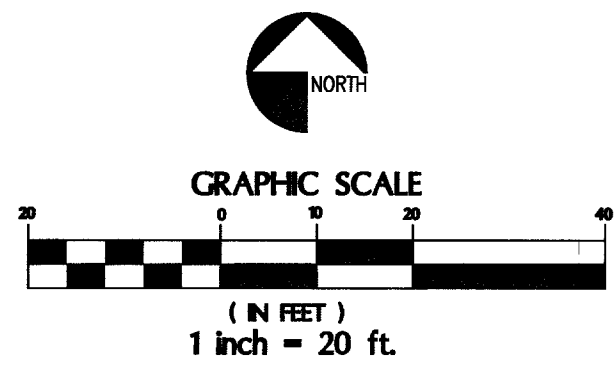

MATCHLINE SEE SHEET IR-4



REVISIONS
1-19-06

CONTRACTOR REVISIONS
1-19-06

7251 W CHARLESTON BLVD
LAS VEGAS, NEVADA 89117
PHONE (702) 258-0115
FAX (702) 869-8547

STAMP

OWNER: CITY OF LAS VEGAS
DEPARTMENT OF PUBLIC WORKS
ARCHITECTURAL SERVICES

400 EAST STEWART AVENUE
LAS VEGAS, NEVADA 89101
PHONE: (702) 329-6535
FAX: (702) 382-3232
TDD: (702) 386-9101

DRAWN RJP
FILE P-IR-02.dwg
DATE AUGUST 2003
SCALE 1"=20'-0"
BID NO 03.034101
CLV DWG NO 65076.1A
SHT NO

IR-2