
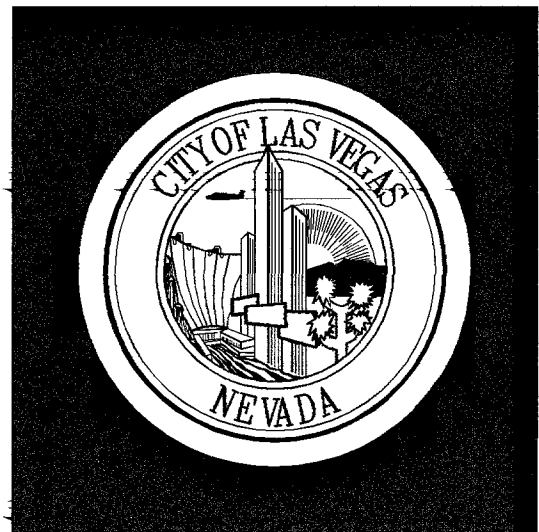
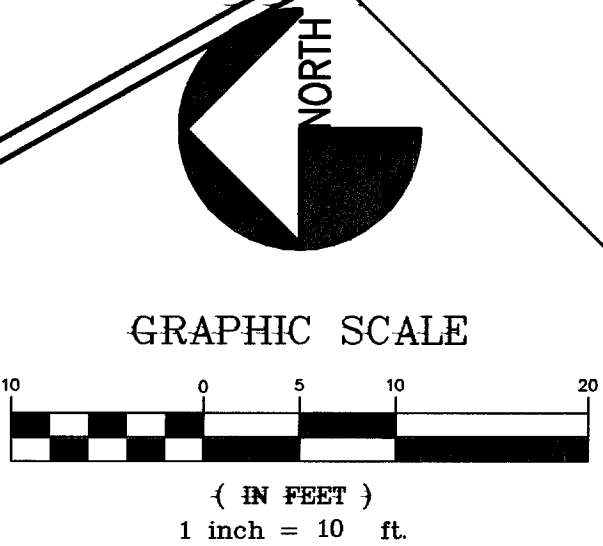


96944

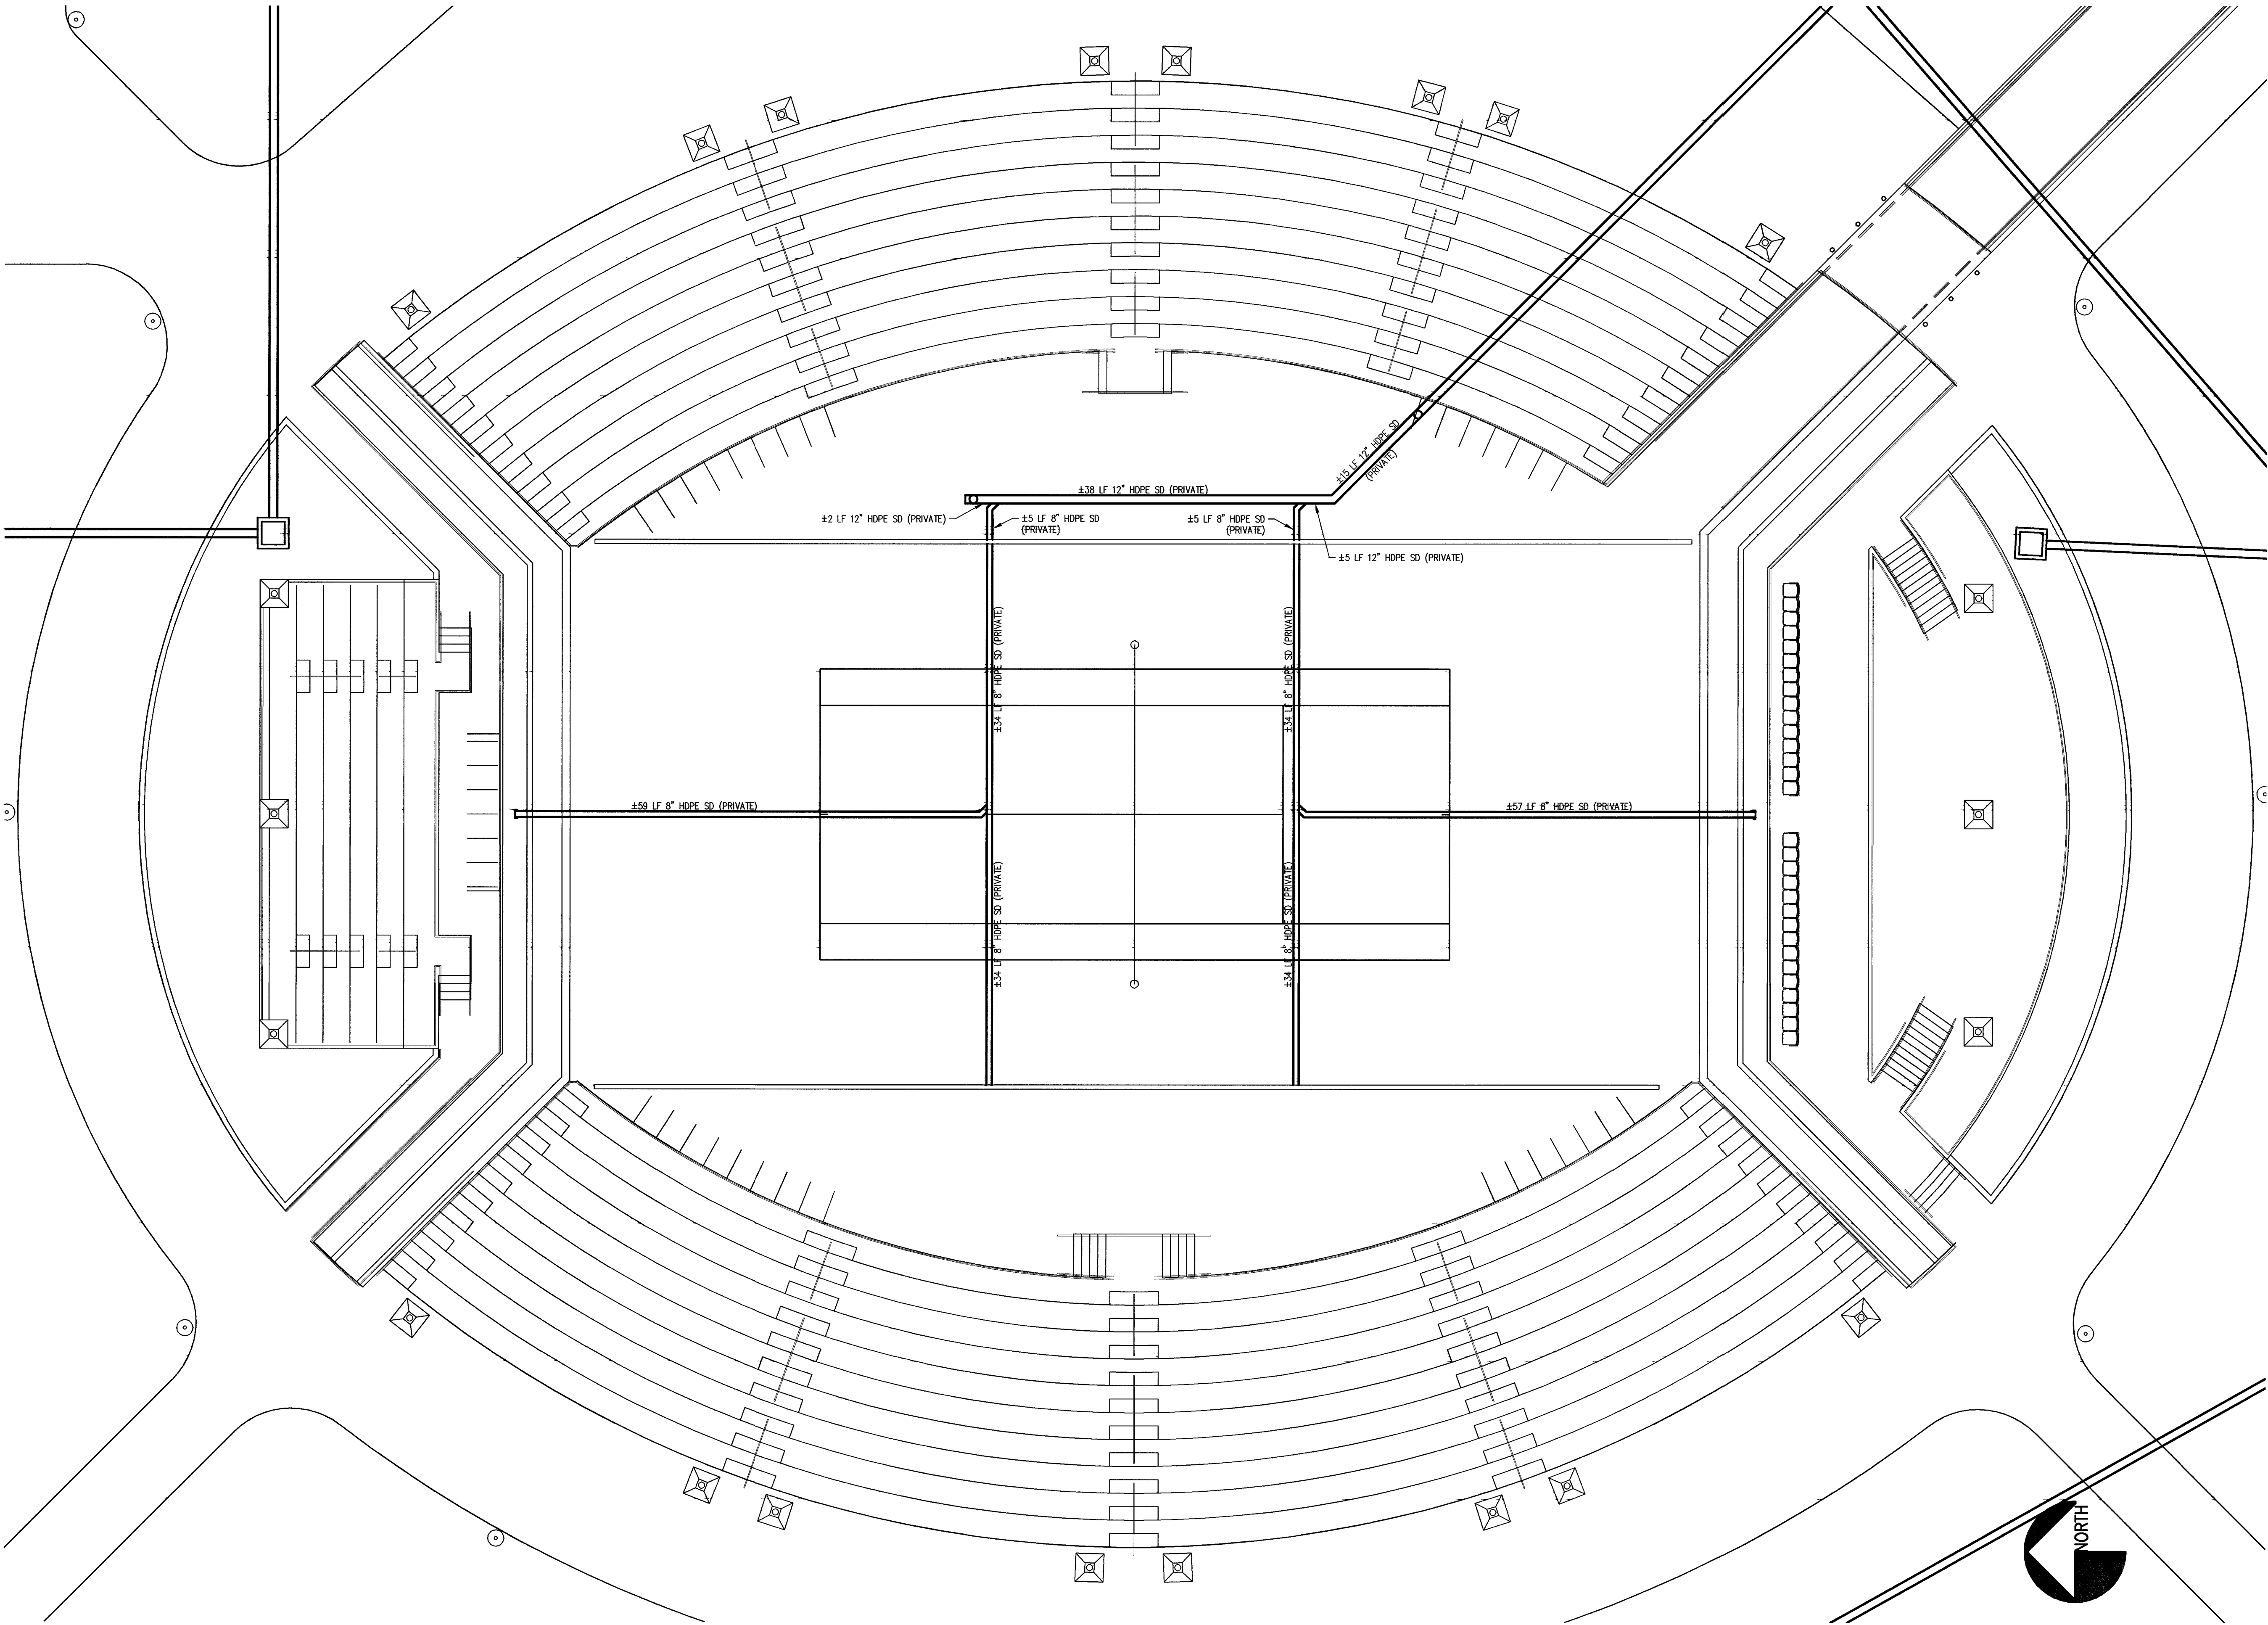

REVISIONS

NO.	DESCRIPTION	DATE

CONSULTANT

7251 W CHARLESTON BLVD
LAS VEGAS, NEVADA 89117
PHONE (702) 258-0115
FAX (702) 869-8547

Stantec

DEPARTMENT OF PUBLIC WORKS

WASHINGTON BUFFALO PARK - PHASE 1A
WASHINGTON & BUFFALO, LAS VEGAS, NV

UTILITY PLAN
(CHAMPIONSHIP COURT)

STAMP

RECORD DOCUMENTS ARE PREPARED FROM DATA AND INFORMATION SUPPLIED BY OTHERS. STANTEC CONSULTING, INC. DOES NOT CERTIFY, NOR WARRANT IN ANY MANNER, THE ACCURACY OR COMPLETENESS OF RECORD DOCUMENTS. STANTEC CONSULTING, INC. ADVISES ANYONE USING RECORD DOCUMENTS, FOR ANY PURPOSE, TO INDEPENDENTLY VERIFY THE ACCURACY OR COMPLETENESS OF THE INFORMATION PRESENTED, AND TO VERIFY THE SUITABILITY OF THE INFORMATION FOR THE PURPOSE FOR WHICH THEY INTEND TO USE THE INFORMATION. STANTEC CONSULTING, INC. SHALL NOT BE RESPONSIBLE FOR ANY PROBLEMS, DISCREPANCIES OR RELATED COSTS THAT MAY ARISE OUT OF THE USE OF RECORD DOCUMENTS.

OWNER: CITY OF LAS VEGAS
DEPARTMENT OF PUBLIC WORKS
ARCHITECTURAL SERVICES

400 EAST STEWART AVENUE
LAS VEGAS, NEVADA 89101
PHONE: (702) 229-6535
FAX: (702) 382-3232
TDD: (702) 386-9108

DRAWN: M GRIMES
FILE: Utility Planning
DATE: 1/03
SCALE: 1" = 10'-0"
DID NO: 03.B34100
CLV DWG NO: 65076-1A
SHT NO: 100% SUBMITTAL

C13