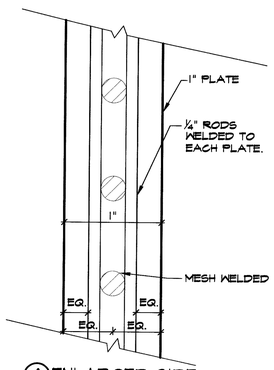

(A) ENLARGED SIDE SECTION

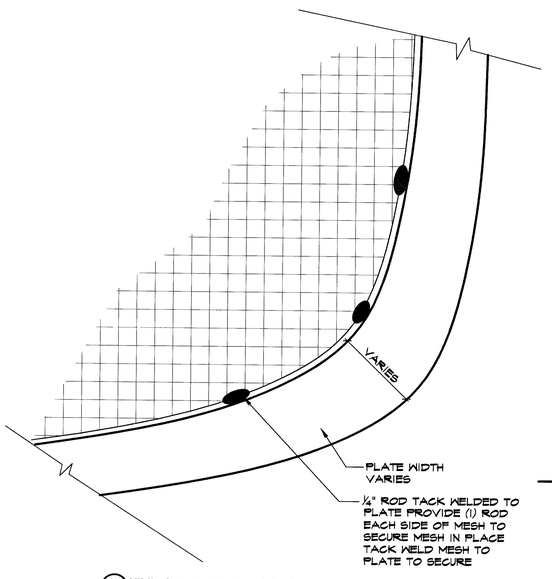

(B) ENLARGED SECTION

5 MESH TO PLATE CONNECTION

NTS

96978

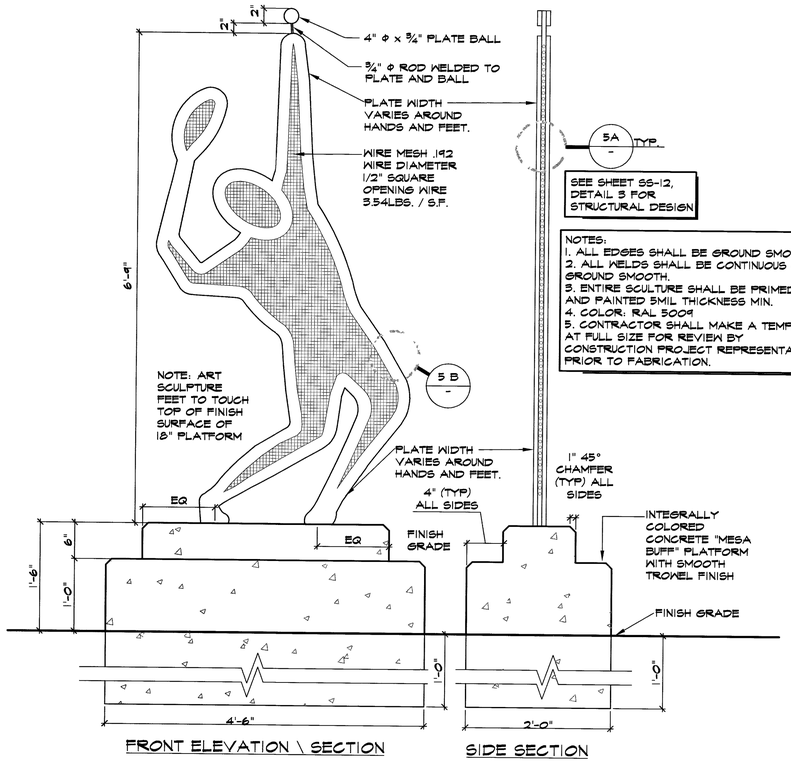

3 ART SCULPTURE TENNIS PLAYER

NTS

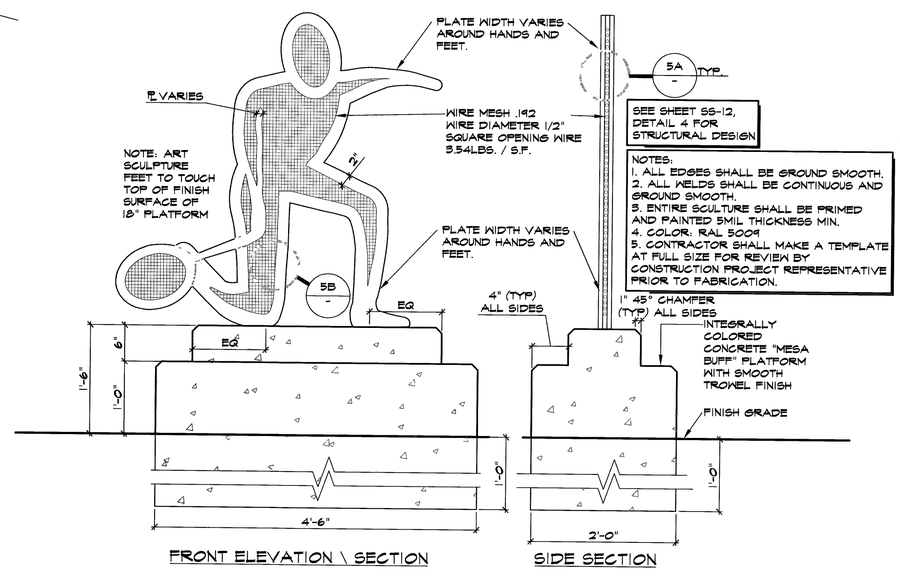

4 ART SCULPTURE TENNIS PLAYER

NTS

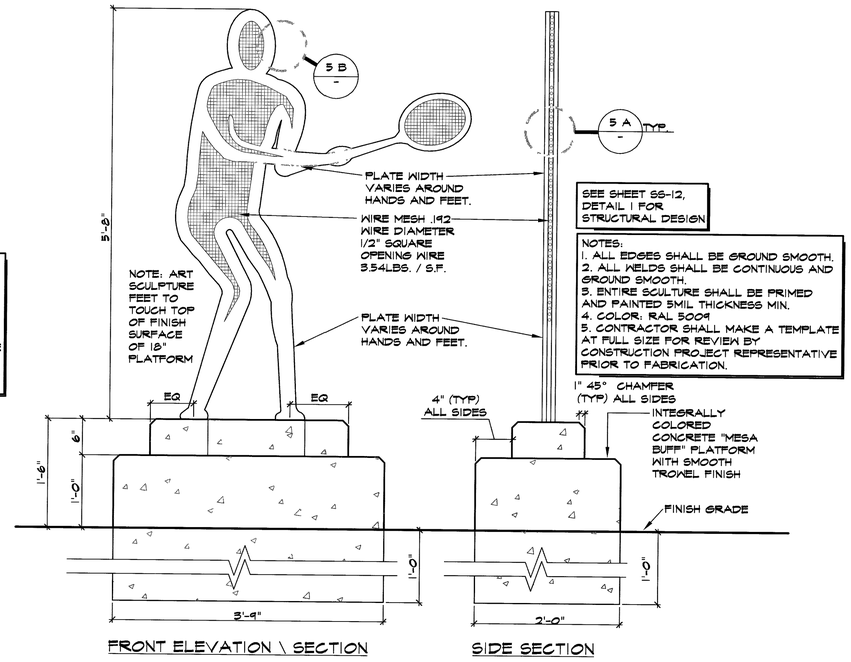

1 ART SCULPTURE TENNIS PLAYER

NTS

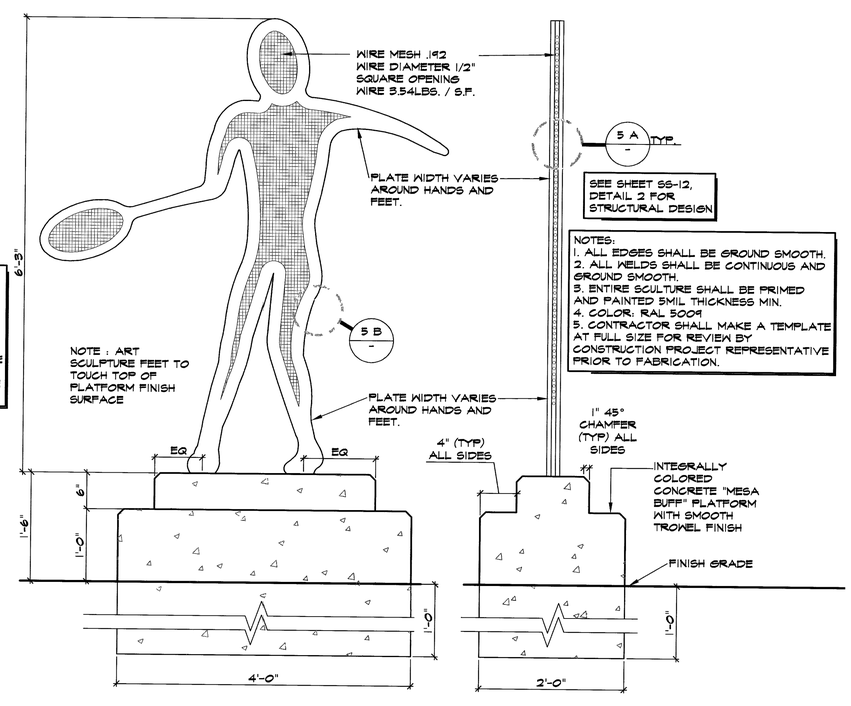

2 ART SCULPTURE TENNIS PLAYER

NTS

RECORD DRAWING (01/19/06)

CITY OF LAS VEGAS NEVADA

REVISIONS

CONSULTANT

7251 W. CHARLESTON BLVD.
LAS VEGAS, NEVADA 89117
PHONE (702) 258-0115
FAX (702) 869-8547
Stantec

PUBLICWORKS

DEPARTMENT OF

WASHINGTON BUFFALO PARK - PHASE 1A
WASHINGTON & BUFFALO, LAS VEGAS, NV

SITE DETAILS

STAMP

RECORD DOCUMENTS ARE PREPARED FROM DATA AND INFORMATION SUPPLIED BY OTHERS. STANTEC CONSULTING, INC. DOES NOT CERTIFY, NOR WARRANT IN ANY MANNER, THE ACCURACY OR COMPLETENESS OF RECORD DOCUMENTS. STANTEC CONSULTING, INC. ADVISES ANYONE USING RECORD DOCUMENTS, FOR ANY PURPOSE, TO INDEPENDENTLY VERIFY THE ACCURACY OR COMPLETENESS OF THE INFORMATION PRESENTED, AND TO VERIFY THE SUITABILITY OF THE INFORMATION FOR THE PURPOSE FOR WHICH THEY INTEND TO USE THE INFORMATION. STANTEC CONSULTING, INC. SHALL NOT RESPONSIBLE FOR ANY PROBLEMS, DISCREPANCIES OR RELATED COSTS THAT MAY ARISE OUT OF THE USE OF RECORD DOCUMENTS.

OWNER: CITY OF LAS VEGAS
DEPARTMENT OF PUBLIC WORKS
ARCHITECTURAL SERVICES

400 EAST STEWART AVENUE
LAS VEGAS, NEVADA 89101
PHONE (702) 229-6535
FAX (702) 382-3232
TDD (702) 386-9108

DRAWN	KLC
FILE	71865D-13.dwg
DATE	7/03
SCALE	NTS
BID NO	03.B341.08
CLV DWG NO	65076-1A
	100% SUBMITTAL
SHT NO	SD-13

DRAWINGS AS INSTRUMENTS OF SERVICE ARE THE PROPERTY OF THE DESIGN PROFESSIONAL, WHOSE STAMP OF CERTIFICATION APPEARS ON THE DRAWINGS AND SPECIFICATIONS RECEIVED BY THE CLIENT MAY BE UTILIZED ONLY FOR CONSTRUCTING THE PROJECT FOR WHICH THEY WERE PREPARED AND NOT FOR THE CONSTRUCTION OF ANY OTHER PROJECT. N. A. E. 633.700