



BEING A PORTION OF THE NORTHEAST QUARTER (NE 1/4) OF THE SOUTHWEST QUARTER (SW 1/4) OF SECTION 29,
TOWNSHIP 20 SOUTH, RANGE 62 EAST, M.D.M., CITY OF LAS VEGAS, CLARK COUNTY, NEVADA.

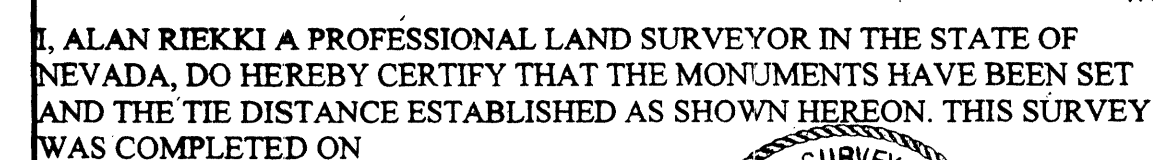


ALAN RIEKKI
NEVADA CERTIFICATION NO. 12469

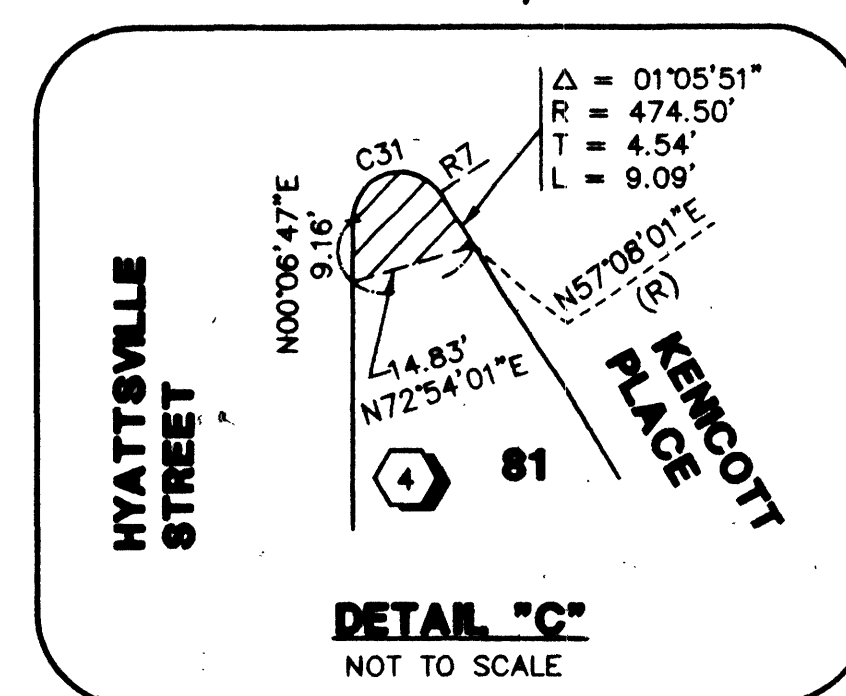

LINE TABLE		
NO.	BEARING	DISTANCE
1	N87°28'46" E	10.59
2	S87°28'46" W	5.58
3	S66°55'48" E	30.54
4	S47°45'59" E	27.69
5	S42°28'08" W	27.58
6	S43°47'27" W	28.24
7	S46°27'19" E	27.07
8	S23°09'41" E	39.65
9	S15°43'20" W	35.36

RADIAL LINE TABLE		
NO.	BEARING	TYPE
R1	S57°28'46" W	
R2	N77°27'33" E	PRC
R3	S62°31'14" E	
R4	N59°48'00" E	PCC
R5	S45°54'03" W	PRC
R6	S57°27'39" W	
R7	S56°02'10" W	PCC
R8	S57°22'39" W	
R9	N66°31'16" W	
R10	S29°16'40" E	PRC
R11	S64°04'49" E	
R12	N21°14'58" W	
R13	N09°28'17" W	PRC
R14	N32°29'11" W	
R15	N09°45'19" E	
R16	N61°25'50" E	
R17	S84°41'23" E	
R18	S57°25'31" E	PRC
R19	S34°59'35" E	PRC
R20	N88°50'23" W	
R21	N78°40'08" E	
R22	S14°34'57" E	
R23	S48°12'08" W	
R24	S45°33'08" E	

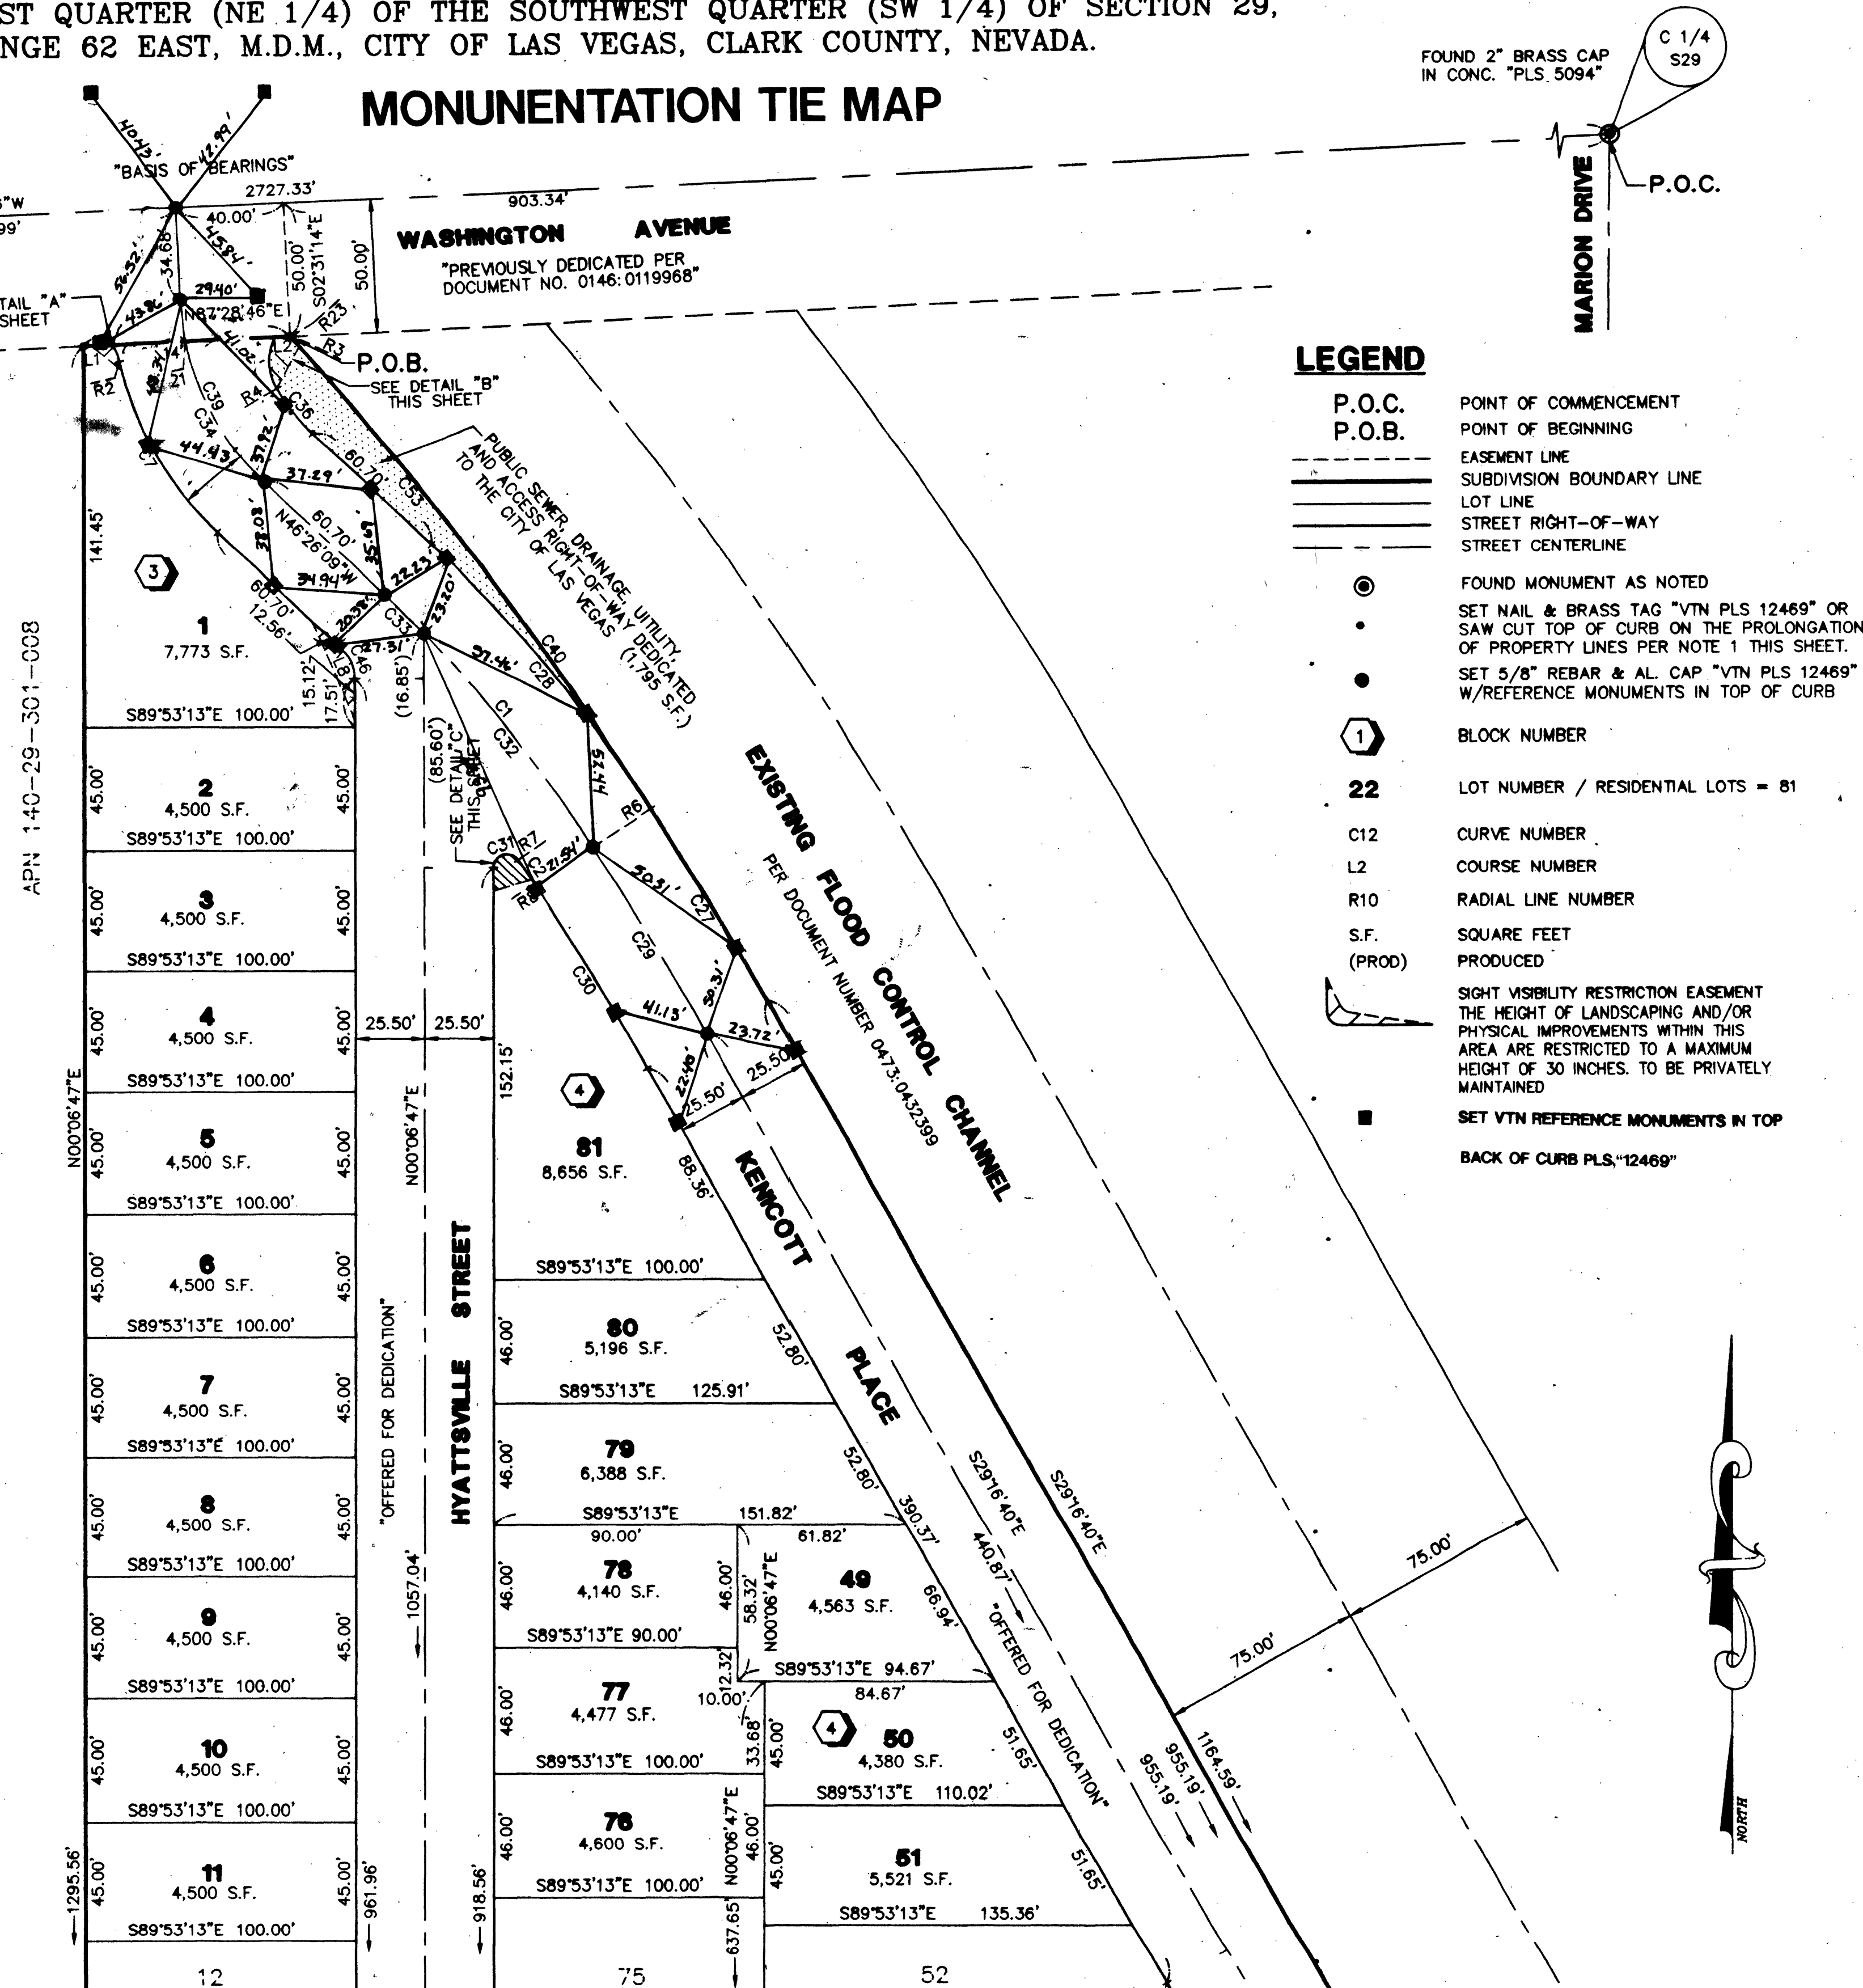

FOR CONTINUATION SEE SHEET 3

NOTES:

1. ALL REAR LOT CORNERS SHALL BE SET WITH A NAIL AND BRASS TAG P.L.S. 12-69 ON BLOCK WALL AND ALL FRONT OF SIDE LOT CORNERS ADJOINING RIGHT-OF-WAY SHALL BE MARKED BY THE SAW CUTTING OF THE BACK OF CURBS ON THE PROLONGATION OF THE PROPERTY LINES.
2. DIRECT VEHICULAR ACCESS TO WASHINGTON AVENUE FROM ABUTTING LOTS IS PROHIBITED.

W.O. 5549(2)
SHEET 1 OF 2
KAK

050-4637-2

Boof 95 page

ACT	DATE	BY	REVISION
2	6/2/00	KAK	REV STREET NAME
1	4/7/00	KAK	REV SVRE'S, CHANGE STREET NAME, RETABLE, REV. DETAILS

