

10000608

00005

MONUMENTATION TIE MAP


WASHINGTON DEVELOPMENT - UNIT 2

BEING A PORTION OF THE NORTHEAST QUARTER (NE 1/4) OF THE SOUTHWEST QUARTER (SW 1/4) OF SECTION 29,
TOWNSHIP 20 SOUTH, RANGE 62 EAST, M.D.M., CITY OF LAS VEGAS, CLARK COUNTY, NEVADA.


FOR CONTINUATION SEE SHEET 2

LEGEND

- EASEMENT LINE
- BOUNDARY LINE
- LOT LINE
- STREET RIGHT-OF-WAY
- STREET CENTERLINE
- FOUND MONUMENT AS NOTED
- SET NAIL & BRASS TAG "VTN PLS 12469" OR SAW CUT TOP OF CURB ON THE PROLONGATION OF PROPERTY LINES PER NOTE 1 THIS SHEET.
- SET 5/8" REBAR & AL. CAP "VTN PLS 12469" W/REFERENCE MONUMENTS IN TOP OF CURB
- BLOCK NUMBER
- LOT NUMBER / RESIDENTIAL LOTS = 81
- C12 CURVE NUMBER
- L2 COURSE NUMBER
- R10 RADIAL LINE NUMBER
- S.F. SQUARE FEET
- (PROD) PRODUCED
- SIGHT VISIBILITY RESTRICTION EASEMENT THE HEIGHT OF LANDSCAPING AND/OR PHYSICAL IMPROVEMENTS WITHIN THIS AREA ARE RESTRICTED TO A MAXIMUM HEIGHT OF 30 INCHES. TO BE PRIVATELY MAINTAINED
- SET VTN REFERENCE MONUMENTS IN TOP BACK OF CURB PLS. "12469"

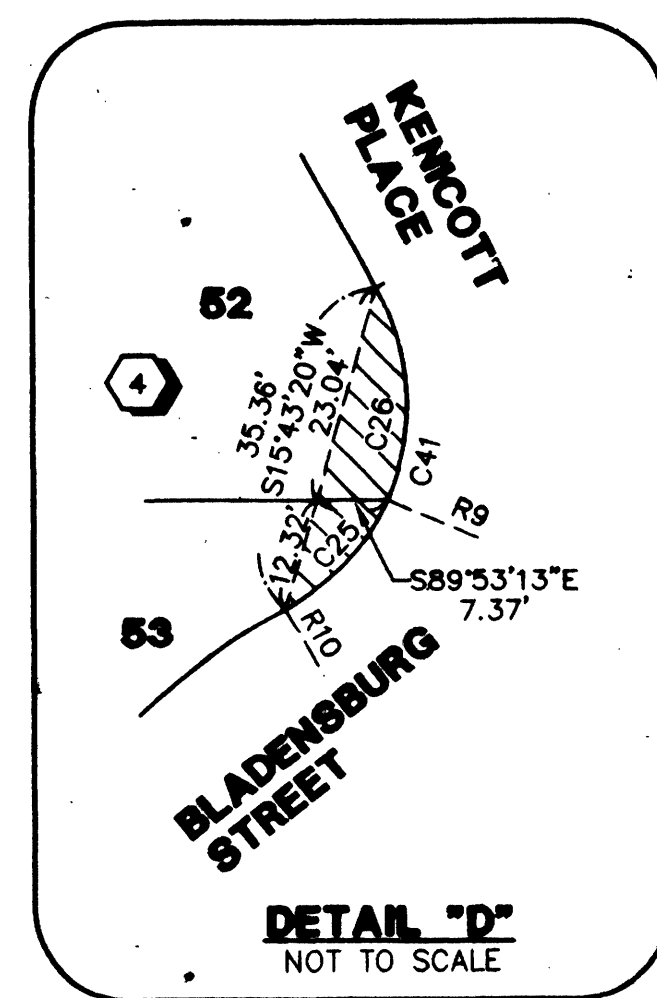

ACT	DATE	BY	REVISION
1	4/21/00	KAK	REVISE SVRE'S

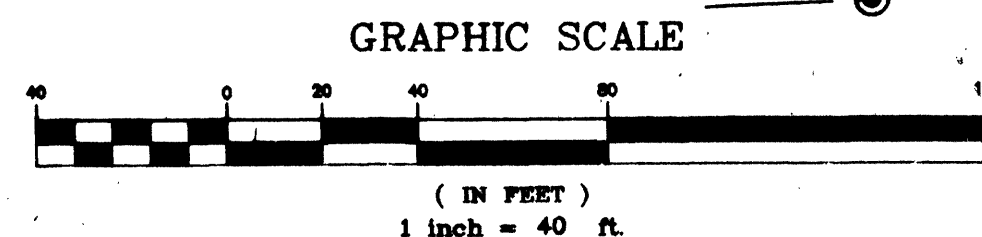

NOTES:

- ALL REAR LOT CORNERS SHALL BE SET WITH A NAIL AND BRASS TAG PLS. 12469 ON BLOCK WALL AND ALL FRONT OF SIDE LOT CORNERS ADJOINING RIGHT-OF-WAY SHALL BE MARKED BY THE SAW CUTTING OF THE BACK OF CURBS ON THE PROLONGATION OF THE PROPERTY LINES.
- SEE SHEET 2 FOR CURVE, LINE AND RADIAL LINE TABLES.

W.O. 5549(2)
SHEET 2 OF 2
KAK

058-4637-2
Book 95 page 1